

UNDERDRAIN FLUSHING BASIN
STA. 23+50, RT



STONE FILL TYPE 1, GEOTEXTILE UNDER
STONE FILL & GRUBBING MATERIAL
STA. 21+16 TO 21+40, LT
STA. 21+17 TO 21+27, RT

STEEL BEAM GUARDRAIL, GALVANIZED
STA. 19+87.5 TO 20+12.5, LT
STEEL BEAM GUARDRAIL, GALVANIZED W/ 8 FEET POSTS
STA. 20+12.5 TO 24+00.0, LT

ANCHOR FOR STEEL BEAM RAIL
STA. 19+87.5, LT
REMOVAL AND DISPOSAL OF GUARDRAIL
STA. 20+09 TO 24+00, LT
DURABLE 4 INCH WHITE LINE, THERMOPLASTIC
DURABLE 4 INCH WHITE LINE, POLYUREA
TEMPORARY 4 INCH WHITE LINE, PAINT
STA. 20+53.92 TO 24+00, SOLID LT & RT

DURABLE 4 INCH YELLOW LINE, THERMOPLASTIC
DURABLE 4 INCH YELLOW LINE, POLYUREA
TEMPORARY 4 INCH YELLOW LINE, PAINT
STA. 20+53.92 TO 24+00, SOLID LT & RT

REMOVING SIGNS
AS SHOWN - 5
ERECTING SALVAGED SIGNS
AS SHOWN - 1

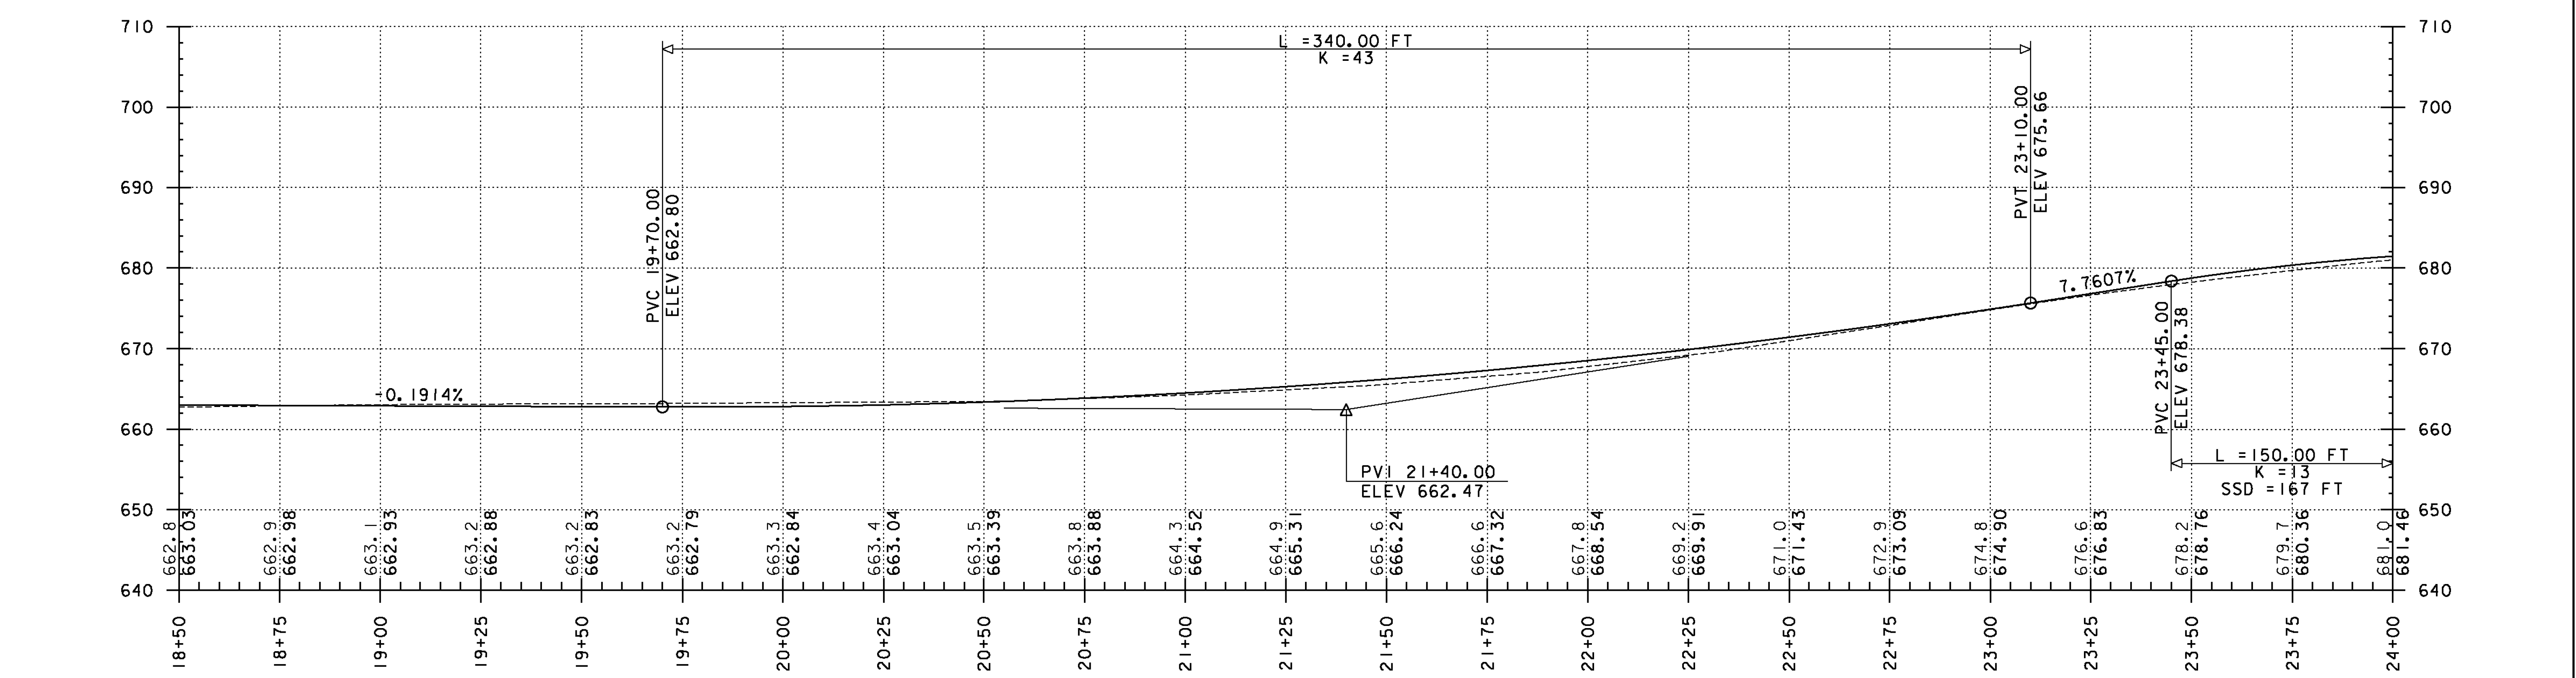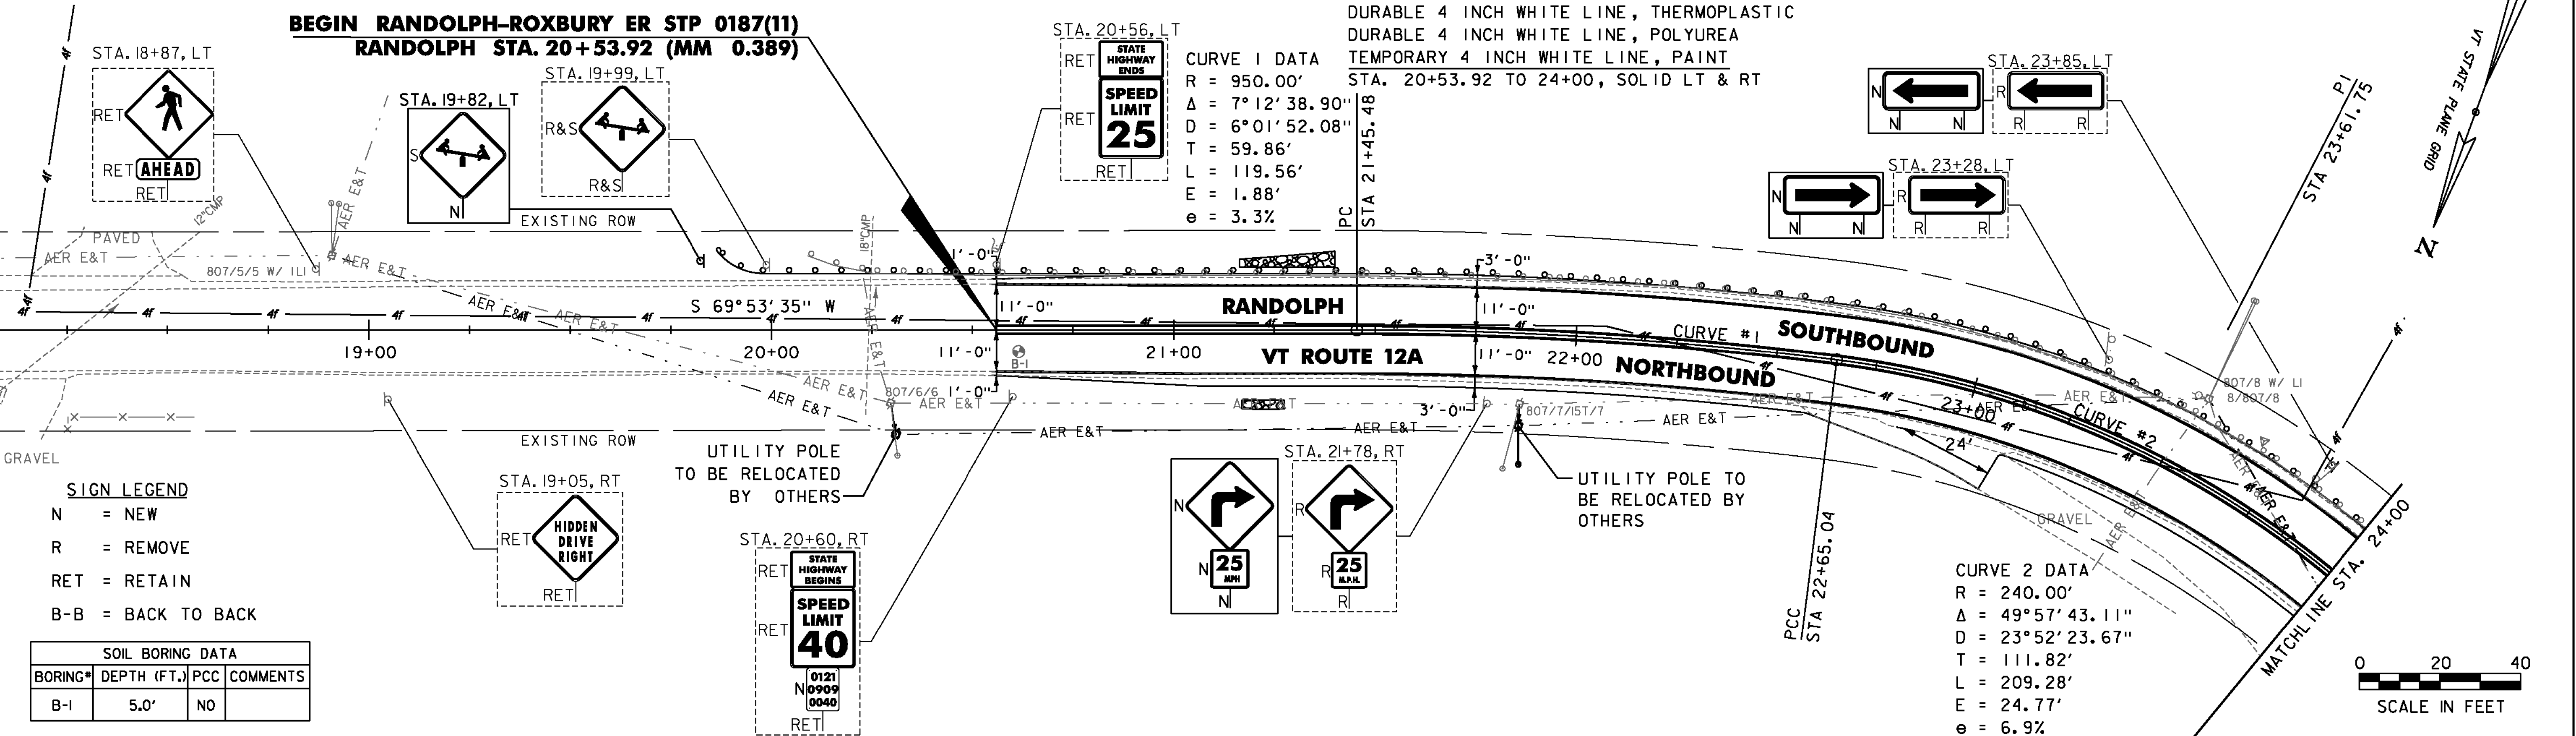

PROJECT NAME: RANDOLPH-ROXBURY
PROJECT NUMBER: ER STP 0187(11)

FILE NAME: z13cl82bdr.dgn
PROJECT LEADER: M. FOISY
DESIGNED BY: I. MAYNARD
PLAN & PROFILE SHEET 1

PLOT DATE: 11/17/2014
DRAWN BY: G. BURGMEIER
CHECKED BY: M. FOISY
SHEET 42 OF 545

