

REMOVING AND RESETTING FENCE

STA. 45+00 TO 45+61, LT
 STA. 45+88 TO 46+20, LT
 STA. 46+52 TO 49+42, LT

DURABLE 4 INCH WHITE LINE, THERMOPLASTIC
 DURABLE 4 INCH WHITE LINE, POLYUREA
 TEMPORARY 4 INCH WHITE LINE, PAINT
 (ALL LINES WILL INCLUDE EDGE LINE BREAKS
 AND RADII FOR SIDE ROADS)
 STA. 45+00 TO 50+00, SOLID LT & RT


DURABLE 4 INCH YELLOW LINE, THERMOPLASTIC
 DURABLE 4 INCH YELLOW LINE, POLYUREA
 TEMPORARY 4 INCH YELLOW LINE, PAINT
 (ALL LINES WILL INCLUDE Q BREAK
 FOR SIDE ROADS)
 STA. 45+00 TO 50+00, SOLID LT & RT
 STA. 47+63, RT (BRAINTREE HILL RD)

DURABLE 24 INCH STOP BAR, THERMOPLASTIC
 DURABLE 24 INCH STOP BAR, POLYUREA
 TEMPORARY 24 INCH STOP BAR, PAINT
 STA. 47+63, RT (BRAINTREE HILL RD) (27 LF)

DURABLE LETTER OR SYMBOL, THERMOPLASTIC
 DURABLE LETTER OR SYMBOL, POLYUREA
 STA. 47+63, RT "STOP" (BRAINTREE HILL RD)

EROSION LOG
 STA. 49+51 TO 50+00, LT

REMOVING SIGNS
 AS SHOWN - 6
 ERECTING SALVAGED SIGNS
 AS SHOWN - 2

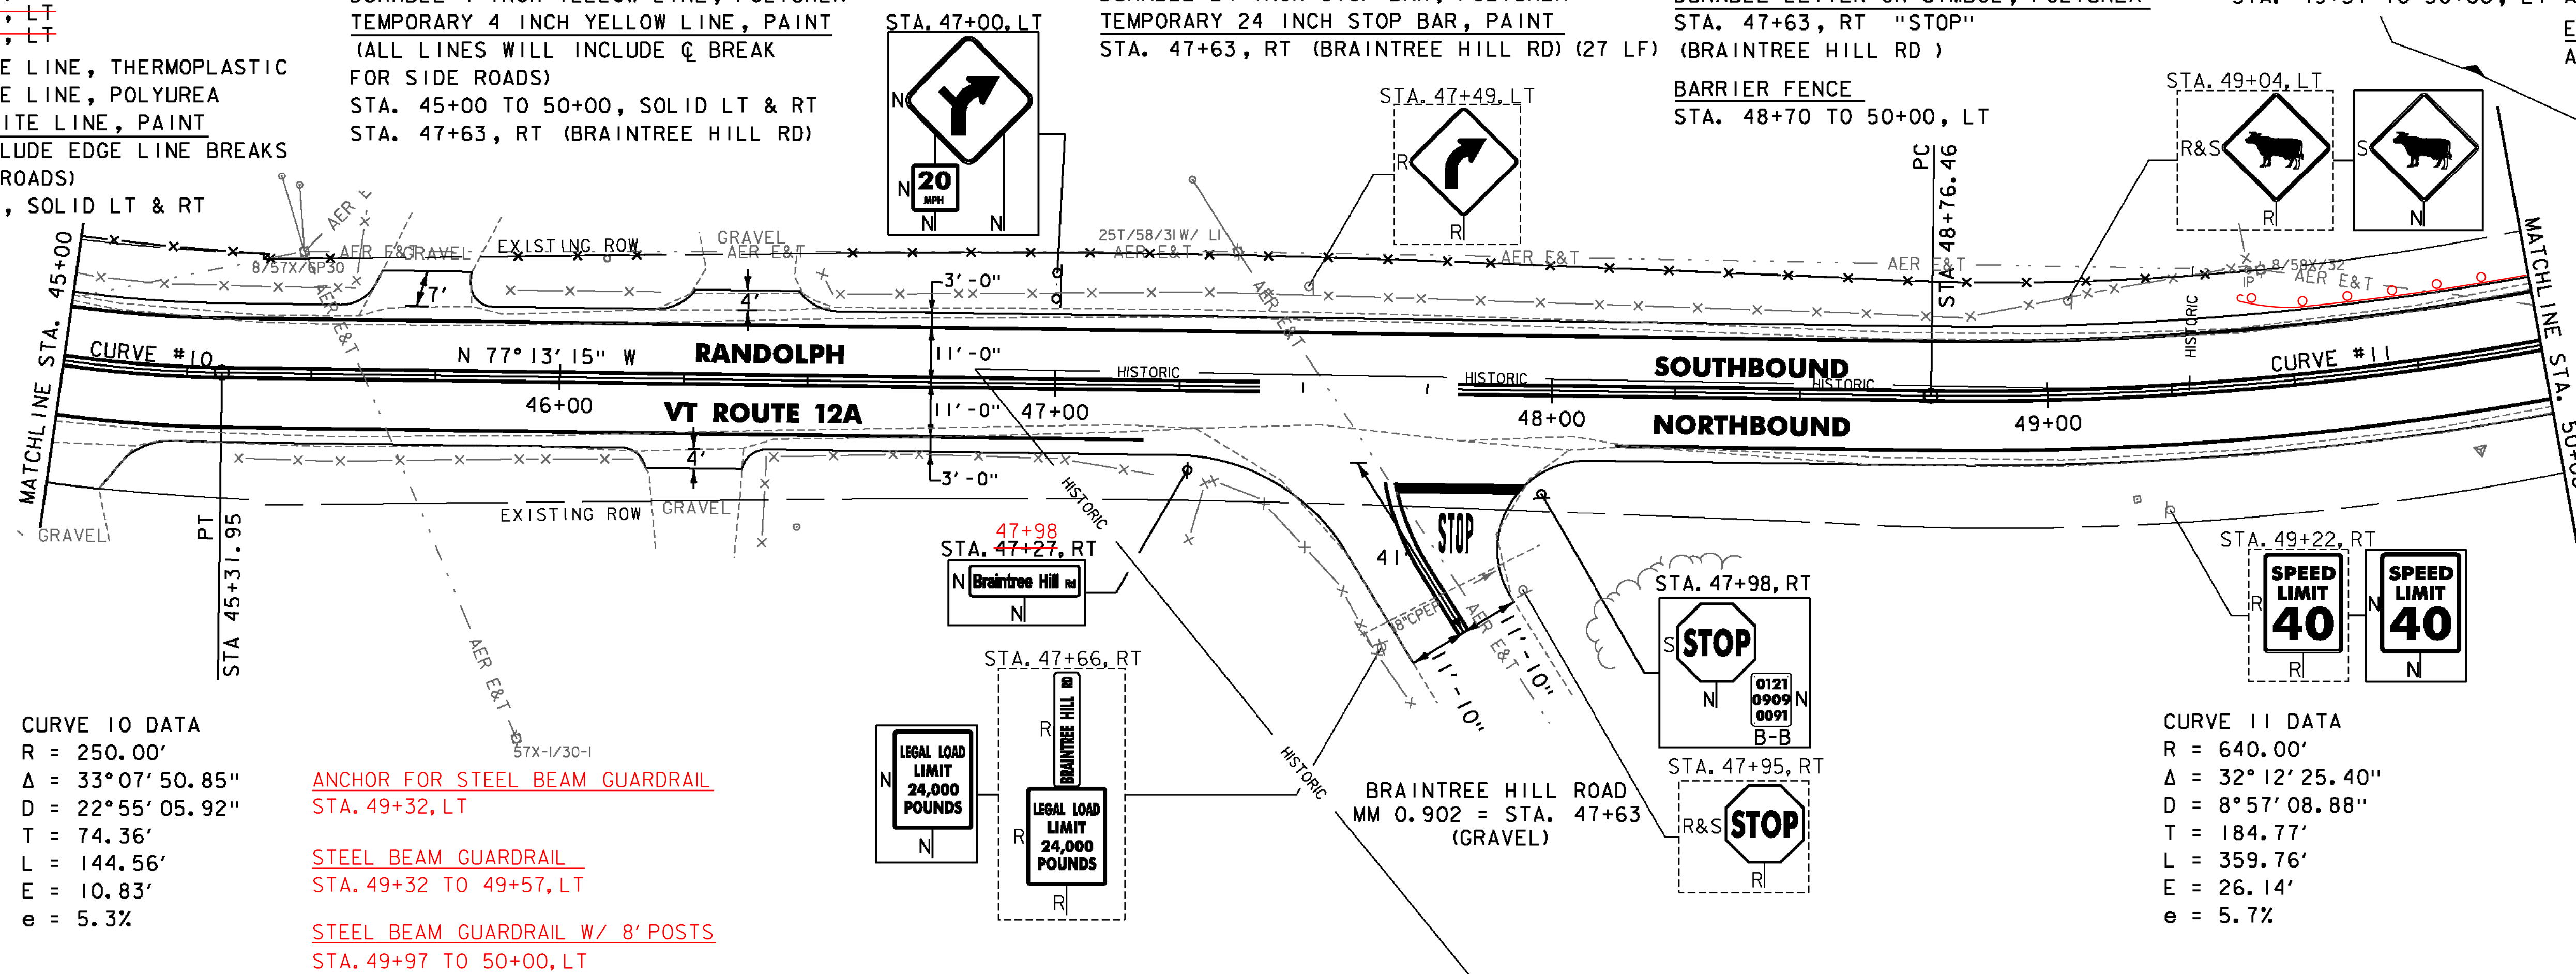




CURVE 10 DATA
 R = 250.00'
 Δ = 33° 07' 50.85"
 D = 22° 55' 05.92"
 T = 74.36'
 L = 144.56'
 E = 10.83'
 e = 5.3%

ANCHOR FOR STEEL BEAM GUARDRAIL
 STA. 49+32, LT

STEEL BEAM GUARDRAIL
 STA. 49+32 TO 49+57, LT

STEEL BEAM GUARDRAIL W/ 8' POSTS
 STA. 49+97 TO 50+00, LT

CURVE 11 DATA
 R = 640.00'
 Δ = 32° 12' 25.40"
 D = 8° 57' 08.88"
 T = 184.77'
 L = 359.76'
 E = 26.14'
 e = 5.7%

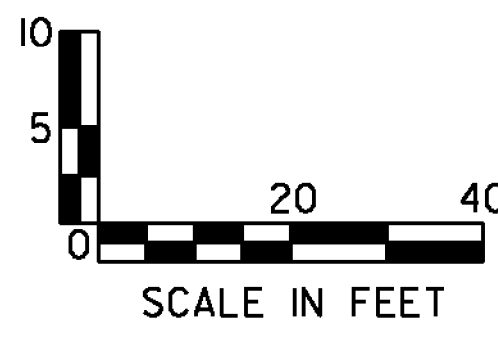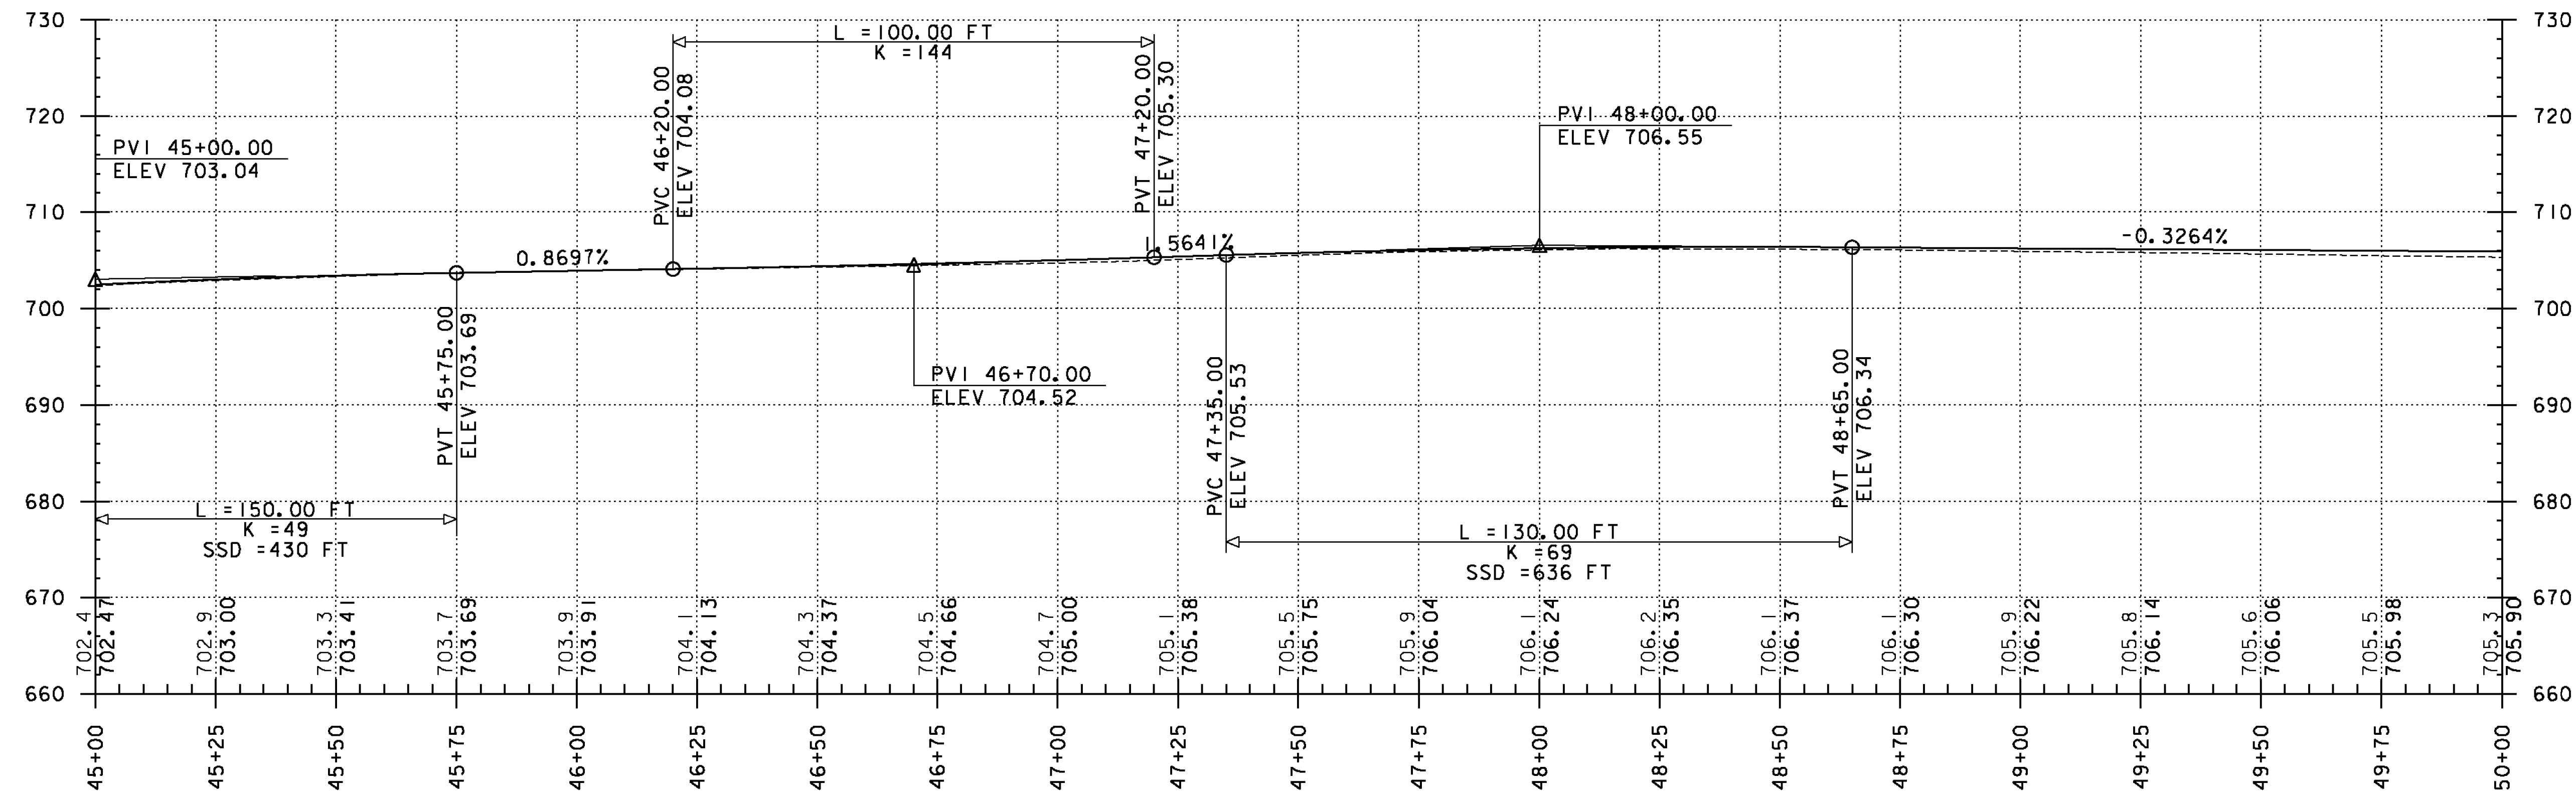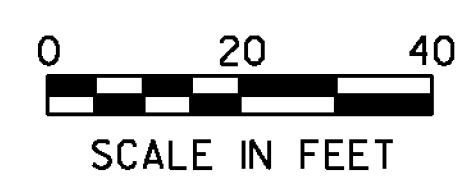

PROJECT NAME: RANDOLPH-ROXBURY
 PROJECT NUMBER: ER STP 0187(II)

FILE NAME: z13cl82bdr.dgn
 PROJECT LEADER: M. FOISY
 DESIGNED BY: I. MAYNARD
PLAN & PROFILE SHEET 6

PLOT DATE: 11/17/2014
 DRAWN BY: G. BURGMEIER
 CHECKED BY: M. FOISY
 SHEET 47 OF 545

