

STONE FILL TYPE I, GEOTEXTILE UNDER STONE FILL & GRUBBING MATERIAL
 STA. 15+36 TO 15+50, LT
 STA. 17+21 TO 20+00, RT
 19+15


CURVE 15 DATA
 R = 1650.00'
 $\Delta = 25^\circ 24' 57.36''$
 D = 3'28" 20.90"
 T = 372.08'
 L = 731.93'
 E = 41.43'
 e = 6.0%

RELOCATE MAILBOX, SINGLE SUPPORT
 STA. 16+66, RT
 STA. 17+70, LT
 STEEL BEAM GUARDRAIL, GALVANIZED
 STA. 15+36.0 TO 15+61.0, LT




STEEL BEAM GUARDRAIL, GALVANIZED W/ 8 FEET POSTS
 STA. 15+00.0 TO 15+36.0, LT
 ANCHOR FOR STEEL BEAM RAIL
 STA. 15+61.0, LT
 REMOVAL AND DISPOSAL OF GUARDRAIL
 STA. 15+00 TO 15+55, LT
 DURABLE 4 INCH WHITE LINE, THERMOPLASTIC
 DURABLE 4 INCH WHITE LINE, POLYUREA
 TEMPORARY 4 INCH WHITE LINE, PAINT
 STA. 15+00 TO 20+00, SOLID LT & RT

DURABLE 4 INCH YELLOW LINE, THERMOPLASTIC BARRIER FENCE
 DURABLE 4 INCH YELLOW LINE, POLYUREA
 TEMPORARY 4 INCH YELLOW LINE, PAINT
 STA. 15+00 TO 20+00, SOLID LT & RT
 GEOTEXTILE FOR SILT FENCE
 STA. 17+50 TO 18+00, RT
 STA. 19+50 TO 20+00, RT

REMOVING SIGNS AS SHOWN - 1
 STA. 16+35 TO 17+60, LT
 STA. 18+93 TO 20+00, LT
 EROSION LOG
 STA. 15+00 TO 15+50, RT

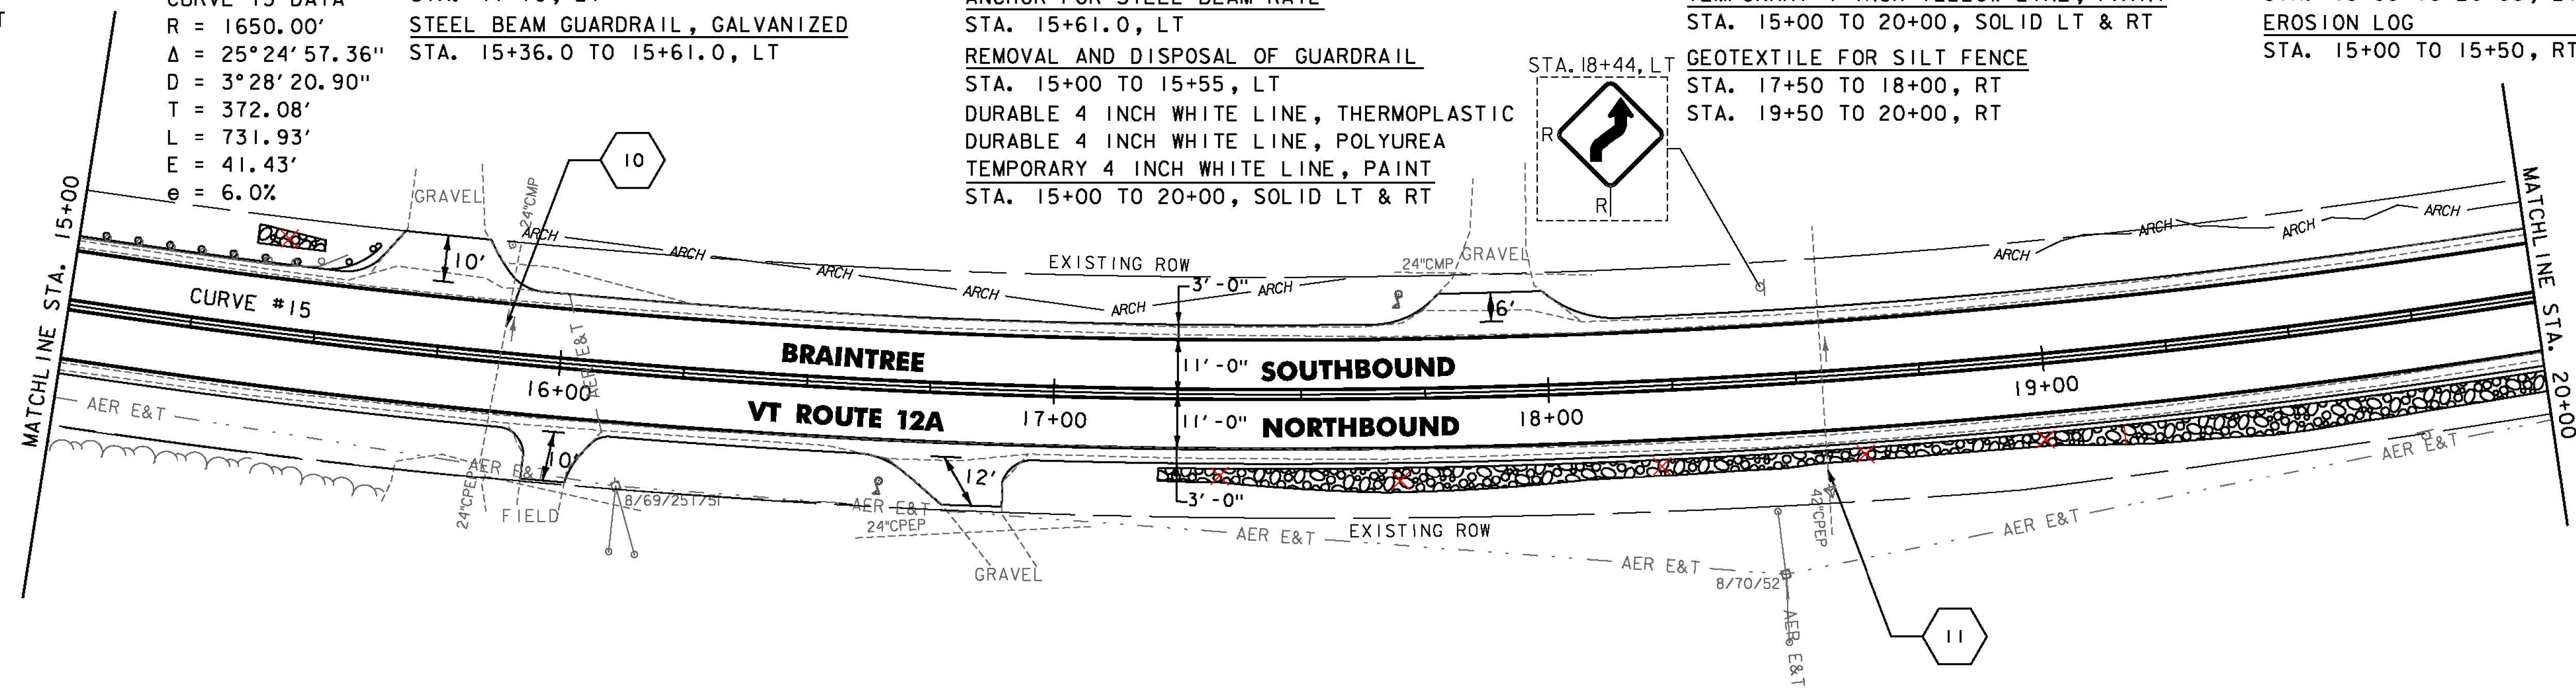

NOTE:
 1. REFER TO SHEET 27 OF 545 FOR CULVERT INFORMATION.

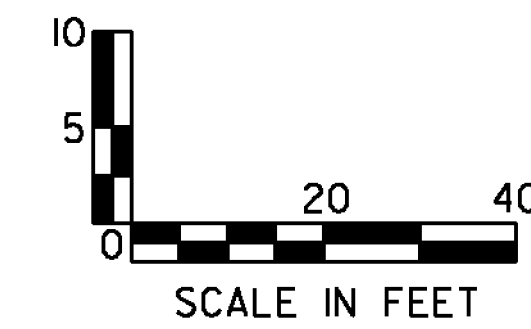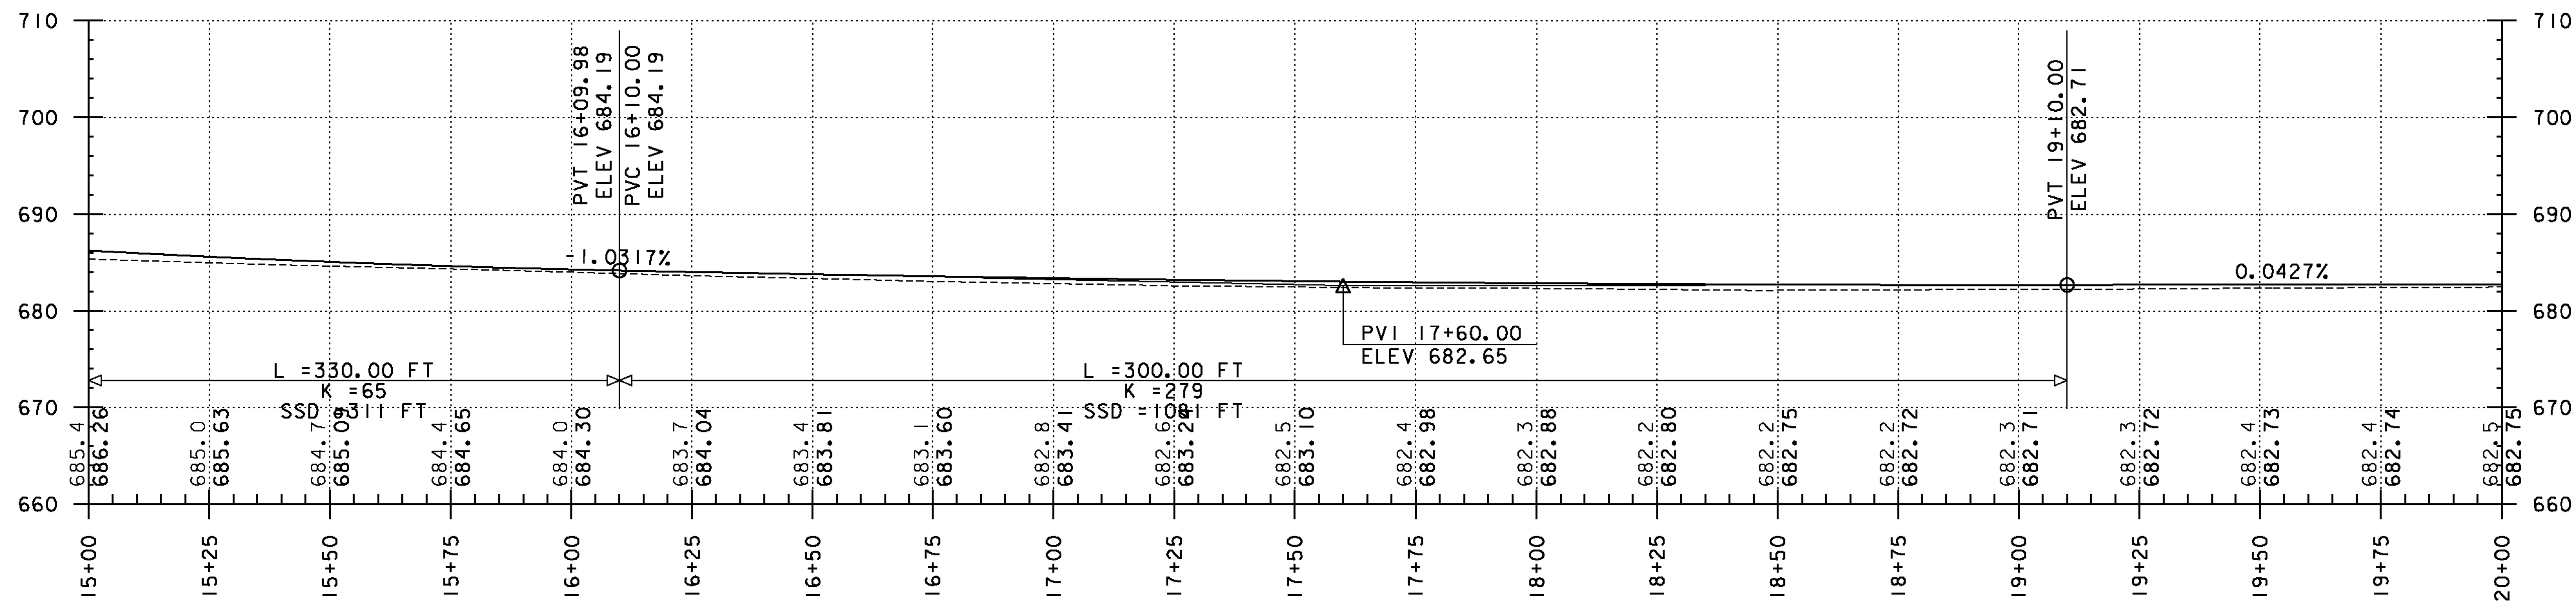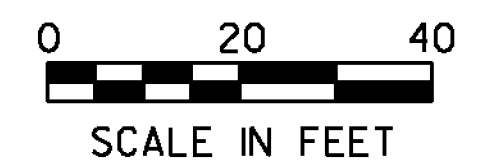

PROJECT NAME: RANDOLPH-ROXBURY
 PROJECT NUMBER: ER STP 0187(II)

FILE NAME: z13cl82bdr.dgn
 PROJECT LEADER: M. FOISY
 DESIGNED BY: I. MAYNARD
 PLAN & PROFILE SHEET 13

PLOT DATE: 11/17/2014
 DRAWN BY: G. BURGMEIER
 CHECKED BY: M. FOISY
 SHEET 54 OF 545

