

UNDERDRAIN FLUSHING BASIN

STA. 24+00, RT

STONE FILL TYPE 1, GEOTEXTILE UNDER STONE FILL & GRUBBING MATERIAL

STA. 20+00 TO 20+62, RT STA. 20+00 TO 20+51, RT

STA. 21+92 TO 24+04, LT STA. 21+80 TO 24+19, LT

RELOCATE MAILBOX, SINGLE SUPPORT

STA. 24+35, LT

DURABLE 4 INCH WHITE LINE, THERMOPLASTIC

DURABLE 4 INCH WHITE LINE, POLYUREA

TEMPORARY 4 INCH WHITE LINE, PAINT

STA. 20+00 TO 25+00, SOLID LT & RT

DURABLE 4 INCH YELLOW LINE, THERMOPLASTIC

DURABLE 4 INCH YELLOW LINE, POLYUREA

TEMPORARY 4 INCH YELLOW LINE, PAINT

STA. 20+00 TO 25+00, SOLID LT & RT

GEOTEXTILE FOR SILT FENCE

STA. 20+00 TO 22+00, RT

STA. 20+00 TO 23+50, LT


BARRIER FENCE

STA. 20+25 TO 23+50, LT

EROSION LOG

STA. 24+00 TO 25+00, RT




CURVE 15 DATA
 R = 1650.00'
 $\Delta = 25^\circ 24' 57.36''$
 D = 3' 28' 20.90"
 T = 372.08'
 L = 731.93'
 E = 41.43'
 e = 6.0%

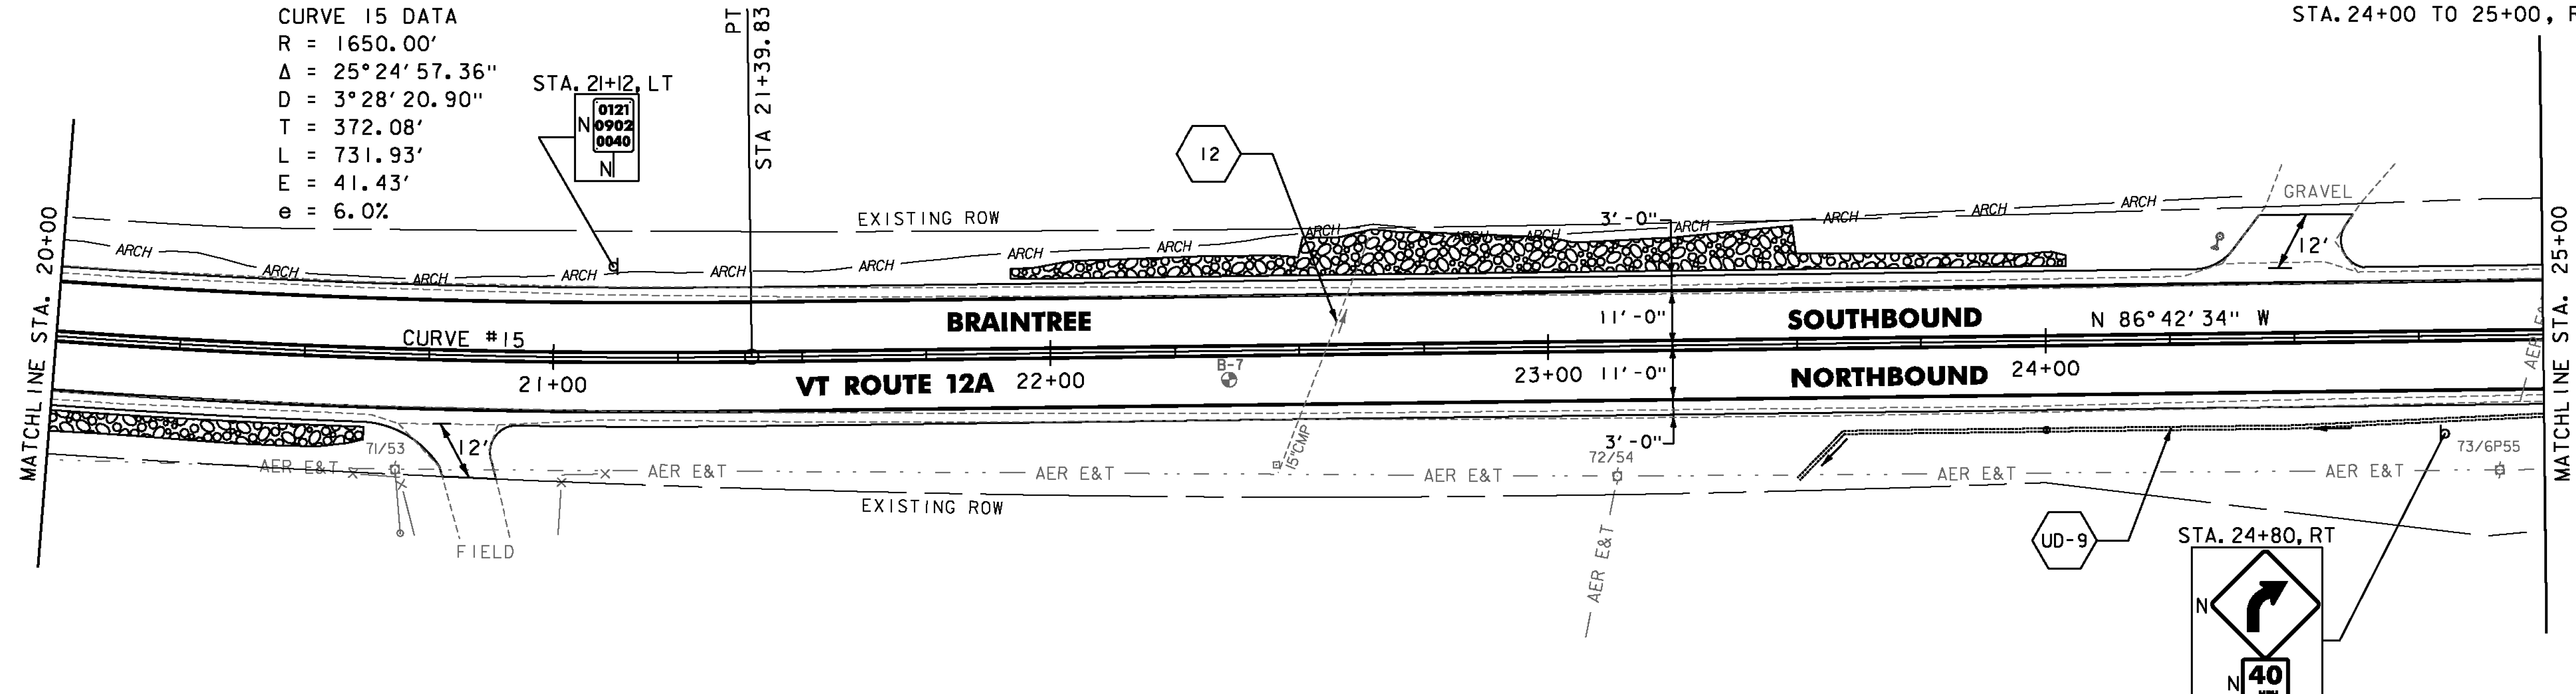

SOIL BORING DATA			
BORING#	DEPTH (FT.)	PCC	COMMENTS
B-7	5.0'	NO	

UD-9 STA 23+50, RT TO 27+00, RT
 CONSTRUCT 6 INCH UNDERDRAIN PIPE,
 SEE SHEET 8 FOR DETAIL AND
 ASSOCIATED QUANTITIES.

NOTE:
 1. REFER TO SHEET 27 OF 545
 FOR CULVERT INFORMATION.

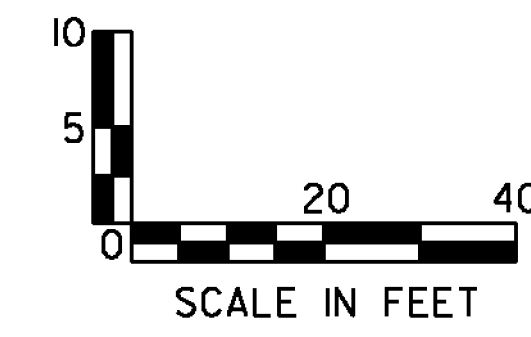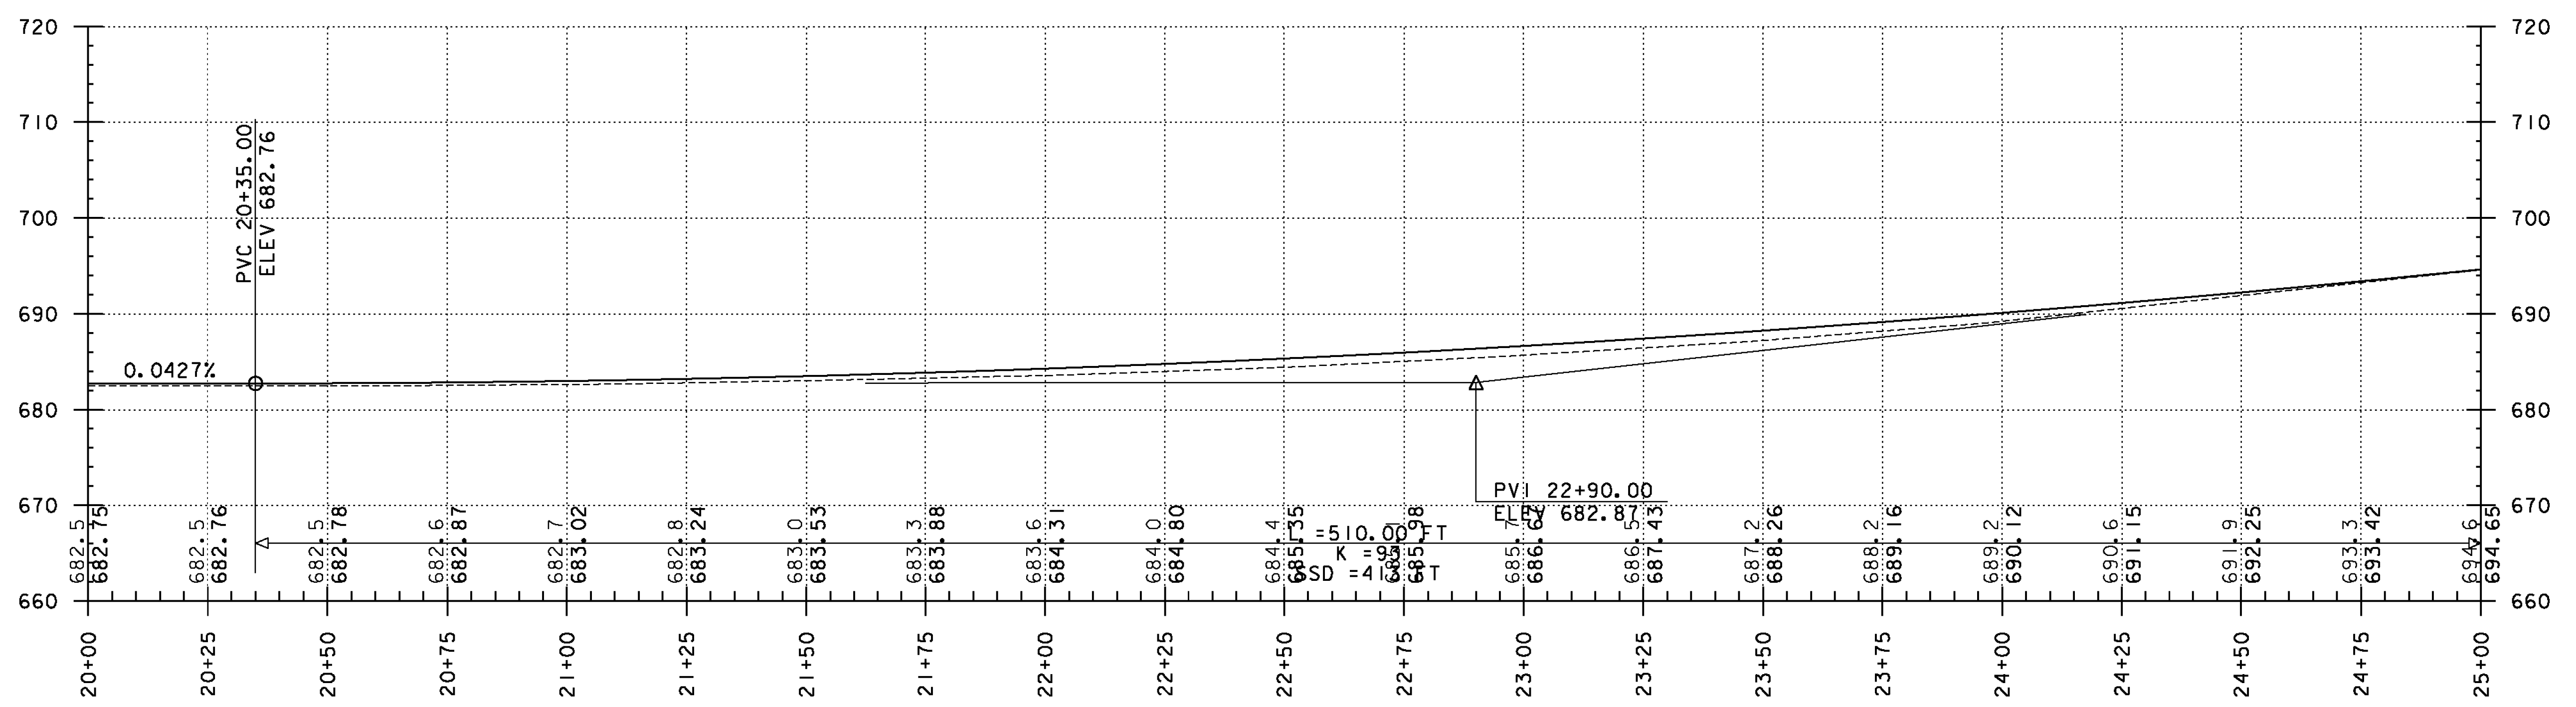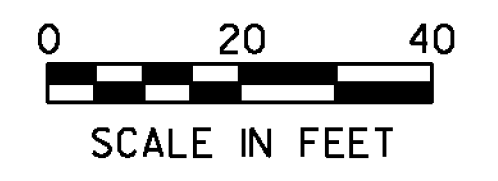

PROJECT NAME: RANDOLPH-ROXBURY
 PROJECT NUMBER: ER STP 0187(II)
 FILE NAME: z13cl82bdr.dgn PLOT DATE: 11/17/2014
 PROJECT LEADER: M. FOISY DRAWN BY: G. BURGMEIER
 DESIGNED BY: I. MAYNARD CHECKED BY: M. FOISY
PLAN & PROFILE SHEET 14 SHEET 55 OF 545

