

UNDERDRAIN FLUSHING BASIN
 STA. 27+00, RT
 26+95



DURABLE 4 INCH WHITE LINE, THERMOPLASTIC
 DURABLE 4 INCH WHITE LINE, POLYUREA
 TEMPORARY 4 INCH WHITE LINE, PAINT
 STA. 25+00 TO 30+00, SOLID LT & RT
 DURABLE 4 INCH YELLOW LINE, THERMOPLASTIC
 DURABLE 4 INCH YELLOW LINE, POLYUREA
 TEMPORARY 4 INCH YELLOW LINE, PAINT
 STA. 25+00 TO 30+00, SOLID LT & RT

EROSION LOG
 STA. 25+00 TO 27+00, RT




REMOVING SIGNS
 AS SHOWN - 2

CURVE 16 DATA
 R = 1800.00'
 $\Delta = 7^{\circ}09'36.17''$
 $D = 3^{\circ}10'59.16''$
 T = 112.62'
 L = 224.94'
 E = 3.52'
 e = 4.1%

CURVE 17 DATA
 R = 695.00'
 $\Delta = 28^{\circ}04'26.95''$
 $D = 8^{\circ}14'38.39''$
 T = 173.76'
 L = 340.54'
 E = 21.39'
 e = 7.8%

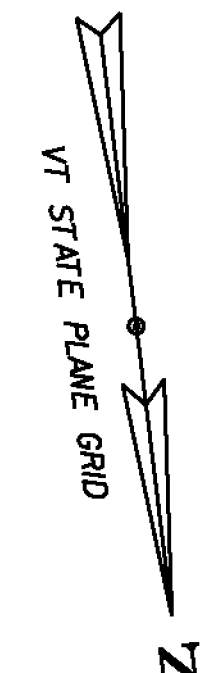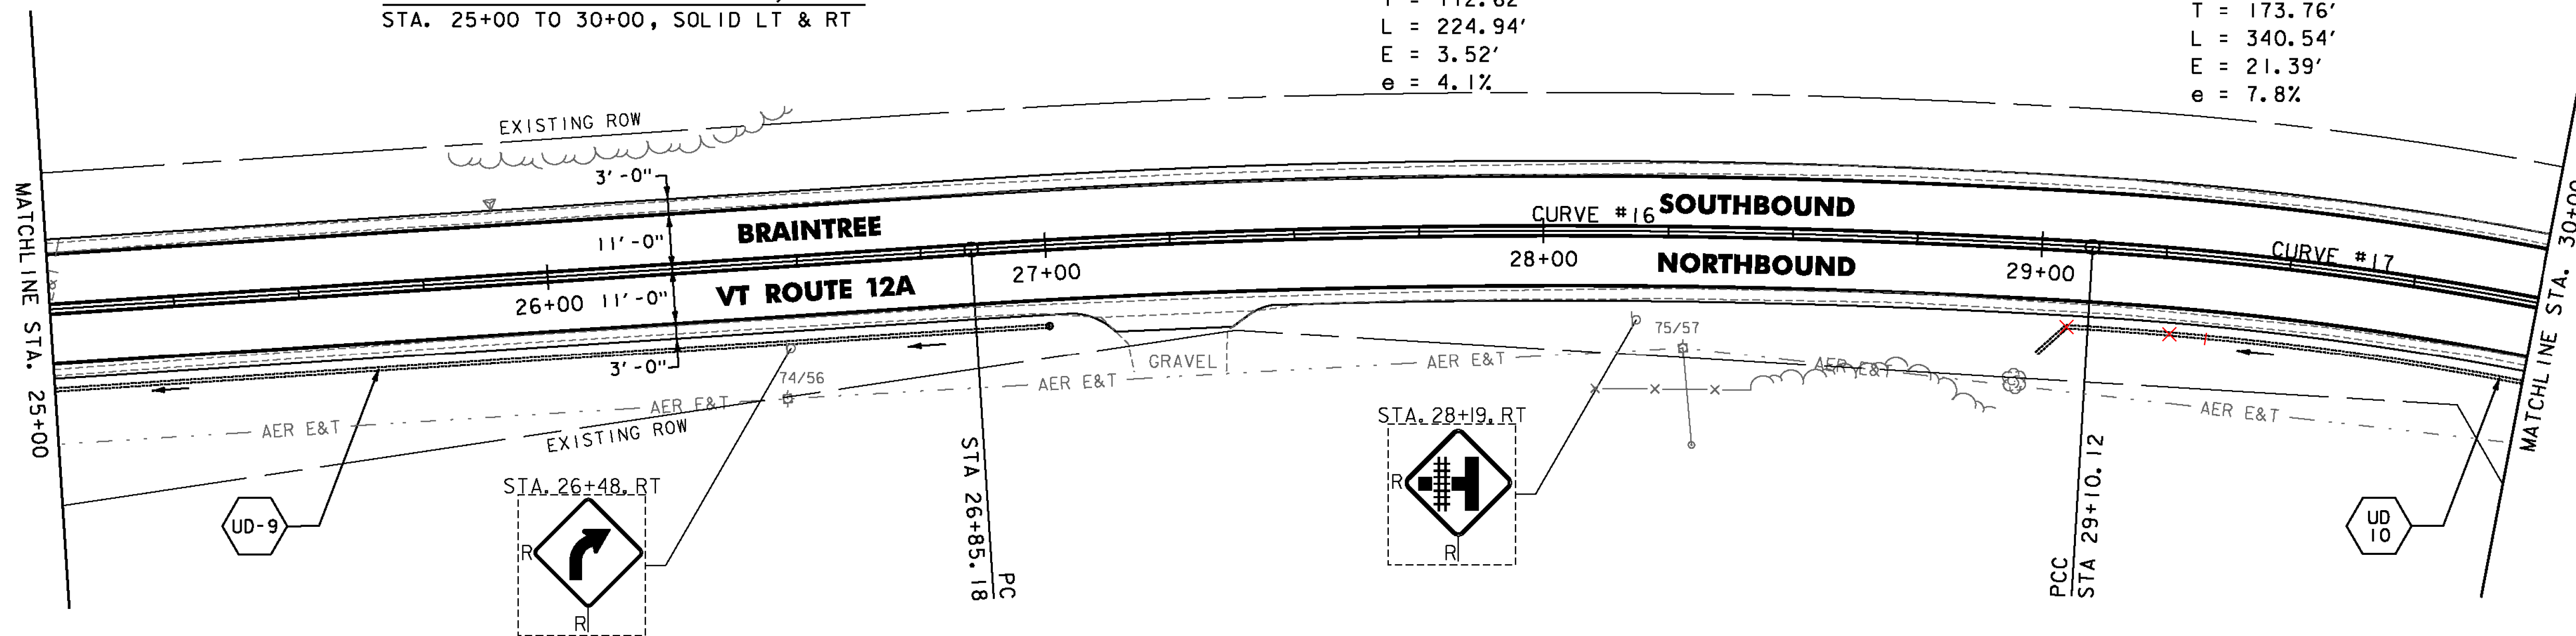

UD 10 STA. 29+00, RT TO 32+25, RT
 CONSTRUCT 6 INCH UNDERDRAIN PIPE,
 SEE SHEET 8 FOR DETAIL AND
 ASSOCIATED QUANTITIES.

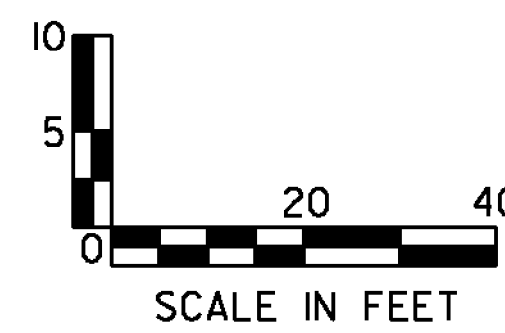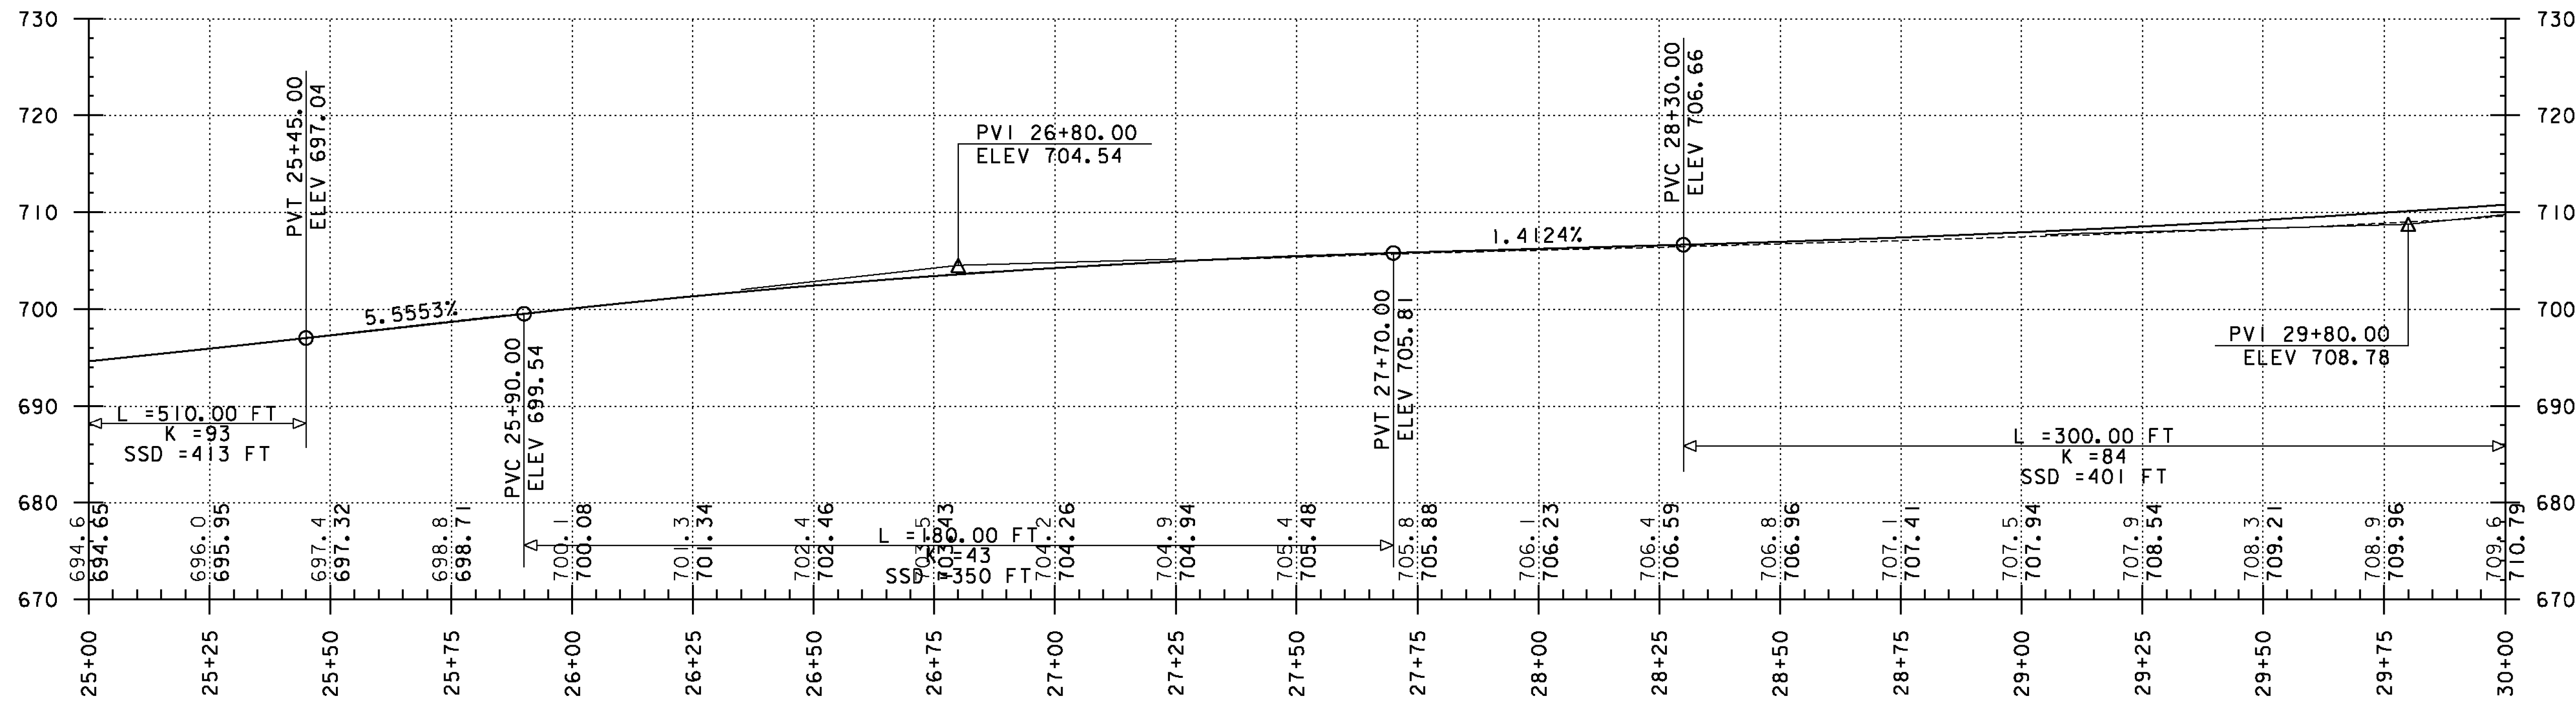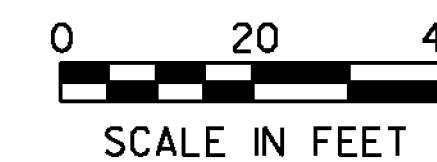

PROJECT NAME: RANDOLPH-ROXBURY
 PROJECT NUMBER: ER STP 0187(II)

FILE NAME: z13cl82bdr.dgn PLOT DATE: 11/17/2014
 PROJECT LEADER: M. FOISY DRAWN BY: G. BURGMEIER
 DESIGNED BY: I. MAYNARD CHECKED BY: M. FOISY
PLAN & PROFILE SHEET 15 SHEET 56 OF 545

