

SOLID ROCK EXCAVATION

STA. 41+40 TO 41+80, RT STA. 41+40 TO 41+75, RT
 STA. 42+15 TO 42+30, RT

UNDERDRAIN FLUSHING BASIN

STA. 43+00, RT STA. 42+90, RT
 STA. 44+50, RT

STONE FILL TYPE I, GEOTEXTILE UNDER STONE FILL & GRUBBING MATERIAL

STA. 40+00 TO 40+40, LT STA. 40+00 TO 41+30, LT
 STA. 42+96 TO 43+93, LT STA. 42+20 TO 43+77, LT
 STA. 44+04 TO 44+56, LT STA. 44+37 TO 45+00, LT

STEEL-BEAM GUARDRAIL, GALVANIZED

STA. 40+65.5 TO 42+03.0, RT

ANCHOR FOR STEEL-BEAM RAIL

STA. 40+65.5, RT
 STA. 42+03.0, RT

DURABLE 4 INCH WHITE LINE, THERMOPLASTIC

DURABLE 4 INCH WHITE LINE, POLYUREA
 TEMPORARY 4 INCH WHITE LINE, PAINT
 STA. 40+00 TO 45+00, SOLID LT & RT

DURABLE 4 INCH YELLOW LINE, THERMOPLASTIC

DURABLE 4 INCH YELLOW LINE, POLYUREA
 TEMPORARY 4 INCH YELLOW LINE, PAINT
 STA. 40+00 TO 45+00, SOLID LT & RT


GEOTEXTILE FOR SILT FENCE

STA. 40+00 TO 40+50, LT
 STA. 43+00 TO 44+50, LT
 STA. 43+11 TO 45+00, RT

REMOVING SIGNS AS SHOWN - 3

EROSION LOG



STA. 41+00 TO 43+00, RT
 STA. 44+50 TO 45+00, RT

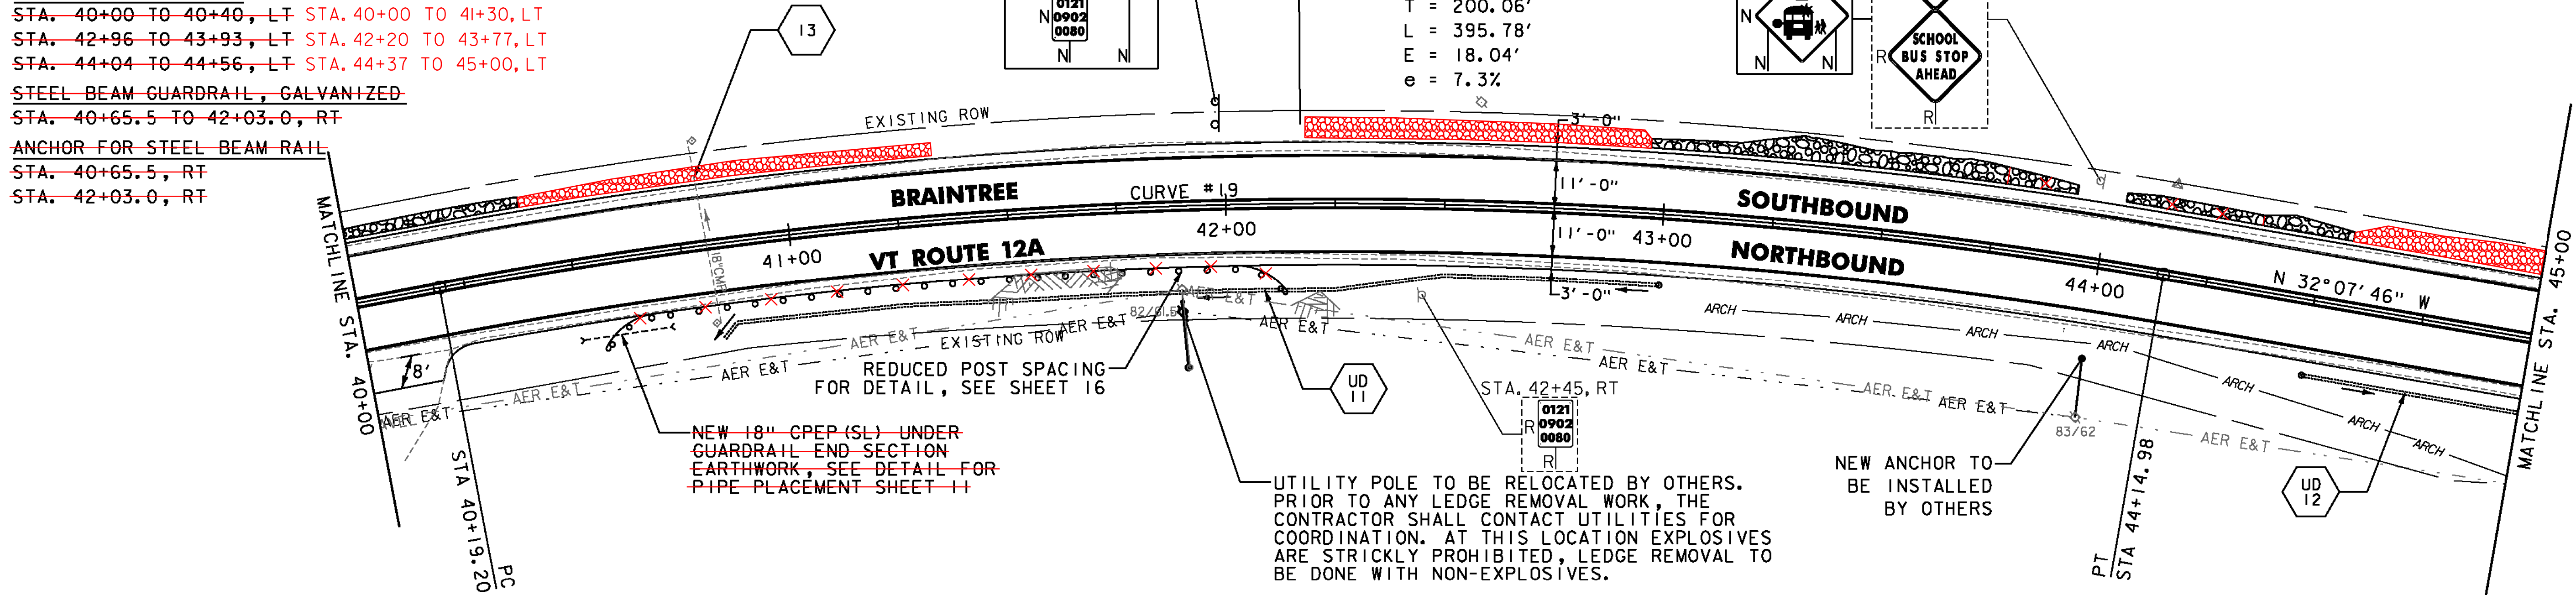

UD 11 STA 40+85, RT TO 43+00, RT
 CONSTRUCT 6 INCH UNDERDRAIN PIPE,
 SEE SHEET 8 FOR DETAIL AND
 ASSOCIATED QUANTITIES.

UD 12 STA 44+50, RT TO 45+84, RT
 CONSTRUCT 6 INCH UNDERDRAIN PIPE,
 SEE SHEET 8 FOR DETAIL AND
 ASSOCIATED QUANTITIES.

NOTE:
 1. REFER TO SHEET 27 OF 545
 FOR CULVERT INFORMATION.

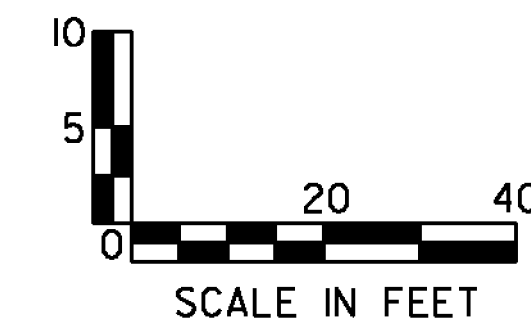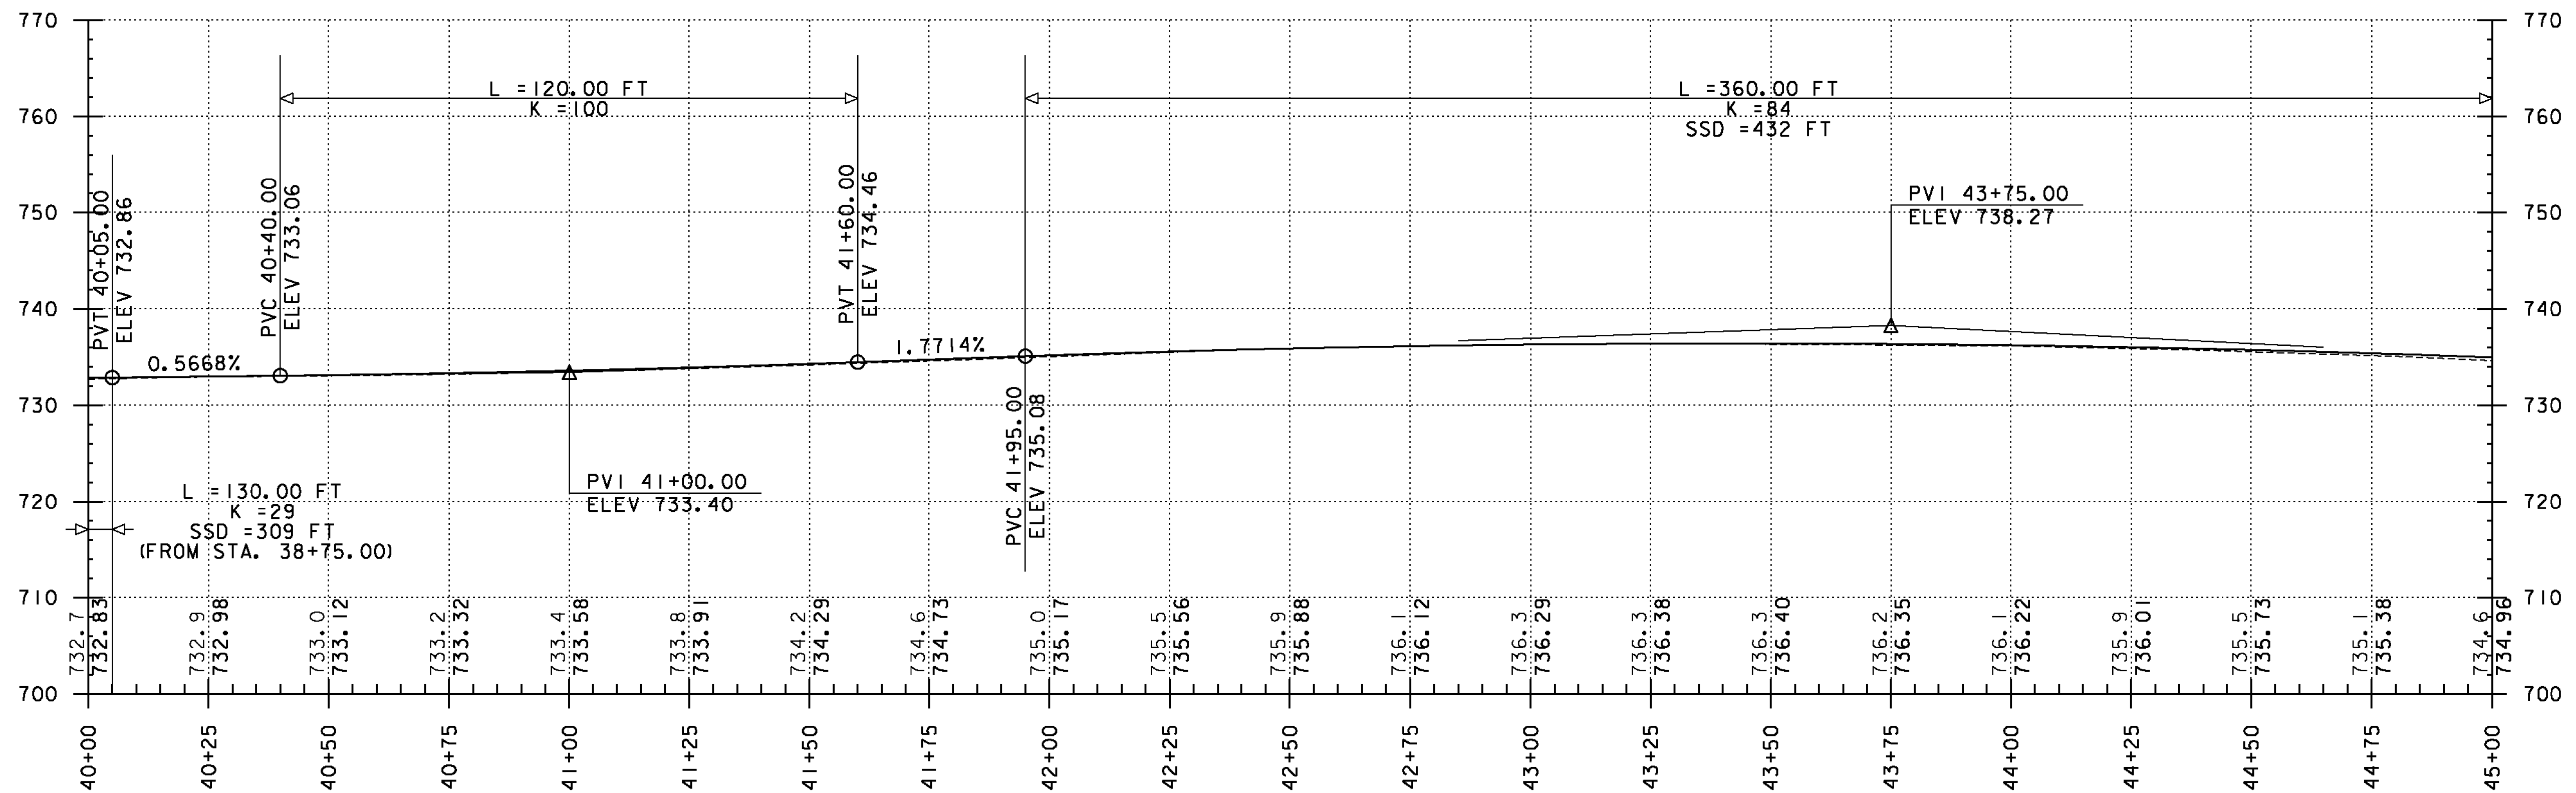

PROJECT NAME: RANDOLPH-ROXBURY
 PROJECT NUMBER: ER STP 0187(II)

FILE NAME: z13cl82bdr.dgn
 PROJECT LEADER: M. FOISY
 DESIGNED BY: I. MAYNARD
PLAN & PROFILE SHEET 18

PLOT DATE: 11/17/2014
 DRAWN BY: G. BURGMEIER
 CHECKED BY: M. FOISY
 SHEET 59 OF 545