
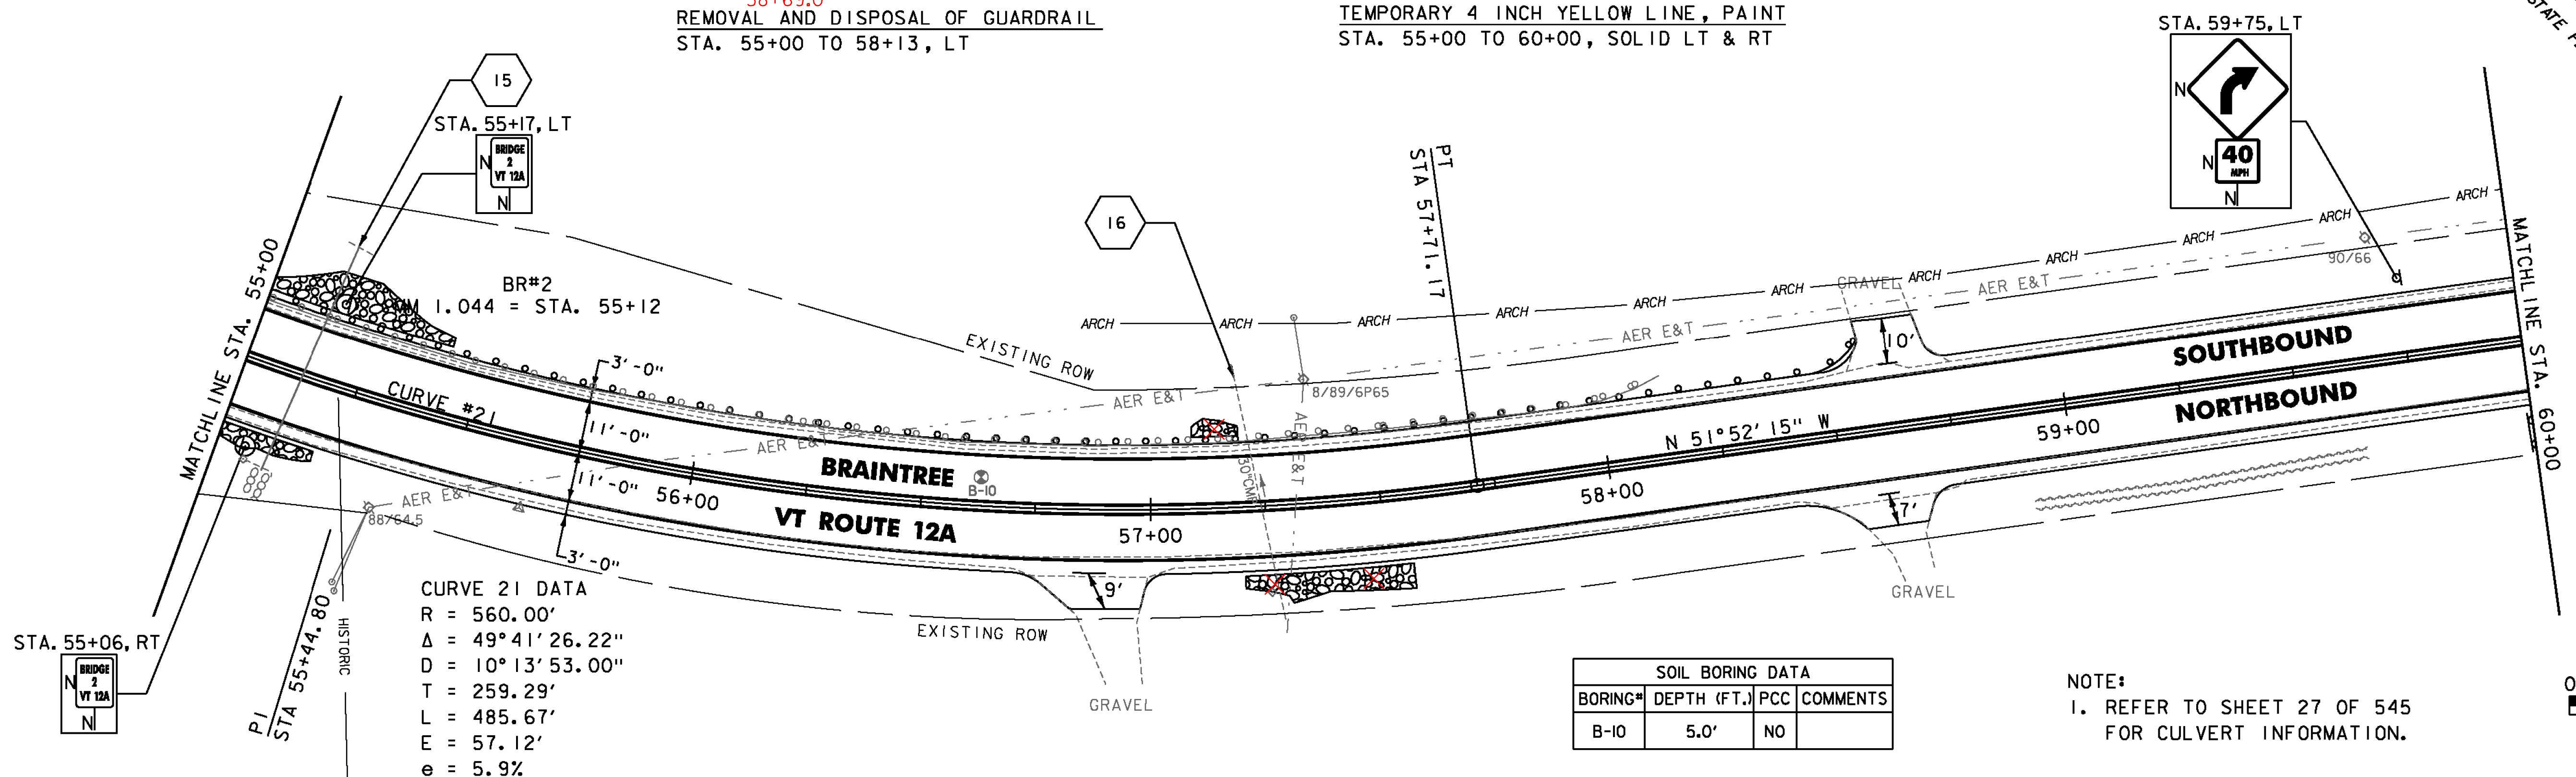


STONE FILL TYPE 1, GEOTEXTILE UNDER STONE FILL & GRUBBING MATERIAL
 STA. 55+00 TO 55+43, LT
 STA. 55+00 TO 55+20, RT STA. 55+00 TO 55+29, RT
 STA. 57+09 TO 57+20, LT
 STA. 57+20 TO 57+56, RT

STEEL BEAM GUARDRAIL, GALVANIZED
 STA. 58+31.5 TO 58+56.5, LT STA. 58+44.0 TO 58+69.0, LT
 STEEL BEAM GUARDRAIL, GALVANIZED W/ 8 FEET POSTS
 STA. 55+00.0 TO 58+31.5, LT
 ANCHOR FOR STEEL BEAM RAIL
 STA. 58+56.5, LT
 REMOVAL AND DISPOSAL OF GUARDRAIL
 STA. 55+00 TO 58+13, LT

DURABLE 4 INCH WHITE LINE, THERMOPLASTIC
 DURABLE 4 INCH WHITE LINE, POLYUREA
 TEMPORARY 4 INCH WHITE LINE, PAINT
 STA. 55+00 TO 60+00, SOLID LT & RT
 DURABLE 4 INCH YELLOW LINE, THERMOPLASTIC
 DURABLE 4 INCH YELLOW LINE, POLYUREA
 TEMPORARY 4 INCH YELLOW LINE, PAINT
 STA. 55+00 TO 60+00, SOLID LT & RT



GEOTEXTILE FOR SILT FENCE
 STA. 55+00 TO 55+25, LT
 STA. 55+00 TO 55+25, RT
 STA. 57+50 TO 58+00, RT

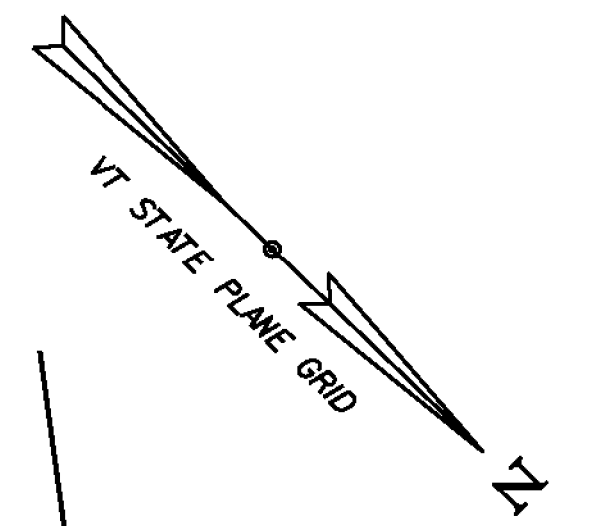

CURVE #21 DATA
 R = 560.00'
 Δ = 49° 41' 26.22"
 D = 10° 13' 53.00"
 T = 259.29'
 L = 485.67'
 E = 57.12'
 e = 5.9%

SOIL BORING DATA			
BORING#	DEPTH (FT.)	PCC	COMMENTS
B-10	5.0'	NO	

NOTE:
 1. REFER TO SHEET 27 OF 545 FOR CULVERT INFORMATION.

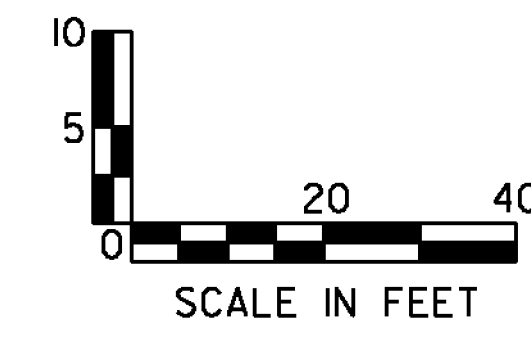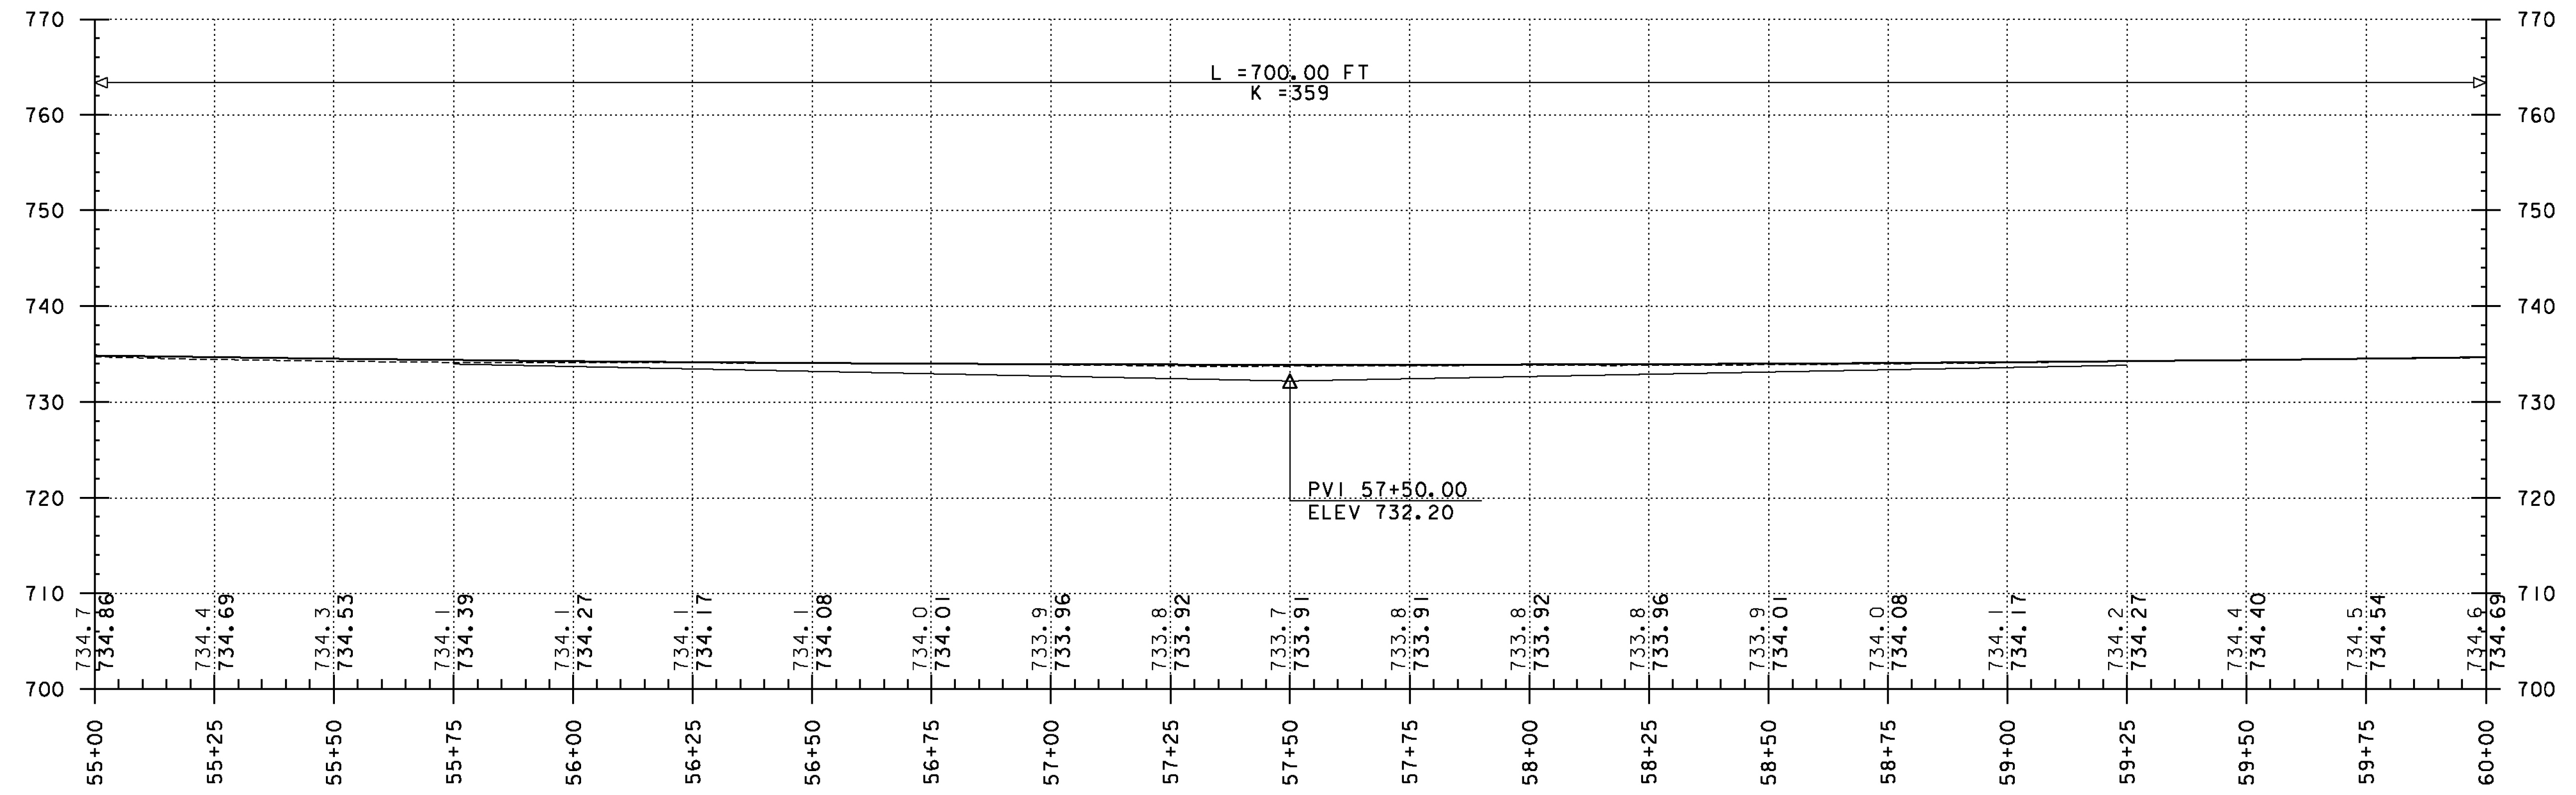

PROJECT NAME: RANDOLPH-ROXBURY
 PROJECT NUMBER: ER STP 0187(II)
 FILE NAME: z13cl82bdr.dgn
 PROJECT LEADER: M. FOISY
 DESIGNED BY: I. MAYNARD
 PLAN & PROFILE SHEET 21
 PLOT DATE: 11/17/2014
 DRAWN BY: G. BURGMEIER
 CHECKED BY: M. FOISY
 SHEET 62 OF 545

