





STONE FILL TYPE I, GEOTEXTILE UNDER STONE FILL & GRUBBING MATERIAL  
STA. 62+02 TO 63+82, LT

DURABLE 4 INCH WHITE LINE, THERMOPLASTIC  
DURABLE 4 INCH WHITE LINE, POLYUREA  
TEMPORARY 4 INCH WHITE LINE, PAINT  
STA. 60+00 TO 64+00, SOLID LT & RT

DURABLE 4 INCH YELLOW LINE, THERMOPLASTIC  
DURABLE 4 INCH YELLOW LINE, POLYUREA  
TEMPORARY 4 INCH YELLOW LINE, PAINT  
STA. 60+00 TO 64+00, SOLID LT & RT

GEOTEXTILE FOR SILT FENCE  
STA. 62+50 TO 63+50, LT

BARRIER FENCE  
STA. 60+23 TO 64+00, RT  
REMOVING SIGNS  
AS SHOWN - 3  
ERECTING SALVAGED SIGNS  
AS SHOWN - 1

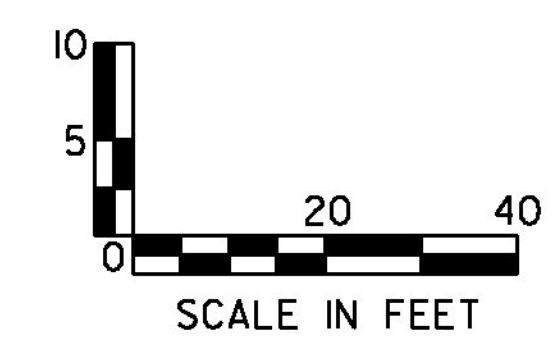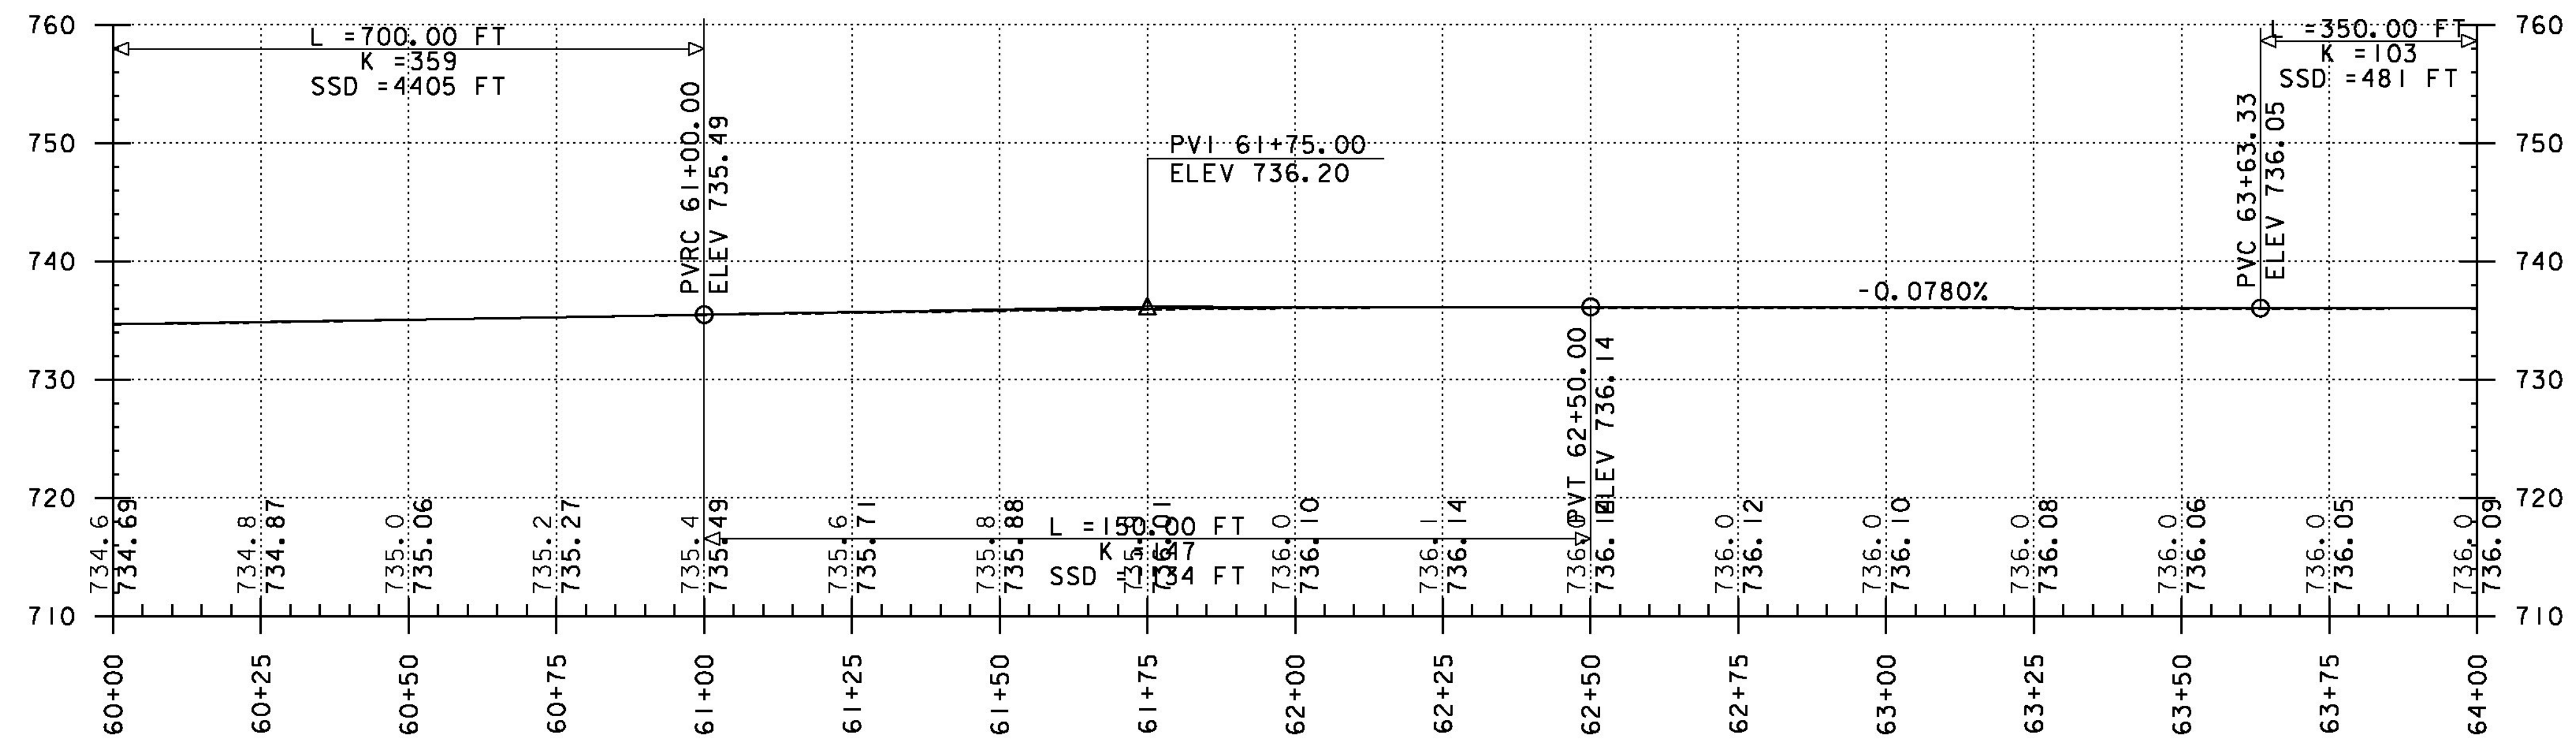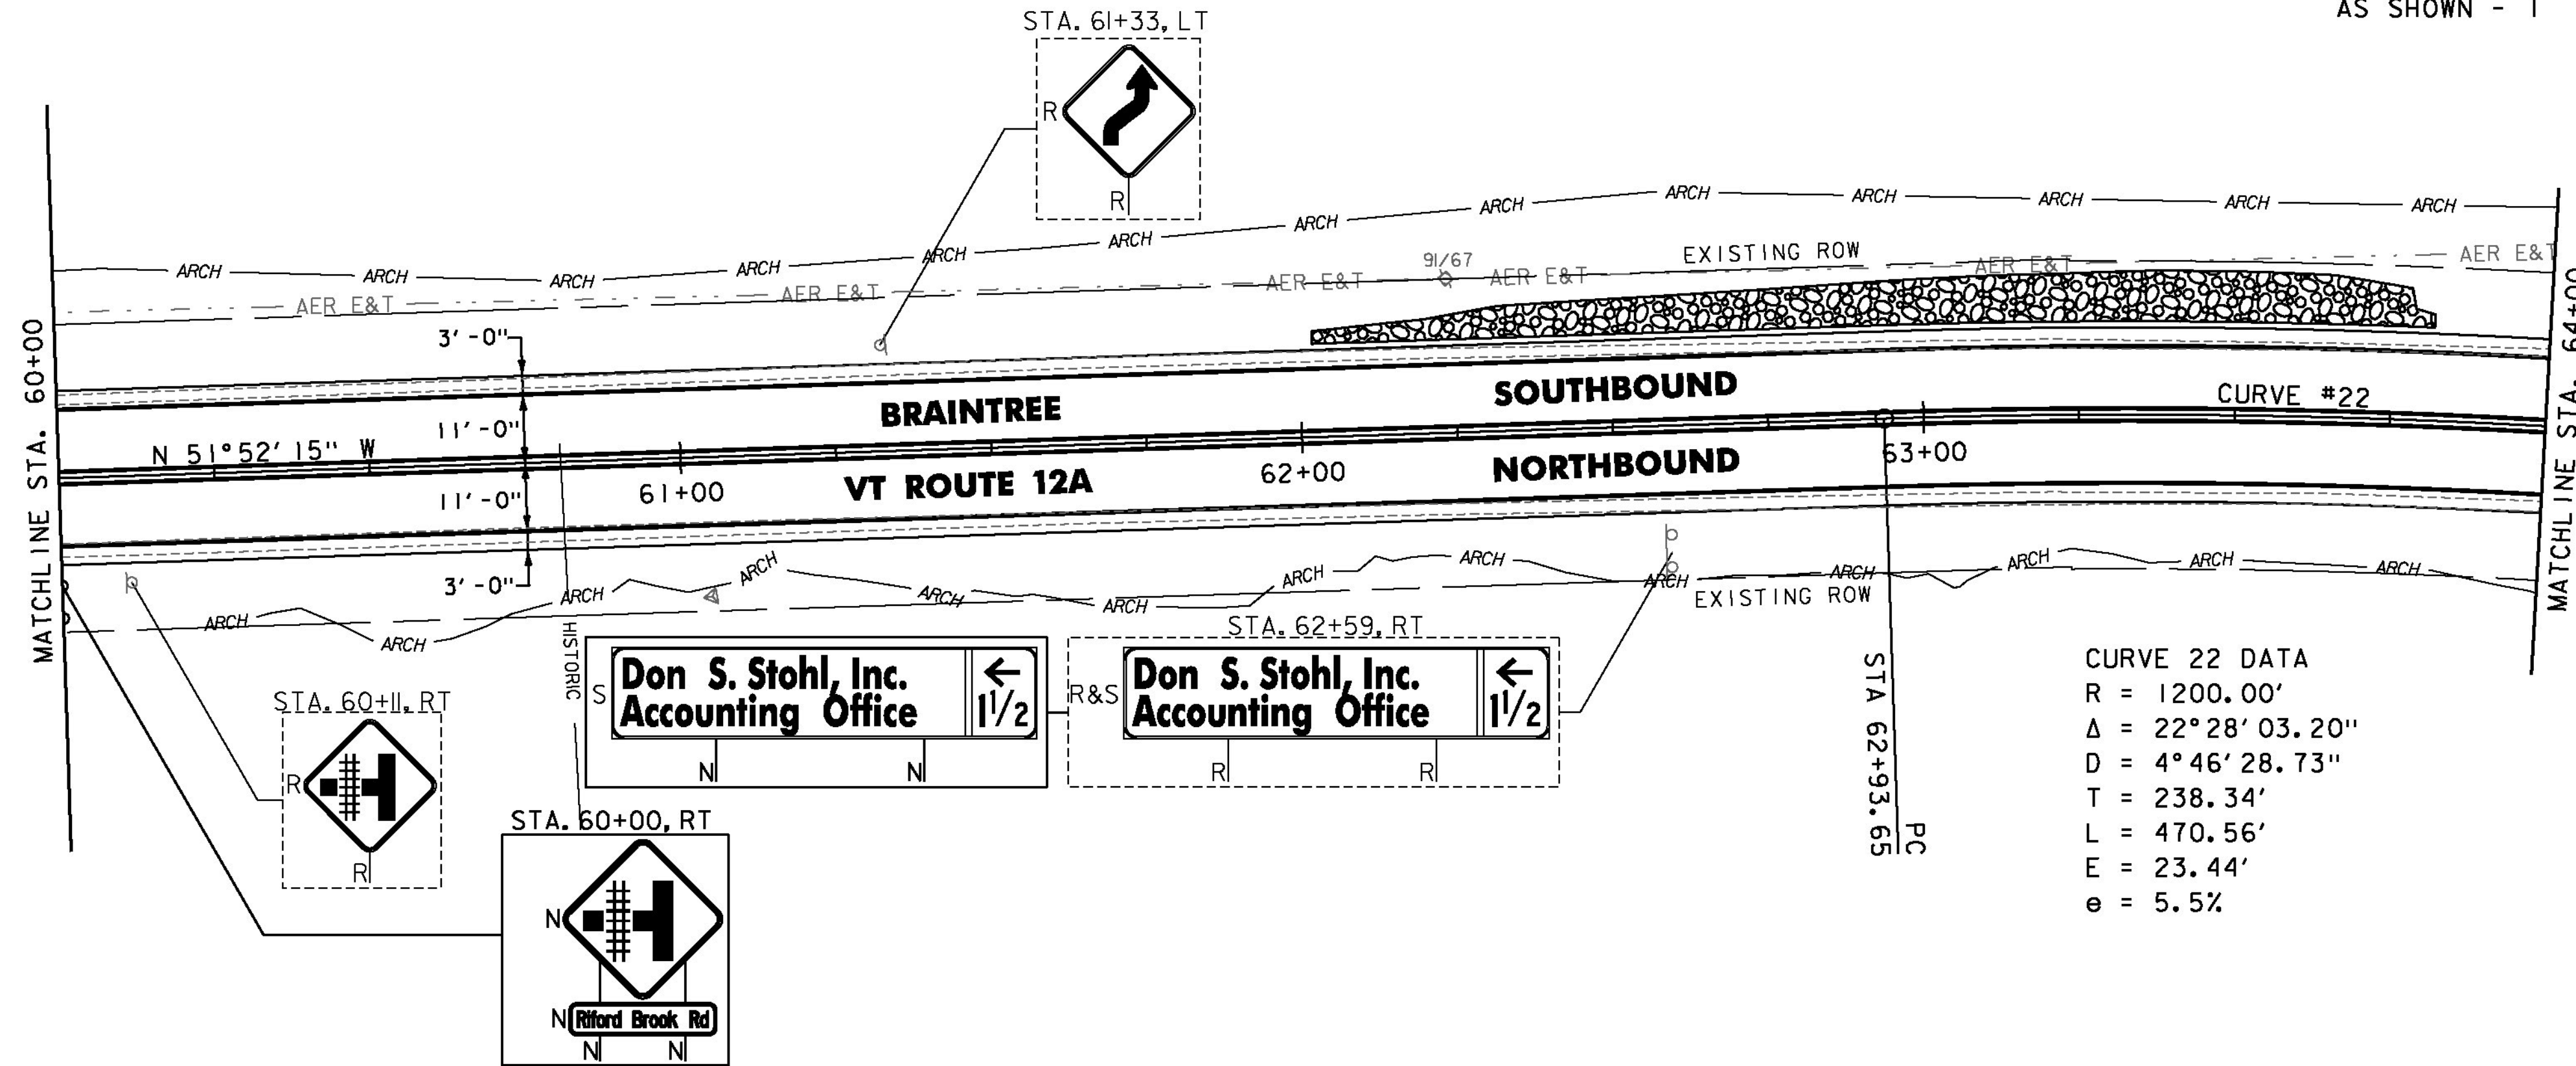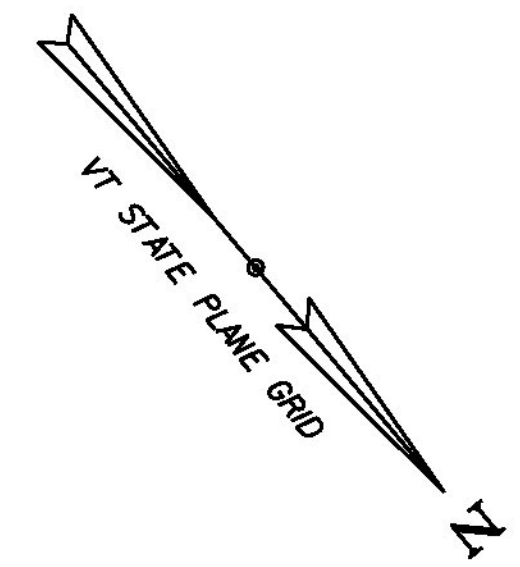

PROJECT NAME: RANDOLPH-ROXBURY  
PROJECT NUMBER: ER STP 0187(II)  
FILE NAME: z13ci82bdr.dgn  
PROJECT LEADER: M. FOISY  
DESIGNED BY: I. MAYNARD  
PLOT DATE: 11/17/2014  
DRAWN BY: G. BURGMEIER  
CHECKED BY: M. FOISY  
**PLAN & PROFILE SHEET 22**  
SHEET 63 OF 545