

~~STONE FILL TYPE 1, GEOTEXTILE UNDER STONE FILL & GRUBBING MATERIAL~~
~~STA. 99+50 TO 99+79, RT~~

RELOCATE MAILBOX, SINGLE SUPPORT


STA. 97+61, RT
 STA. 99+25, RT

DURABLE 4 INCH WHITE LINE, THERMOPLASTIC
 DURABLE 4 INCH WHITE LINE, POLYUREA
 TEMPORARY 4 INCH WHITE LINE, PAINT
 (ALL LINES WILL INCLUDE EDGE LINE BREAKS AND RADII FOR SIDE ROADS)
 STA. 94+00 TO 100+00, SOLID LT & RT

DURABLE 4 INCH YELLOW LINE, THERMOPLASTIC
 DURABLE 4 INCH YELLOW LINE, POLYUREA
 TEMPORARY 4 INCH YELLOW LINE, PAINT
 (ALL LINES WILL INCLUDE ϕ BREAK FOR SIDE ROADS)
 STA. 94+00 TO 100+00, SOLID LT & RT
 STA. 96+57, RT (DUCLOS RD)

DURABLE 24 INCH STOP BAR, THERMOPLASTIC
 DURABLE 24 INCH STOP BAR, POLYUREA
 TEMPORARY 24 INCH STOP BAR, PAINT
 STA. 95+27, RT "STOP" (DUCLOS RD) (18 LF)
 STA. 96+43, RT "STOP" (DUCLOS RD) (21 LF)
 DURABLE LETTER OR SYMBOL, THERMOPLASTIC
 DURABLE LETTER OR SYMBOL, POLYUREA
 STA. 95+27, RT "STOP" (DUCLOS RD)
 STA. 96+43, RT "STOP" (DUCLOS RD)



BARRIER FENCE
 STA. 97+29 TO 99+00, RT
 REMOVING SIGNS
 AS SHOWN - 5

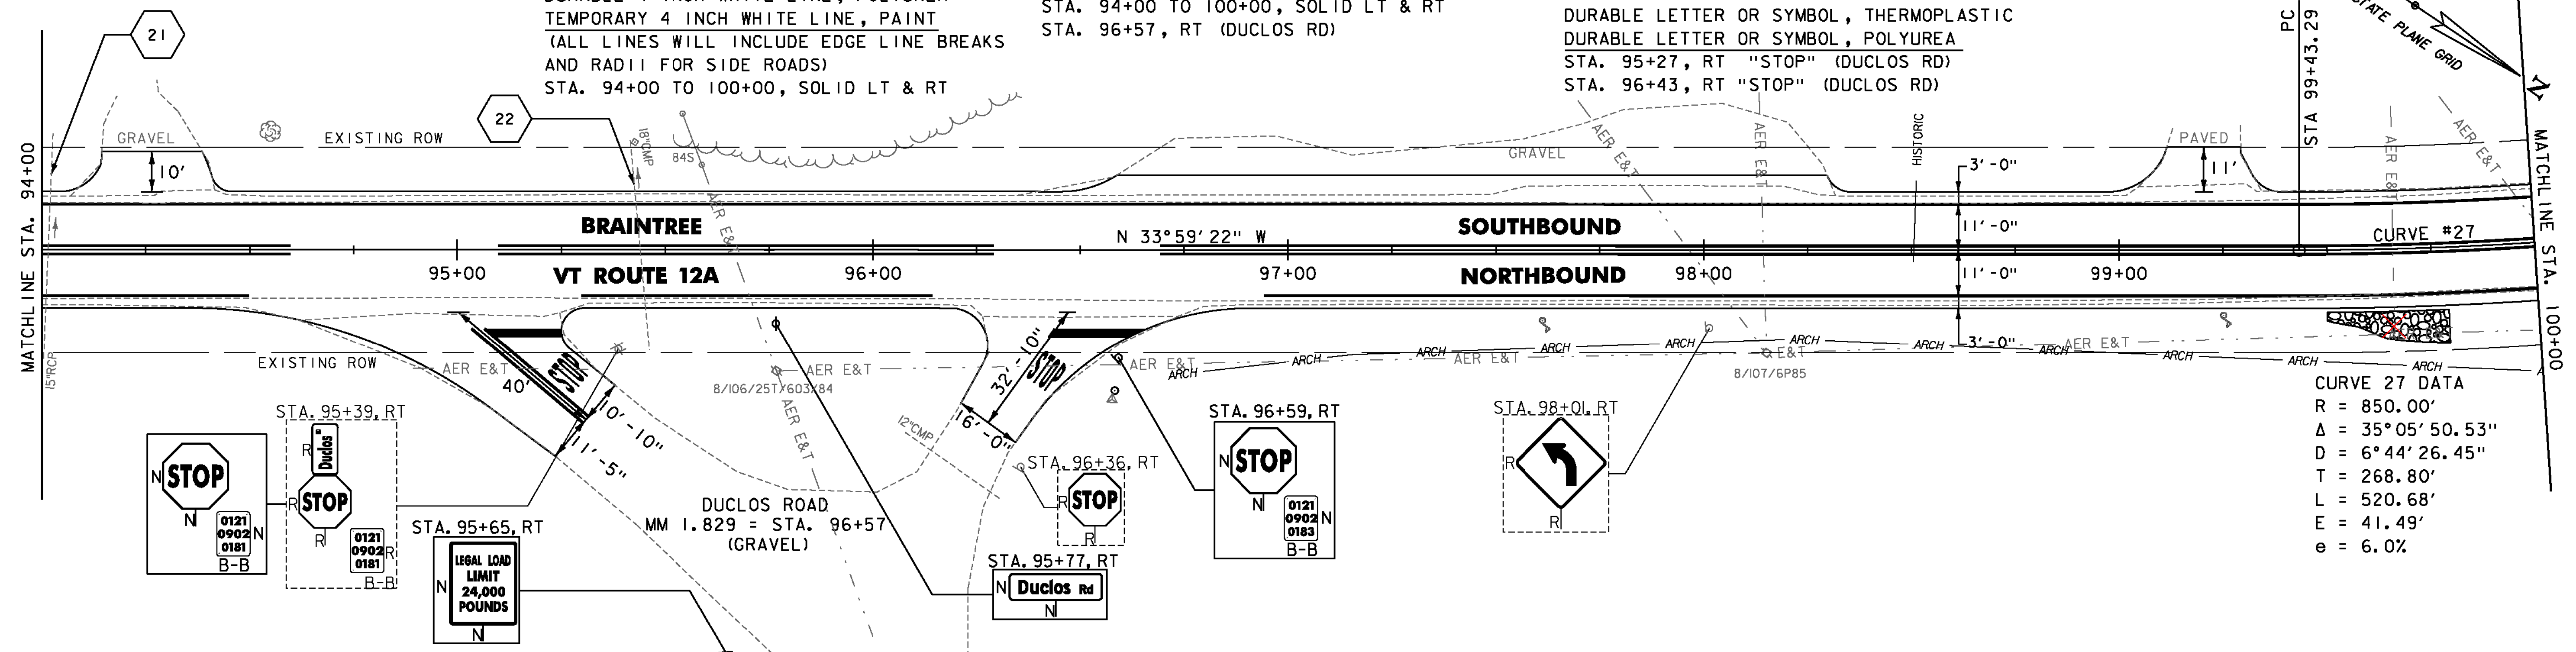

CURVE 27 DATA
 R = 850.00'
 Δ = 35°05'50.53"
 D = 6°44'26.45"
 T = 268.80'
 L = 520.68'
 E = 41.49'
 e = 6.0%

NOTE:
 1. REFER TO SHEET 27 OF 545 FOR CULVERT INFORMATION.

0 20 40
 SCALE IN FEET

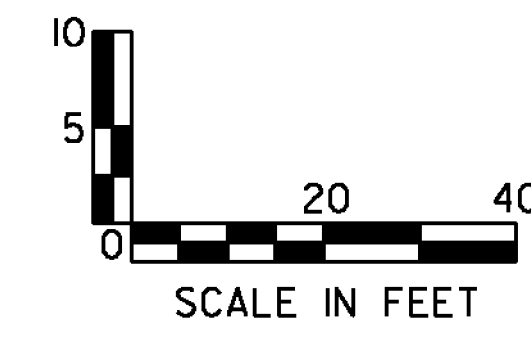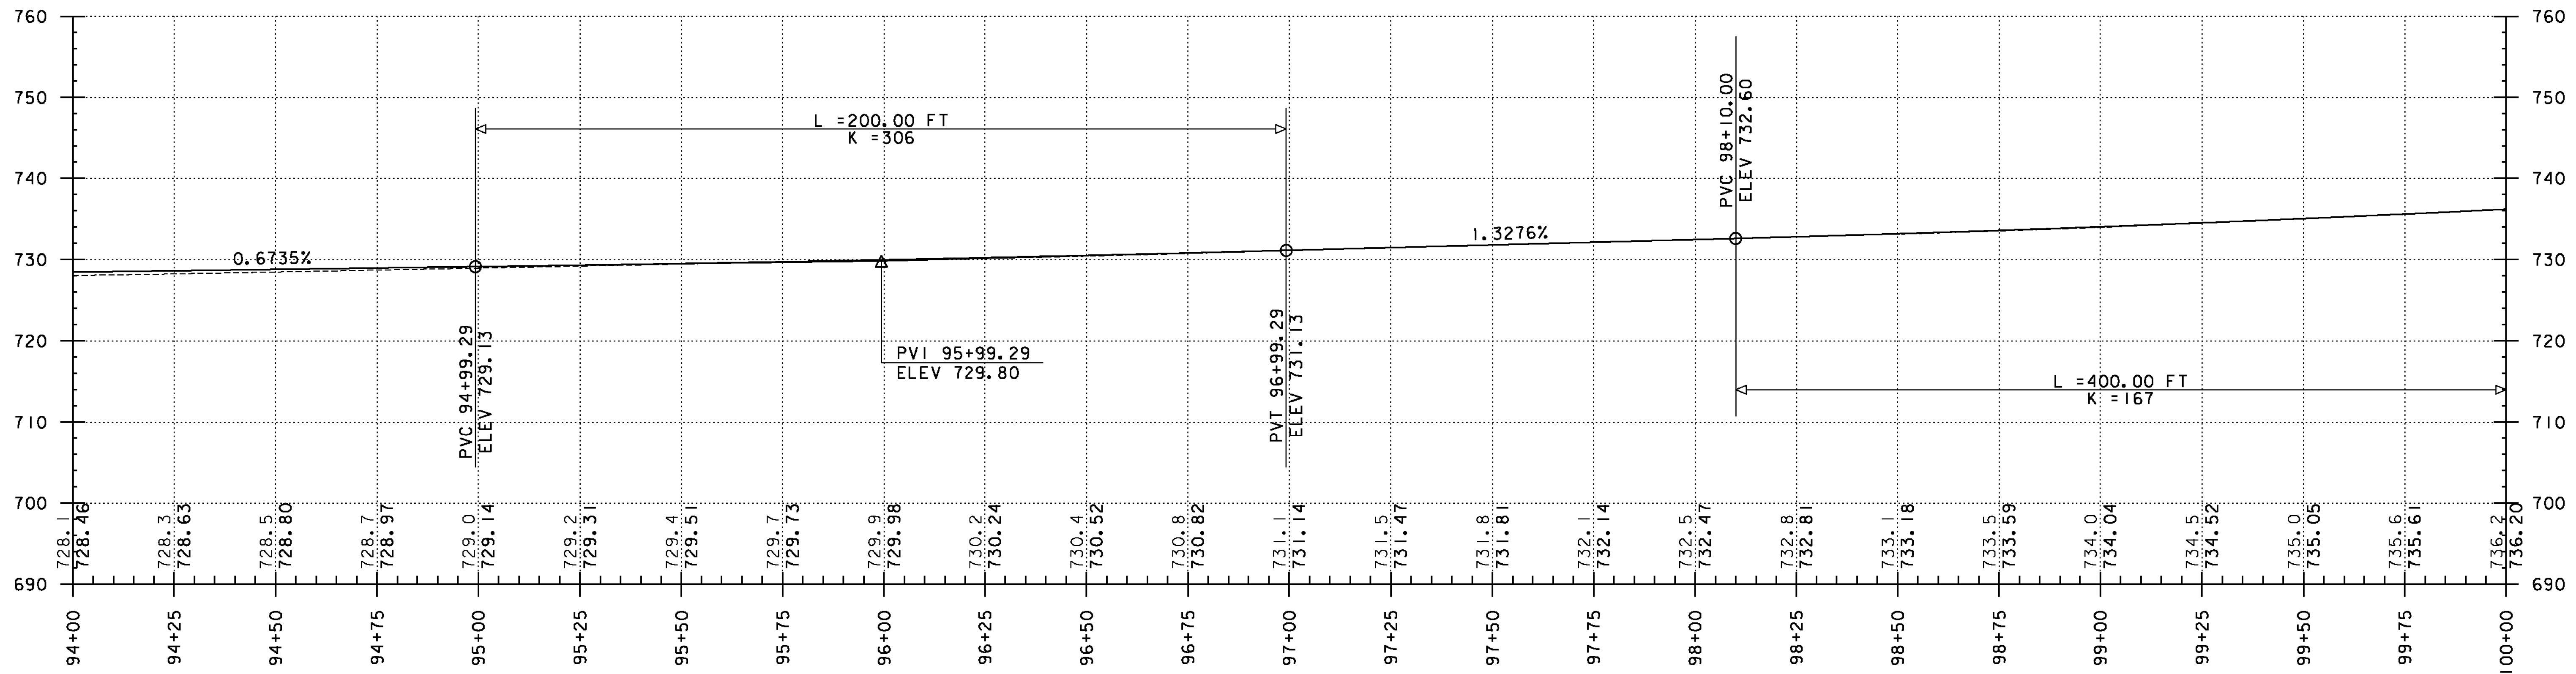

PROJECT NAME: RANDOLPH-ROXBURY
 PROJECT NUMBER: ER STP 0187(II)
 FILE NAME: z13cl82bdr.dgn
 PROJECT LEADER: M. FOISY
 DESIGNED BY: I. MAYNARD
 PLAN & PROFILE SHEET 29

PLOT DATE: 11/17/2014
 DRAWN BY: G. BURGMEIER
 CHECKED BY: M. FOISY
 SHEET 70 OF 545

