

STONE FILL TYPE I, GEOTEXTILE UNDER STONE FILL & GRUBBING MATERIAL  
 STA. 110+59 TO 111+25, RT


RELOCATE MAILBOX, SINGLE SUPPORT  
 STA. 114+08, RT

STEEL BEAM GUARDRAIL, GALVANIZED  
 STA. 112+17.5 TO 112+42.5, LT STA. 111+42.5 TO 112+30, LT  
 STEEL BEAM GUARDRAIL, GALVANIZED W/ 8 FEET POSTS  
 STA. 110+00.0 TO 112+17.5, LT  
 ANCHOR FOR STEEL BEAM RAIL  
 STA. 112+42.5, LT  
 REMOVAL AND DISPOSAL OF GUARDRAIL  
 STA. 110+00 TO 111+48, LT

CURVE 28 DATA  
 R = 1800.00'  
 $\Delta = 9^\circ 56' 55.80''$   
 $D = 3^\circ 10' 59.16''$   
 T = 156.67'  
 L = 312.55'  
 E = 6.81'  
 $e = 5.5\%$




DURABLE 4 INCH WHITE LINE, THERMOPLASTIC  
 DURABLE 4 INCH WHITE LINE, POLYUREA  
 TEMPORARY 4 INCH WHITE LINE, PAINT  
 STA. 110+00 TO 115+00, SOLID LT & RT  
 DURABLE 4 INCH YELLOW LINE, THERMOPLASTIC  
 DURABLE 4 INCH YELLOW LINE, POLYUREA  
 TEMPORARY 4 INCH YELLOW LINE, PAINT  
 STA. 110+00 TO 115+00, SOLID LT & RT

GEOTEXTILE FOR SILT FENCE  
 STA. 111+00 TO 111+50, RT  
 EROSION LOG  
 STA. 110+00 TO 111+50, RT

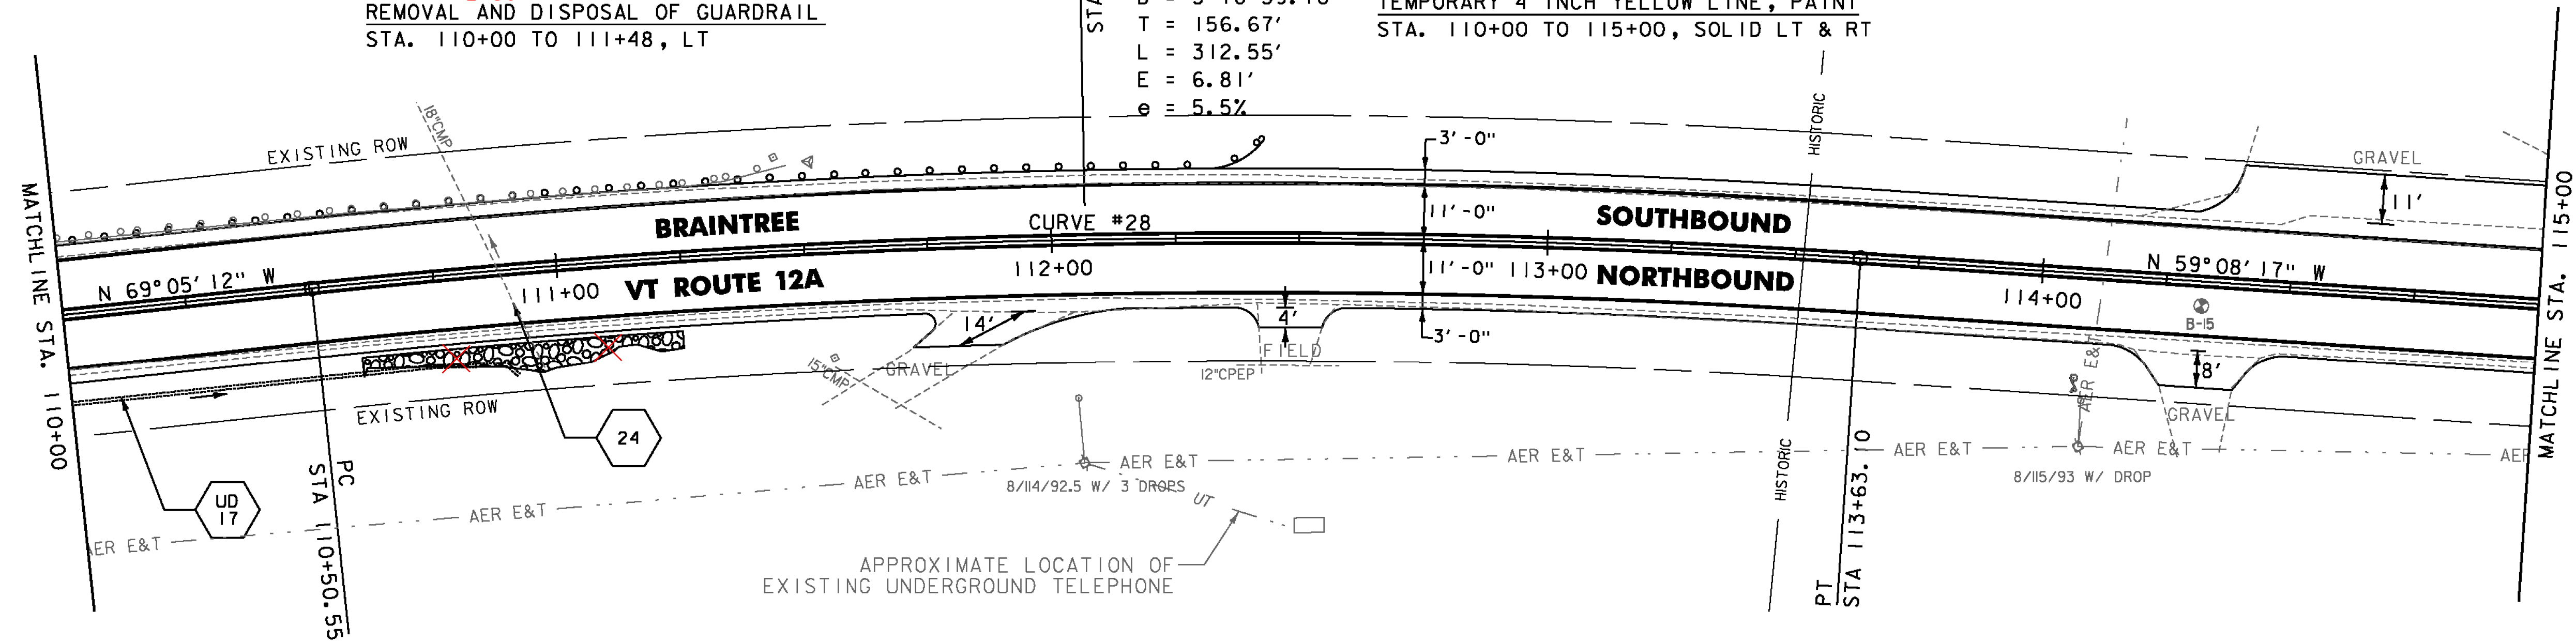

SOIL BORING DATA			
BORING#	DEPTH (FT.)	PCC	COMMENTS
B-15	5.0'	NO	

NOTE:  
 1. REFER TO SHEET 27 OF 545 FOR CULVERT INFORMATION.

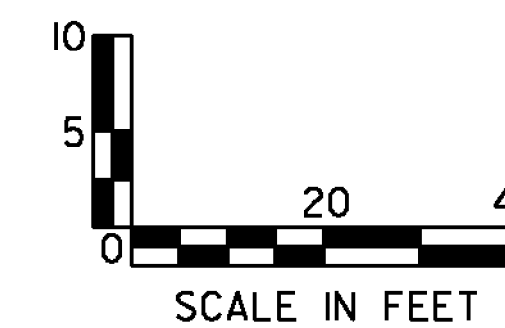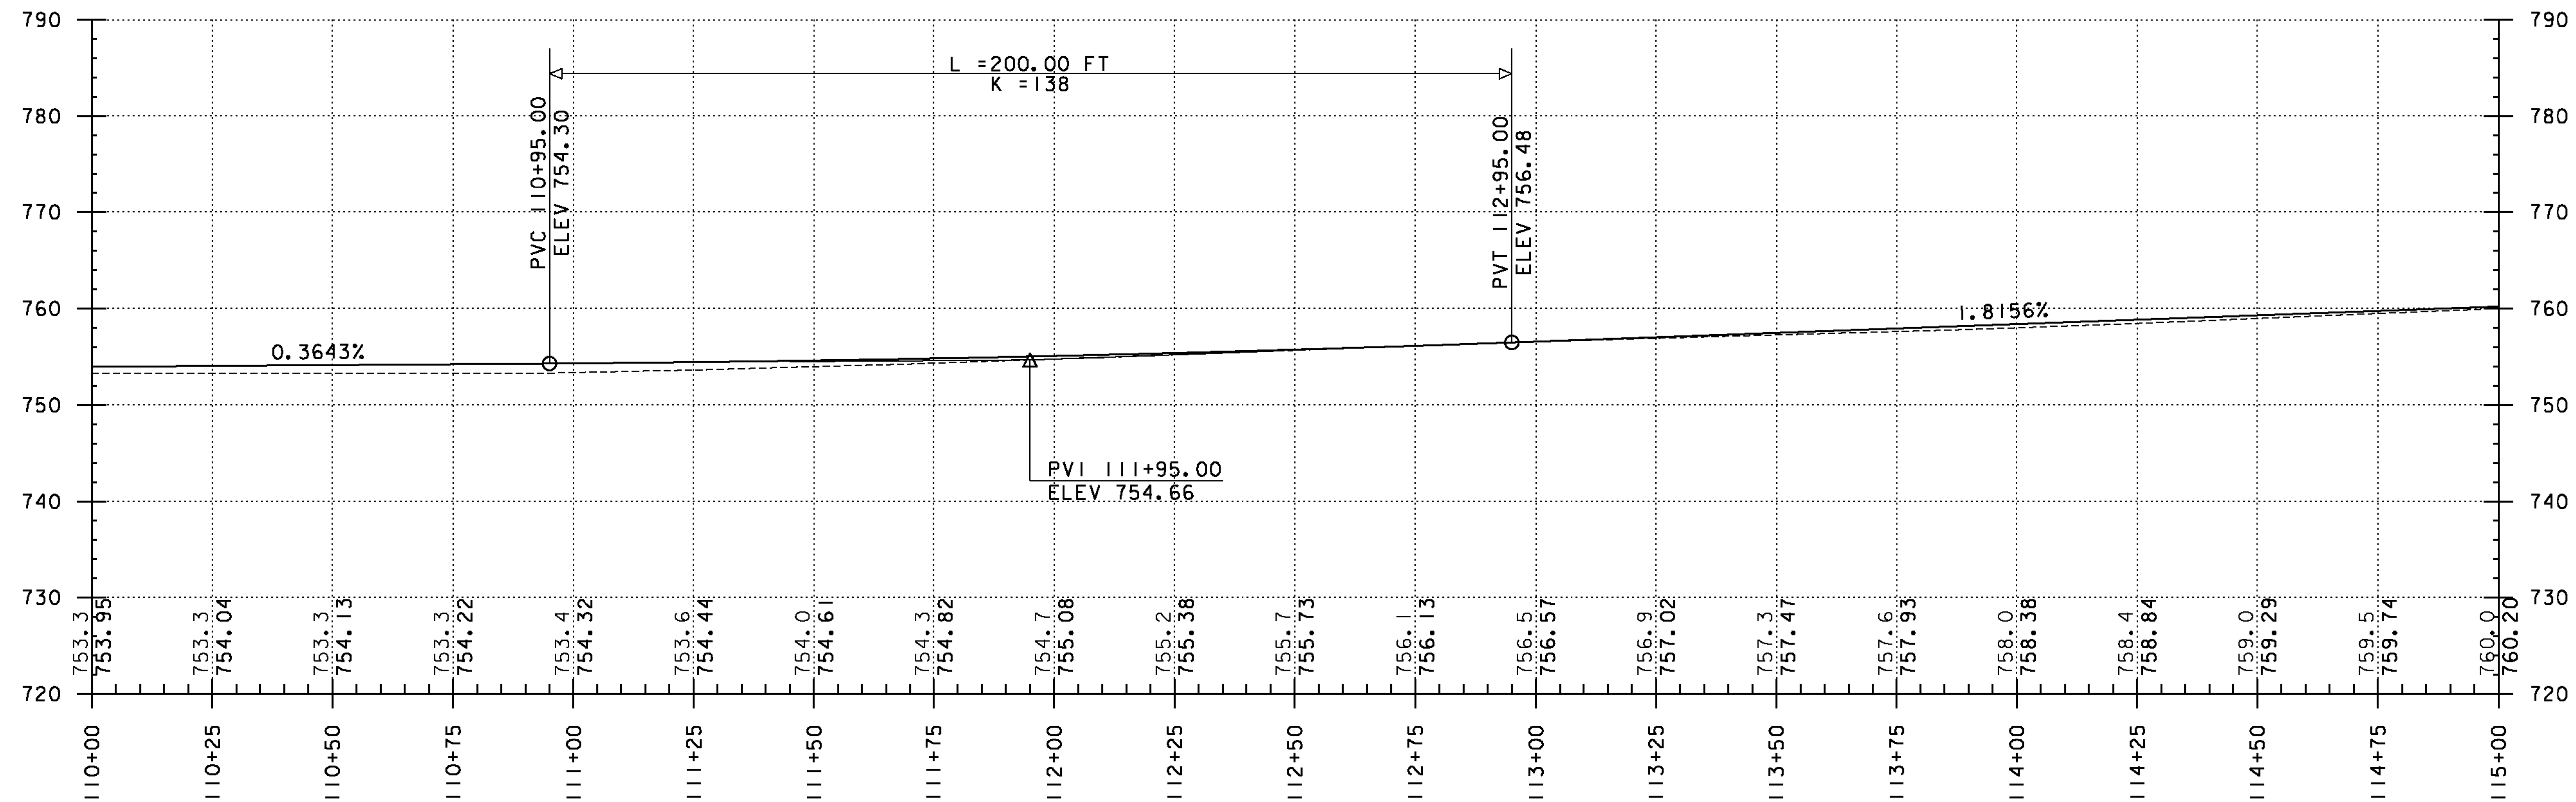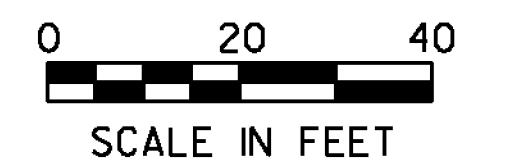

PROJECT NAME: RANDOLPH-ROXBURY  
 PROJECT NUMBER: ER STP 0187(II)

FILE NAME: z13cl82bdr.dgn  
 PROJECT LEADER: M. FOISY  
 DESIGNED BY: I. MAYNARD  
 PLAN & PROFILE SHEET 32

PLOT DATE: 11/17/2014  
 DRAWN BY: G. BURGMEIER  
 CHECKED BY: M. FOISY  
 SHEET 73 OF 545