


~~STONE FILL TYPE 1, GEOTEXTILE UNDER STONE FILL & GRUBBING MATERIAL~~  
~~STA. 117+65 TO 117+75, LT~~  
~~sta. 118+75 TO 118+90, LT~~  
 RELOCATE MAILBOX, SINGLE SUPPORT  
 STA. 119+75, RT

STEEL BEAM GUARDRAIL, GALVANIZED  
 STA. 116+05.0 TO 116+30.0, LT STA. 116+05.0 TO 116+17.5, LT  
 STA. 118+11.5 TO 118+47.0, RT  
 STA. 119+18.5 TO 119+43.5, RT  
 STEEL BEAM GUARDRAIL, GALVANIZED W/ 8 FEET POSTS  
 STA. 116+30.0 TO 120+00.0, LT STA. 116+17.5 TO 120+00, LT  
 STA. 118+47.0 TO 119+18.5, RT STA. 118+11.5 TO 119+43.5, RT

ANCHOR FOR STEEL BEAM RAIL  
 STA. 116+05.0, LT  
 STA. 118+07.0, RT STA. 118+11.5, RT  
 STA. 119+43.5, RT  
 REMOVAL AND DISPOSAL OF GUARDRAIL  
 STA. 116+98 TO 120+00, LT  
 STA. 118+09 TO 119+45, RT




DURABLE 4 INCH WHITE LINE, THERMOPLASTIC  
 DURABLE 4 INCH WHITE LINE, POLYUREA  
 TEMPORARY 4 INCH WHITE LINE, PAINT  
 STA. 115+00 TO 120+00, SOLID LT & RT  
 DURABLE 4 INCH YELLOW LINE, THERMOPLASTIC  
 DURABLE 4 INCH YELLOW LINE, POLYUREA  
 TEMPORARY 4 INCH YELLOW LINE, PAINT  
 STA. 115+00 TO 120+00, SOLID LT & RT

BARRIER FENCE  
 STA. 117+41 TO 119+61, RT  
 EROSION LOG  
 STA. 118+21 TO 118+71, RT  
 REMOVING SIGNS  
 AS SHOWN - 2

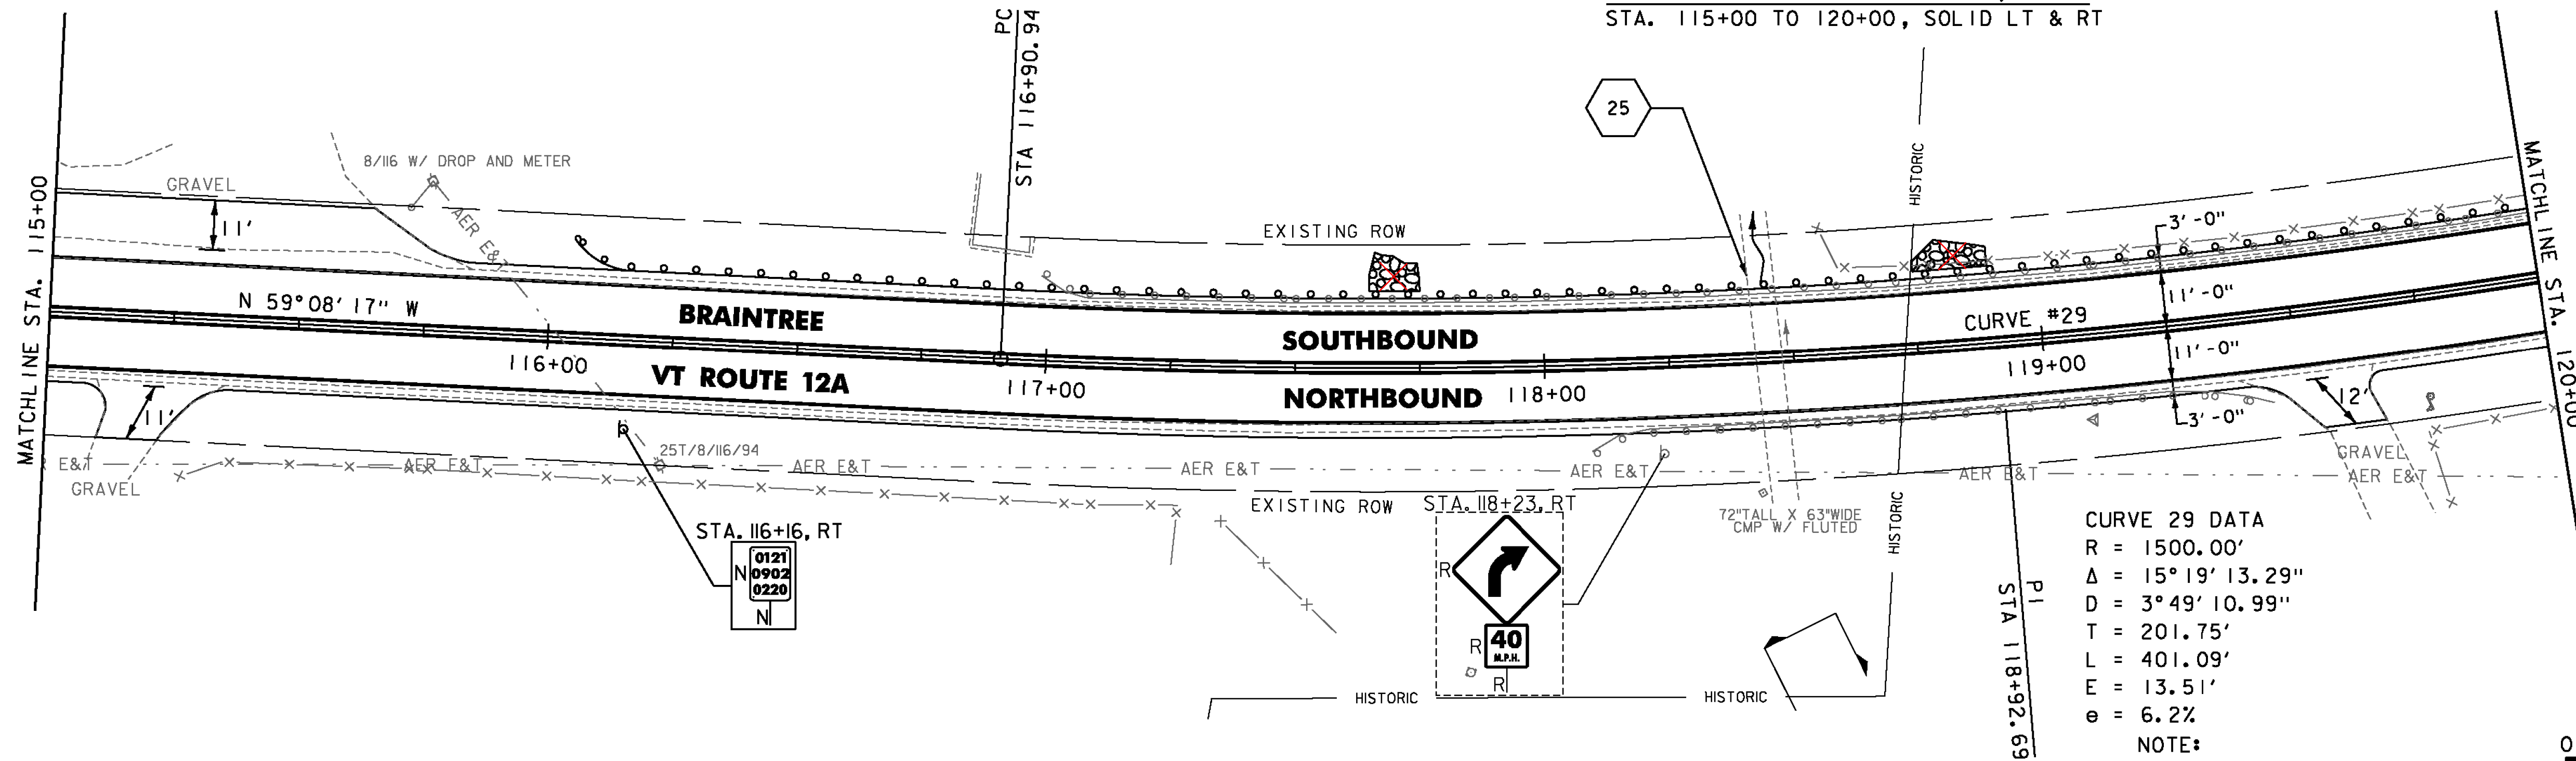

**CURVE 29 DATA**  
 R = 1500.00'  
 Δ = 15° 19' 13.29"  
 D = 3° 49' 10.99"  
 T = 201.75'  
 L = 401.09'  
 E = 13.51'  
 e = 6.2%

NOTE:  
 1. REFER TO SHEET 27 OF 545 FOR CULVERT INFORMATION.

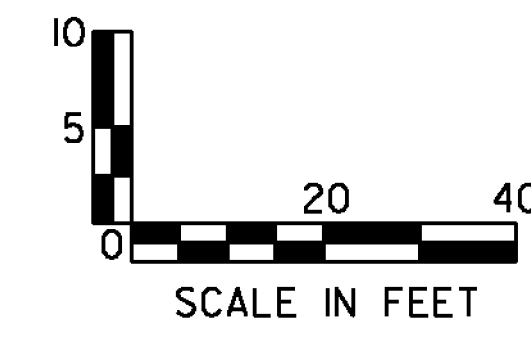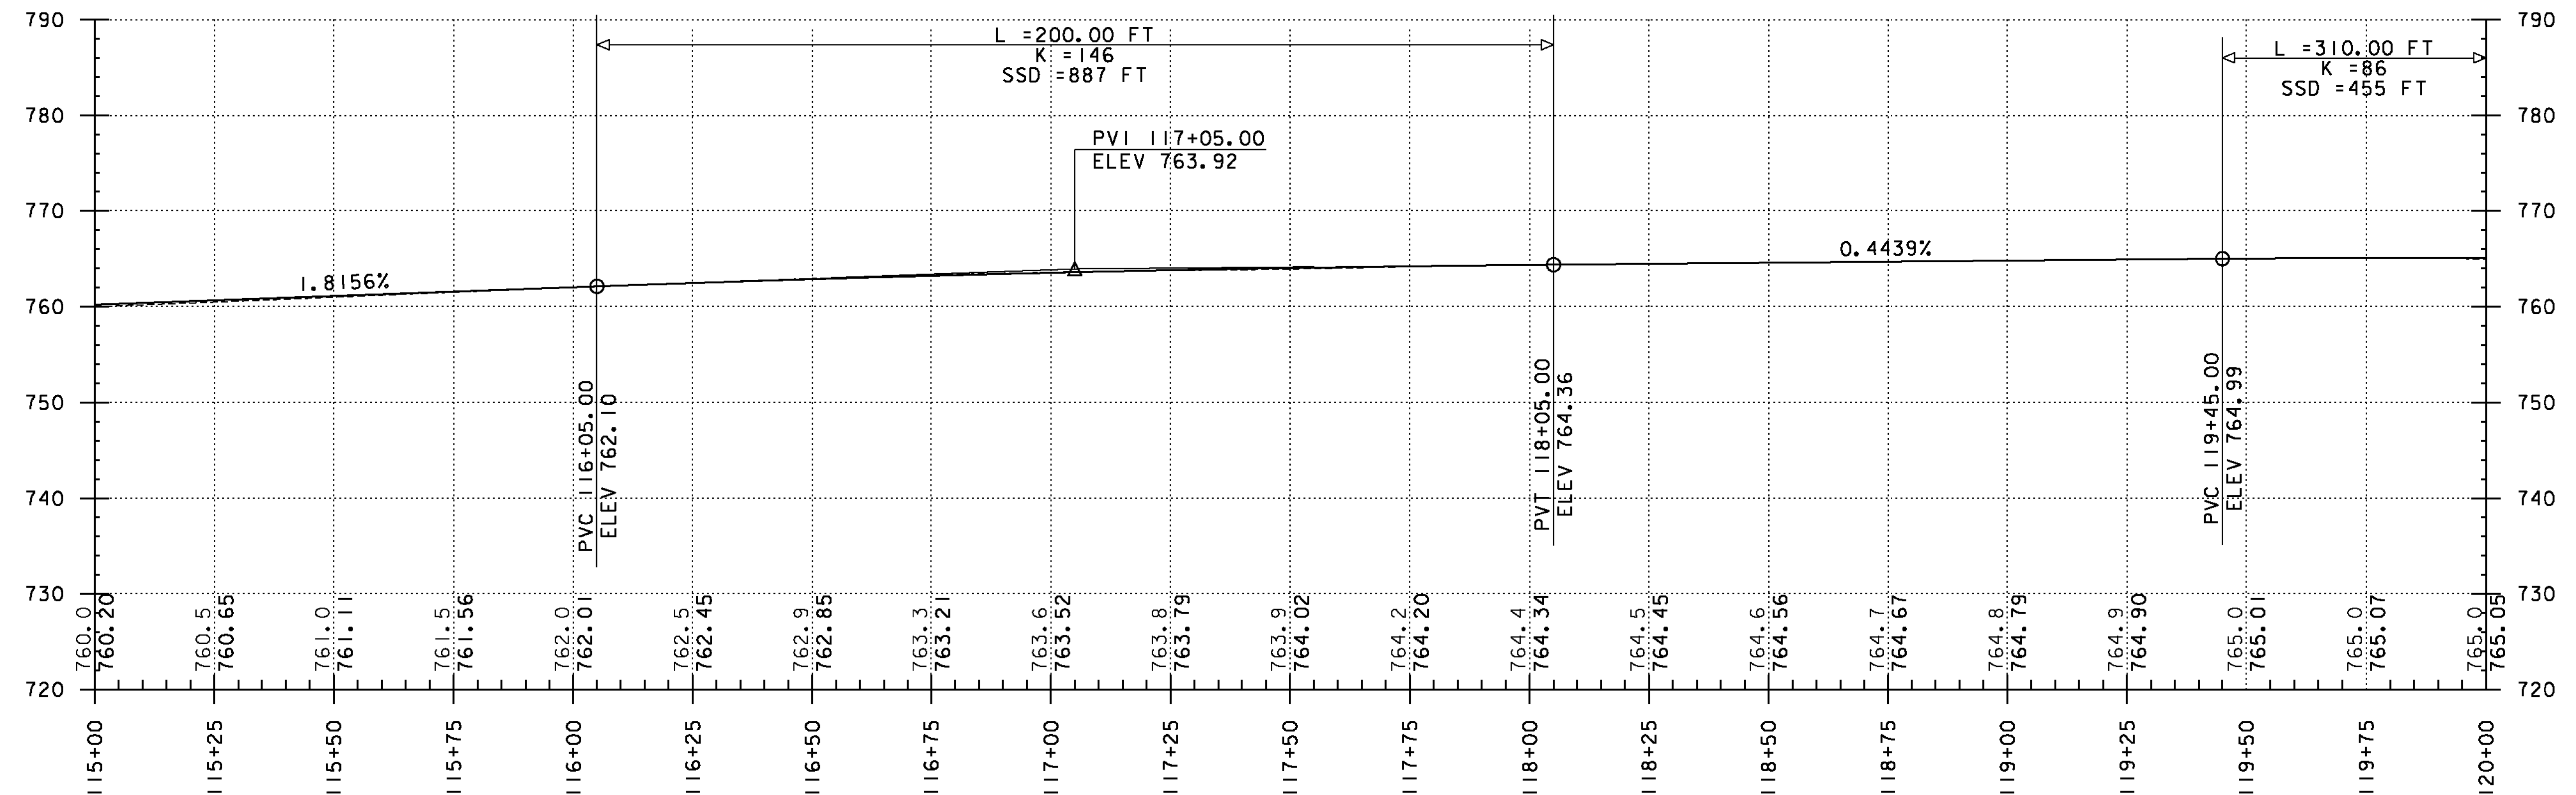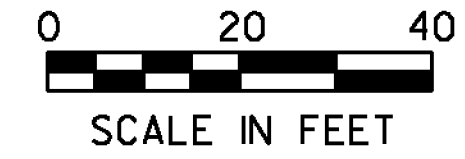

PROJECT NAME: RANDOLPH-ROXBURY  
 PROJECT NUMBER: ER STP 0187(II)  
 FILE NAME: z13cl82bdr.dgn  
 PROJECT LEADER: M. FOISY  
 DESIGNED BY: I. MAYNARD  
 PLAN & PROFILE SHEET 33  
 PLOT DATE: 11/17/2014  
 DRAWN BY: G. BURMEIER  
 CHECKED BY: M. FOISY  
 SHEET 74 OF 545

