
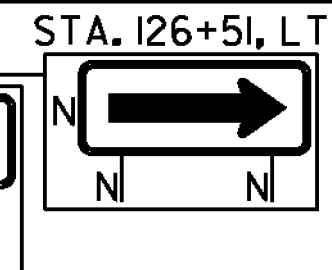
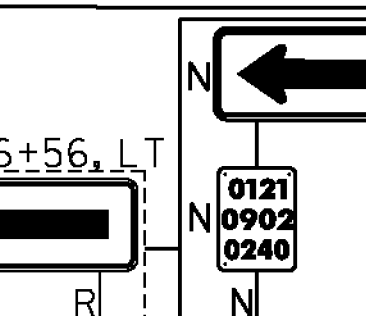
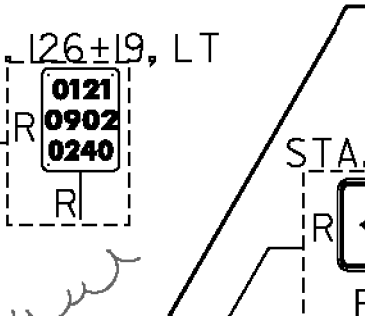
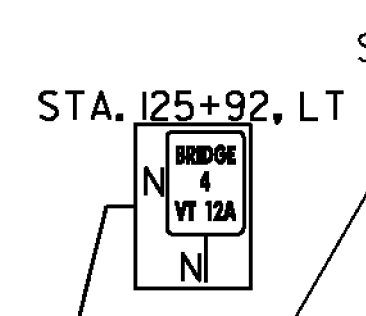
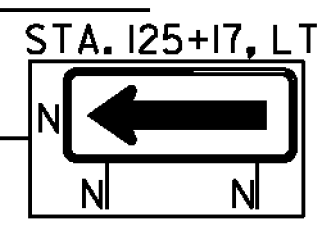



SOLID ROCK EXCAVATION
 STA. 125+00 TO 125+10, RT
 STA. 125+00 TO 125+75, RT
 STONE FILL TYPE 1, GEOTEXTILE UNDER STONE FILL
 & GRUBBING MATERIAL
 STA. 125+21 TO 126+47, RT

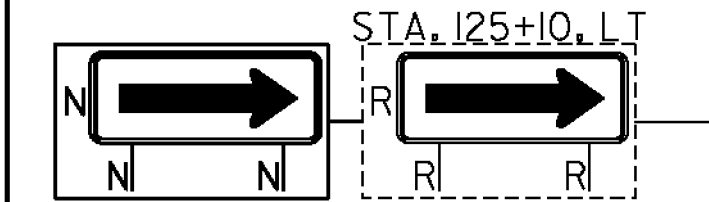

CURVE 31 DATA
 R = 680.00'
 $\Delta = 14^{\circ}40'24.87''$
 D = $8^{\circ}25'33.06''$
 T = 87.55'
 L = 174.15'
 E = 5.61'
 e = 5.6%

DURABLE 4 INCH WHITE LINE, THERMOPLASTIC
 DURABLE 4 INCH WHITE LINE, POLYUREA
 TEMPORARY 4 INCH WHITE LINE, PAINT
 STA. 125+00 TO 130+00, SOLID LT & RT

DURABLE 4 INCH YELLOW LINE, THERMOPLASTIC
 DURABLE 4 INCH YELLOW LINE, POLYUREA
 TEMPORARY 4 INCH YELLOW LINE, PAINT
 STA. 125+00 TO 130+00, SOLID LT & RT


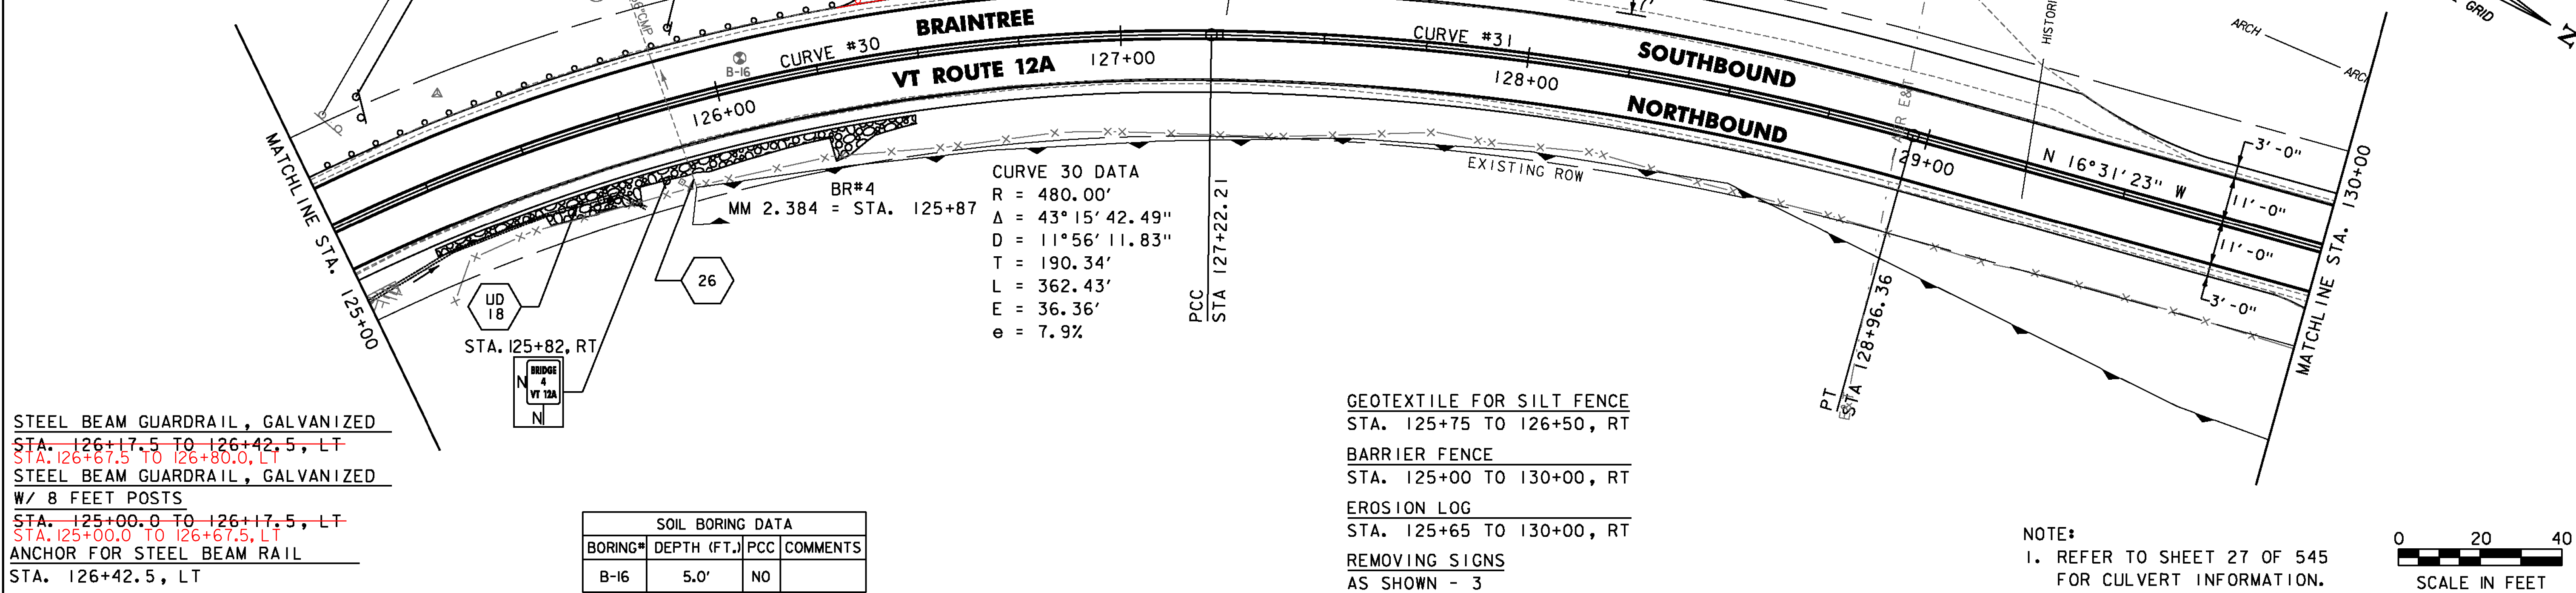


STEEL BEAM GUARDRAIL, GALVANIZED
 STA. 126+17.5 TO 126+42.5, LT
 STA. 126+67.5 TO 126+80.0, LT
 STEEL BEAM GUARDRAIL, GALVANIZED
 W/ 8 FEET POSTS
 STA. 125+00.0 TO 126+17.5, LT
 STA. 125+00.0 TO 126+67.5, LT
 ANCHOR FOR STEEL BEAM RAIL
 STA. 126+42.5, LT

SOIL BORING DATA			
BORING#	DEPTH (FT.)	PCC	COMMENTS
B-16	5.0'	NO	

GEOTEXTILE FOR SILT FENCE
 STA. 125+75 TO 126+50, RT
 BARRIER FENCE
 STA. 125+00 TO 130+00, RT
 EROSION LOG
 STA. 125+65 TO 130+00, RT
 REMOVING SIGNS
 AS SHOWN - 3

NOTE:
 1. REFER TO SHEET 27 OF 545
 FOR CULVERT INFORMATION.

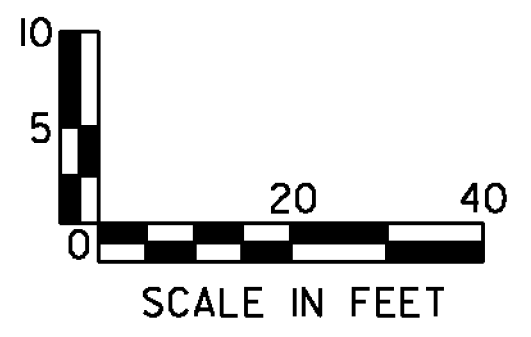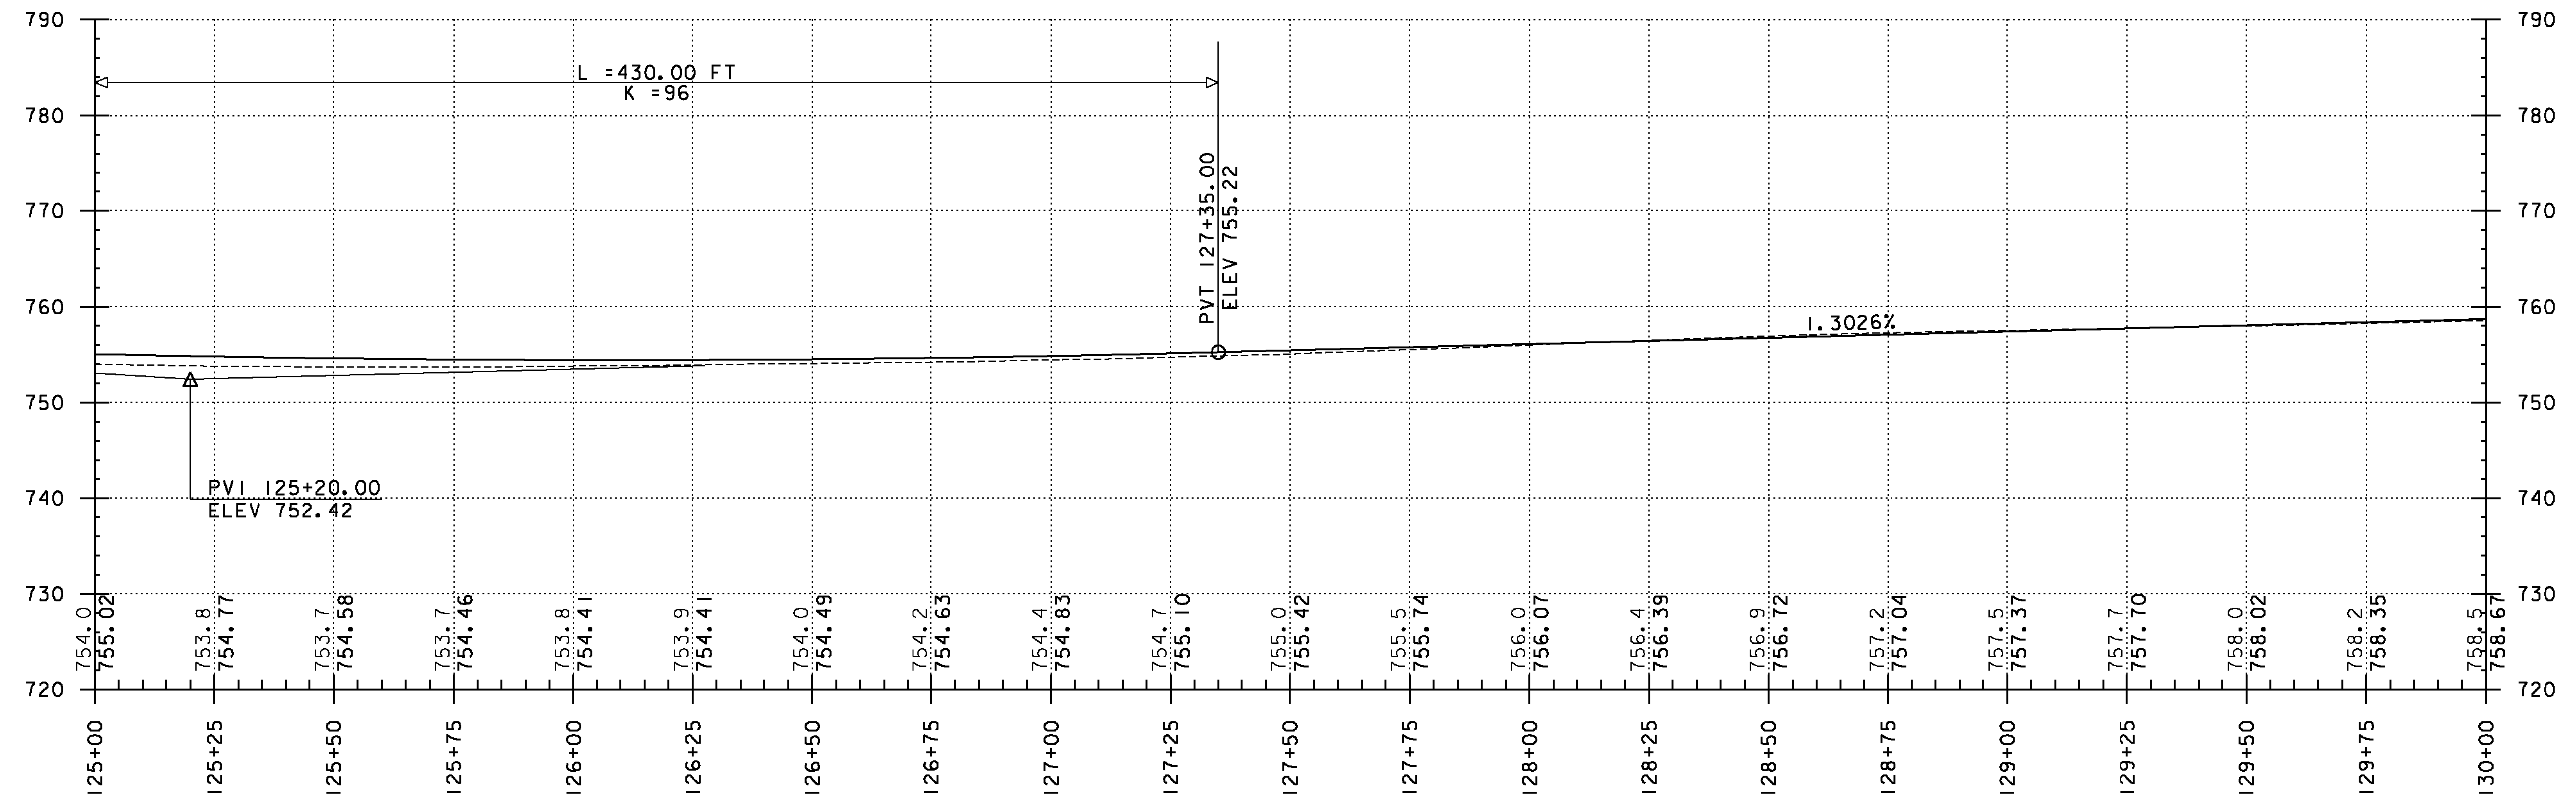

PROJECT NAME: RANDOLPH-ROXBURY
 PROJECT NUMBER: ER STP 0187(II)
 FILE NAME: z13cl82bdr.dgn
 PROJECT LEADER: M. FOISY
 DESIGNED BY: I. MAYNARD
 PLAN & PROFILE SHEET 35
 PLOT DATE: 11/17/2014
 DRAWN BY: G. BURGMEIER
 CHECKED BY: M. FOISY
 SHEET 76 OF 545