

REHAD Dis, CBs, OR Mhs, CLASS 1  
 STA. 141+46, RT

DURABLE 4 INCH WHITE LINE, THERMOPLASTIC  
 DURABLE 4 INCH WHITE LINE, POLYUREA  
 TEMPORARY 4 INCH WHITE LINE, PAINT  
 (ALL LINES WILL INCLUDE EDGE LINE BREAKS  
 AND RADII FOR SIDE ROADS)  
 STA. 140+00 TO 145+00, SOLID LT & RT


DURABLE 4 INCH YELLOW LINE, THERMOPLASTIC  
 DURABLE 4 INCH YELLOW LINE, POLYUREA  
 TEMPORARY 4 INCH YELLOW LINE, PAINT  
 (ALL LINES WILL INCLUDE  $\text{C}$  BREAK  
 FOR SIDE ROADS)  
 STA. 140+00 TO 145+00, SOLID LT & RT  
 STA. 141+77, RT (BENT HILL RD)

DURABLE 24 INCH STOP BAR, THERMOPLASTIC  
 DURABLE 24 INCH STOP BAR, POLYUREA  
 TEMPORARY 24 INCH STOP BAR, PAINT  
 STA. 141+77, RT (BENT HILL RD) (23 LF)  
 DURABLE LETTER OR SYMBOL, THERMOPLASTIC  
 DURABLE LETTER OR SYMBOL, POLYUREA  
 STA. 141+77, RT "STOP" (BENT HILL RD)



BARRIER FENCE  
 STA. 144+30 TO 145+00, RT

CURVE 32 DATA  
 R = 1420.00'  
 $\Delta = 47^\circ 00' 34.07''$   
 D =  $4^\circ 02' 05.69''$   
 T = 617.57'  
 L = 1165.07'  
 E = 128.48'  
 e = 5.2%

STONE FILL, TYPE I, GEOTEXTILE UNDER STONE FILL  
 & GRUBBING MATERIAL  
 STA. 142+00 TO 143+98, LT

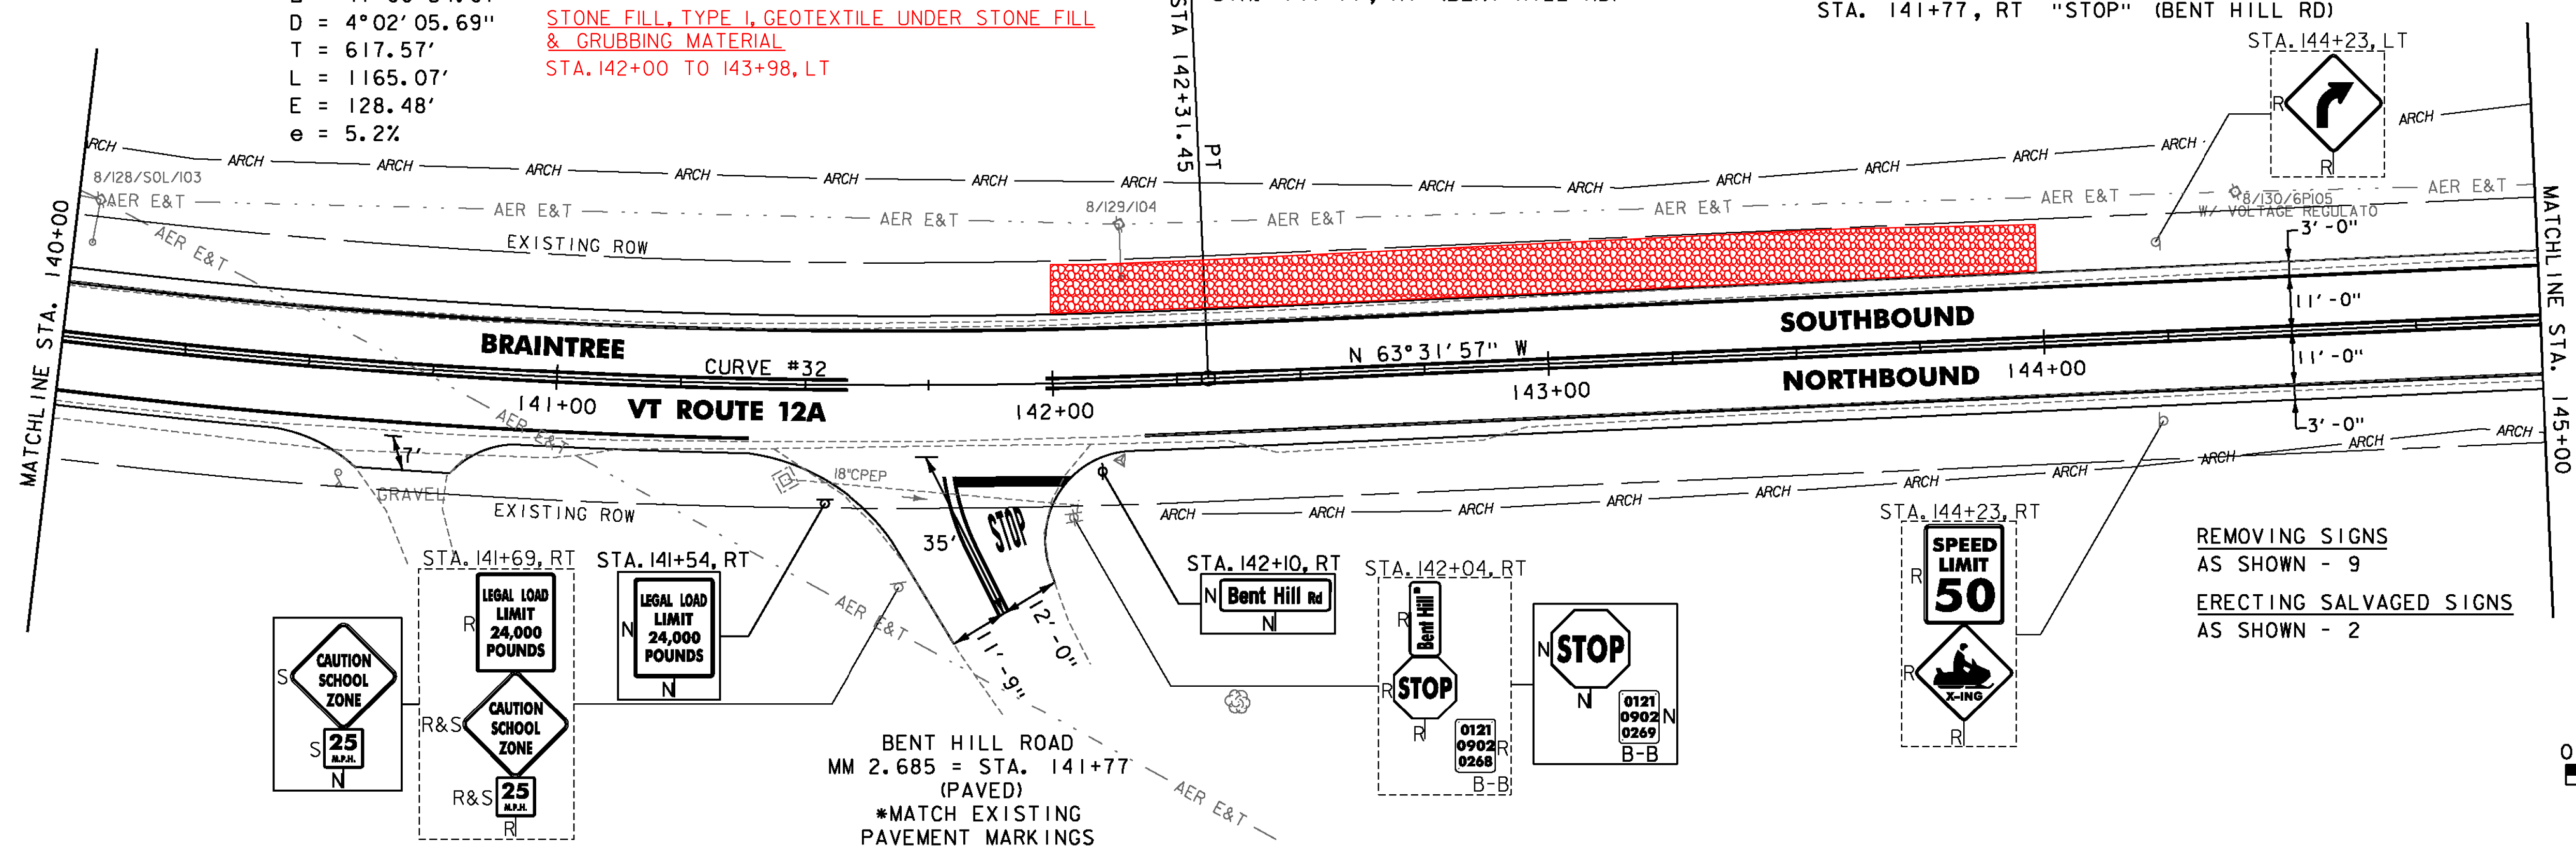

REMOVING SIGNS  
 AS SHOWN - 9  
 ERECTING SALVAGED SIGNS  
 AS SHOWN - 2

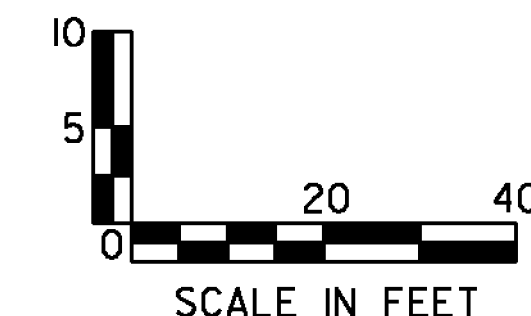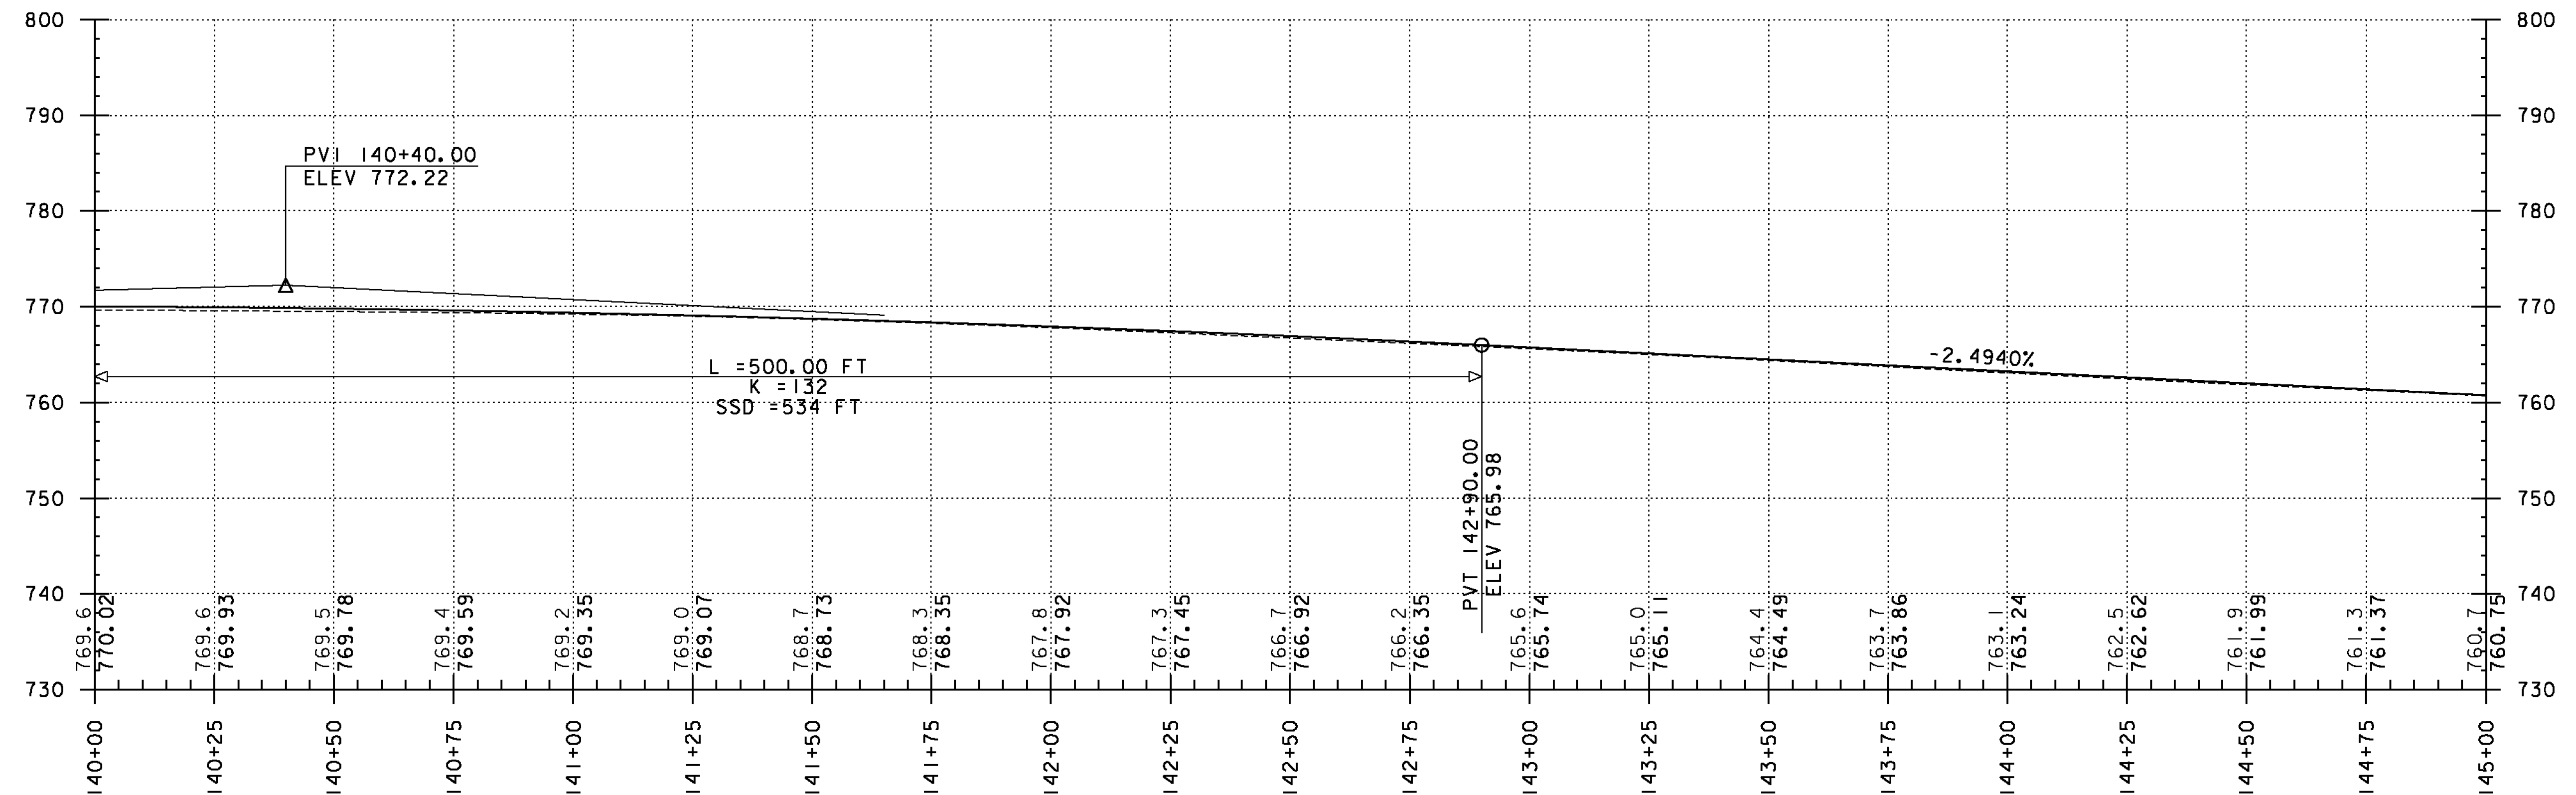

PROJECT NAME: RANDOLPH-ROXBURY  
 PROJECT NUMBER: ER STP 0187(II)  
 FILE NAME: z13cl82bdr.dgn  
 PROJECT LEADER: M. FOISY  
 DESIGNED BY: I. MAYNARD  
 PLAN & PROFILE SHEET 38  
 PLOT DATE: 11/17/2014  
 DRAWN BY: G. BURGMEIER  
 CHECKED BY: M. FOISY  
 SHEET 79 OF 545

