

STONE FILL TYPE I, GEOTEXTILE UNDER STONE FILL
& GRUBBING MATERIAL
STA. 152+75 TO 153+88, RT
STA. 152+91 TO 155+00, LT
STA. 154+00 TO 155+00, LT

DURABLE 4 INCH WHITE LINE, THERMOPLASTIC
DURABLE 4 INCH WHITE LINE, POLYUREA
TEMPORARY 4 INCH WHITE LINE, PAINT
STA. 150+00 TO 155+00, SOLID LT & RT

STEEL BEAN GUARDRAIL
STA. 152+51 TO 153+01, LT

STEEL BEAN GUARDRAIL W/ 8 FEET POSTS
STA. 153+01 TO 155+00, LT


CURVE 33 DATA
R = 4400.00'
 $\Delta = 11^\circ 19' 53.92''$
D = $1^\circ 18' 07.84''$
T = 436.53'
L = 870.21'
E = 21.60'
e = 2.0%

DURABLE 4 INCH YELLOW LINE, THERMOPLASTIC
DURABLE 4 INCH YELLOW LINE, POLYUREA
TEMPORARY 4 INCH YELLOW LINE, PAINT
STA. 150+00 TO 155+00, SOLID LT & RT




ANCHOR FOR STEEL BEAN GUARDRAIL
STA. 152+51, LT

BARRIER FENCE
STA. 150+08 TO 153+30, RT

GEOTEXTILE FOR SILT FENCE
STA. 151+25 TO 151+75, LT
STA. 153+00 TO 155+00, LT
STA. 153+50 TO 154+50, RT

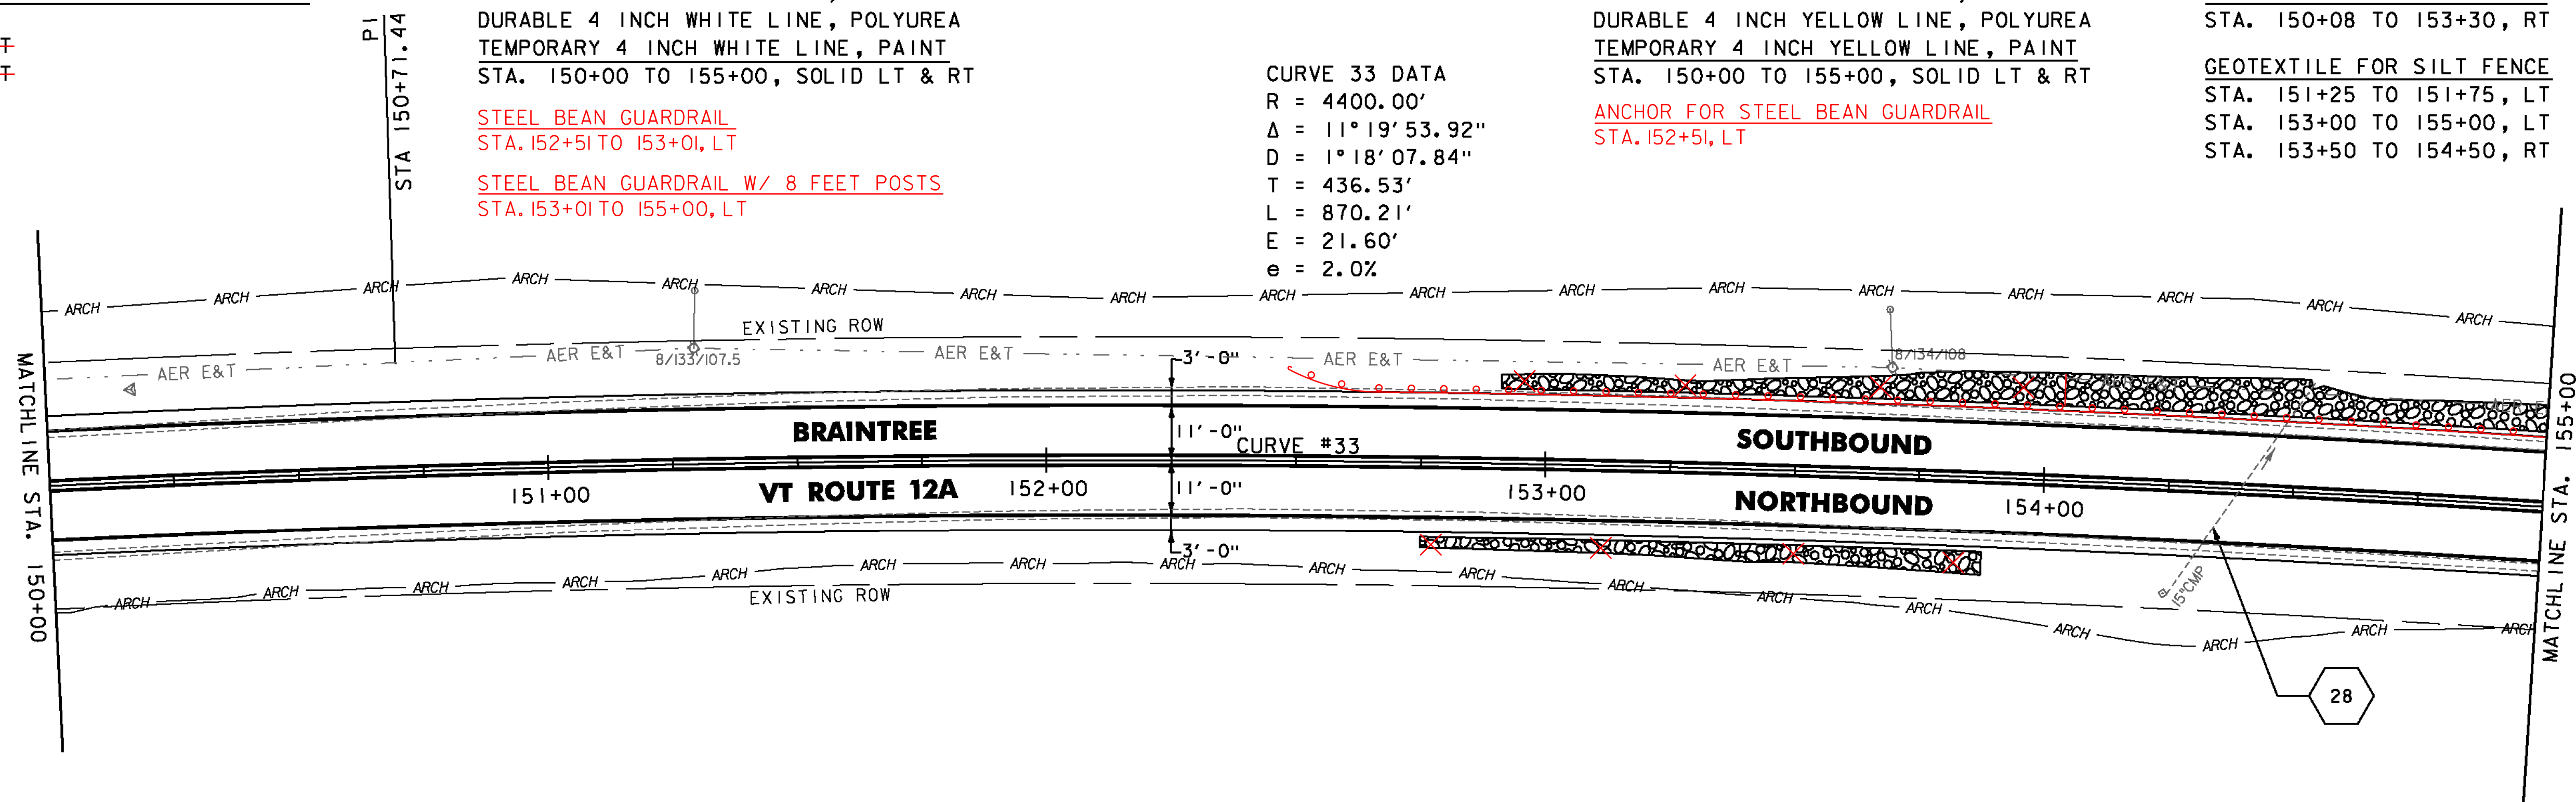

NOTE:
1. REFER TO SHEET 27 OF 545
FOR CULVERT INFORMATION.

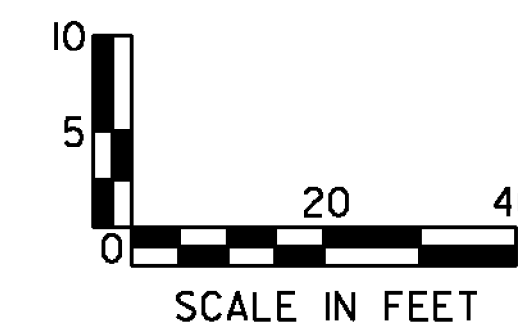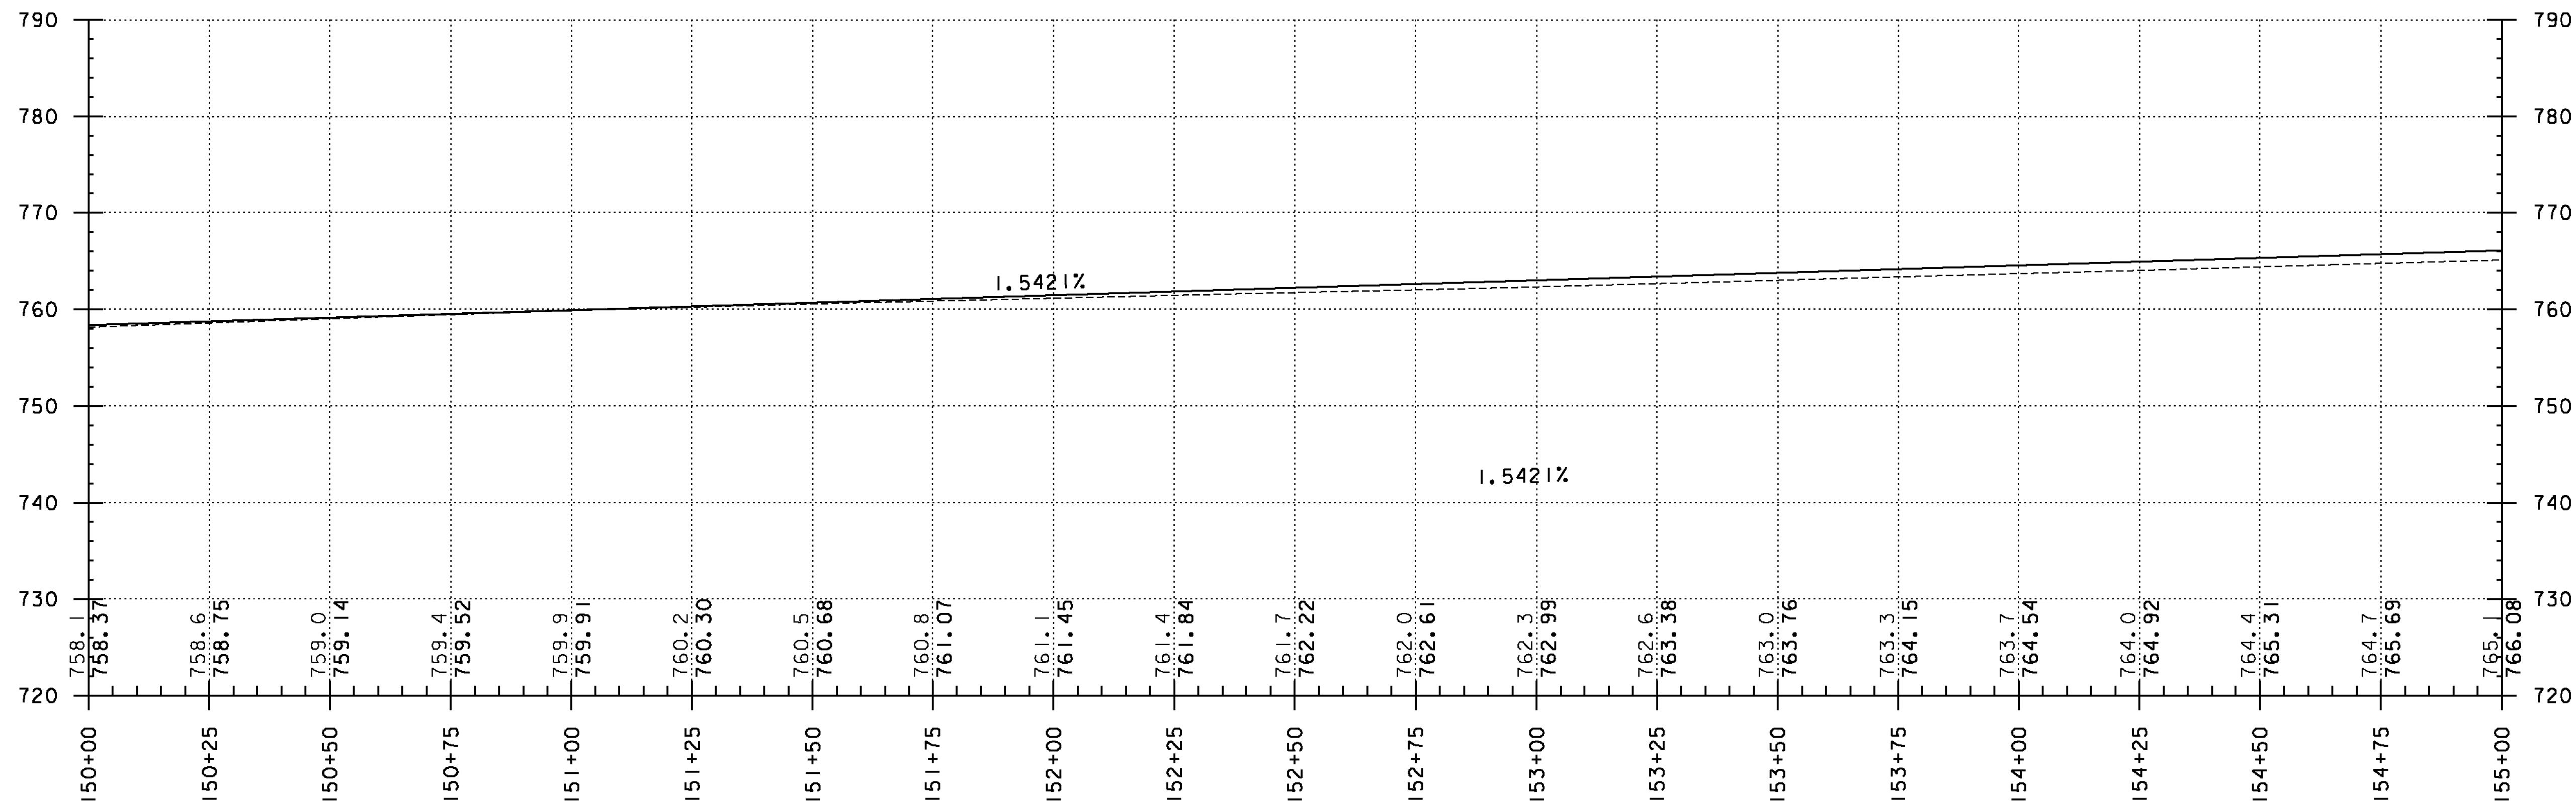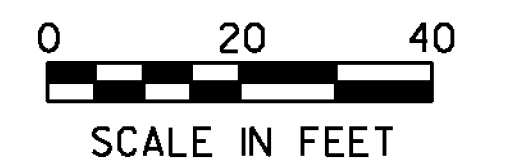

PROJECT NAME: RANDOLPH-ROXBURY
PROJECT NUMBER: ER STP 0187(II)

FILE NAME: z13cl82bdr.dgn
PROJECT LEADER: M. FOISY
DESIGNED BY: I. MAYNARD
PLAN & PROFILE SHEET 40

PLOT DATE: 11/17/2014
DRAWN BY: G. BURGMEIER
CHECKED BY: M. FOISY
SHEET 81 OF 545