
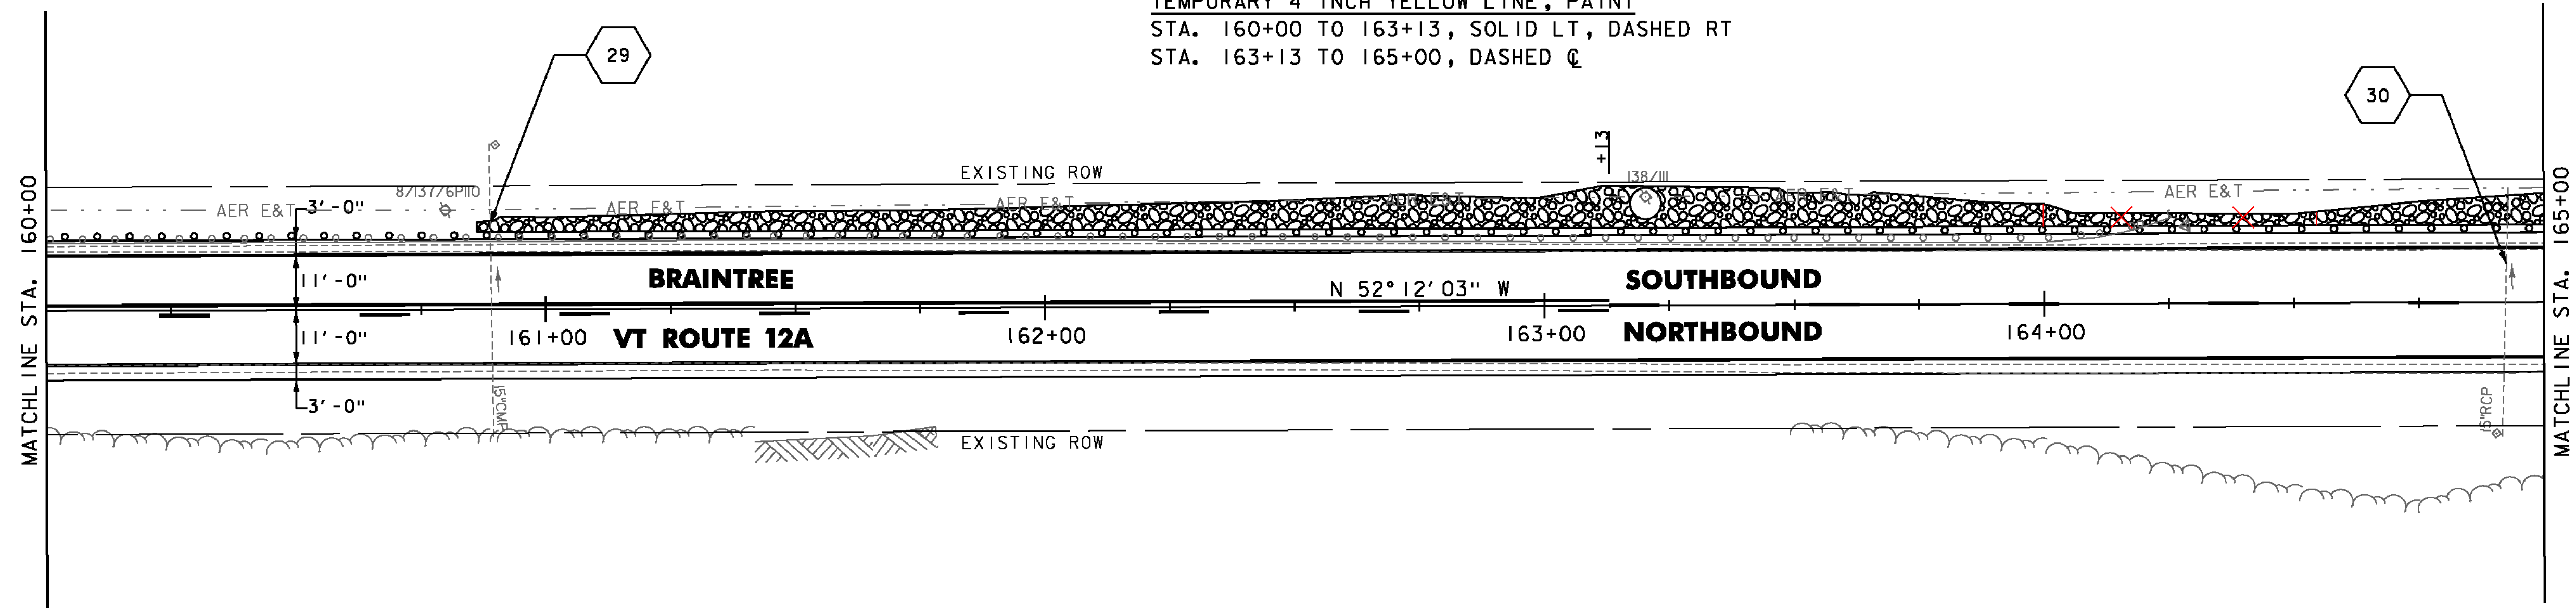


STONE FILL TYPE I, GEOTEXTILE UNDER STONE FILL & GRUBBING MATERIAL
 STA. 160+86 TO 165+00, LT
 STA. 160+86 TO 164+00, LT
 STA. 164+60 TO 165+00, LT

STEEL BEAM GUARDRAIL, GALVANIZED W/ 8 FEET POSTS
 STA. 160+00.0 TO 165+00.0, LT
 REMOVAL AND DISPOSAL OF GUARDRAIL
 STA. 160+00 TO 164+26, LT




DURABLE 4 INCH WHITE LINE, THERMOPLASTIC
 DURABLE 4 INCH WHITE LINE, POLYUREA
 TEMPORARY 4 INCH WHITE LINE, PAINT
 STA. 160+00 TO 165+00, SOLID LT & RT
 DURABLE 4 INCH YELLOW LINE, THERMOPLASTIC
 DURABLE 4 INCH YELLOW LINE, POLYUREA
 TEMPORARY 4 INCH YELLOW LINE, PAINT
 STA. 160+00 TO 163+13, SOLID LT, DASHED RT
 STA. 163+13 TO 165+00, DASHED C

GEOTEXTILE FOR SILT FENCE
 STA. 161+00 TO 164+00, LT
 EROSION LOG
 STA. 161+50 TO 165+00, RT

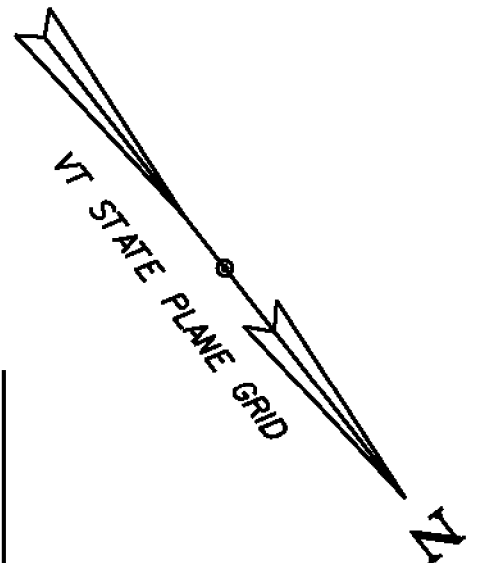

NOTE:
 KEY-IN FOR STONE SLOPE SHALL NOT BE INSTALLED WITHIN 10 FEET OF UTILITY POLE.

NOTE:
 1. REFER TO SHEET 27 OF 545 FOR CULVERT INFORMATION.

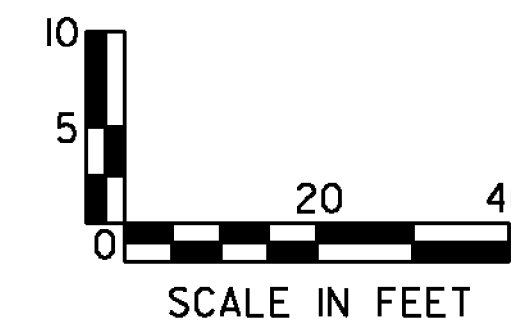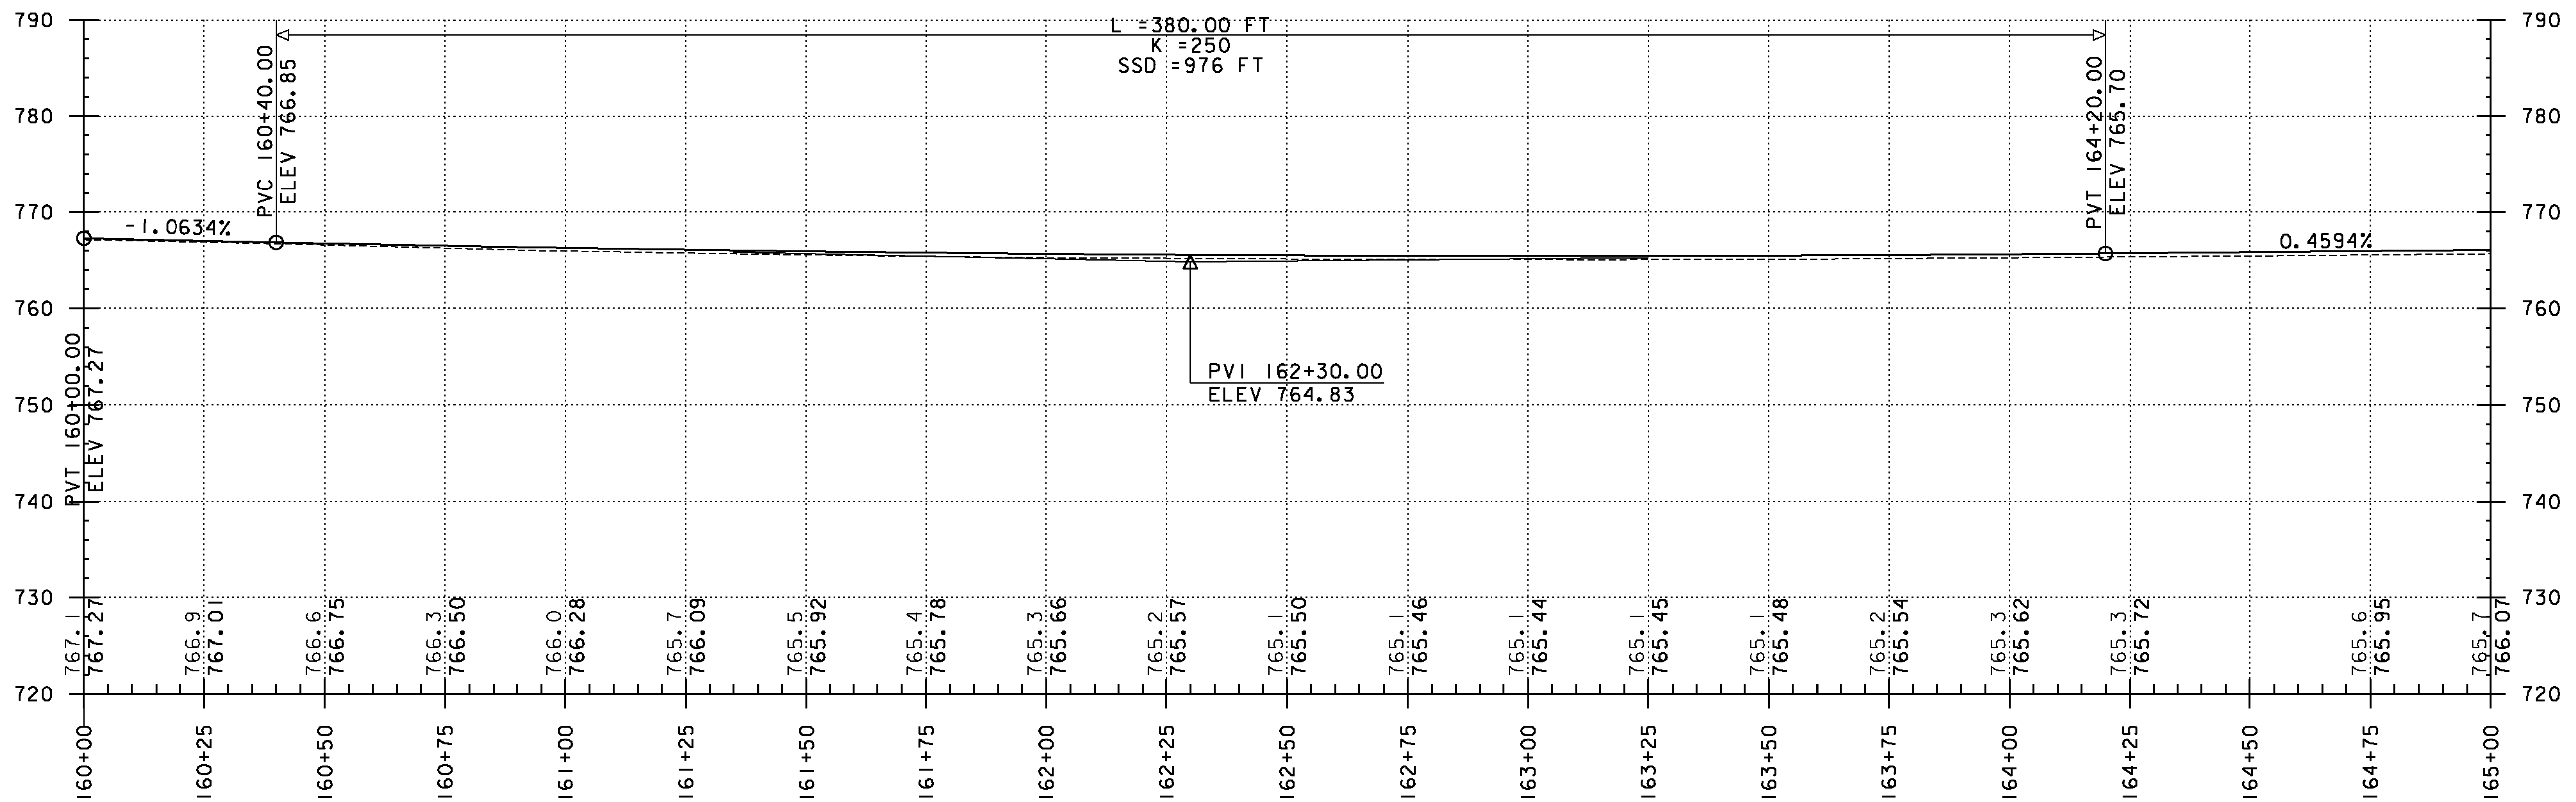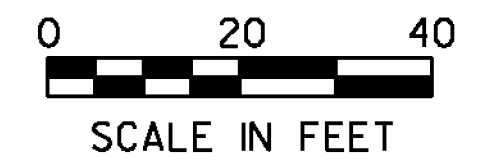

PROJECT NAME: RANDOLPH-ROXBURY
 PROJECT NUMBER: ER STP 0187(II)

FILE NAME: z13cl82bdr.dgn
 PROJECT LEADER: M. FOISY
 DESIGNED BY: I. MAYNARD
 PLOT DATE: 11/17/2014
 DRAWN BY: G. BURGMEIER
 CHECKED BY: M. FOISY
 SHEET 83 OF 545



PLAN & PROFILE SHEET 42