
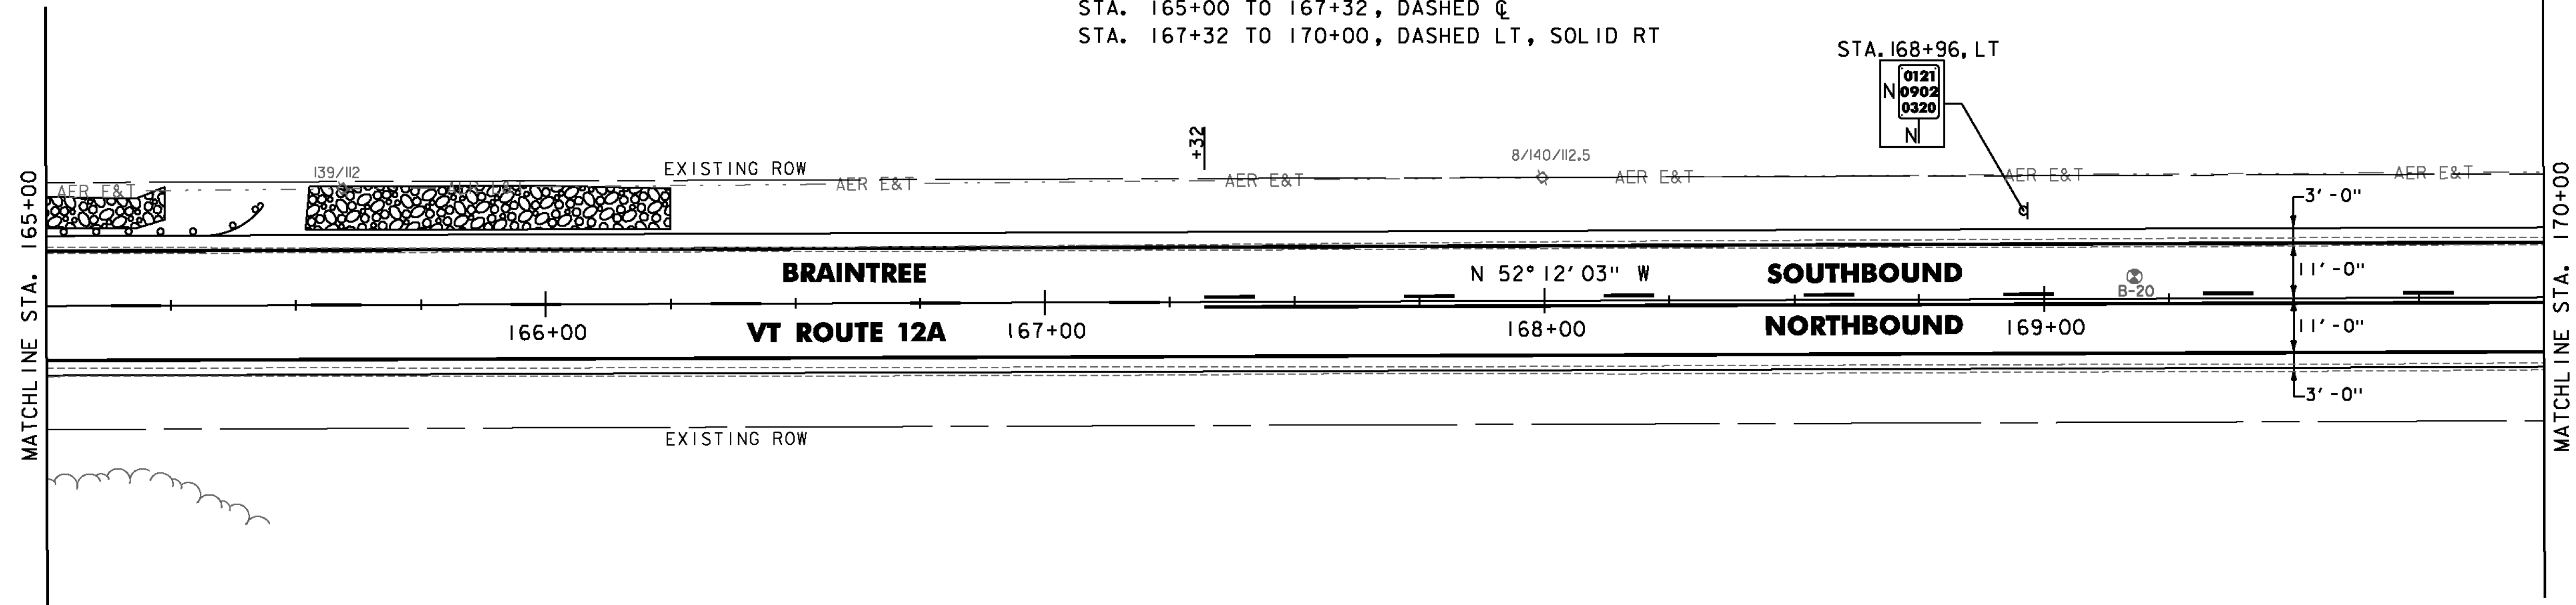


STONE FILL TYPE 1, GEOTEXTILE UNDER STONE FILL & GRUBBING MATERIAL
STA. 165+00 TO 166+25, LT




STEEL BEAM GUARDRAIL, GALVANIZED
STA. ~~165+18.0 TO 165+43.0, LT~~ STA. 165+9.5 TO 168+22, LT
STEEL BEAM GUARDRAIL, GALVANIZED W/ 8 FEET POSTS
STA. ~~165+00.0 TO 165+18.0, LT~~ STA. 165+00 TO 165+9.5, LT
ANCHOR FOR STEEL BEAM RAIL
STA. ~~165+43.0, LT~~ STA. 165+22, LT

DURABLE 4 INCH WHITE LINE, THERMOPLASTIC
DURABLE 4 INCH WHITE LINE, POLYUREA
TEMPORARY 4 INCH WHITE LINE, PAINT
STA. 165+00 TO 170+00, SOLID LT & RT
DURABLE 4 INCH YELLOW LINE, THERMOPLASTIC
DURABLE 4 INCH YELLOW LINE, POLYUREA
TEMPORARY 4 INCH YELLOW LINE, PAINT
STA. 165+00 TO 167+32, DASHED C
STA. 167+32 TO 170+00, DASHED LT, SOLID RT

GEOTEXTILE FOR SILT FENCE
STA. 165+00 TO 168+50, LT

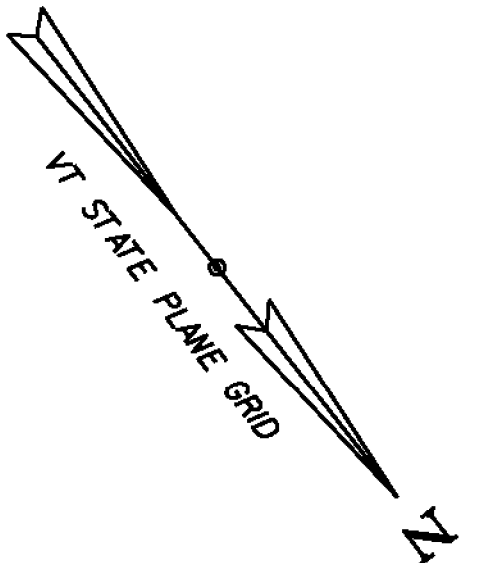

SOIL BORING DATA			
BORING#	DEPTH (FT.)	PCC	COMMENTS
B-20	5.0'	NO	

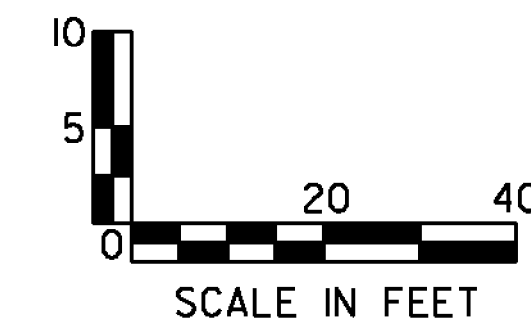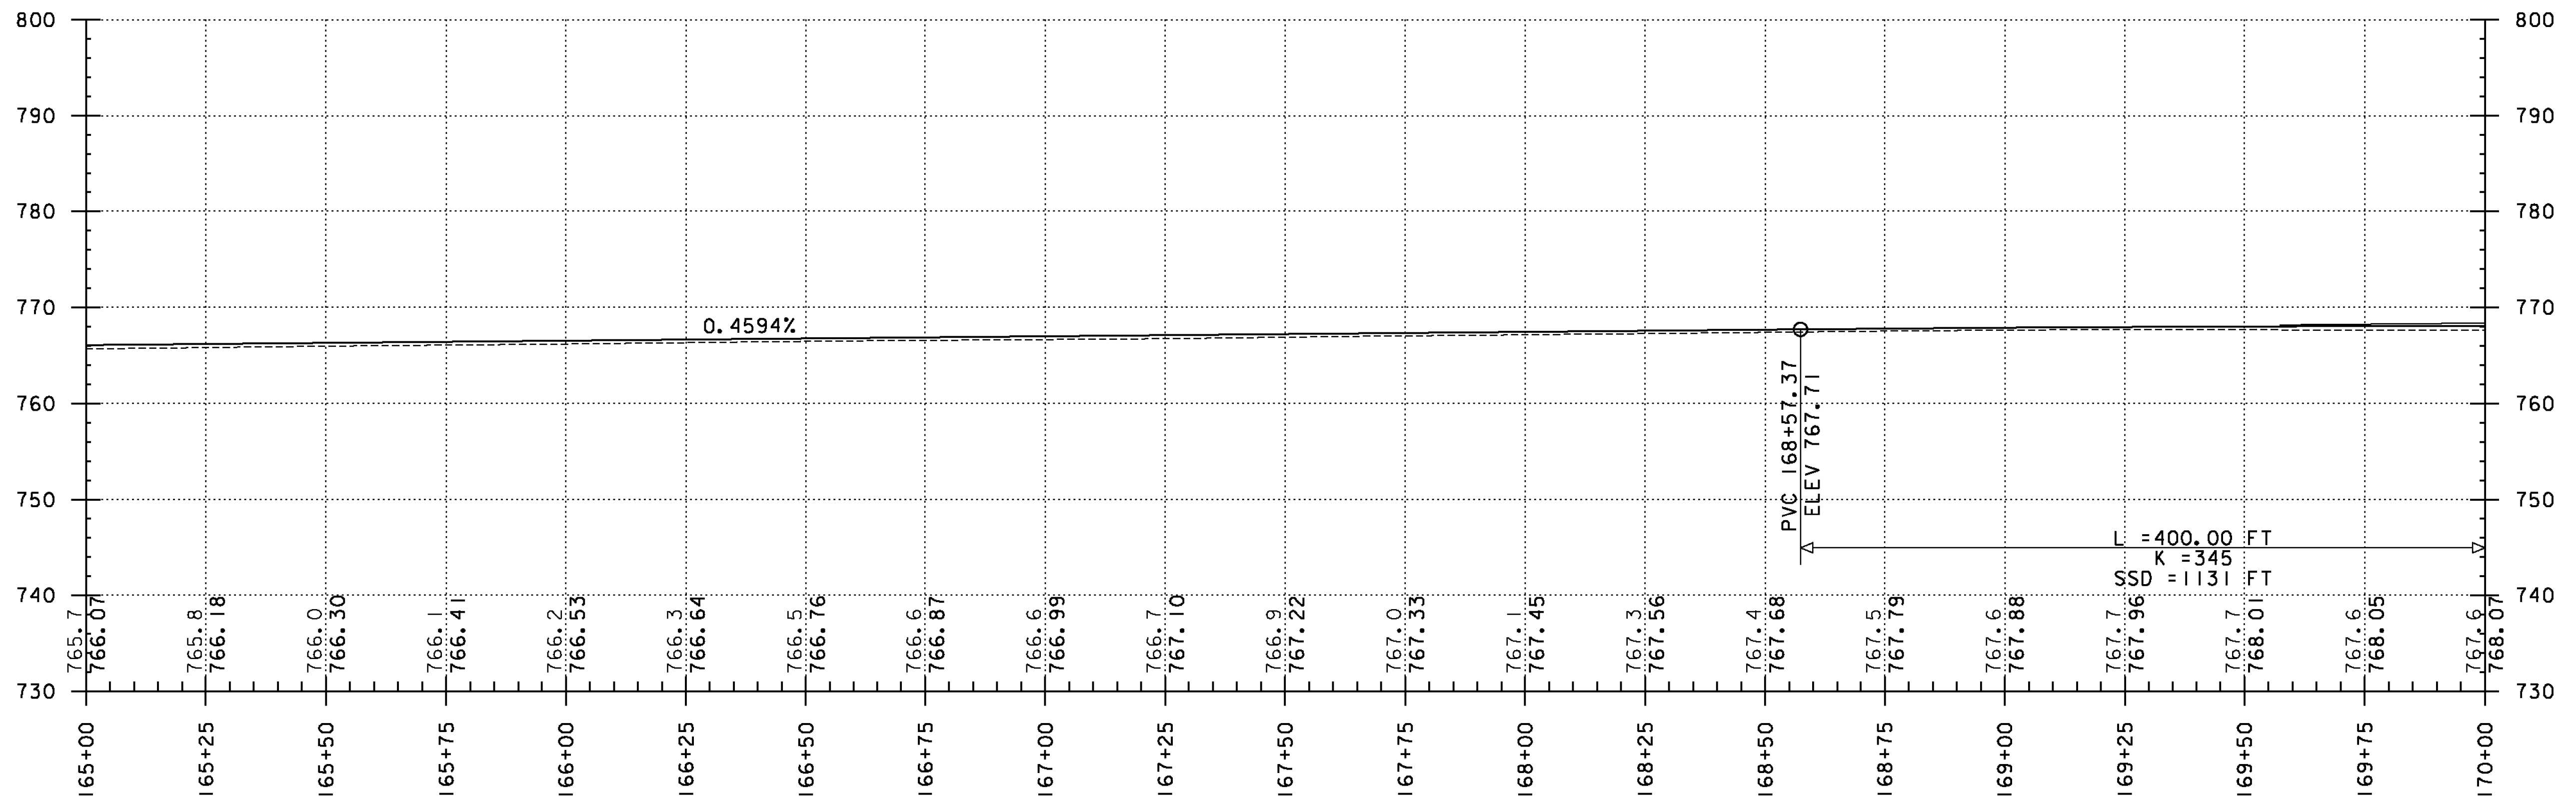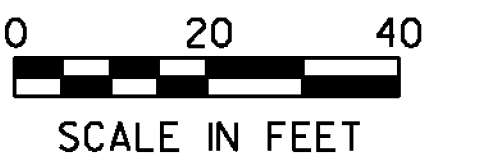

PROJECT NAME: RANDOLPH-ROXBURY
PROJECT NUMBER: ER STP 0187(II)

FILE NAME: z13cl82bdr.dgn
PROJECT LEADER: M. FOISY
DESIGNED BY: I. MAYNARD
PLOT DATE: 11/17/2014
DRAWN BY: G. BURGMEIER
CHECKED BY: M. FOISY
PLAN & PROFILE SHEET 43
SHEET 84 OF 545