

~~STONE FILL TYPE 1, GEOTEXTILE UNDER STONE FILL & GRUBBING MATERIAL~~



~~STA. 185+13 TO 186+82, LT~~
~~STA. 187+11 TO 188+73, LT~~

DURABLE 4 INCH WHITE LINE, THERMOPLASTIC
 DURABLE 4 INCH WHITE LINE, POLYUREA
 TEMPORARY 4 INCH WHITE LINE, PAINT
 STA. 185+00 TO 190+00, SOLID LT & RT

DURABLE 4 INCH YELLOW LINE, THERMOPLASTIC
 DURABLE 4 INCH YELLOW LINE, POLYUREA
 TEMPORARY 4 INCH YELLOW LINE, PAINT
 STA. 185+00 TO 189+12, SOLID LT & RT
 STA. 189+12 TO 190+00, DASHED C

GEOTEXTILE FOR SILT FENCE
 STA. 185+50 TO 186+50, LT
 STA. 187+50 TO 190+00, LT
 BARRIER FENCE
 STA. 185+00 TO 186+94, LT
 STA. 187+50 TO 188+00, LT
 EROSION LOG
 STA. 185+64 TO 186+80, LT

REMOVING SIGNS
 AS SHOWN - 1

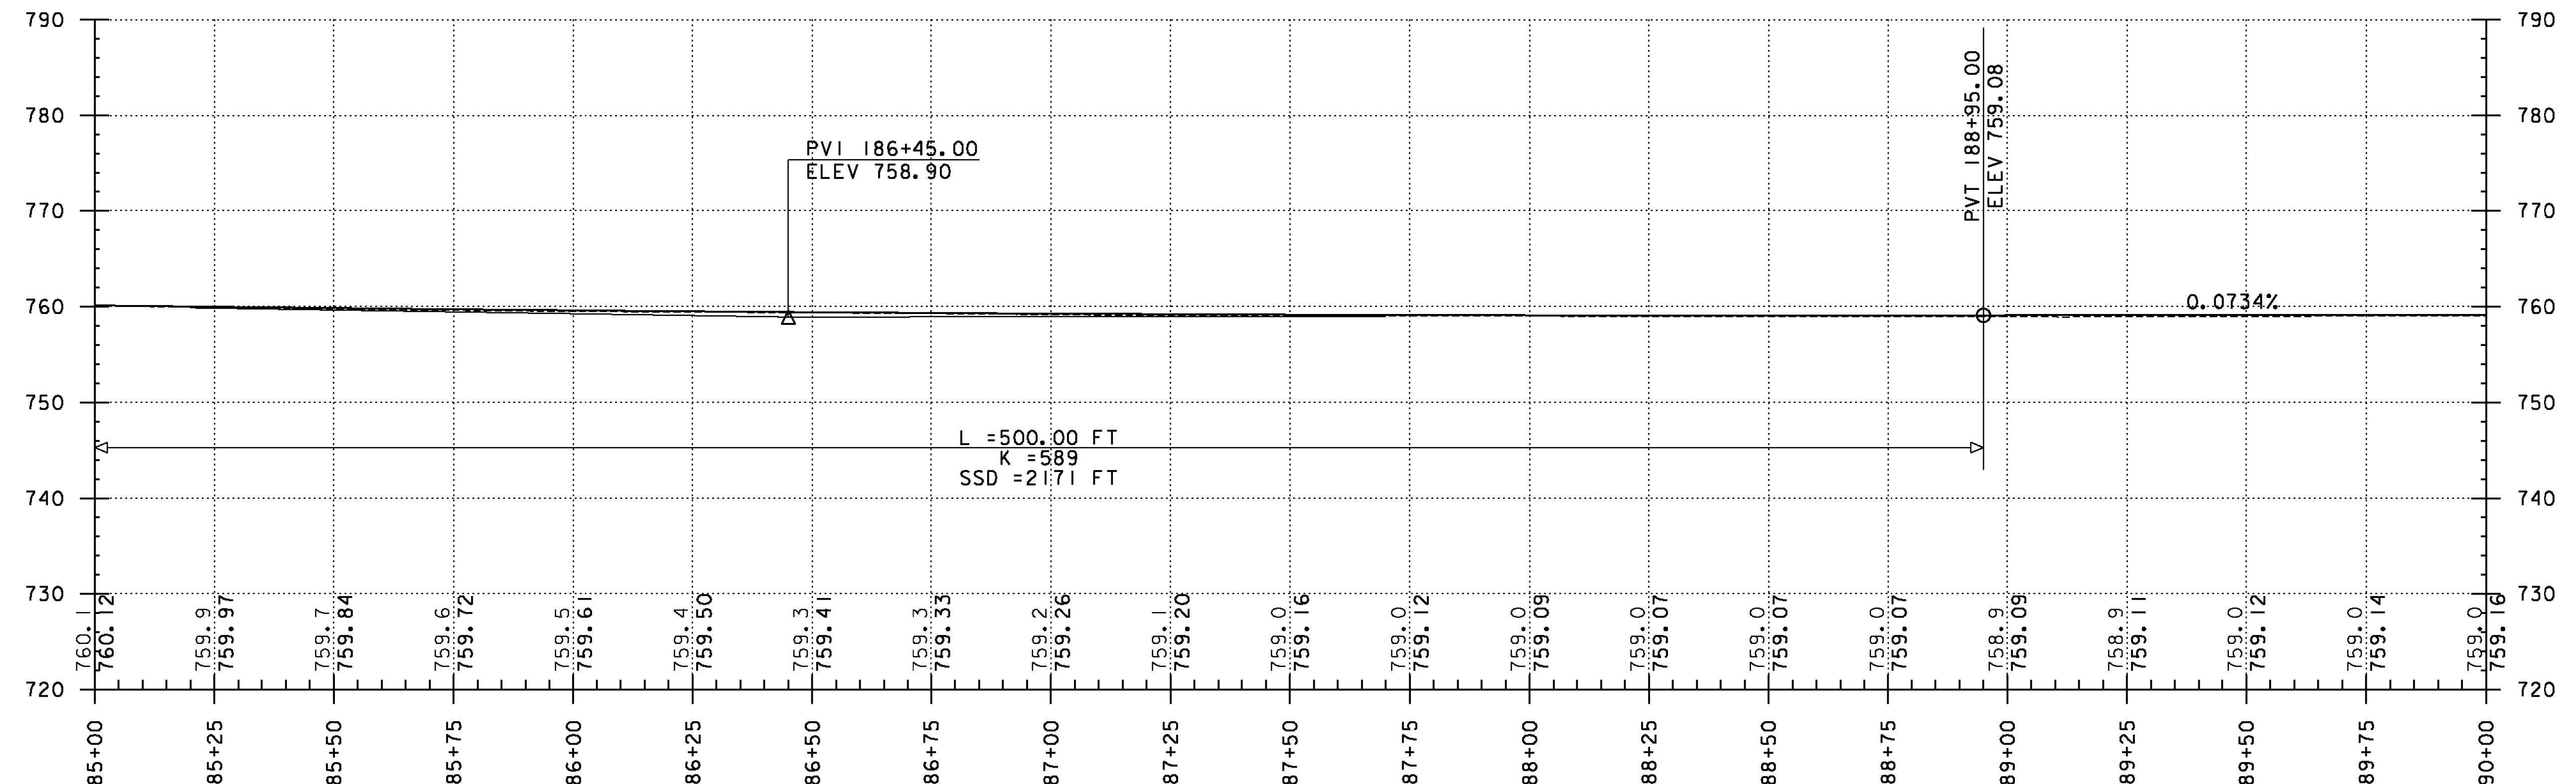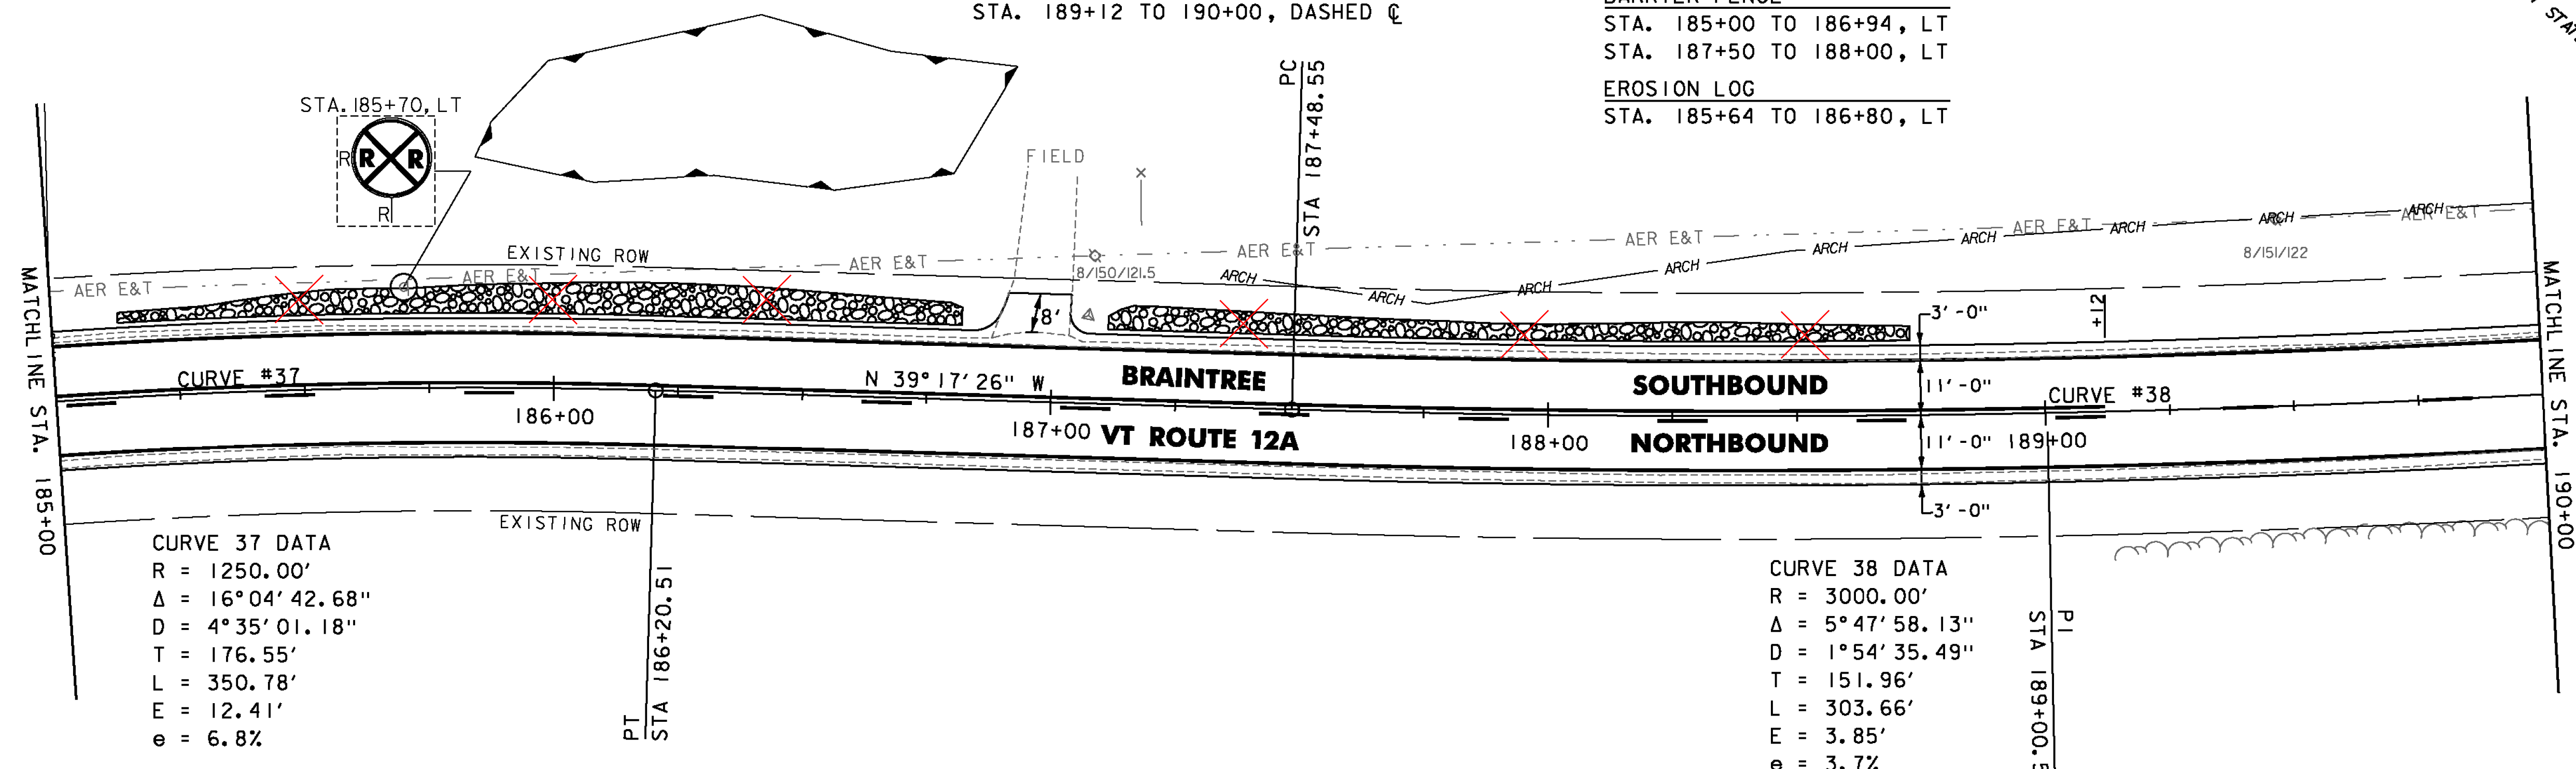

PROJECT NAME: RANDOLPH-ROXBURY
 PROJECT NUMBER: ER STP 0187(II)
 FILE NAME: z13cl82bdr.dgn
 PROJECT LEADER: M. FOISY
 DESIGNED BY: I. MAYNARD
 PLOT DATE: 11/17/2014
 DRAWN BY: G. BURGMEIER
 CHECKED BY: M. FOISY
 PLAN & PROFILE SHEET 47
 SHEET 88 OF 545

