



RELOCATE MAILBOX, SINGLE SUPPORT
 STA. 227+44, RT
 STA. 228+05, LT

~~STEEL BEAM GUARDRAIL, GALVANIZED~~
 STA. 229+13.5 TO 230+00.0, LT
~~ANCHOR FOR STEEL BEAM RAIL~~
 STA. 229+13.5, LT

DURABLE 4 INCH WHITE LINE, THERMOPLASTIC
 DURABLE 4 INCH WHITE LINE, POLYUREA
 TEMPORARY 4 INCH WHITE LINE, PAINT
 STA. 225+00 TO 230+00, SOLID LT & RT
 DURABLE 4 INCH YELLOW LINE, THERMOPLASTIC
 DURABLE 4 INCH YELLOW LINE, POLYUREA
 TEMPORARY 4 INCH YELLOW LINE, PAINT
 STA. 225+00 TO 230+00, SOLID LT & RT

BARRIER FENCE
 STA. 225+00 TO 227+40, RT
 STA. 227+70 TO 230+00, RT
 STA. 226+15 TO 227+29, LT
 GEOTEXTILE FOR SILT FENCE
 STA. 225+00 TO 225+50, LT
 STA. 226+50 TO 227+00, LT
 STA. 227+75 TO 228+25, LT

REMOVING SIGNS
 AS SHOWN - 5

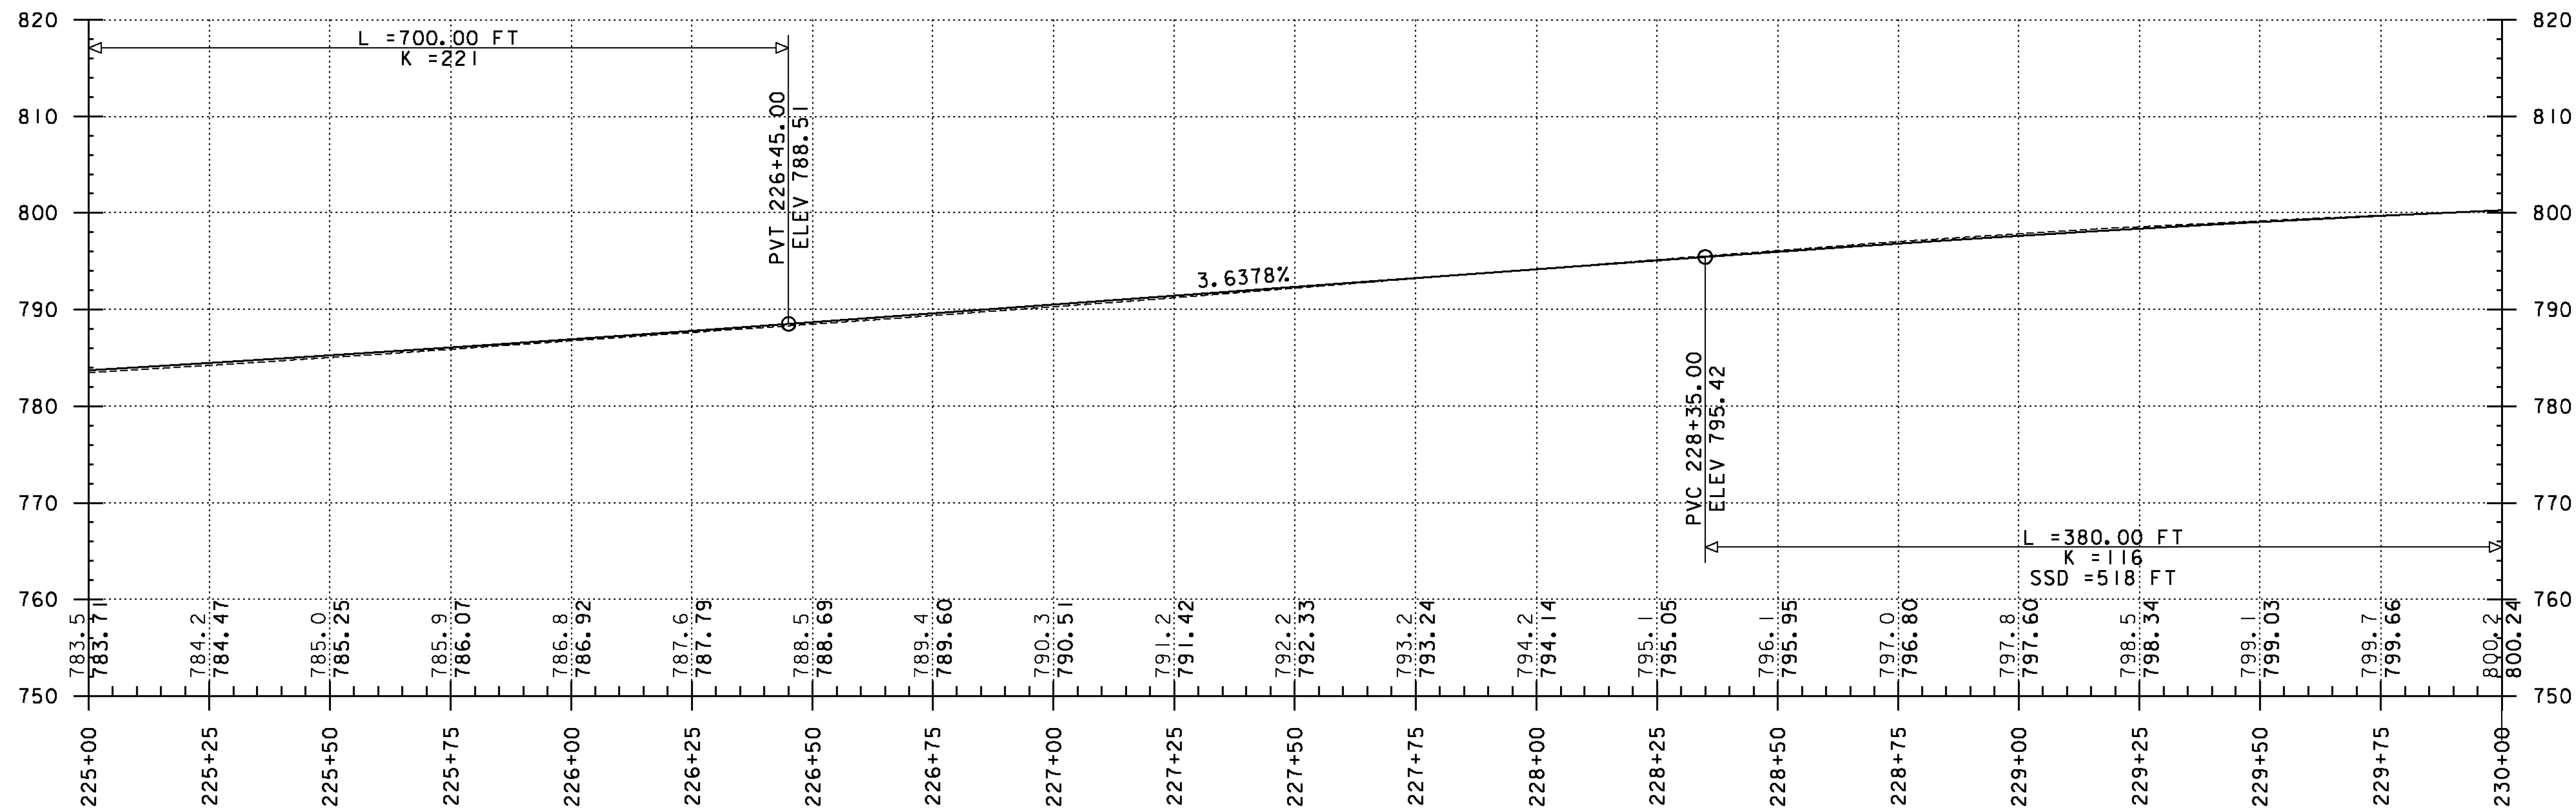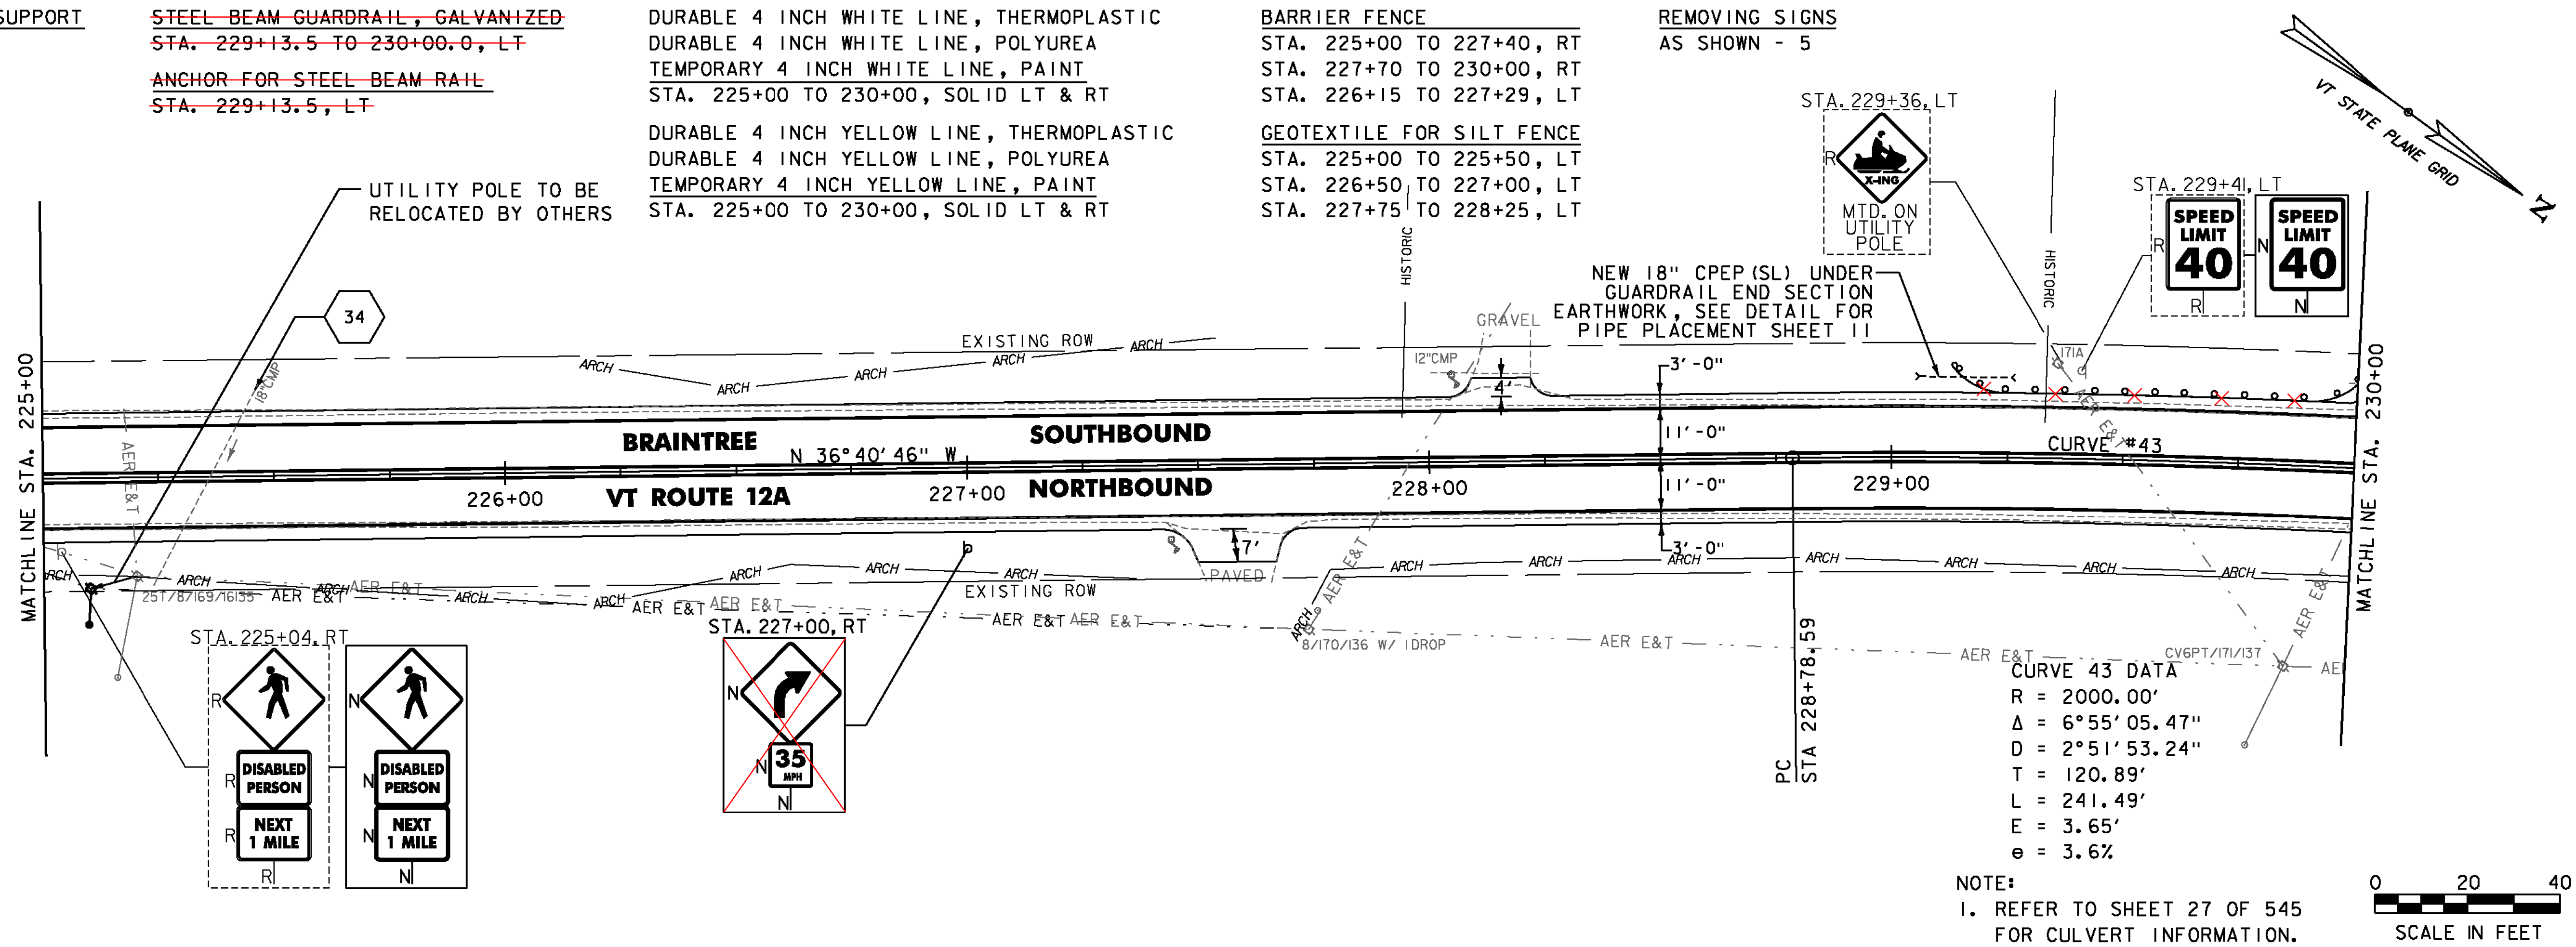

PROJECT NAME: RANDOLPH-ROXBURY
 PROJECT NUMBER: ER STP 0187(II)
 FILE NAME: z13cl82bdr.dgn
 PROJECT LEADER: M. FOISY
 DESIGNED BY: I. MAYNARD
 PLAN & PROFILE SHEET 55
 PLOT DATE: 11/17/2014
 DRAWN BY: G. BURGMEIER
 CHECKED BY: M. FOISY
 SHEET 96 OF 545

