

RELOCATE MAILBOX, SINGLE SUPPORT

STA. 237+20, RT

STA. 237+67, RT

~~STEEL BEAM GUARDRAIL, GALVANIZED~~

~~STA. 238+18.5 TO 238+50.0, LT~~

~~ANCHOR FOR STEEL BEAM RAIL~~

~~STA. 238+18.5, LT~~

DURABLE 4 INCH WHITE LINE, THERMOPLASTIC

DURABLE 4 INCH WHITE LINE, POLYUREA

TEMPORARY 4 INCH WHITE LINE, PAINT

STA. 235+00 TO 238+50, SOLID LT & RT

DURABLE 4 INCH YELLOW LINE, THERMOPLASTIC

DURABLE 4 INCH YELLOW LINE, POLYUREA

TEMPORARY 4 INCH YELLOW LINE, PAINT

STA. 235+00 TO 238+50, SOLID LT & RT

~~DURABLE 24 INCH STOP BAR, THERMOPLASTIC~~

~~DURABLE 24 INCH STOP BAR, POLYUREA~~

~~TEMPORARY 24 INCH STOP BAR, PAINT~~

~~STA. 237+28, RT (SOUTH RD) (23 LF)~~

~~DURABLE LETTER OR SYMBOL, THERMOPLASTIC~~

~~DURABLE LETTER OR SYMBOL, POLYUREA~~






~~STA. 237+28, RT "STOP" (SOUTH RD)~~

GEOTEXTILE FOR SILT FENCE

STA. 236+00 TO 236+50, RT

REMOVING SIGNS

AS SHOWN - 3

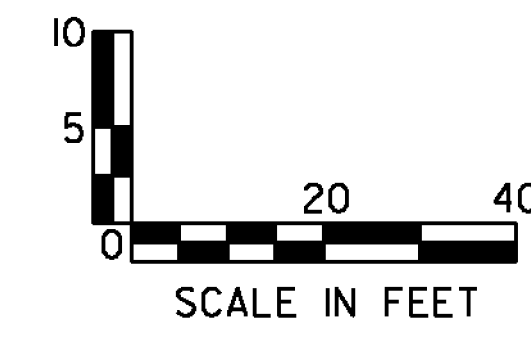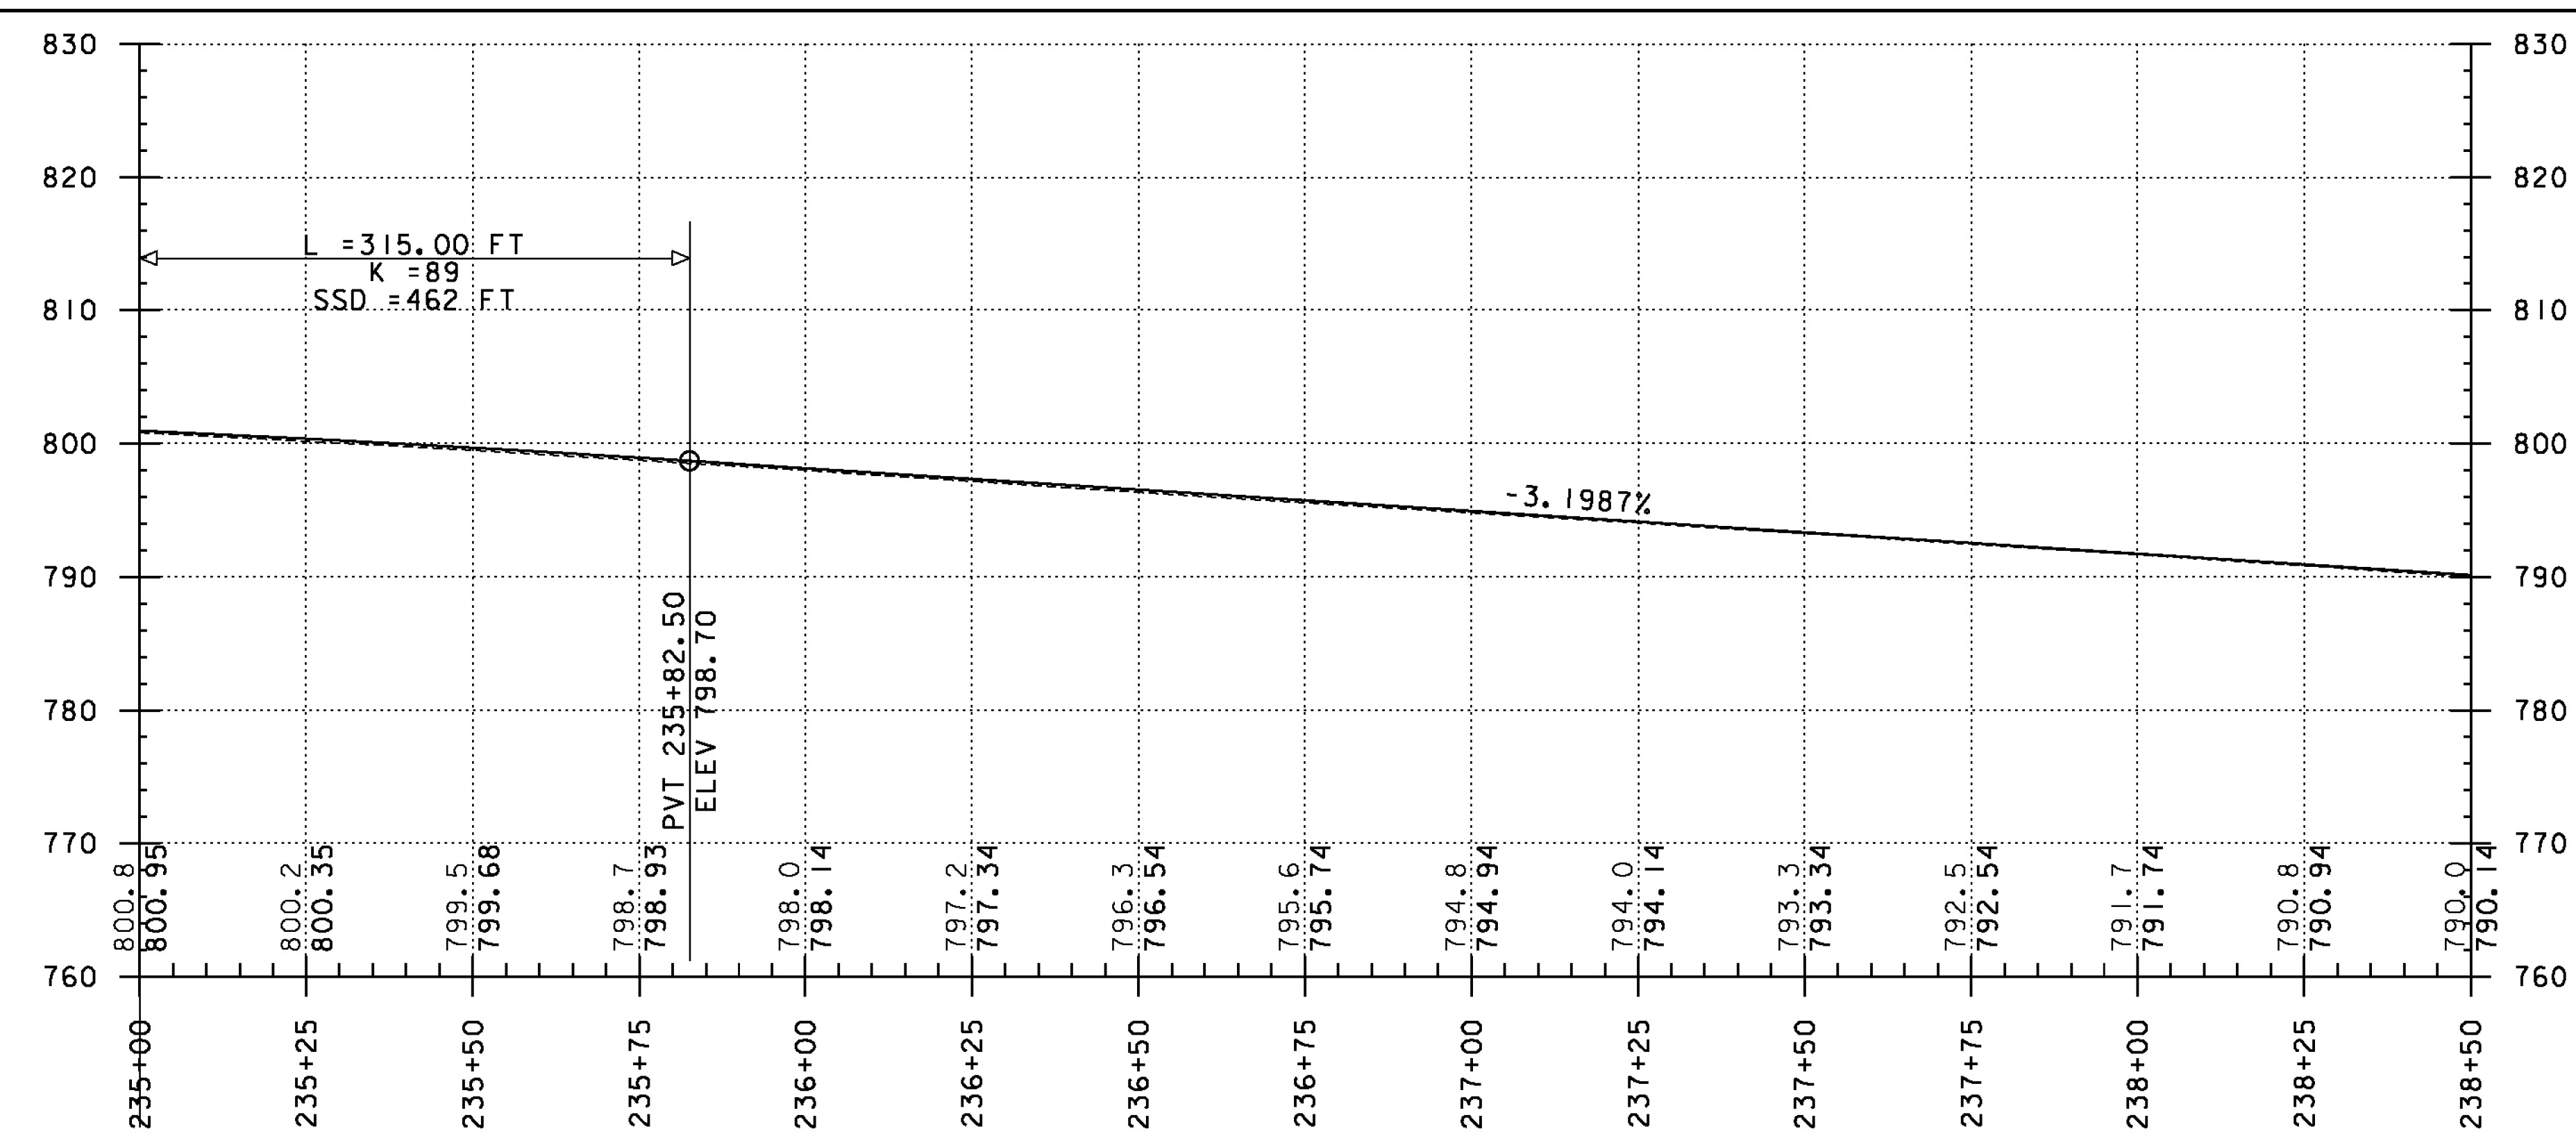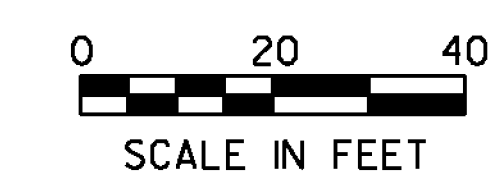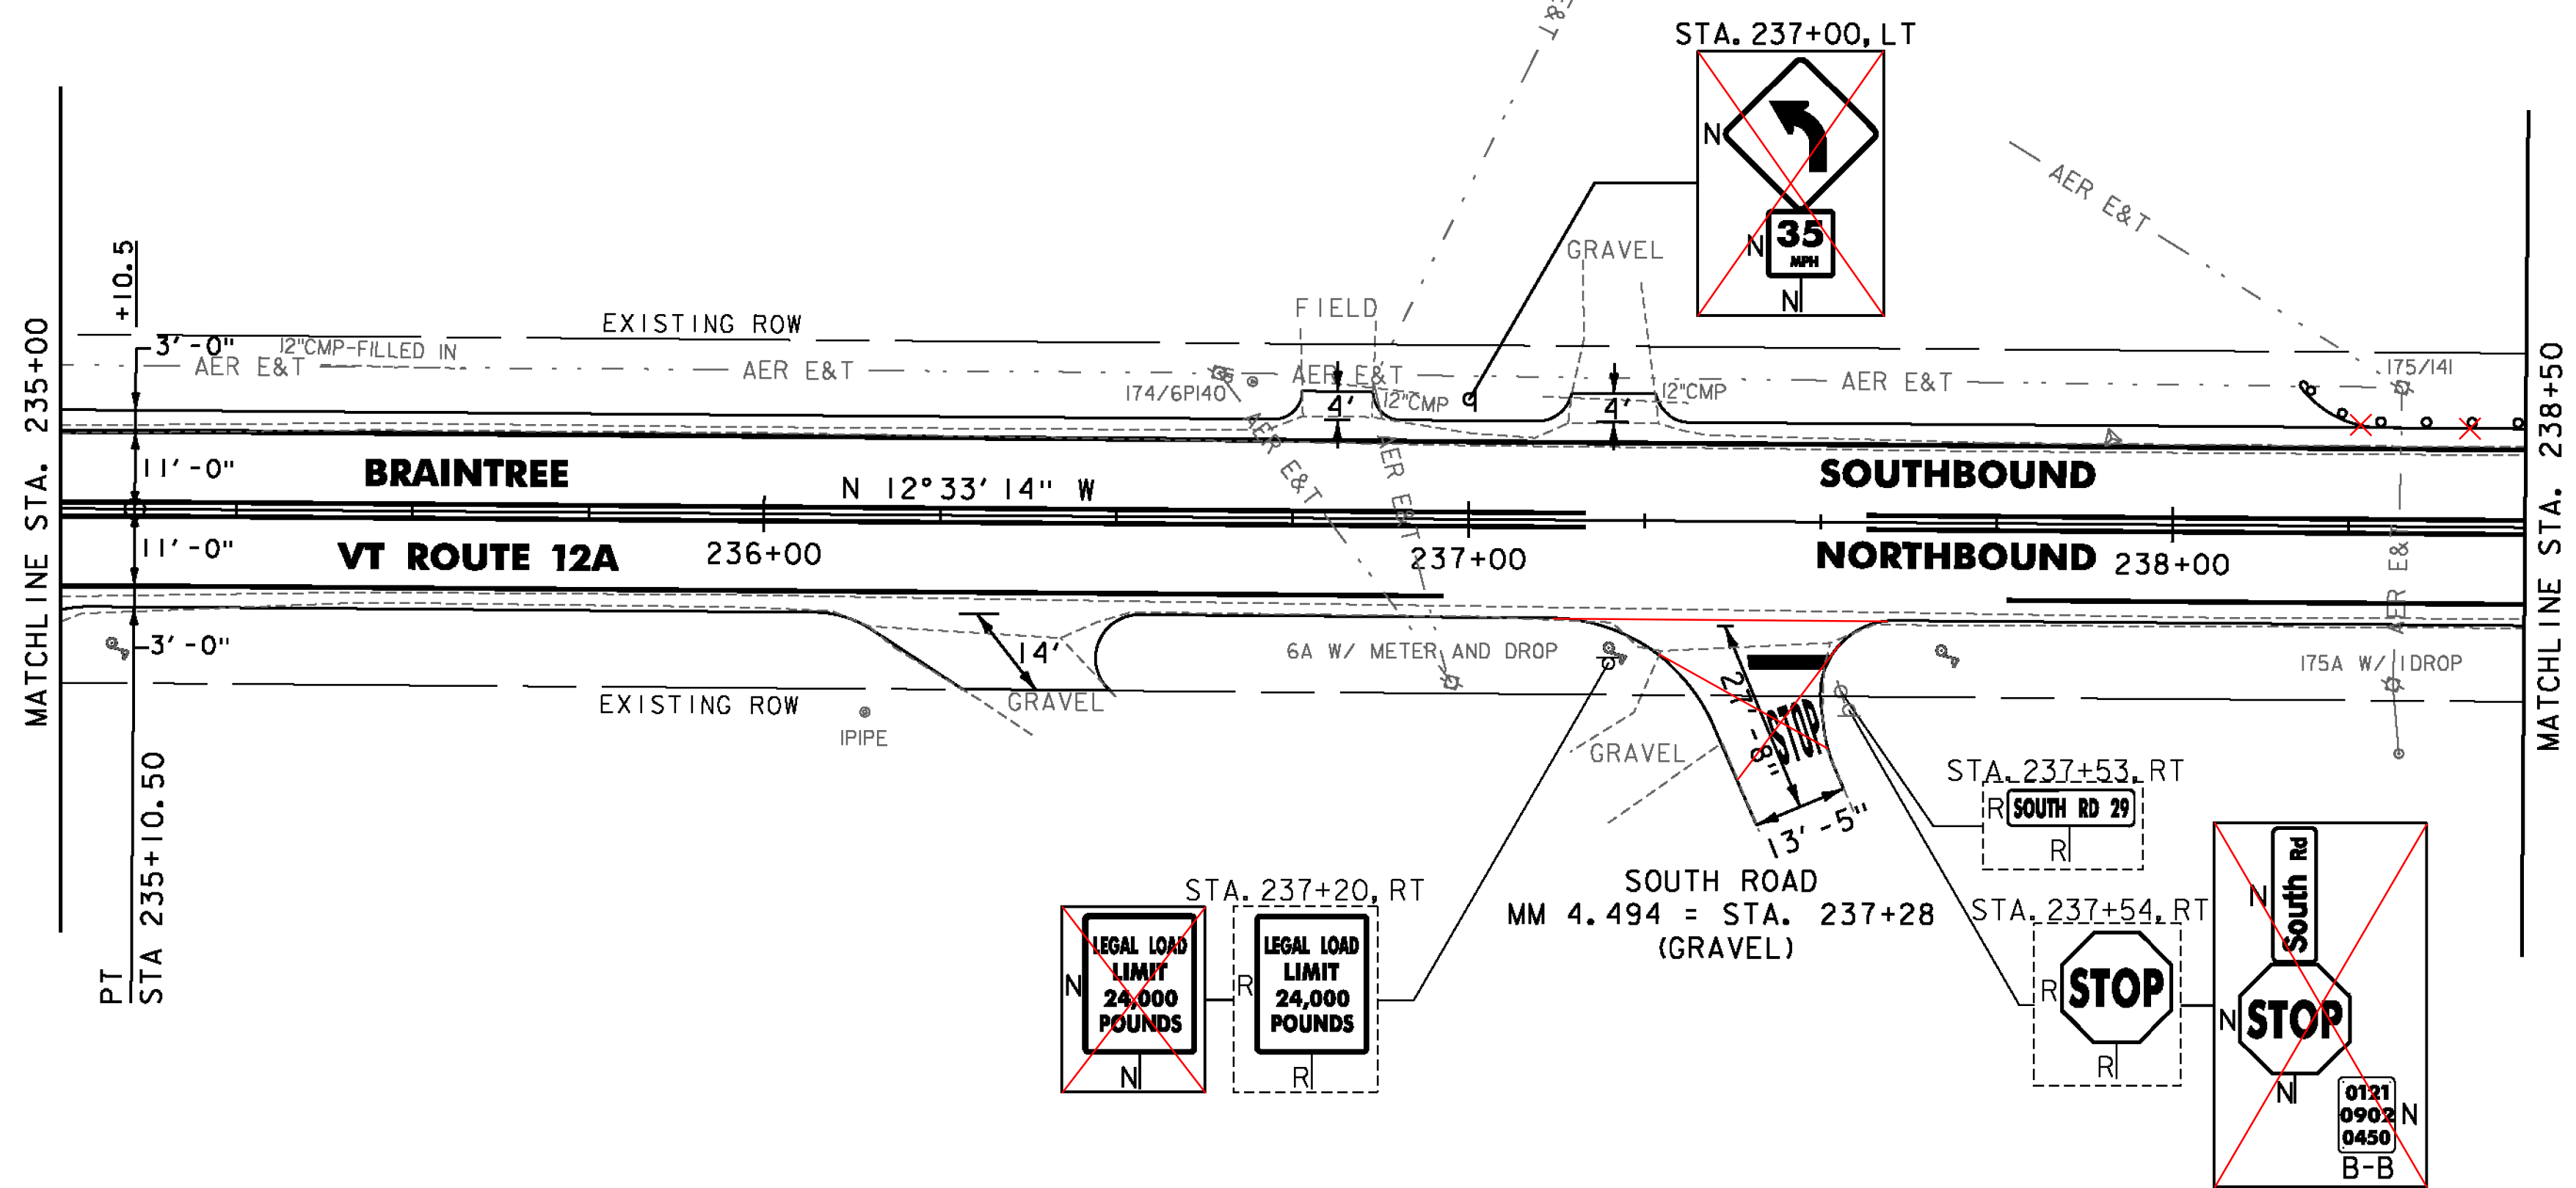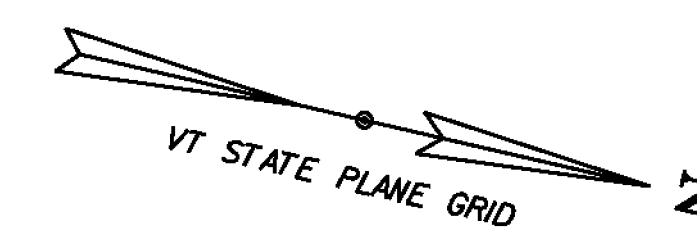

PROJECT NAME: RANDOLPH-ROXBURY  
 PROJECT NUMBER: ER STP 0187(II)  
 FILE NAME: z13cl82bdr.dgn  
 PROJECT LEADER: M. FOISY  
 DESIGNED BY: I. MAYNARD  
 PLOT DATE: 11/17/2014  
 DRAWN BY: G. BURGMEIER  
 CHECKED BY: M. FOISY  
**PLAN & PROFILE SHEET 57**  
 SHEET 98 OF 545

