

STONE FILL TYPE 1, GEOTEXTILE UNDER STONE FILL & GRUBBING MATERIAL  
 STA. 246+25 TO 246+75, LT

RELOCATE MAILBOX, SINGLE SUPPORT  
 STA. 245+65, RT  
 STA. 246+19, LT  
 STA. 247+44, RT  
 STA. 248+36, LT  
 STA. 249+25, RT

~~STEEL BEAM GUARDRAIL, GALVANIZED~~  
~~STA. 244+50.0 TO 244+92.2, LT~~  
~~ANCHOR FOR STEEL BEAM RAIL~~  
~~STA. 244+92.2, LT~~



DURABLE 4 INCH WHITE LINE, THERMOPLASTIC  
 DURABLE 4 INCH WHITE LINE, POLYUREA  
 TEMPORARY 4 INCH WHITE LINE, PAINT  
 STA. 244+50 TO 250+00, SOLID LT & RT

DURABLE 4 INCH YELLOW LINE, THERMOPLASTIC  
 DURABLE 4 INCH YELLOW LINE, POLYUREA  
 TEMPORARY 4 INCH YELLOW LINE, PAINT  
 STA. 244+50 TO 250+00, SOLID LT & RT




GEOTEXTILE FOR SILT FENCE  
 STA. 244+50 TO 245+50, LT  
 STA. 245+75 TO 246+25, RT  
 STA. 248+00 TO 248+50, RT  
 STA. 248+50 TO 249+50, LT

BARRIER FENCE  
 STA. 246+12 TO 248+00, LT  
 EROSION LOG  
 STA. 246+10 TO 248+00, LT

CURVE 45 DATA  
 R = 6500.00'  
 $\Delta = 3^\circ 53' 26.20''$   
 $D = 0^\circ 52' 53.30''$   
 T = 220.77'  
 L = 441.38'  
 E = 3.75'  
 e = NORMAL CROWN

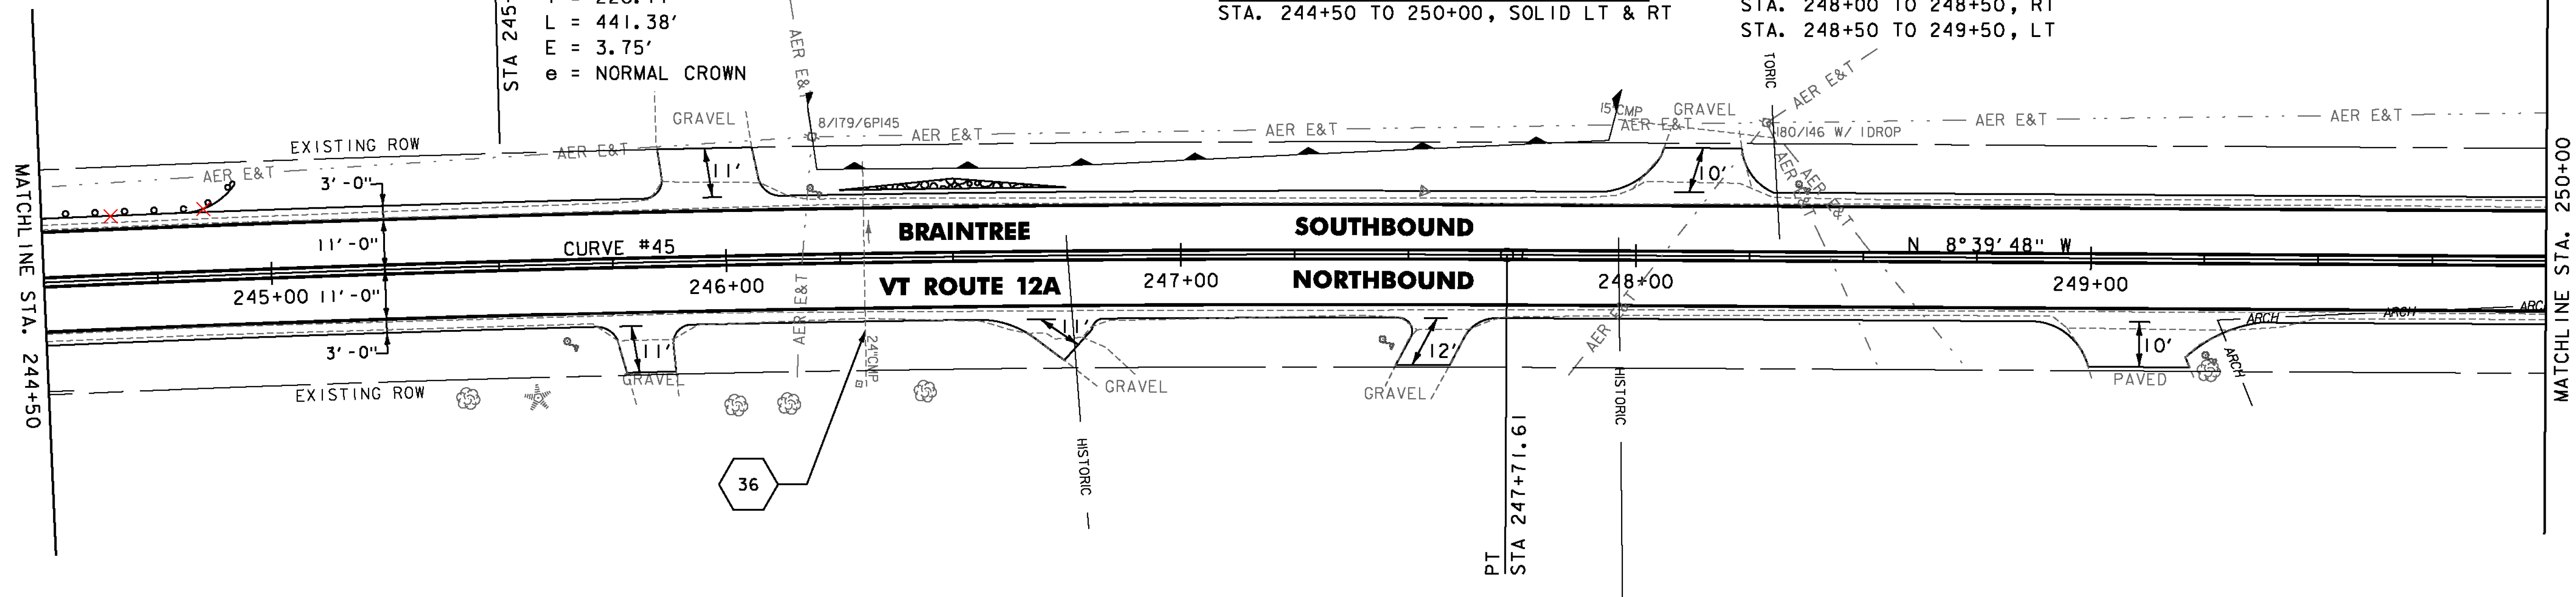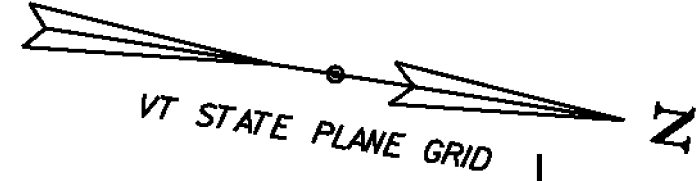

NOTE:  
 1. REFER TO SHEET 27 OF 545 FOR CULVERT INFORMATION.

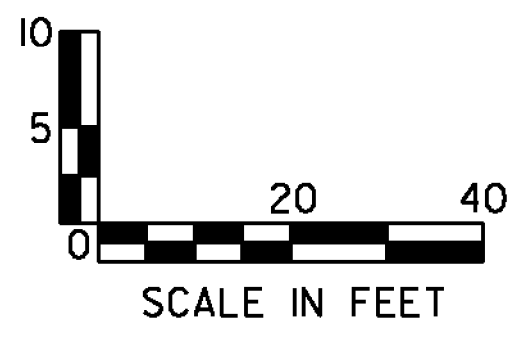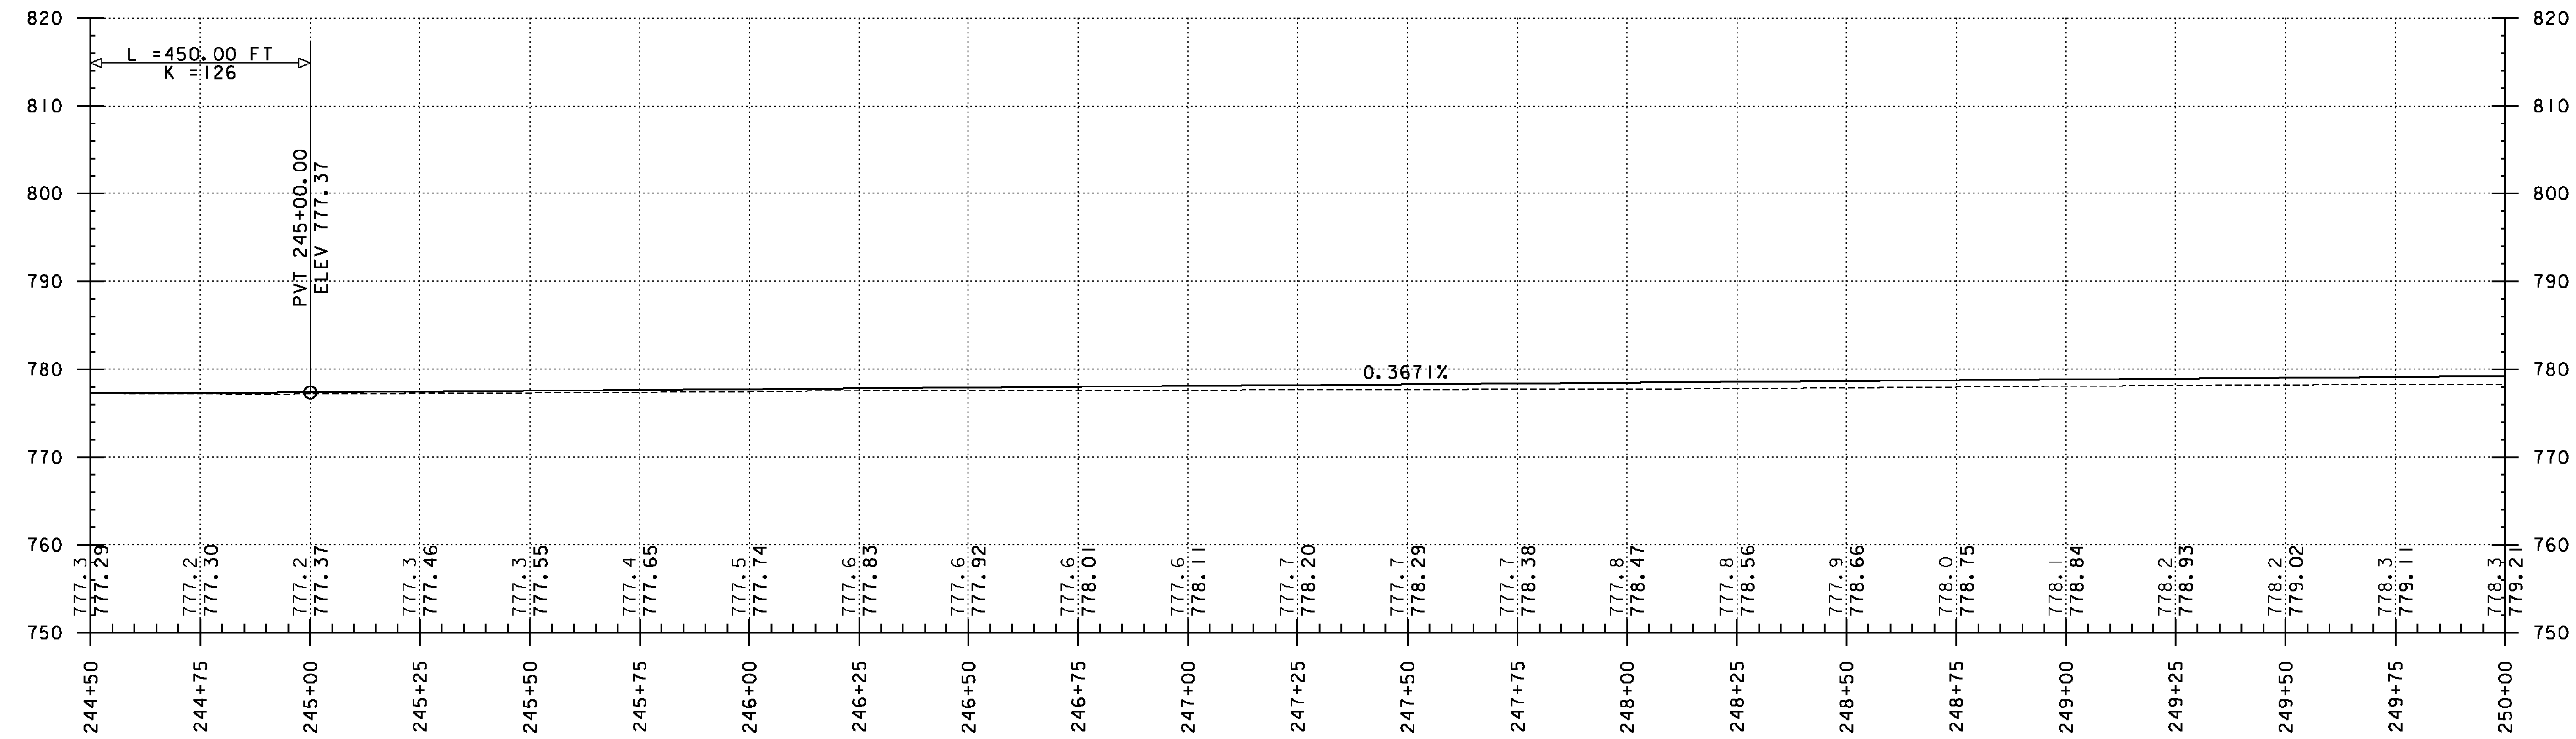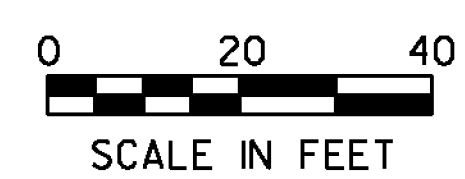

PROJECT NAME: RANDOLPH-ROXBURY  
 PROJECT NUMBER: ER STP 0187(II)

FILE NAME: z13cl82bdr.dgn  
 PROJECT LEADER: M. FOISY  
 DESIGNED BY: I. MAYNARD  
**PLAN & PROFILE SHEET 59**

PLOT DATE: 11/17/2014  
 DRAWN BY: G. BURGMEIER  
 CHECKED BY: M. FOISY  
 SHEET 100 OF 545

