


REHAB DIS, CBs, OR MHS, CLASS I
 STA. 251+40, RT
~~STONE FILL TYPE I, GEOTEXTILE UNDER STONE FILL & GRUBBING MATERIAL~~
~~STA. 251+00 TO 252+00, LT~~
~~STA. 253+50 TO 255+00, LT~~

RELOCATE MAILBOX, SINGLE SUPPORT
 STA. 250+04, LT
 STA. 250+43, RT
 STA. 252+82, RT
 STA. 253+64, RT



DURABLE 4 INCH WHITE LINE, THERMOPLASTIC
 DURABLE 4 INCH WHITE LINE, POLYUREA
 TEMPORARY 4 INCH WHITE LINE, PAINT
 STA. 250+00 TO 255+00, SOLID LT & RT

DURABLE 4 INCH YELLOW LINE, THERMOPLASTIC
 DURABLE 4 INCH YELLOW LINE, POLYUREA
 TEMPORARY 4 INCH YELLOW LINE, PAINT
 STA. 250+00 TO 255+00, SOLID LT & RT
 GEOTEXTILE FOR SILT FENCE
 STA. 250+50 TO 255+00, LT
 STA. 250+50 TO 251+25, RT

BARRIER FENCE
 STA. 250+37 TO 253+20, LT
 STA. 253+43 TO 255+00, LT
 EROSION LOG
 STA. 250+57 TO 252+73, LT
 STA. 253+43 TO 255+00, LT

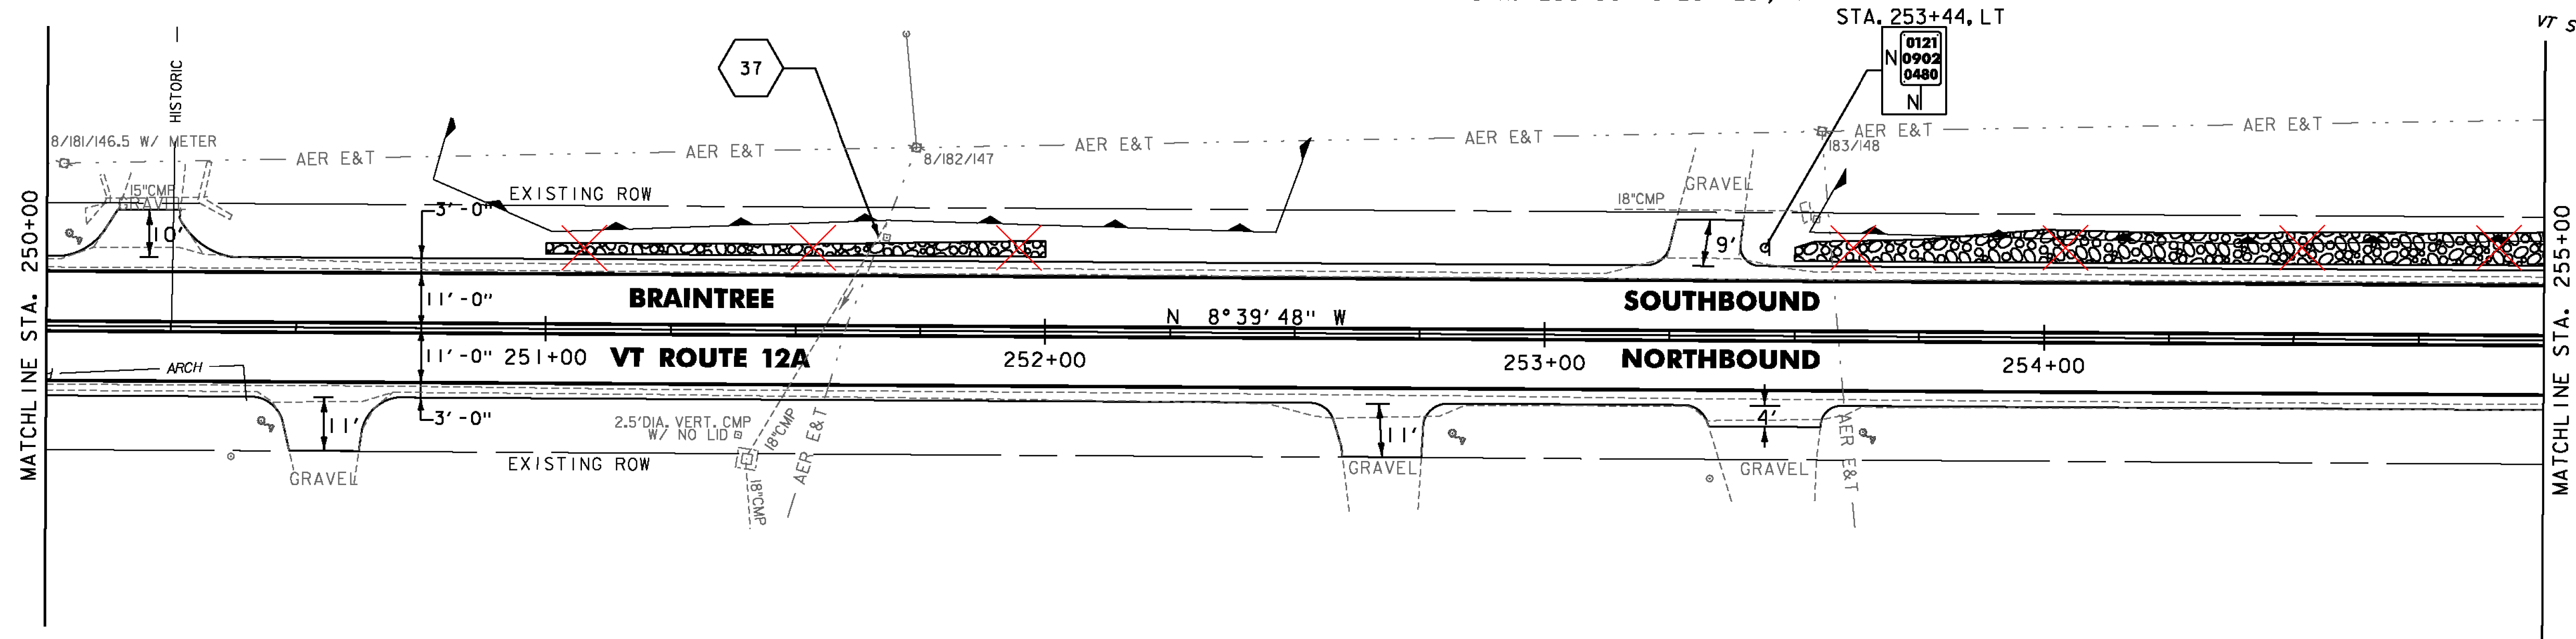

NOTE:
 1. REFER TO SHEET 27 OF 545 FOR CULVERT INFORMATION.

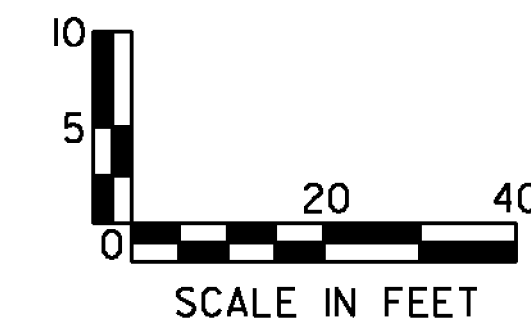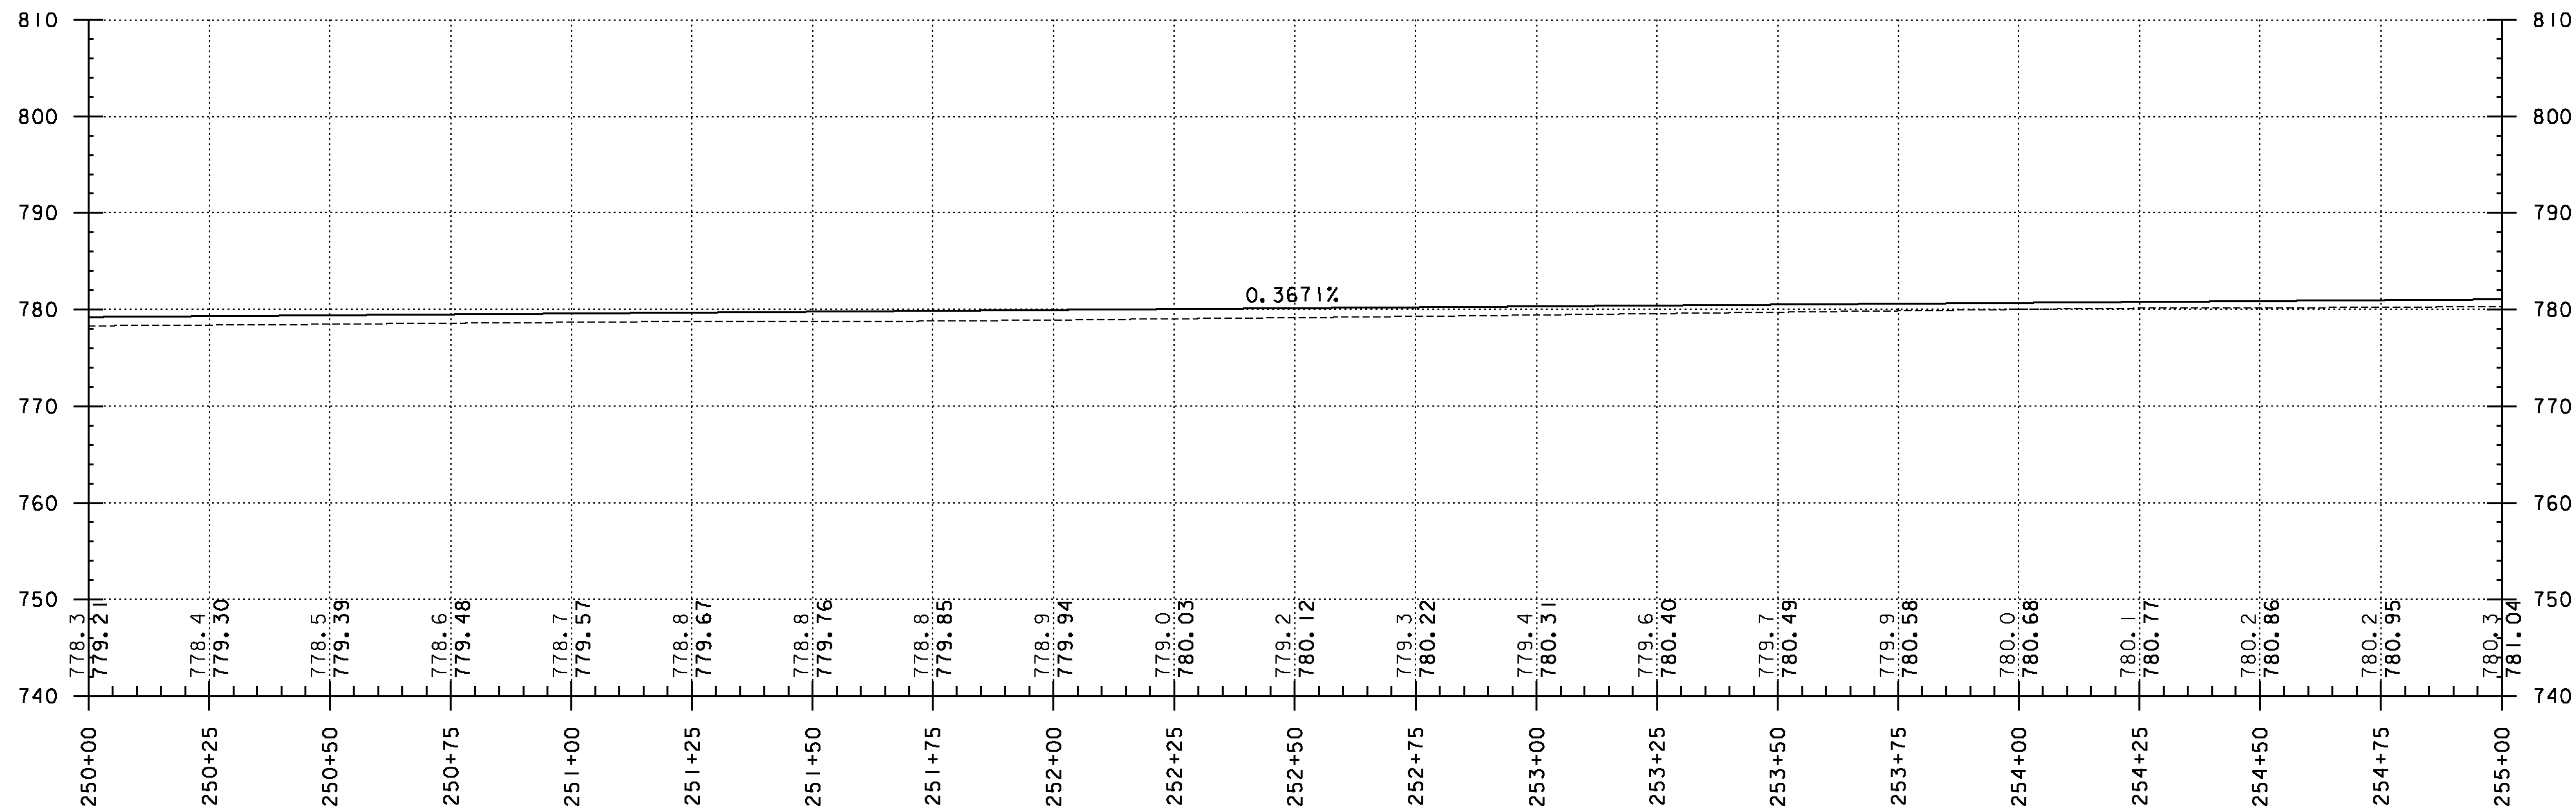

PROJECT NAME: RANDOLPH-ROXBURY
 PROJECT NUMBER: ER STP 0187(II)
 FILE NAME: z13cl82bdr.dgn
 PROJECT LEADER: M. FOISY
 DESIGNED BY: I. MAYNARD
 PLAN & PROFILE SHEET 60
 PLOT DATE: 11/17/2014
 DRAWN BY: G. BURGMEIER
 CHECKED BY: M. FOISY
 SHEET 101 OF 545