

STONE FILL TYPE I, GEOTEXTILE UNDER STONE FILL & GRUBBING MATERIAL
 STA. 260+00 TO 264+93, RT
 STA. 260+00 TO 261+61, LT
 STA. 263+85 TO 264+49, LT
 STA. 260+00 TO 261+50, LT
 STA. 261+26 TO 264+51, RT


RELOCATE MAILBOX, SINGLE SUPPORT
 STA. 263+27, LT

DURABLE 4 INCH WHITE LINE, THERMOPLASTIC
 DURABLE 4 INCH WHITE LINE, POLYUREA
 TEMPORARY 4 INCH WHITE LINE, PAINT
 STA. 260+00 TO 265+00, SOLID LT & RT

DURABLE 4 INCH YELLOW LINE, THERMOPLASTIC
 DURABLE 4 INCH YELLOW LINE, POLYUREA
 TEMPORARY 4 INCH YELLOW LINE, PAINT
 STA. 260+00 TO 265+00, SOLID LT & RT

GEOTEXTILE FOR SILT FENCE
 STA. 260+00 TO 264+50, LT
 STA. 264+00 TO 265+00, RT



BARRIER FENCE
 STA. 260+00 TO 261+91, LT
 STA. 260+00 TO 264+50, RT
 EROSION LOG
 STA. 260+00 TO 261+11, LT

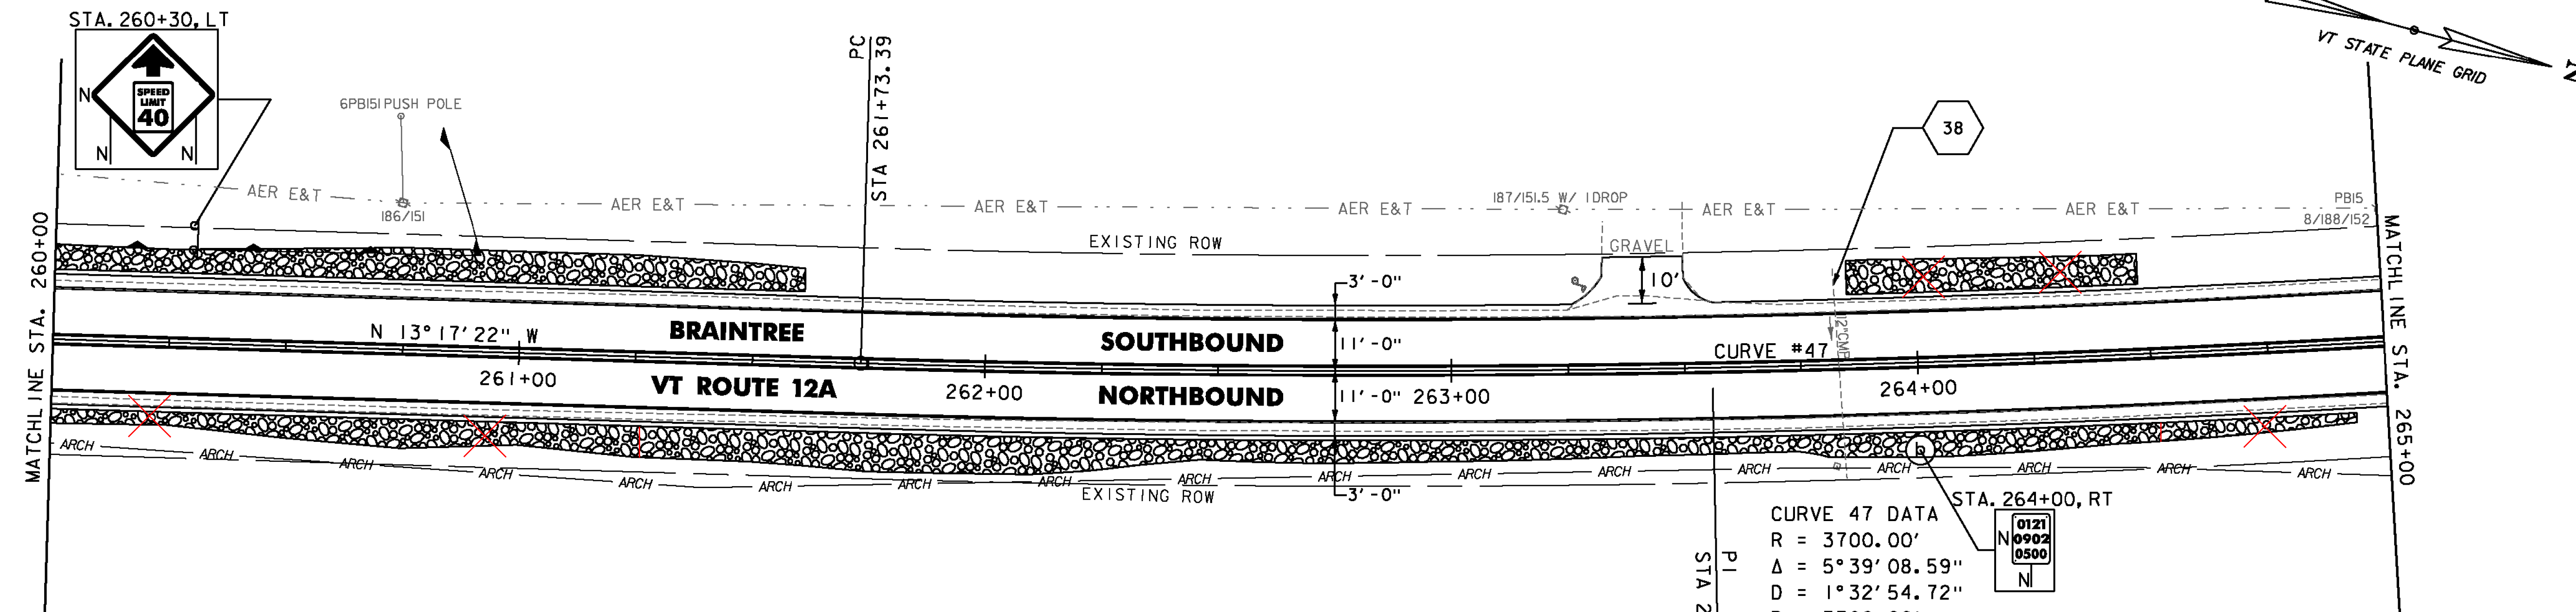

CURVE 47 DATA
 R = 3700.00'
 Δ = 5°39'08.59"
 D = 1°32'54.72"
 T = 182.66'
 L = 365.02'
 E = 4.51'
 e = 3.1%

NOTE:
 1. REFER TO SHEET 27 OF 545 FOR CULVERT INFORMATION.

0 20 40
 SCALE IN FEET

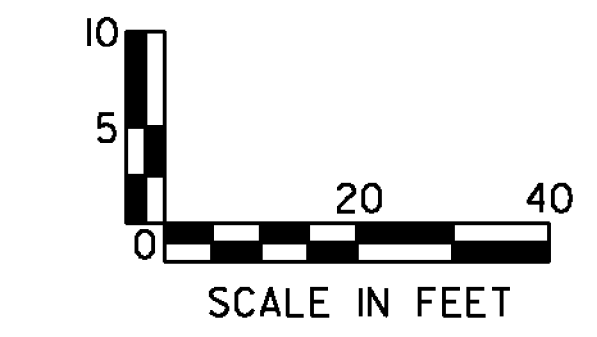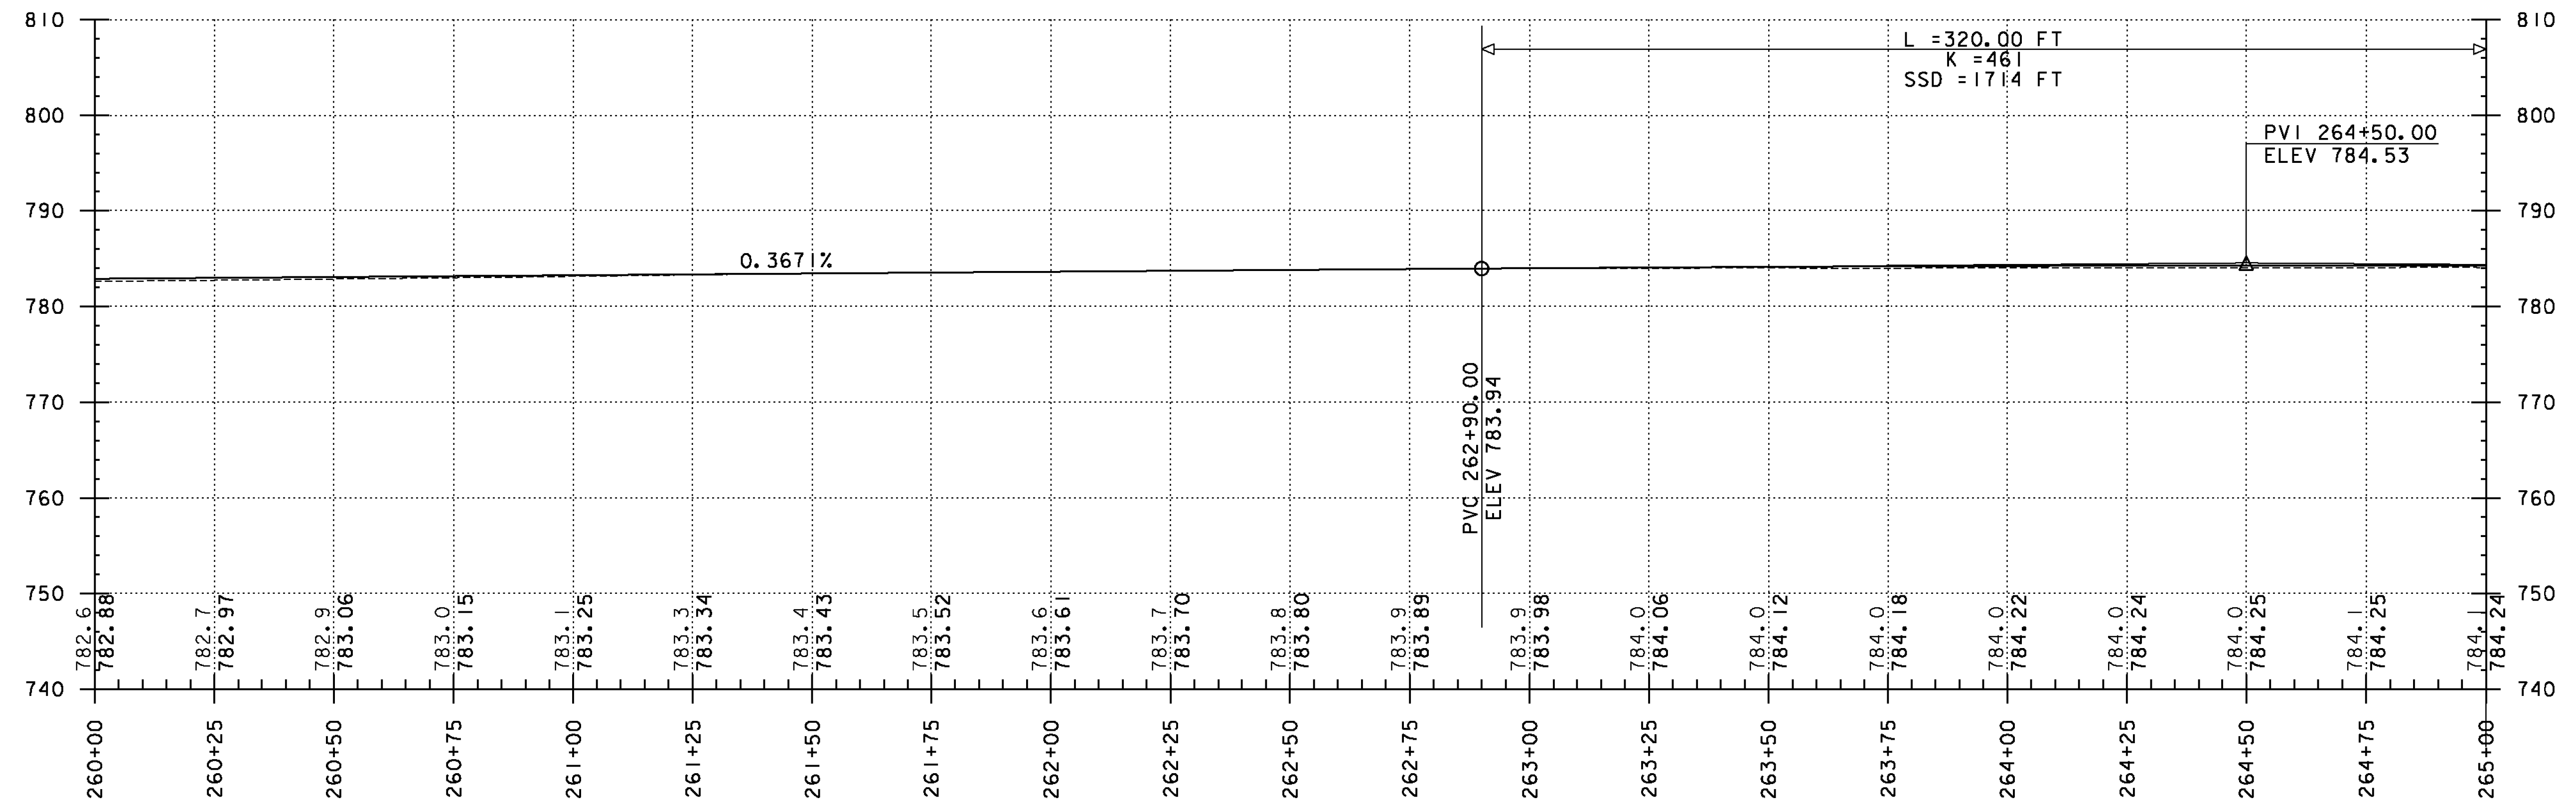

PROJECT NAME: RANDOLPH-ROXBURY
 PROJECT NUMBER: ER STP 0187(II)

FILE NAME: z13cl82bdr.dgn
 PROJECT LEADER: M. FOISY
 DESIGNED BY: I. MAYNARD
 PLAN & PROFILE SHEET 62

PLOT DATE: 11/17/2014
 DRAWN BY: G. BURGMEIER
 CHECKED BY: M. FOISY
 SHEET 103 OF 545

