

~~STONE FILL TYPE 1, GEOTEXTILE UNDER STONE FILL & GRUBBING MATERIAL~~  
~~STA. 270+00 TO 274+25, LT~~



DURABLE 4 INCH WHITE LINE, THERMOPLASTIC  
 DURABLE 4 INCH WHITE LINE, POLYUREA  
 TEMPORARY 4 INCH WHITE LINE, PAINT  
 STA. 270+00 TO 275+00, SOLID LT & RT

DURABLE 4 INCH YELLOW LINE, THERMOPLASTIC  
 DURABLE 4 INCH YELLOW LINE, POLYUREA  
 TEMPORARY 4 INCH YELLOW LINE, PAINT  
 STA. 270+00 TO 274+50, SOLID LT, DASHED RT  
 STA. 274+50 TO 275+00, SOLID LT & RT



GEOTEXTILE FOR SILT FENCE  
 STA. 270+00 TO 274+00, LT  
 STA. 273+00 TO 273+50, RT

BARRIER FENCE  
 STA. 273+41 TO 275+00, LT

EROSION LOG  
 STA. 274+21 TO 275+00, LT

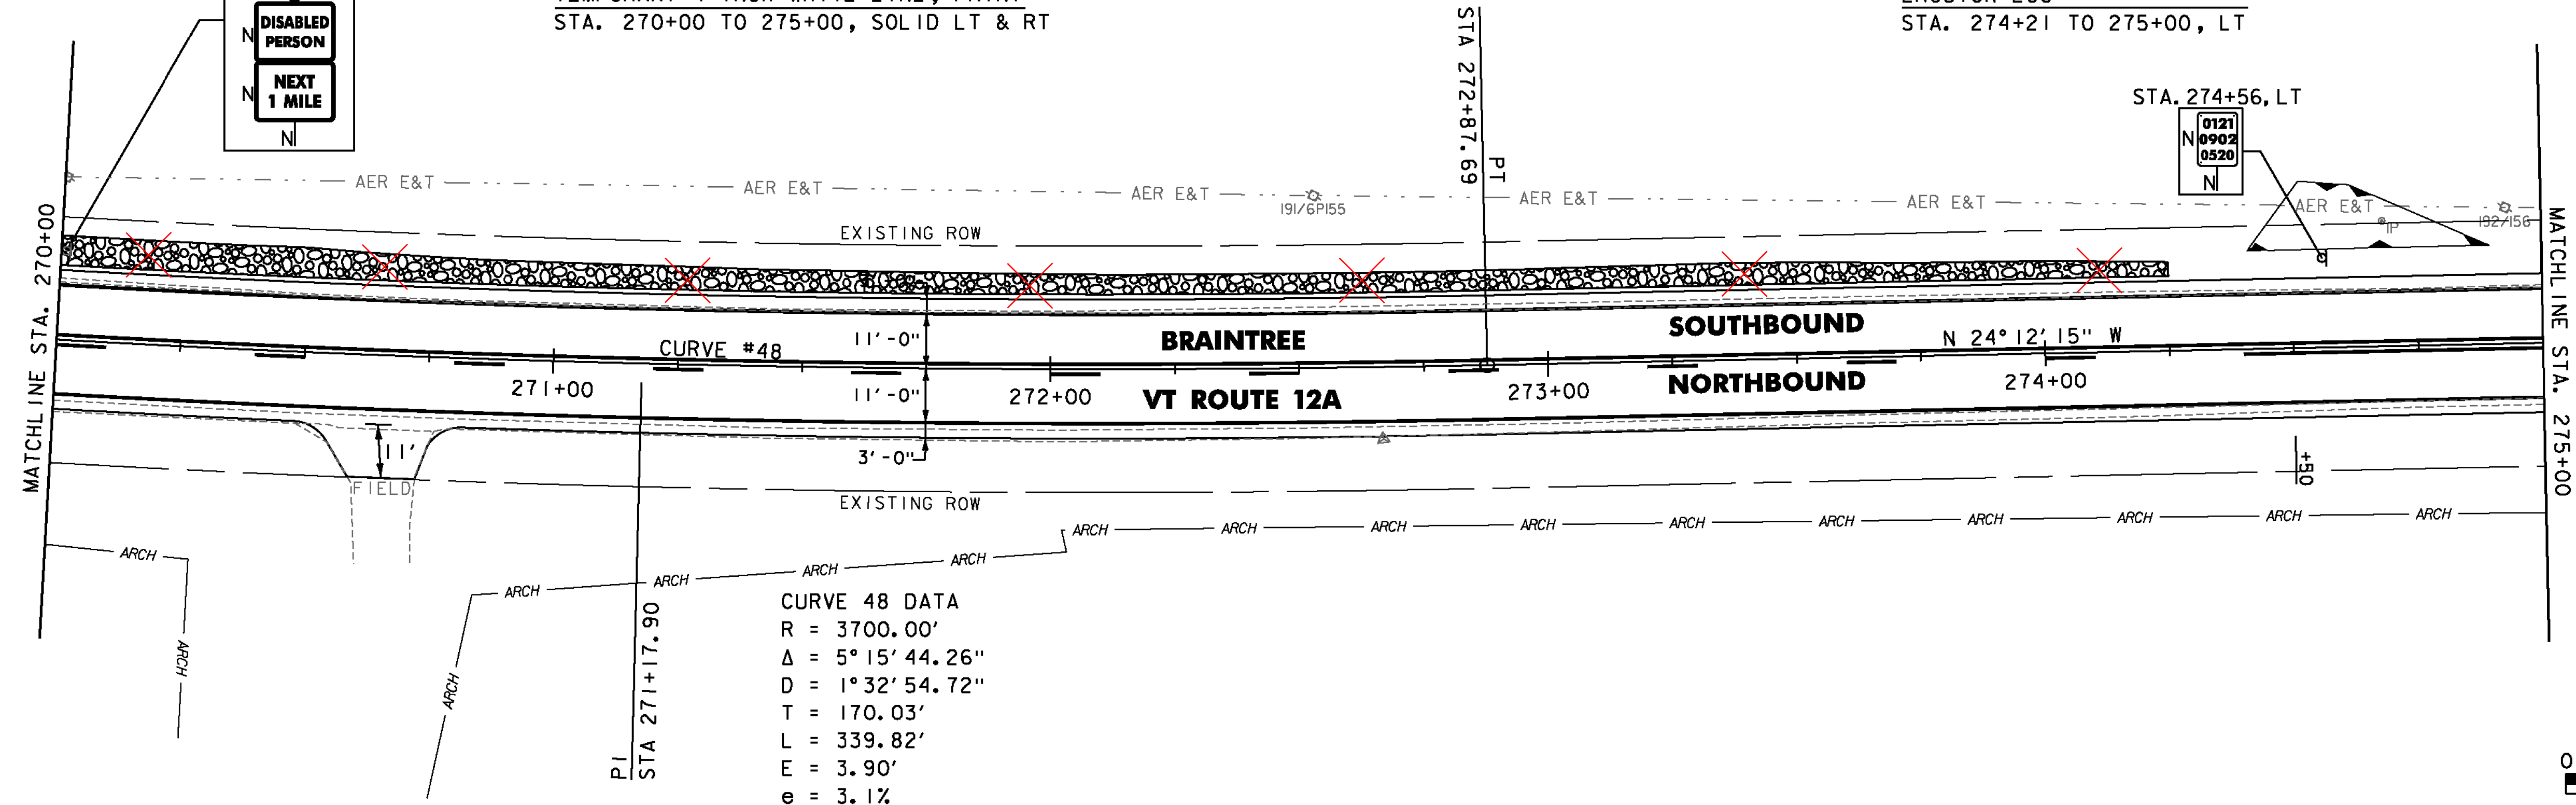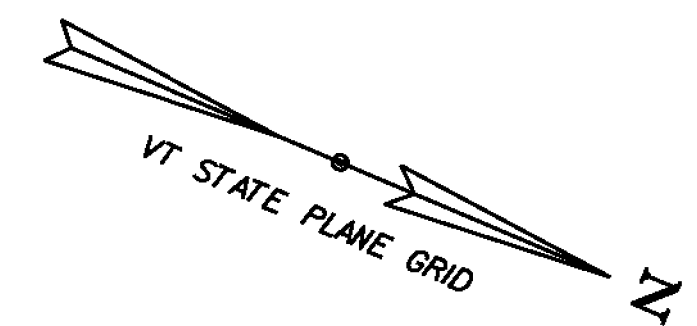

**CURVE 48 DATA**  
 R = 3700.00'  
 $\Delta = 5^\circ 15' 44.26''$   
 D =  $1^\circ 32' 54.72''$   
 T = 170.03'  
 L = 339.82'  
 E = 3.90'  
 $e = 3.1\%$

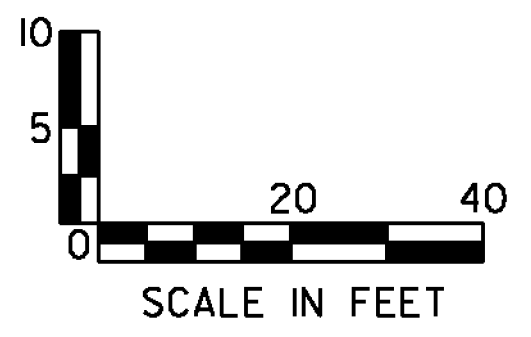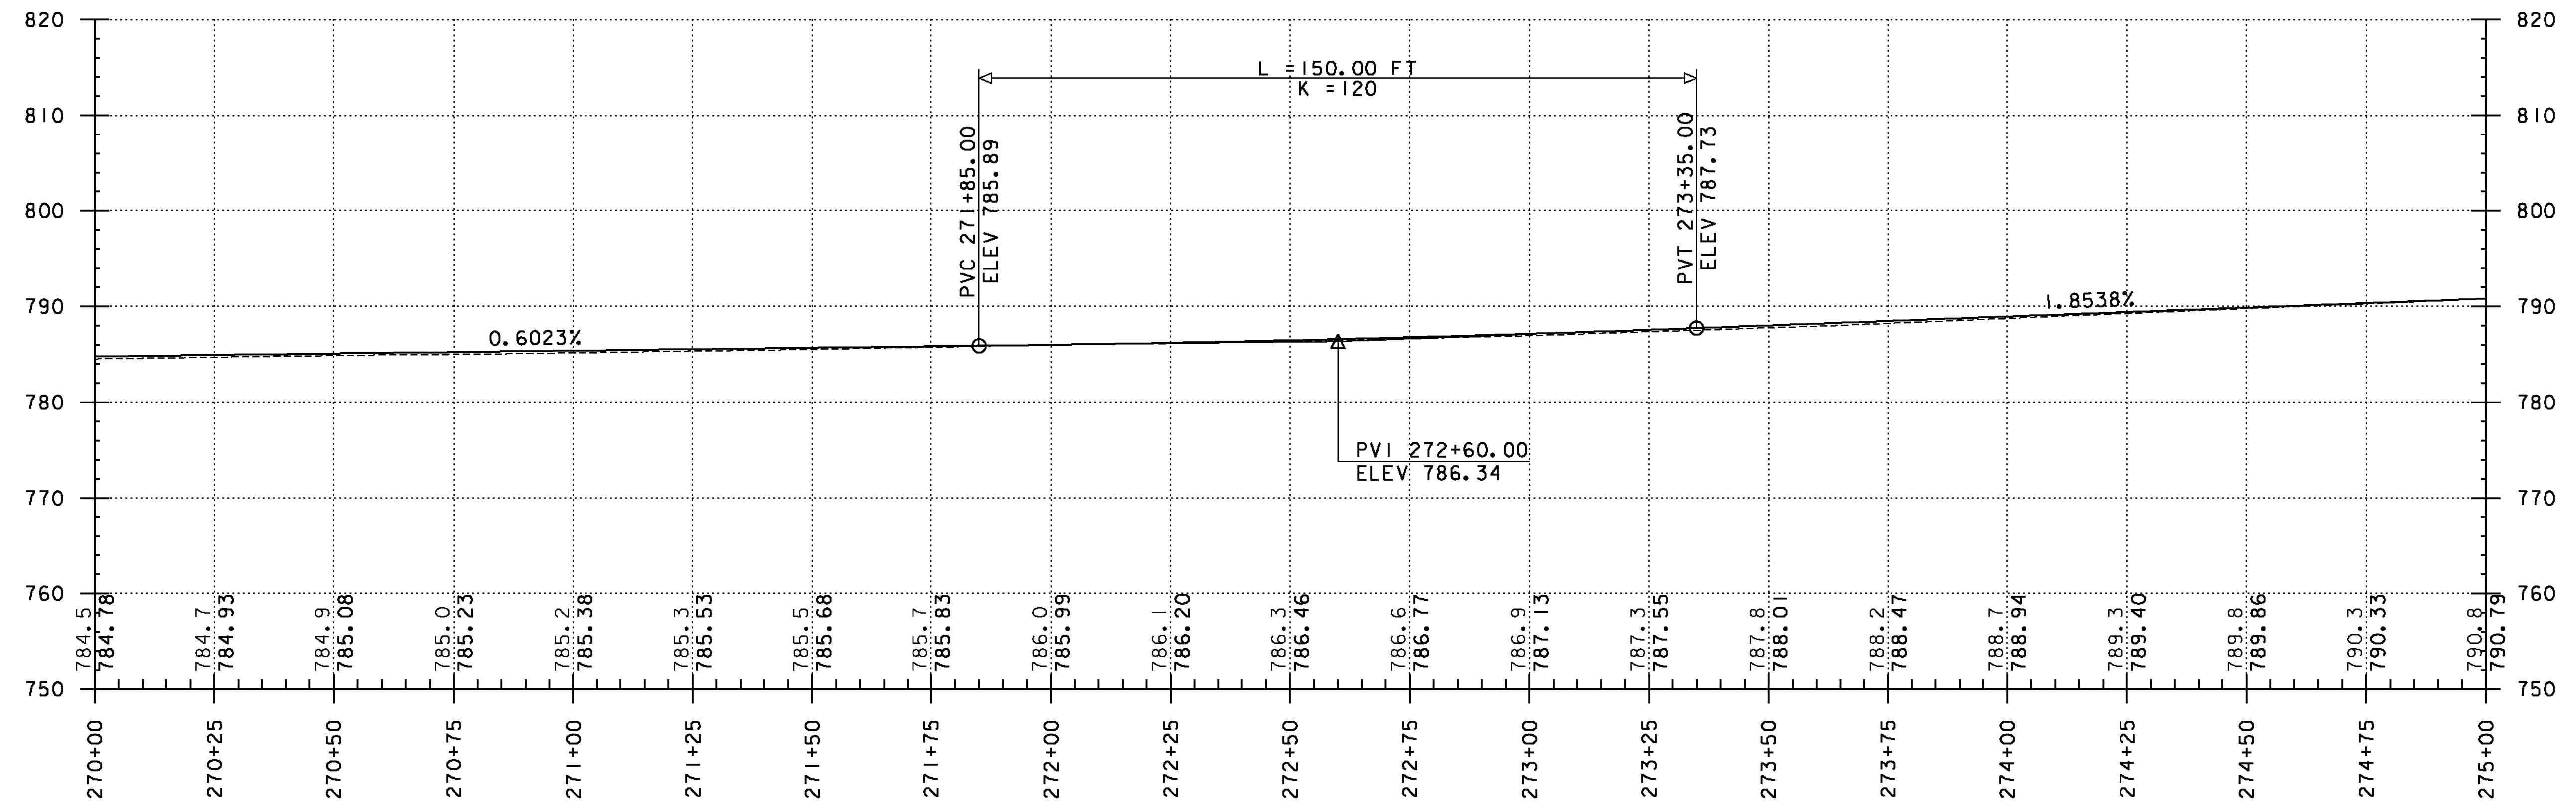

PROJECT NAME: RANDOLPH-ROXBURY  
 PROJECT NUMBER: ER STP 0187(II)

FILE NAME: z13cl82bdr.dgn  
 PROJECT LEADER: M. FOISY  
 DESIGNED BY: I. MAYNARD  
**PLAN & PROFILE SHEET 64**

PLOT DATE: 11/17/2014  
 DRAWN BY: G. BURGMEIER  
 CHECKED BY: M. FOISY  
 SHEET 105 OF 545

