

UNDERDRAIN FLUSHING BASIN
 STA. 278+25, LT STA. 278+30, LT
 STONE FILL TYPE 1, GEOTEXTILE UNDER STONE FILL
 & GRUBBING MATERIAL
 STA. 275+50 TO 276+45, LT



RELOCATE MAILBOX, SINGLE SUPPORT
 STA. 278+67, LT

DURABLE 4 INCH WHITE LINE, THERMOPLASTIC
 DURABLE 4 INCH WHITE LINE, POLYUREA
 TEMPORARY 4 INCH WHITE LINE, PAINT
 STA. 275+00 TO 280+00, SOLID LT & RT

DURABLE 4 INCH YELLOW LINE, THERMOPLASTIC
 DURABLE 4 INCH YELLOW LINE, POLYUREA
 TEMPORARY 4 INCH YELLOW LINE, PAINT
 STA. 275+00 TO 275+09, SOLID LT & RT
 STA. 275+09 TO 280+00, SOLID RT, DASHED LT

GEOTEXTILE FOR SILT FENCE
 STA. 275+50 TO 276+00, LT
 STA. 277+25 TO 277+75, RT
 STA. 279+75 TO 280+00, LT
 BARRIER FENCE
 STA. 275+00 TO 277+49, LT

EROSION LOG
 STA. 275+00 TO 276+69, LT
 STA. 277+00 TO 278+00, LT


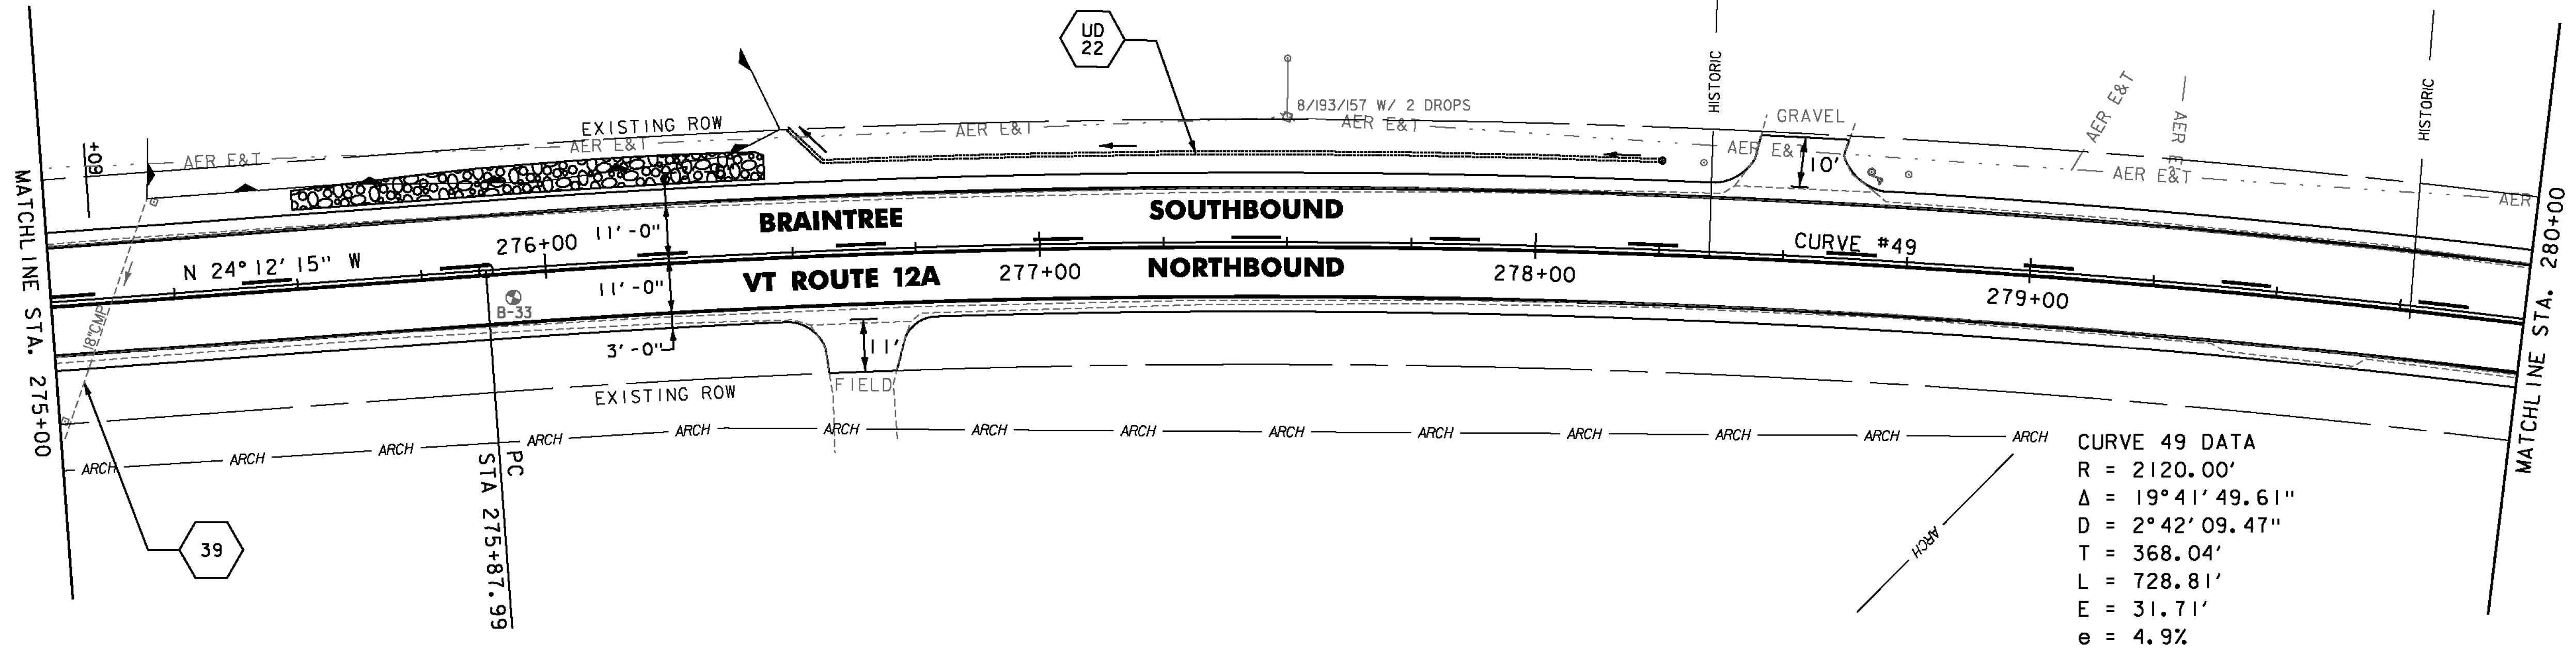
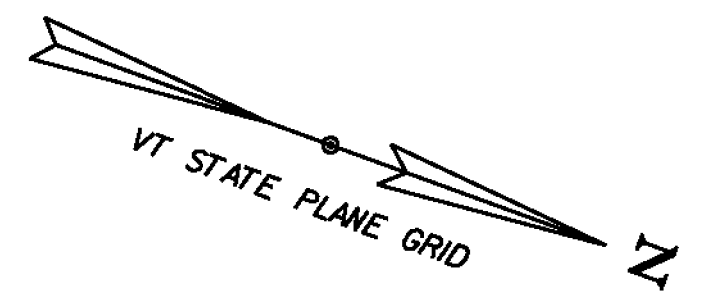


CURVE 49 DATA
 R = 2120.00'
 $\Delta = 19^\circ 41' 49.61''$
 D = 2° 42' 09.47"
 T = 368.04'
 L = 728.81'
 E = 31.71'
 e = 4.9%

SOIL BORING DATA			
BORING#	DEPTH (FT.)	PCC	COMMENTS
B-33	5.0'	NO	

UD 22
 STA 276+50, LT TO 278+25, LT
 CONSTRUCT 6 INCH UNDERDRAIN PIPE,
 SEE SHEET 8 FOR DETAIL AND
 ASSOCIATED QUANTITIES.

NOTE:
 1. REFER TO SHEET 27 OF 545
 FOR CULVERT INFORMATION.

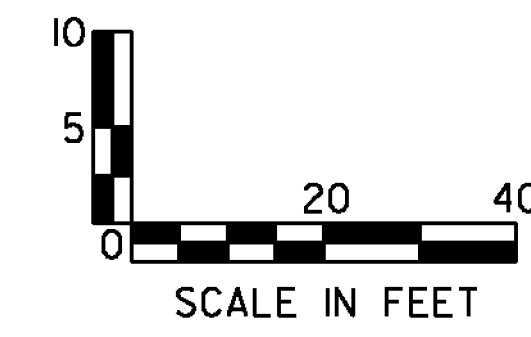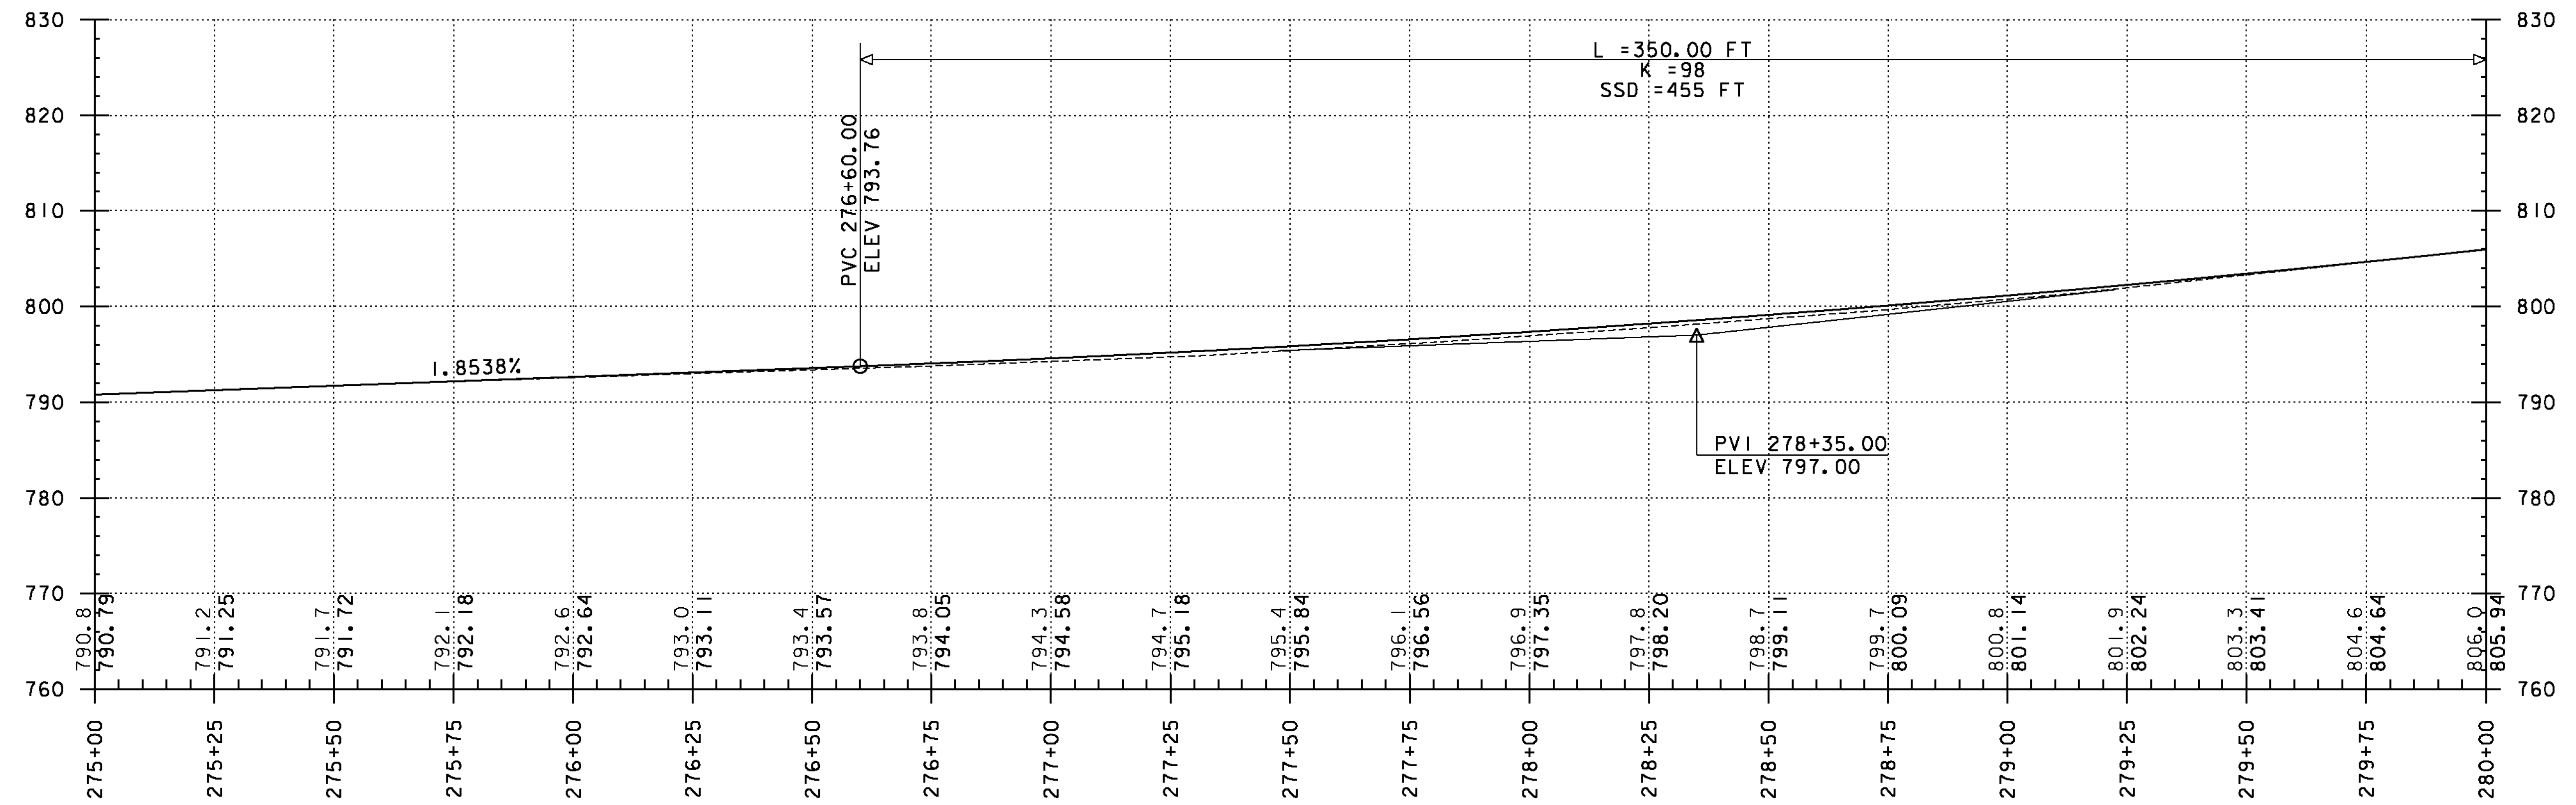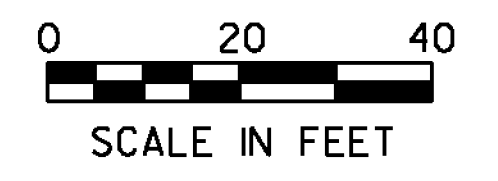

PROJECT NAME: RANDOLPH-ROXBURY
 PROJECT NUMBER: ER STP 0187(II)
 FILE NAME: z13cl82bdr.dgn
 PROJECT LEADER: M. FOISY
 DESIGNED BY: I. MAYNARD
 PLOT DATE: 11/17/2014
 DRAWN BY: G. BURGMEIER
 CHECKED BY: M. FOISY
PLAN & PROFILE SHEET 65
 SHEET 106 OF 545

