
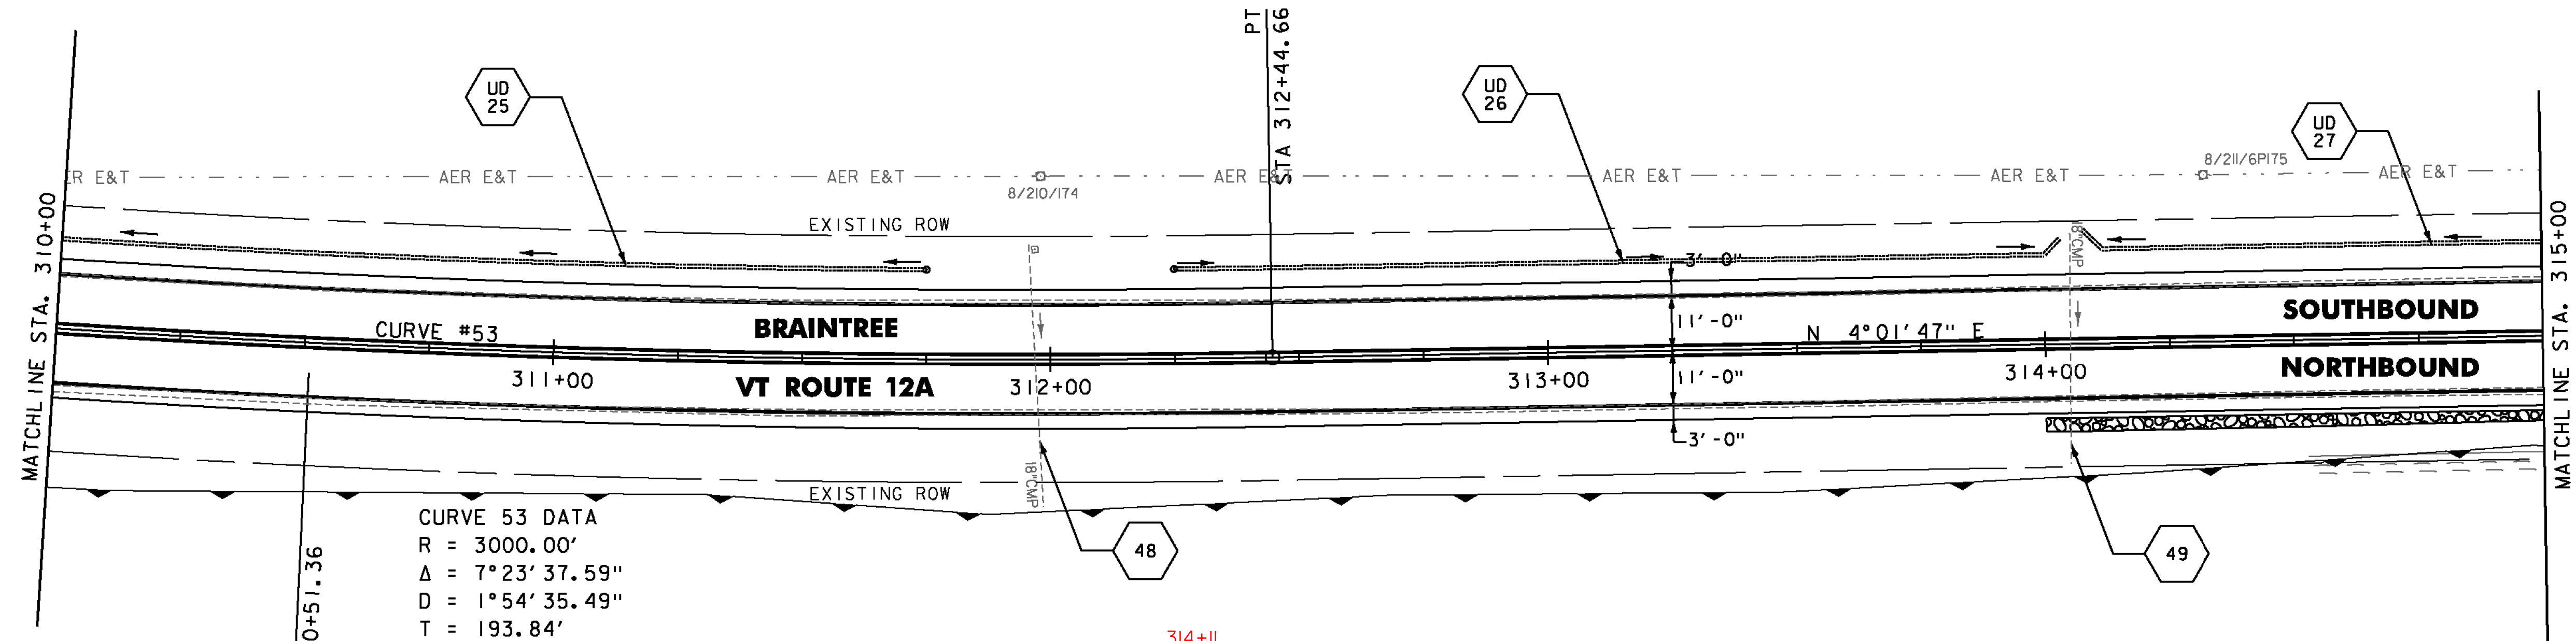


UNDERDRAIN FLUSHING BASIN
 STA. 311+75, LT STA. 311+61, LT
 STA. 312+25, LT
 STONE FILL TYPE I, GEOTEXTILE UNDER STONE FILL
 & GRUBBING MATERIAL
 STA. 314+00 TO 315+00, RT

DURABLE 4 INCH WHITE LINE, THERMOPLASTIC
 DURABLE 4 INCH WHITE LINE, POLYUREA
 TEMPORARY 4 INCH WHITE LINE, PAINT
 STA. 310+00 TO 315+00, SOLID LT & RT

DURABLE 4 INCH YELLOW LINE, THERMOPLASTIC
 DURABLE 4 INCH YELLOW LINE, POLYUREA
 TEMPORARY 4 INCH YELLOW LINE, PAINT
 STA. 310+00 TO 315+00, SOLID LT & RT



BARRIER FENCE
 STA. 310+00 TO 315+00, RT
 EROSION LOG
 STA. 310+00 TO 315+00, RT
 STA. 310+00 TO 311+50, LT
 STA. 312+50 TO 315+00, LT

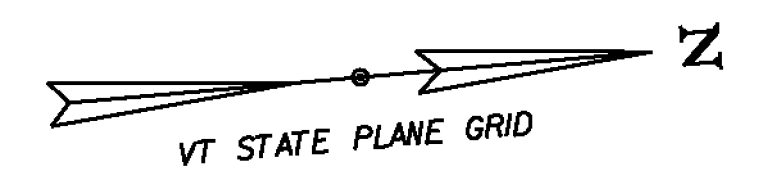

CURVE #53 DATA
 R = 3000.00'
 $\Delta = 7^\circ 23' 37.59''$
 $D = 1^\circ 54' 35.49''$
 T = 193.84'
 L = 387.14'
 E = 6.26'
 e = 3.7%

- UD 26 STA 312+25, LT TO 314+03, LT
CONSTRUCT 6 INCH UNDERDRAIN PIPE,
SEE SHEET 8 FOR DETAIL AND
ASSOCIATED QUANTITIES.
- UD 27 STA 314+08, LT TO 316+00, LT
CONSTRUCT 6 INCH UNDERDRAIN PIPE,
SEE SHEET 8 FOR DETAIL AND
ASSOCIATED QUANTITIES.

NOTE:
 1. REFER TO SHEET 27 OF 545
 FOR CULVERT INFORMATION.

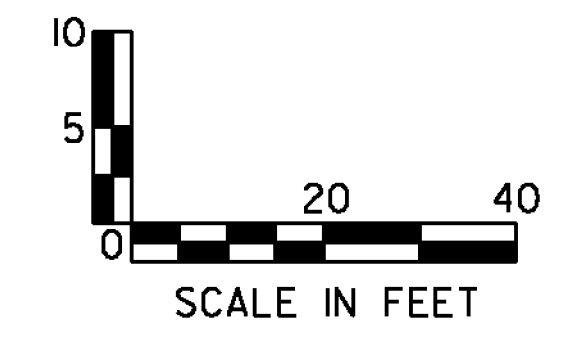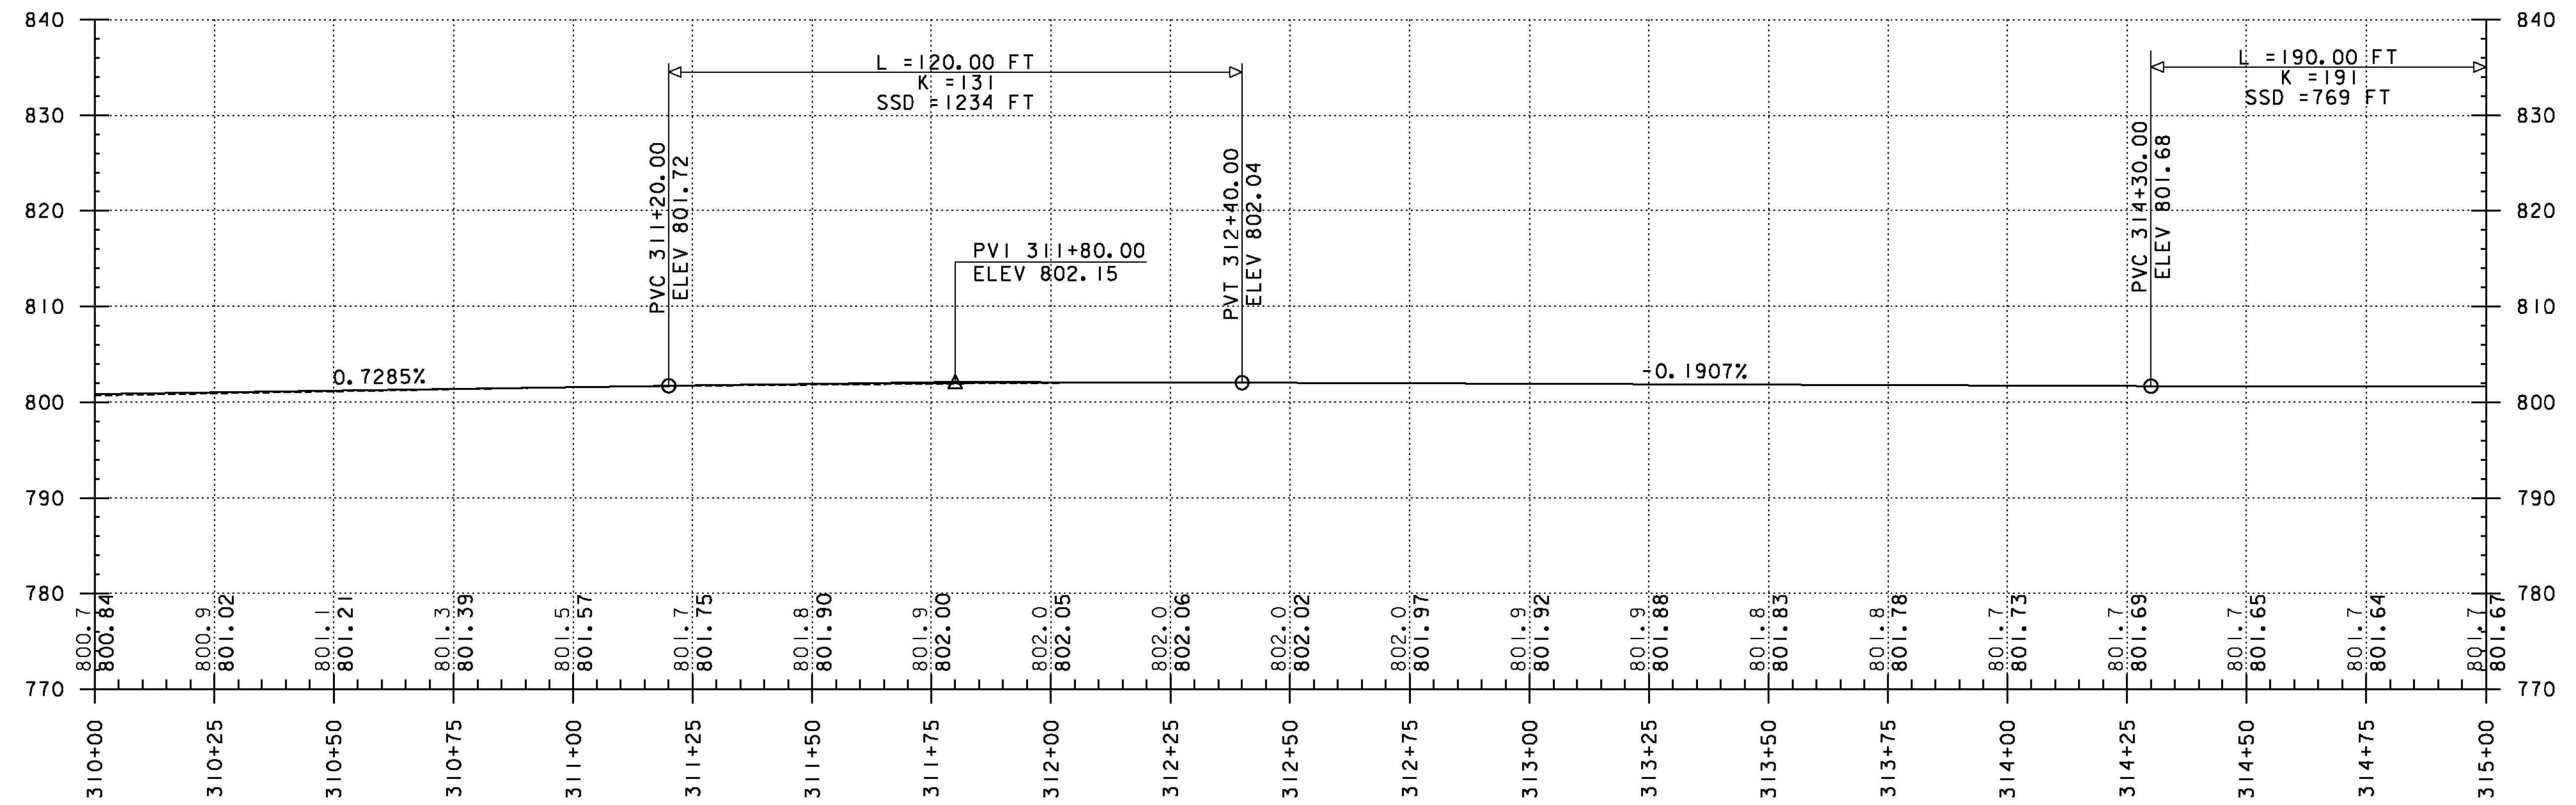

PROJECT NAME: RANDOLPH-ROXBURY
 PROJECT NUMBER: ER STP 0187(II)
 FILE NAME: z13cl82bdr.dgn
 PROJECT LEADER: M. FOISY
 DESIGNED BY: I. MAYNARD
 PLAN & PROFILE SHEET 72
 PLOT DATE: 11/17/2014
 DRAWN BY: G. BURGMEIER
 CHECKED BY: M. FOISY
 SHEET 113 OF 545

