

UNDERDRAIN FLUSHING BASIN



STA. 316+00, LT
~~STA. 319+25, LT~~ ~~STA. 318+86, LT~~
 STONE FILL TYPE I, GEOTEXTILE UNDER STONE FILL & GRUBBING MATERIAL
 STA. 315+00 TO 316+14, RT
~~STA. 319+63 TO 320+25, LT~~

DURABLE 4 INCH WHITE LINE, THERMOPLASTIC
 DURABLE 4 INCH WHITE LINE, POLYUREA
 TEMPORARY 4 INCH WHITE LINE, PAINT
 STA. 315+00 TO 320+50, SOLID LT & RT

DURABLE 4 INCH YELLOW LINE, THERMOPLASTIC
 DURABLE 4 INCH YELLOW LINE, POLYUREA
 TEMPORARY 4 INCH YELLOW LINE, PAINT
 STA. 315+00 TO 320+50, SOLID LT & RT



GEOTEXTILE FOR SILT FENCE
 STA. 315+50 TO 316+00, RT
 STA. 320+00 TO 320+50, LT
 BARRIER FENCE
 STA. 315+00 TO 320+50, RT
 STA. 318+39 TO 320+50, LT

EROSION LOG
 STA. 315+00 TO 320+00, RT
 STA. 315+00 TO 320+00, LT
 STA. 319+19 TO 320+50, LT

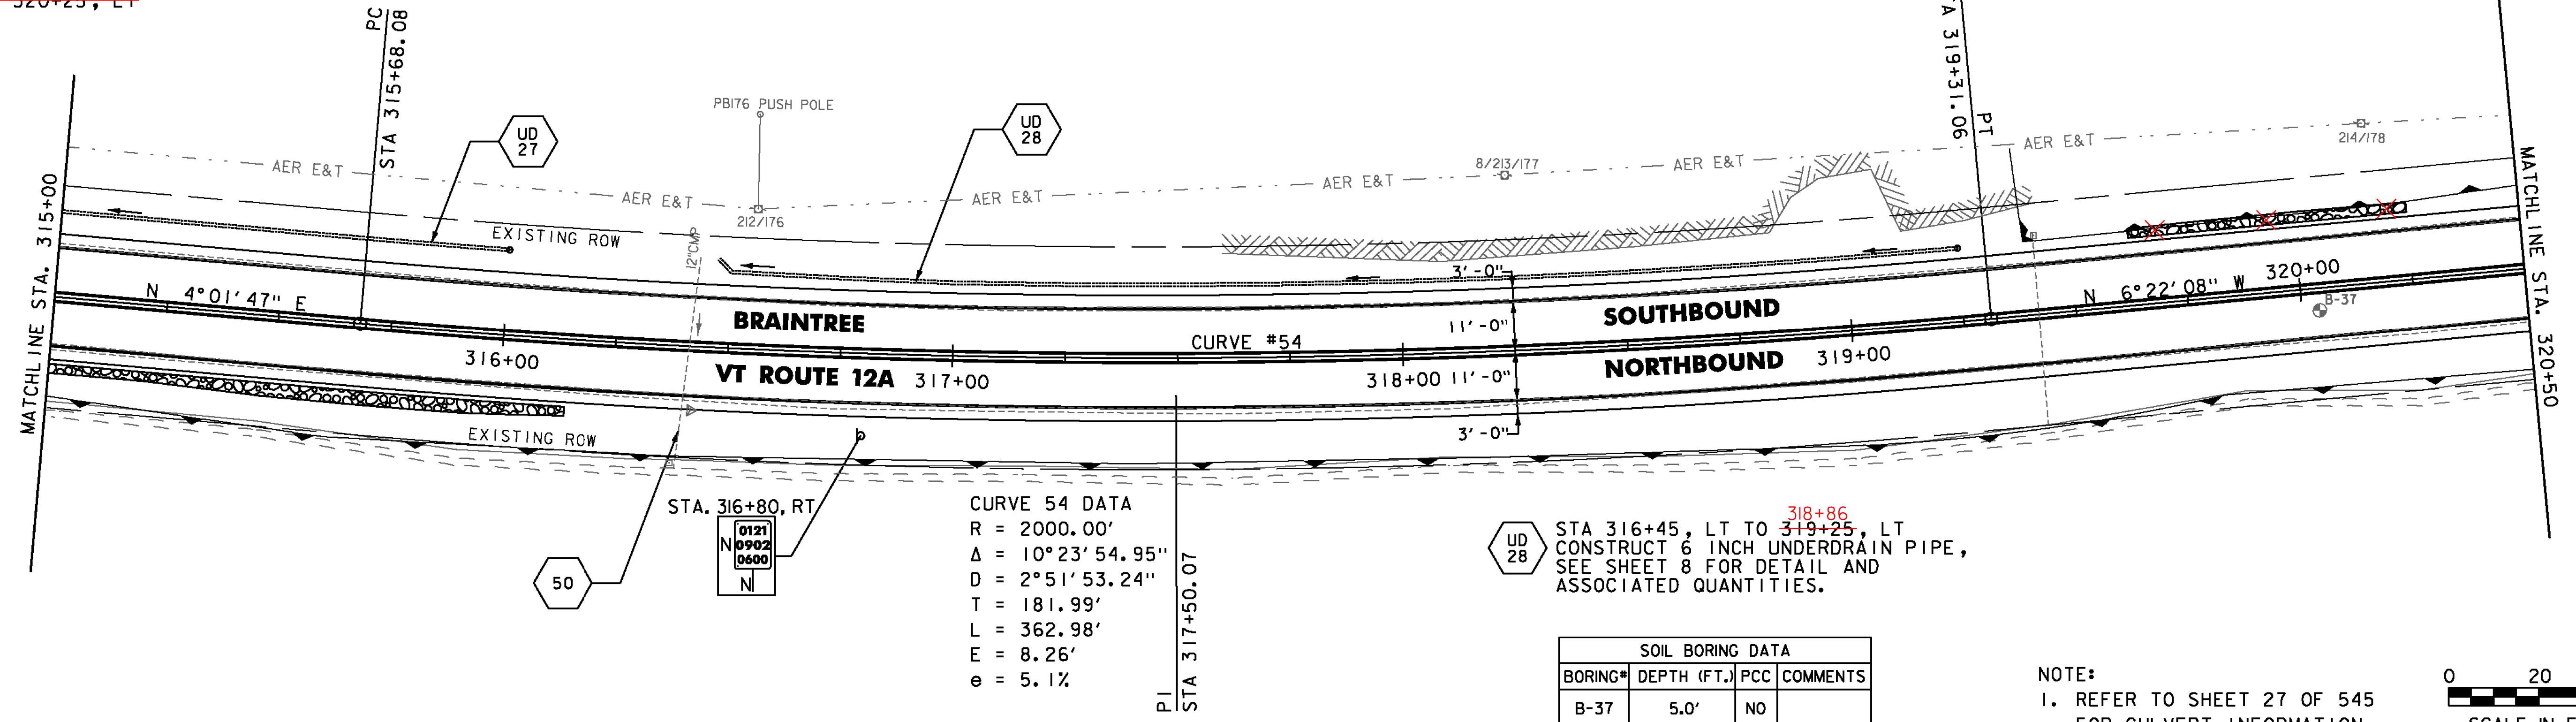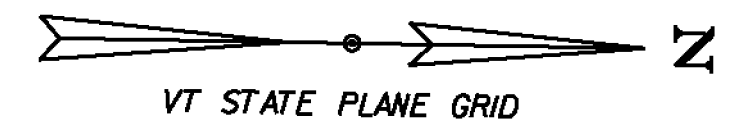

SOIL BORING DATA			
BORING#	DEPTH (FT.)	PCC	COMMENTS
B-37	5.0'	NO	

NOTE:
 1. REFER TO SHEET 27 OF 545 FOR CULVERT INFORMATION.

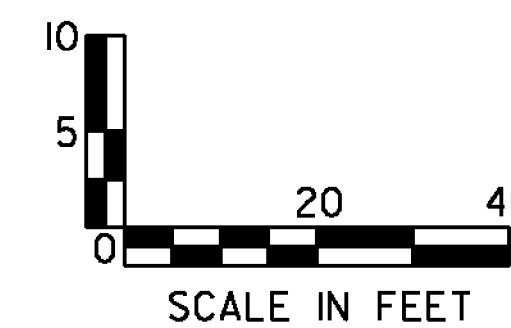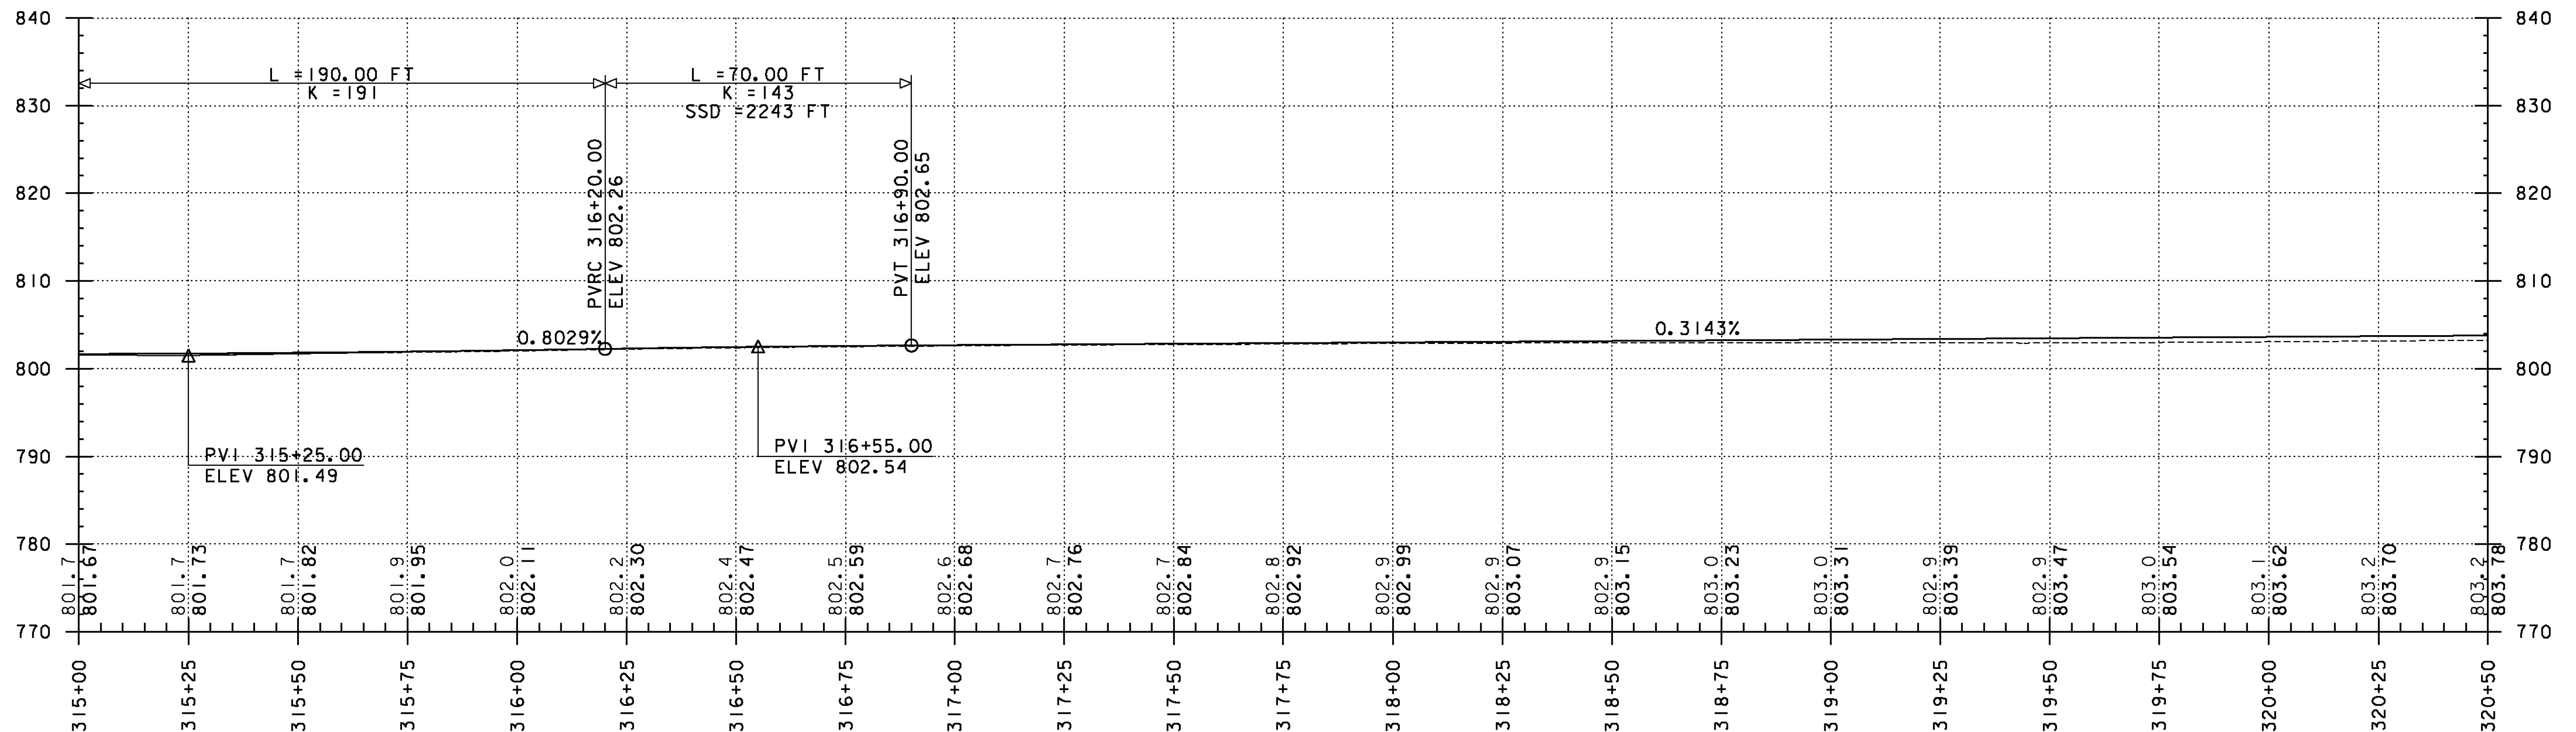

PROJECT NAME: RANDOLPH-ROXBURY
 PROJECT NUMBER: ER STP 0187(II)

FILE NAME: z13cl82bdr.dgn
 PROJECT LEADER: M. FOISY
 DESIGNED BY: I. MAYNARD
 PLOT DATE: 11/17/2014
 DRAWN BY: G. BURGMEIER
 CHECKED BY: M. FOISY
PLAN & PROFILE SHEET 73
 SHEET 114 OF 545

