

STONE FILL TYPE I, GEOTEXTILE UNDER STONE FILL & GRUBBING MATERIAL
 STA. 332+93 TO 334+00, RT
 STA. 334+18 TO 334+87, RT
 STA. 334+63 TO 336+77, LT
 STA. 335+79 TO 335+93, RT

RELOCATE MAILBOX, SINGLE SUPPORT
 STA. 333+56, LT



~~STEEL BEAM GUARDRAIL, GALVANIZED~~
~~STA. 334+07.5 TO 334+32.5, RT~~

STEEL BEAM GUARDRAIL, GALVANIZED W/ 8 FEET POSTS
 STA. 334+32.5 TO 337+00.0, RT
 STA. 331+50 TO 337+00.0, RT
 ANCHOR FOR STEEL BEAM RAIL
 STA. 334+07.5, RT
 STA. 330+75, RT
 REMOVAL AND DISPOSAL OF GUARDRAIL
 STA. 335+49 TO 337+00 RT

DURABLE 4 INCH WHITE LINE, THERMOPLASTIC
 DURABLE 4 INCH WHITE LINE, POLYUREA
 TEMPORARY 4 INCH WHITE LINE, PAINT
 STA. 331+50 TO 337+00, SOLID LT & RT

DURABLE 4 INCH YELLOW LINE, THERMOPLASTIC
 DURABLE 4 INCH YELLOW LINE, POLYUREA
 TEMPORARY 4 INCH YELLOW LINE, PAINT
 STA. 331+50 TO 337+00, SOLID LT & RT
 STA. 334+88, LT

GEOTEXTILE FOR SILT FENCE
 STA. 333+50 TO 334+50, RT
 EROSION LOG
 STA. 336+50 TO 337+00, LT
 REMOVING SIGNS
 AS SHOWN - 1

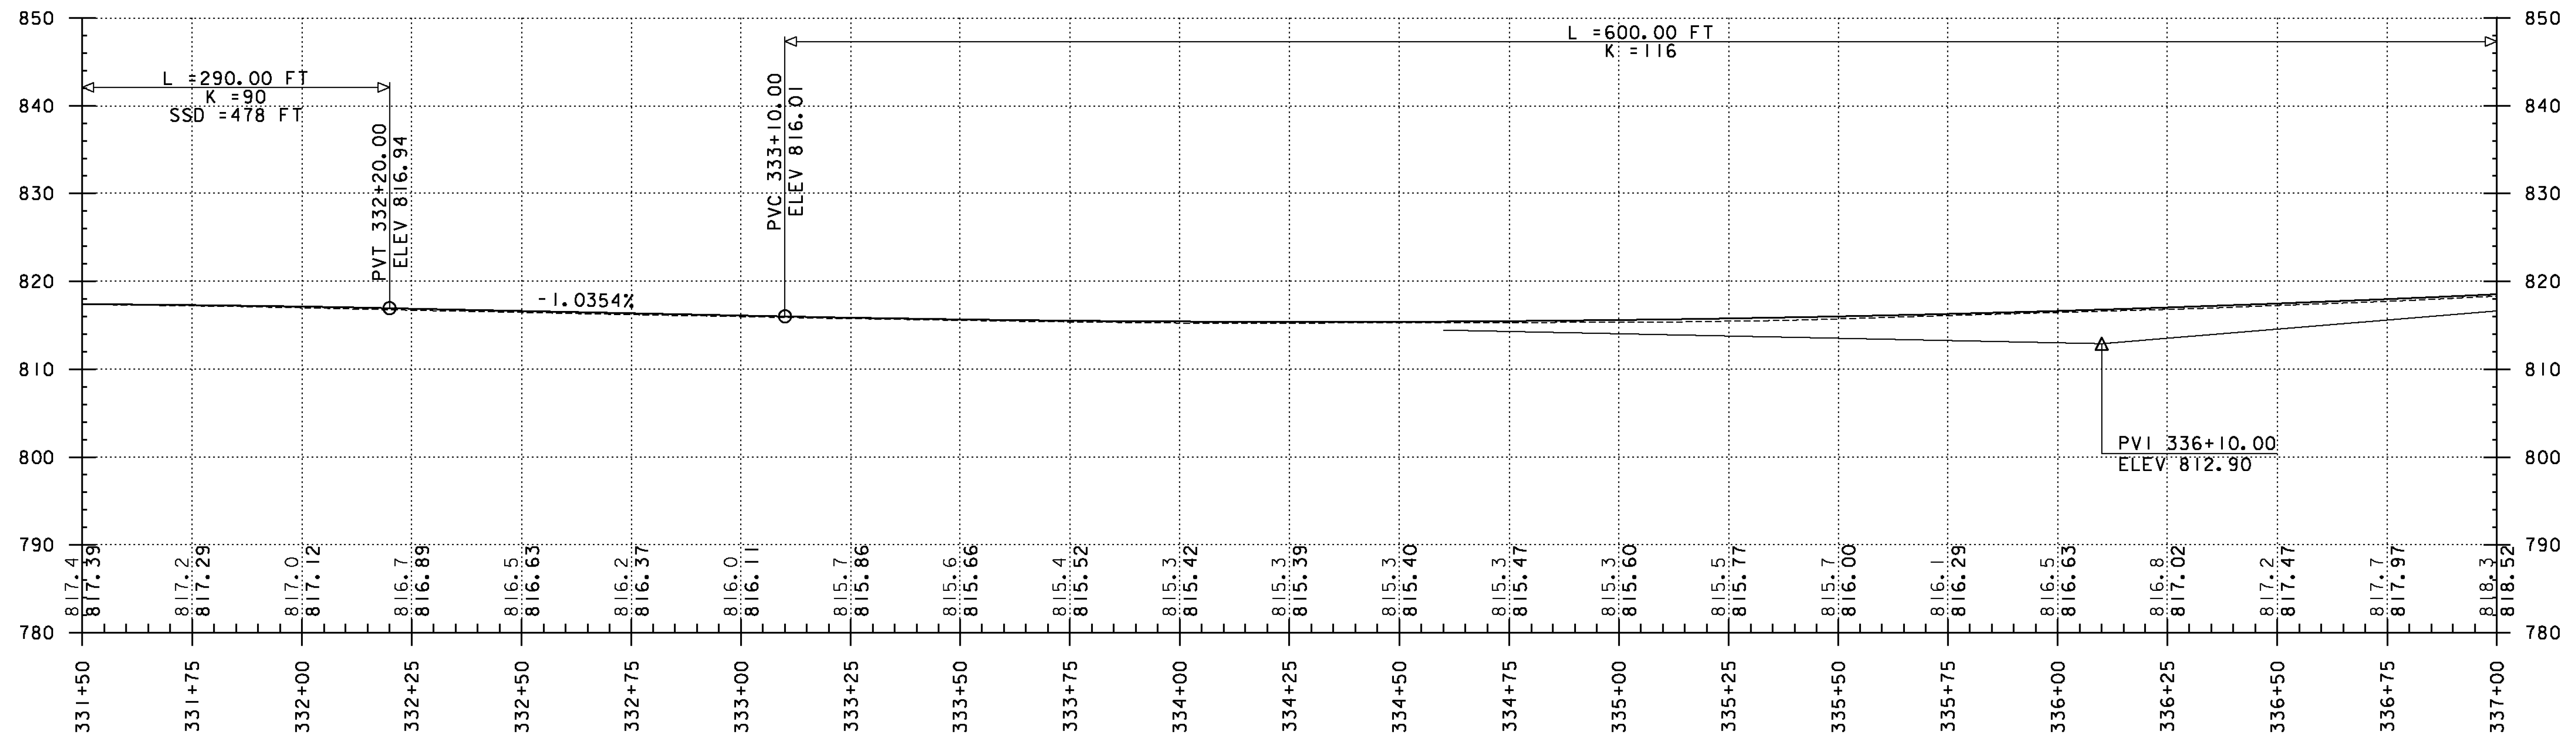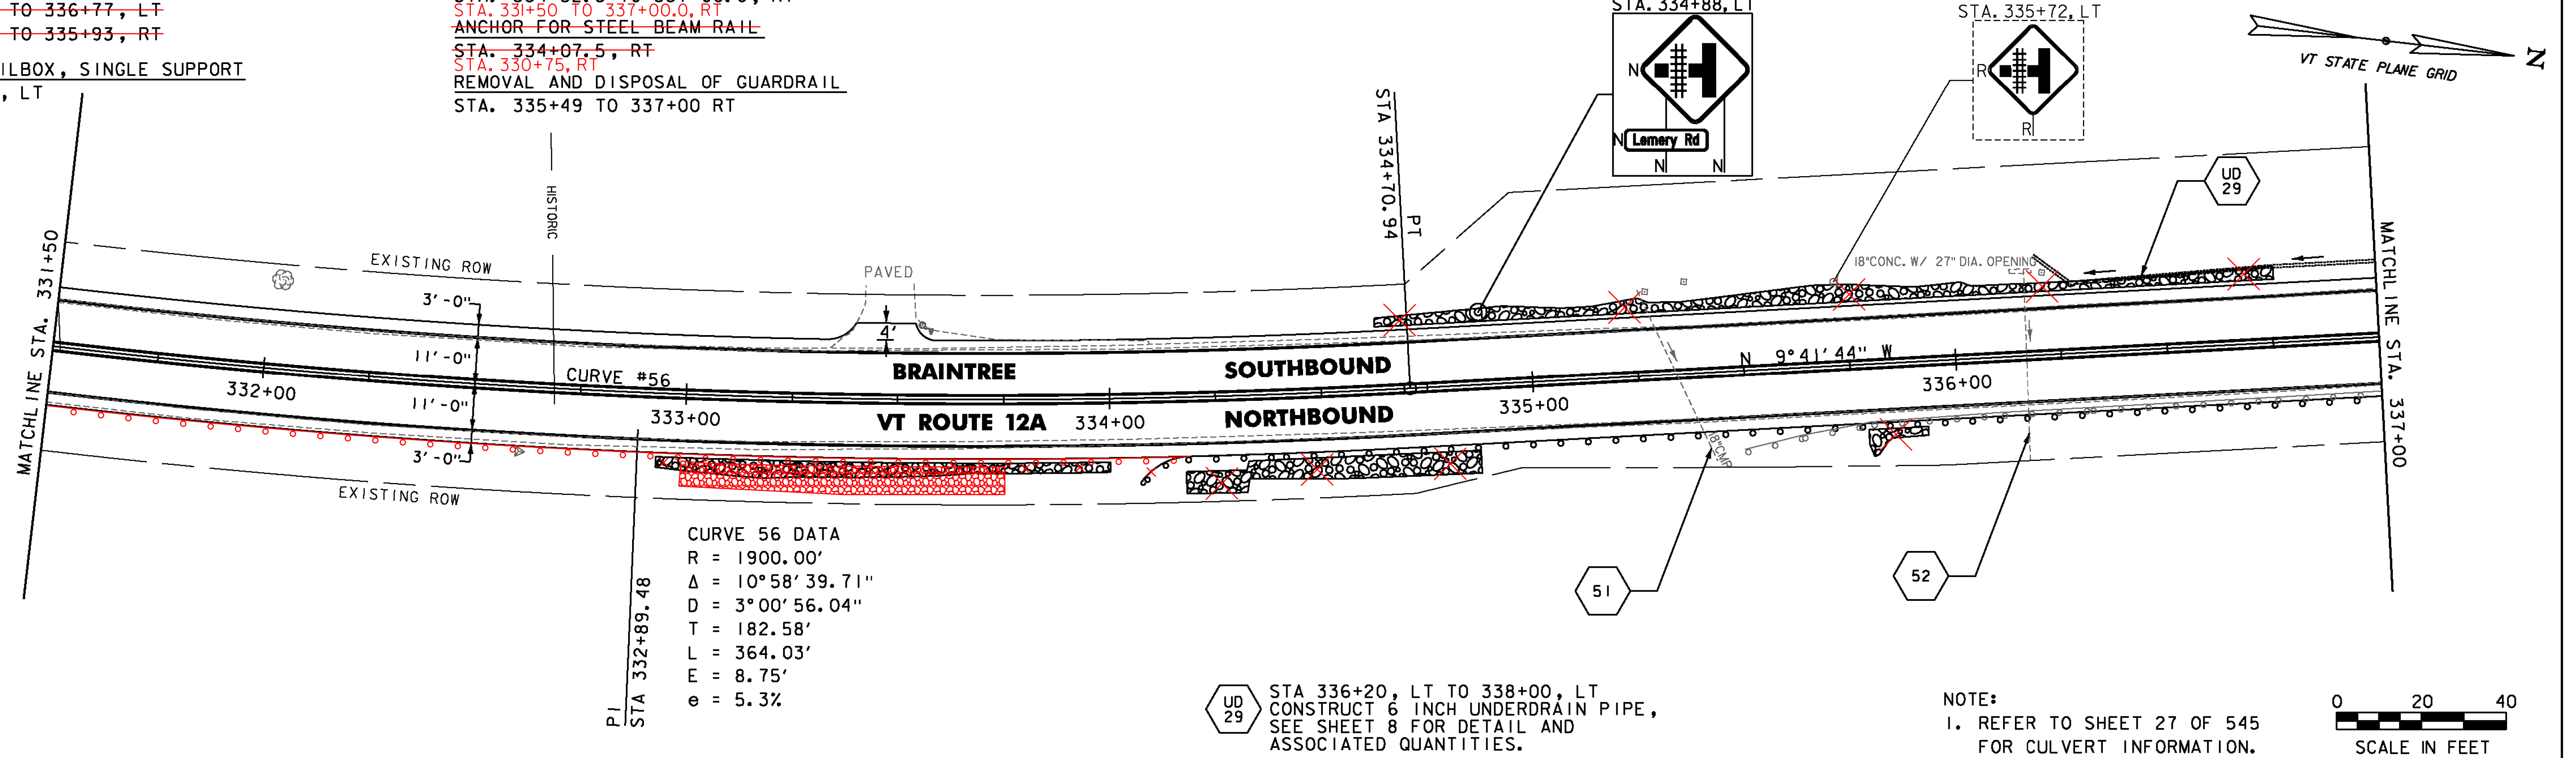

PROJECT NAME: RANDOLPH-ROXBURY
 PROJECT NUMBER: ER STP 0187(II)
 FILE NAME: z13cl82bdr.dgn
 PROJECT LEADER: M. FOISY
 DESIGNED BY: I. MAYNARD
 PLAN & PROFILE SHEET 76
 PLOT DATE: 11/17/2014
 DRAWN BY: G. BURGMEIER
 CHECKED BY: M. FOISY
 SHEET 117 OF 545

