

SOLID ROCK EXCAVATION

STA. 347+00 TO 348+20, LT STA. 347+00 TO 348+50, LT

STA. 349+05 TO 352+00, LT

UNDERDRAIN FLUSHING BASIN

STA. 347+75, LT

STA. 350+75, LT

STONE FILL TYPE I, GEOTEXTILE UNDER STONE FILL & GRUBBING MATERIAL

STA. 350+66 TO 352+00, LT

STEEL BEAM GUARDRAIL, GALVANIZED W/ 8 FEET POSTS

STA. 347+00.0 TO 352+00.0, RT

REMOVAL AND DISPOSAL OF GUARDRAIL

STA. 347+00 TO 352+00 RT

DURABLE 4 INCH WHITE LINE, THERMOPLASTIC

DURABLE 4 INCH WHITE LINE, POLYUREA

TEMPORARY 4 INCH WHITE LINE, PAINT

STA. 347+00 TO 352+00, SOLID LT & RT

DURABLE 4 INCH YELLOW LINE, THERMOPLASTIC

DURABLE 4 INCH YELLOW LINE, POLYUREA

TEMPORARY 4 INCH YELLOW LINE, PAINT

STA. 347+00 TO 352+00, SOLID LT, DASHED RT



BARRIER FENCE

STA. 348+71 TO 352+00, RT

EROSION LOG

STA. 347+00 TO 352+00, LT

STA. 349+51 TO 352+00, RT

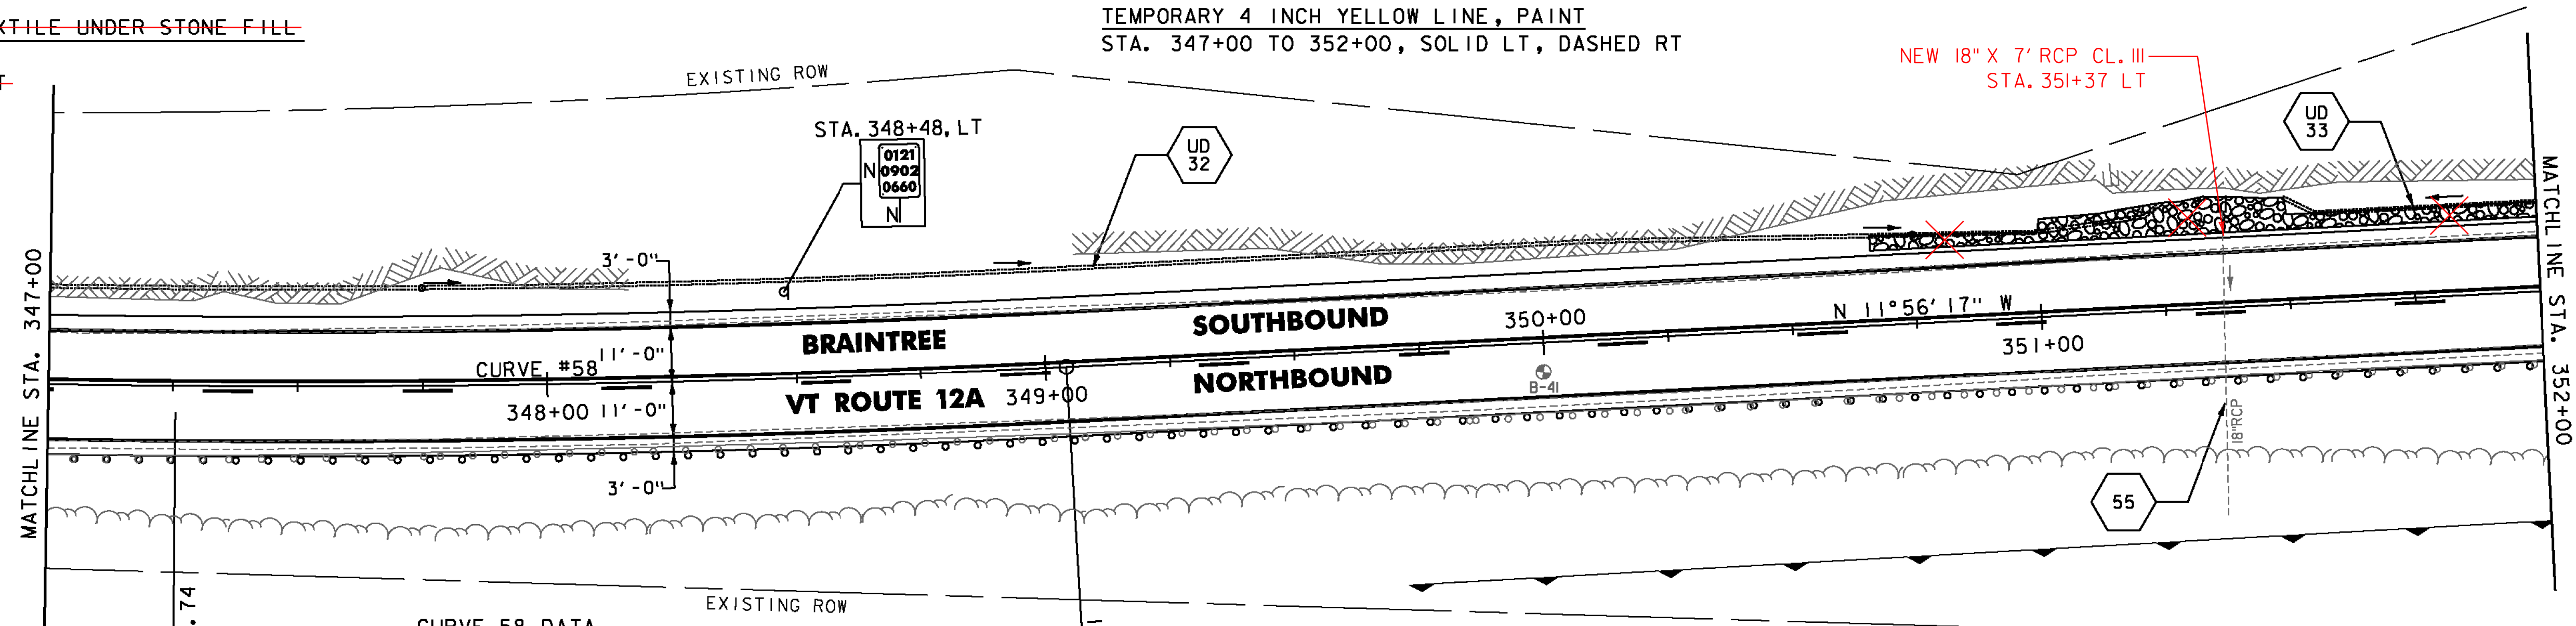
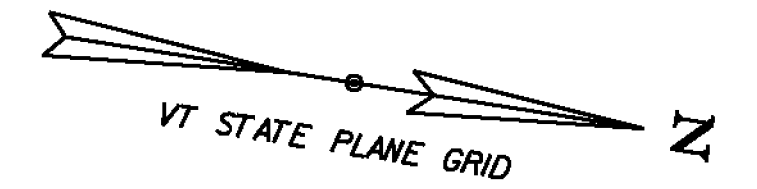


CURVE #58 DATA
 R = 3000.00'
 $\Delta = 6^\circ 49' 30.96''$
 $D = 1^\circ 54' 35.49''$
 T = 178.90'
 L = 357.37'
 E = 5.33'
 $e = 3.2\%$

SOIL BORING DATA			
BORING#	DEPTH (FT.)	PCC	COMMENTS
B-41	3.5'	NO	

UD 33 STA 351+50, LT TO 355+75, LT
 CONSTRUCT 6 INCH UNDERDRAIN PIPE, SEE SHEET 8 FOR DETAIL AND ASSOCIATED QUANTITIES.

NOTE:
 1. REFER TO SHEET 27 OF 545 FOR CULVERT INFORMATION.

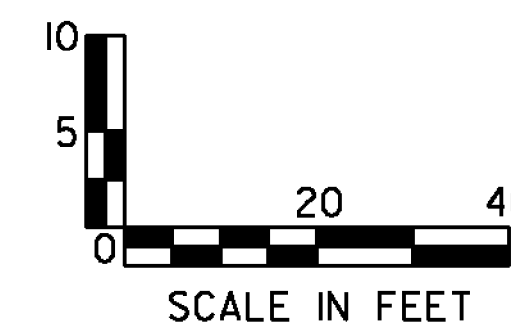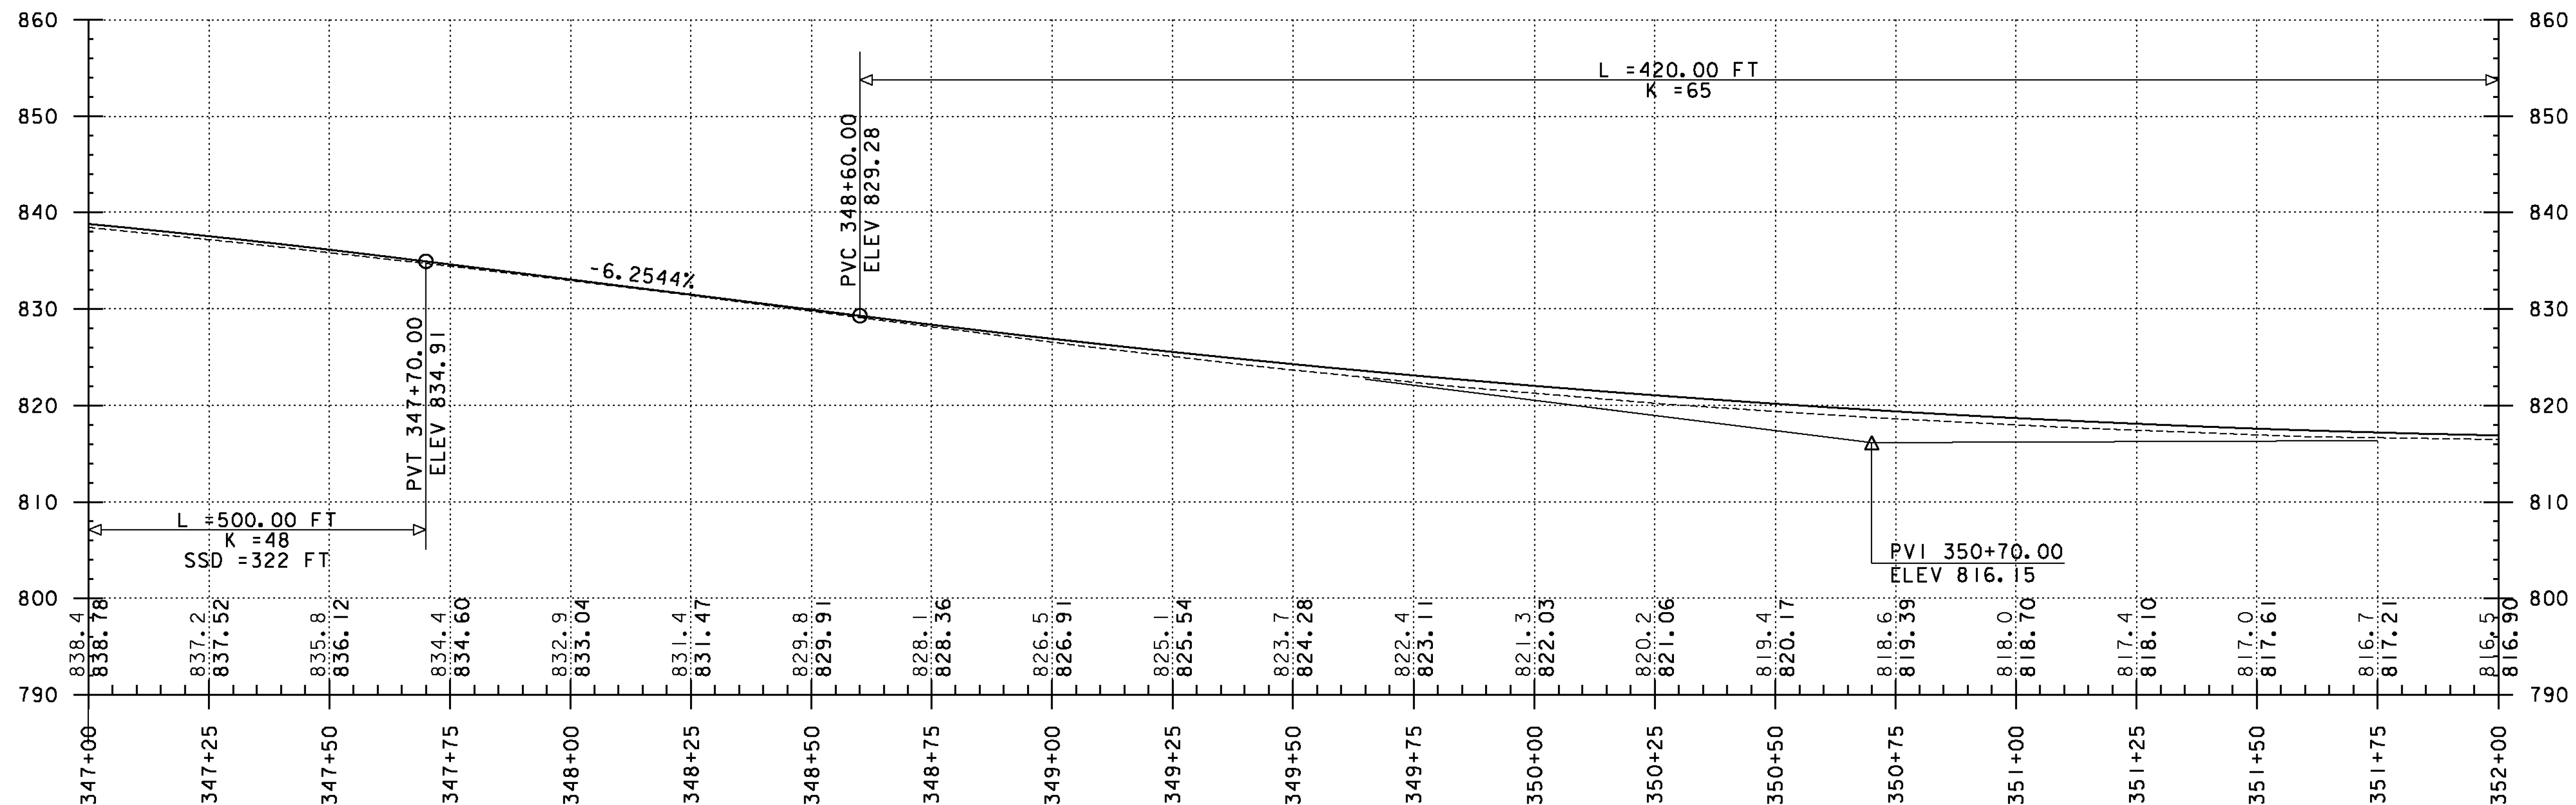

PROJECT NAME: RANDOLPH-ROXBURY
 PROJECT NUMBER: ER STP 0187(II)

FILE NAME: z13cl82bdr.dgn
 PROJECT LEADER: M. FOISY
 DESIGNED BY: I. MAYNARD

PLOT DATE: 11/17/2014
 DRAWN BY: G. BURGMEIER
 CHECKED BY: M. FOISY

PLAN & PROFILE SHEET 79

SHEET 120 OF 545

