


UNDERDRAIN FLUSHING BASIN
~~STA. 358+00, RT STA. 358+07, RT~~
~~STA. 358+25, LT STA. 358+30, LT~~
 STA. 361+00, LT

DURABLE 4 INCH WHITE LINE, THERMOPLASTIC
 DURABLE 4 INCH WHITE LINE, POLYUREA
 TEMPORARY 4 INCH WHITE LINE, PAINT
 STA. 357+00 TO 362+00, SOLID LT & RT


DURABLE 4 INCH YELLOW LINE, THERMOPLASTIC
 DURABLE 4 INCH YELLOW LINE, POLYUREA
 TEMPORARY 4 INCH YELLOW LINE, PAINT
 STA. 357+00 TO 362+00, DASHED C

GEOTEXTILE FOR SILT FENCE
 STA. 358+25 TO 358+75, LT

BARRIER FENCE
 STA. 357+00 TO 362+00, RT
 EROSION LOG
 STA. 357+00 TO 362+00, RT
 STA. 357+00 TO 362+00, LT

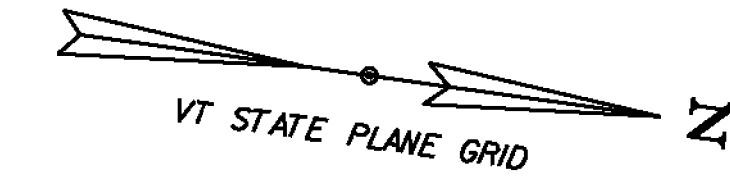

STONE FILL TYPE I, GEOTEXTILE UNDER STONE FILL
 & GRUBBING MATERIAL
~~STA. 358+50 TO 358+75, LT~~

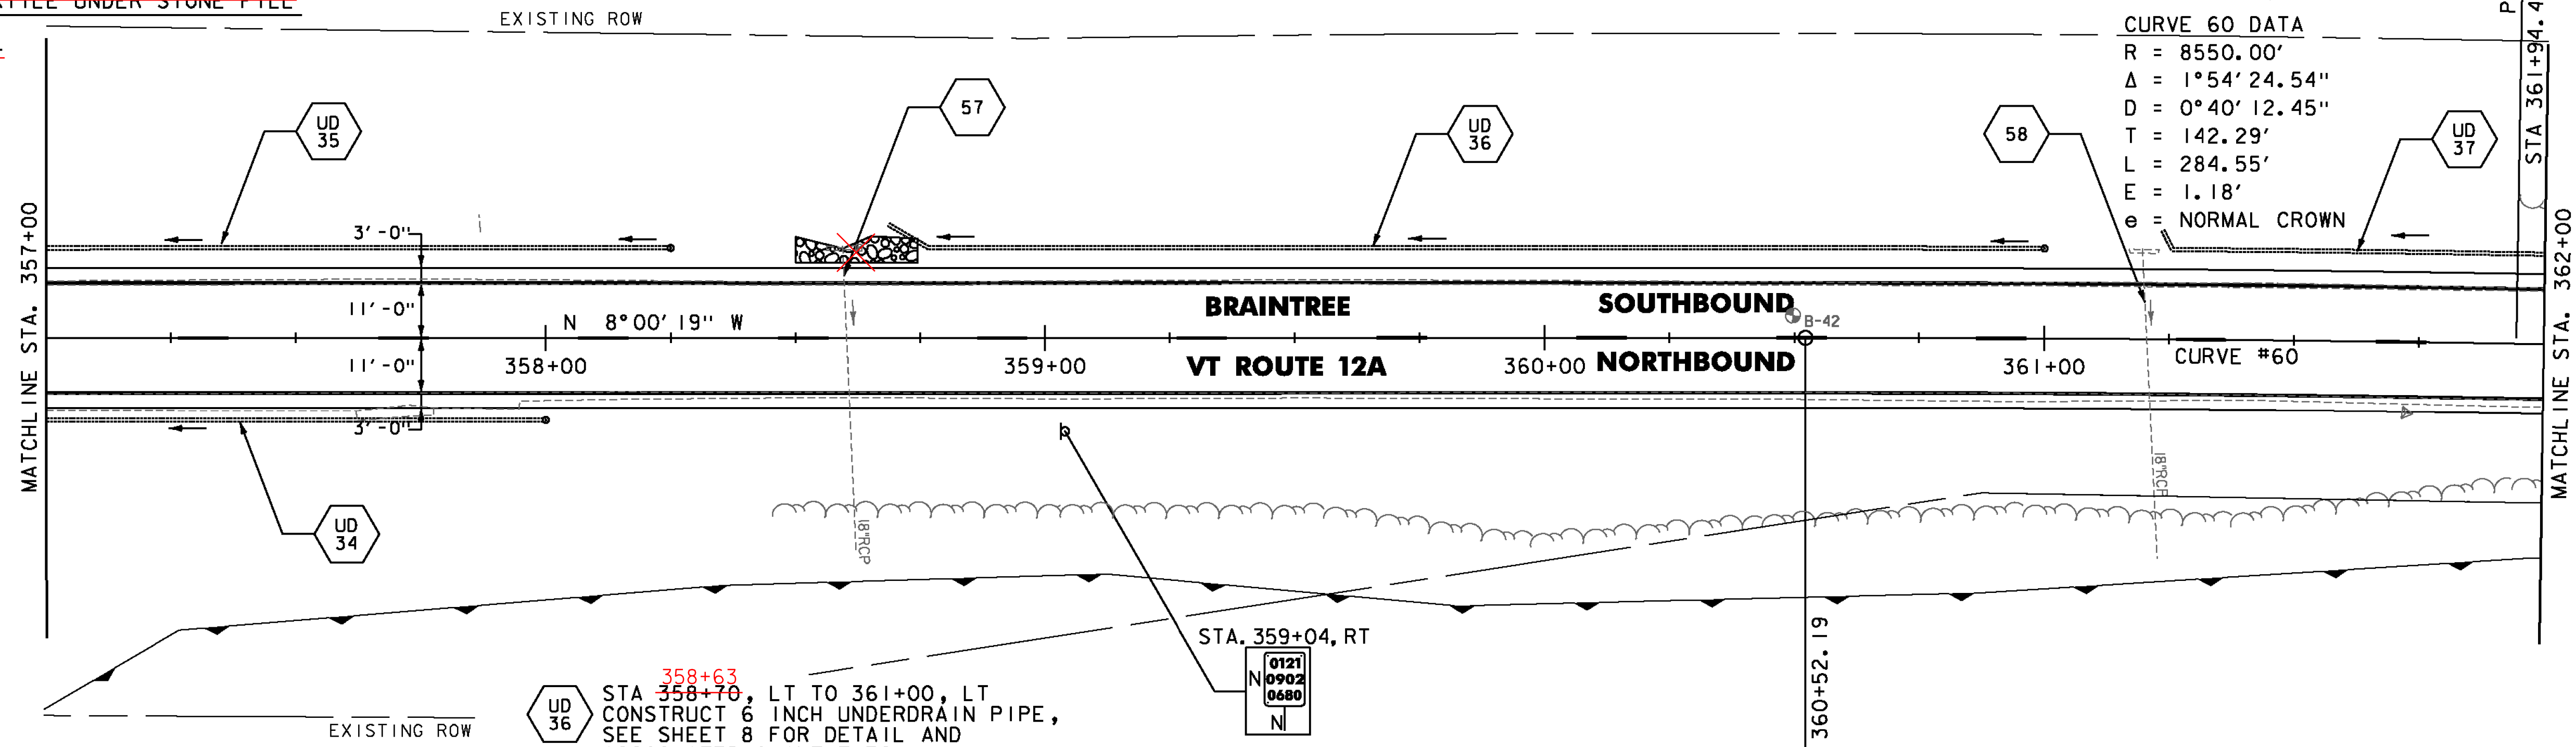




CURVE 60 DATA
 R = 8550.00'
 Δ = 1°54'24.54"
 D = 0°40'12.45"
 T = 142.29'
 L = 284.55'
 E = 1.18'
 e = NORMAL CROWN

UD 36 STA. 358+70, LT TO 361+00, LT
 CONSTRUCT 6 INCH UNDERDRAIN PIPE,
 SEE SHEET 8 FOR DETAIL AND
 ASSOCIATED QUANTITIES.

UD 37 STA. 361+25, LT TO 362+50, LT
 CONSTRUCT 6 INCH UNDERDRAIN PIPE,
 SEE SHEET 8 FOR DETAIL AND
 ASSOCIATED QUANTITIES.

SOIL BORING DATA			
BORING*	DEPTH (FT.)	PCC	COMMENTS
B-42	5.0'	NO	

NOTE:
 1. REFER TO SHEET 27 OF 545
 FOR CULVERT INFORMATION.

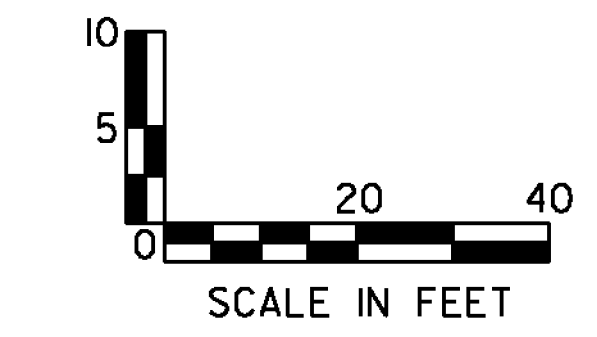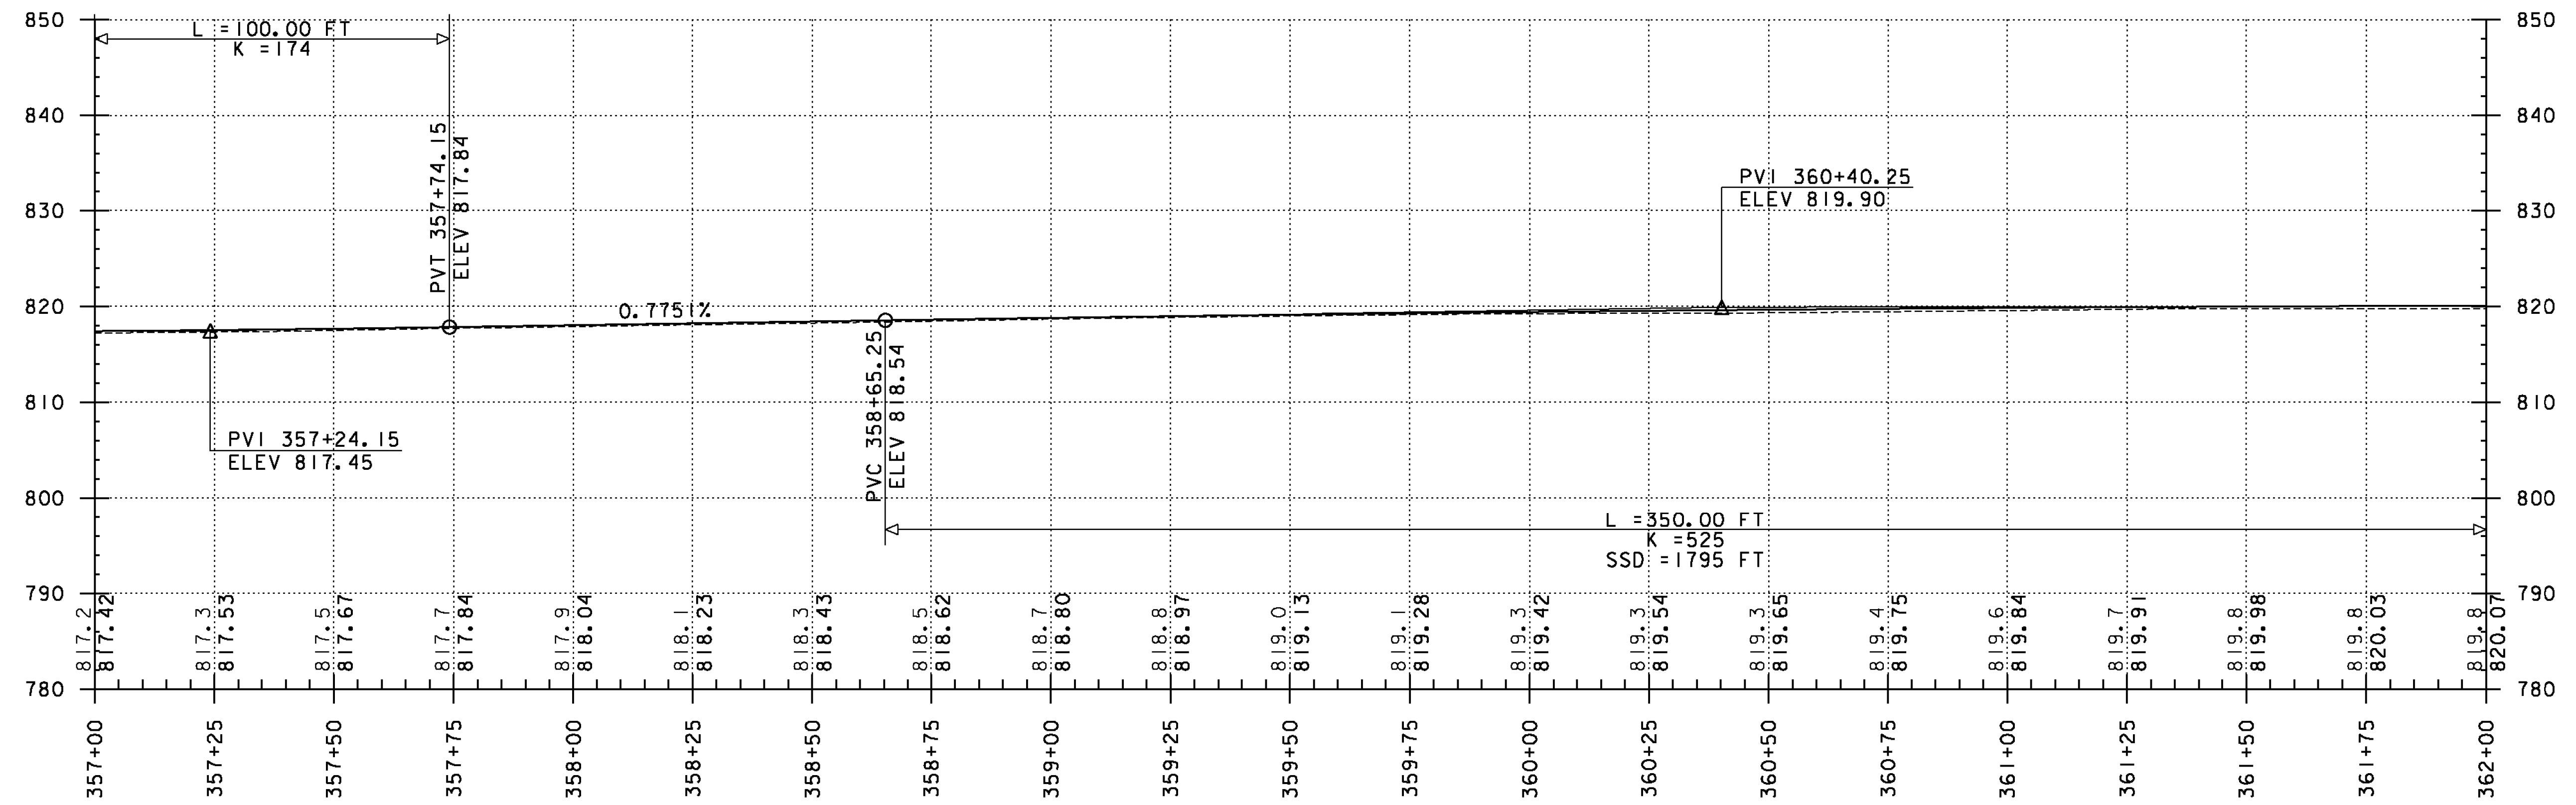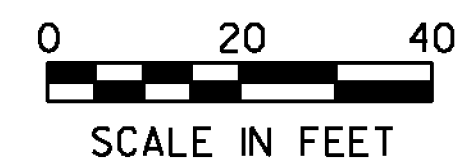

PROJECT NAME: RANDOLPH-ROXBURY
 PROJECT NUMBER: ER STP 0187(II)
 FILE NAME: z13cl82bdr.dgn
 PROJECT LEADER: M. FOISY
 DESIGNED BY: I. MAYNARD
PLAN & PROFILE SHEET 81

PLOT DATE: 11/17/2014
 DRAWN BY: G. BURGMEIER
 CHECKED BY: M. FOISY
 SHEET 122 OF 545

