

SOLID ROCK EXCAVATION  
 STA. 365+50 TO 366+45, LT  
 UNDERDRAIN FLUSHING BASIN  
 STA. 362+50, LT  
 STA. 365+75, LT  
 STA. 366+95, LT  
 STA. 365+80, LT


STONE FILL TYPE I, GEOTEXTILE UNDER STONE FILL  
 & GRUBBING MATERIAL  
 STA. 362+61 TO 363+50, LT  
 STA. 362+50 TO 363+50, LT

DURABLE 4 INCH WHITE LINE, THERMOPLASTIC  
 DURABLE 4 INCH WHITE LINE, POLYUREA  
 TEMPORARY 4 INCH WHITE LINE, PAINT  
 STA. 362+00 TO 367+00, SOLID LT & RT

DURABLE 4 INCH YELLOW LINE, THERMOPLASTIC  
 DURABLE 4 INCH YELLOW LINE, POLYUREA  
 TEMPORARY 4 INCH YELLOW LINE, PAINT  
 STA. 362+00 TO 367+00, DASHED CL

GEOTEXTILE FOR SILT FENCE  
 STA. 363+00 TO 363+50, LT




BARRIER FENCE  
 STA. 362+00 TO 367+00, RT  
 EROSION LOG  
 STA. 362+00 TO 367+00, RT  
 STA. 362+00 TO 367+00, LT

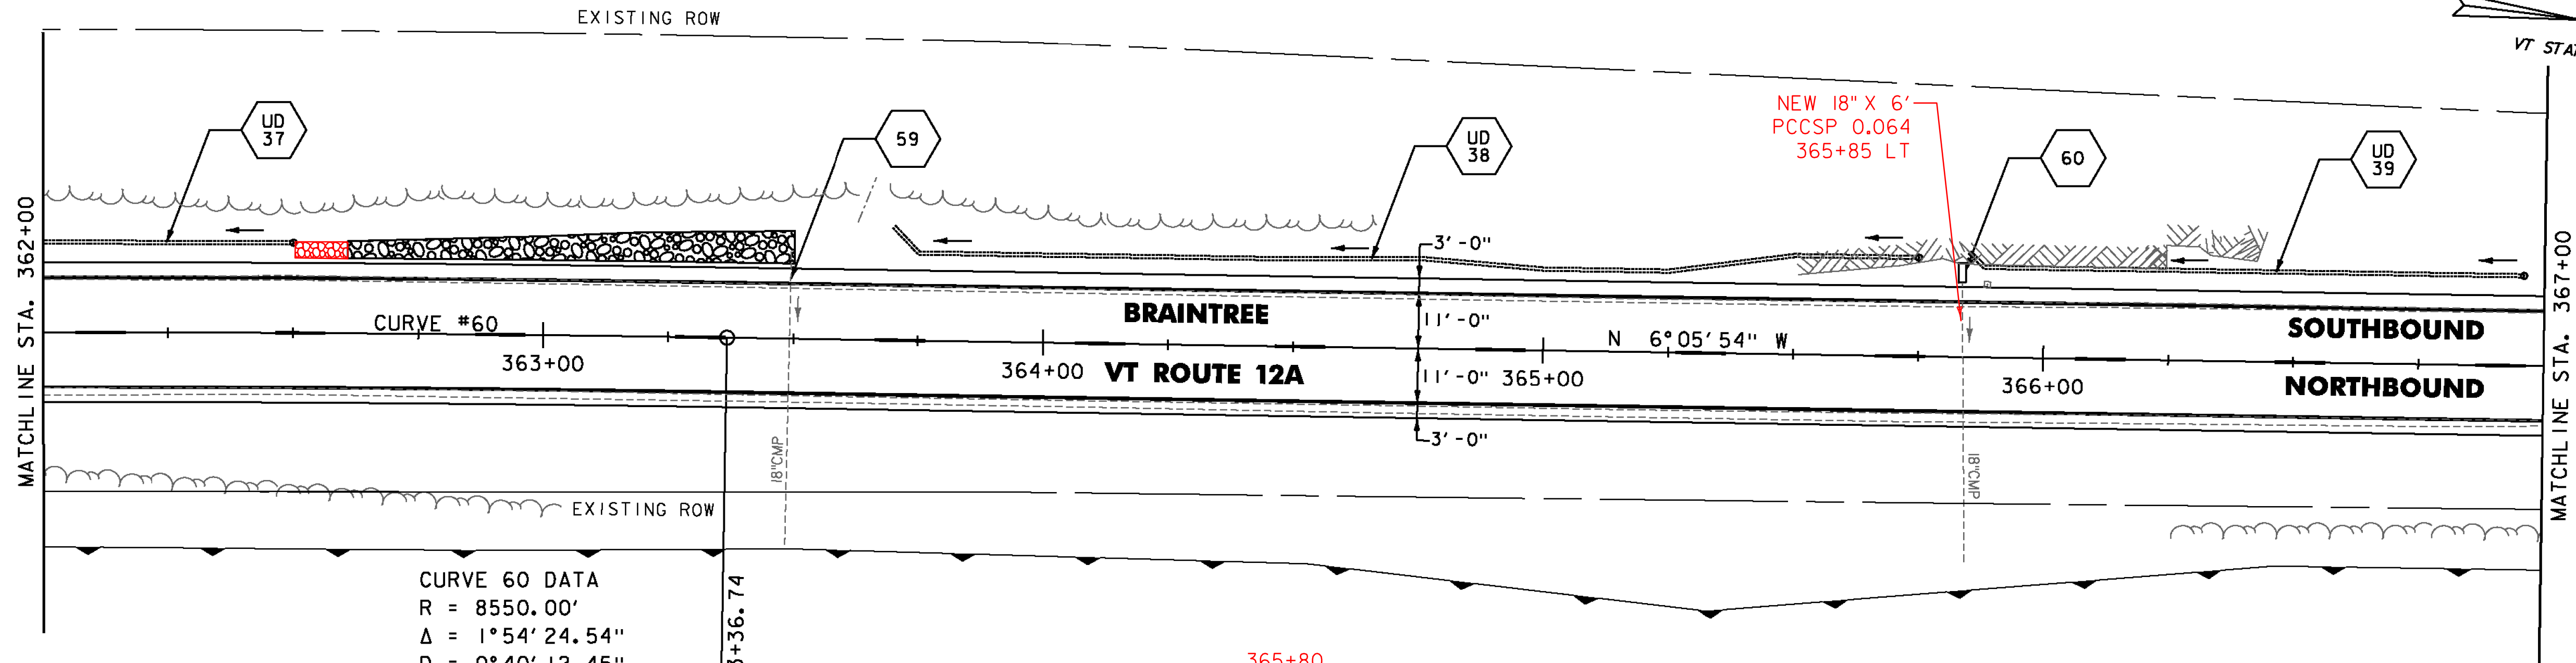

CURVE 60 DATA  
 R = 8550.00'  
 $\Delta = 1^\circ 54' 24.54''$   
 $D = 0^\circ 40' 12.45''$   
 T = 142.29'  
 L = 284.55'  
 E = 1.18'  
 e = N.C.

- STA 363+70, LT TO 365+75, LT  
 CONSTRUCT 6 INCH UNDERDRAIN PIPE,  
 SEE SHEETS 8 & 9 FOR DETAIL AND  
 ASSOCIATED QUANTITIES.
- STA 365+85, LT TO 366+95, LT  
 CONSTRUCT 6 INCH UNDERDRAIN PIPE,  
 SEE SHEETS 8 & 9 FOR DETAIL AND  
 ASSOCIATED QUANTITIES.

NOTE:  
 1. REFER TO SHEET 27 OF 545  
 FOR CULVERT INFORMATION.

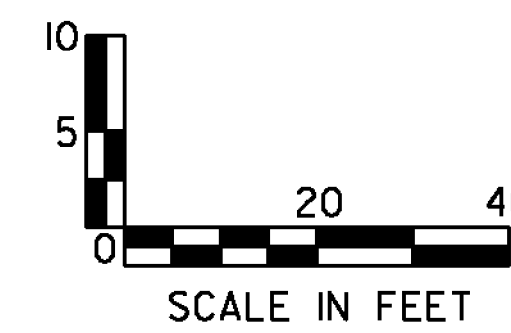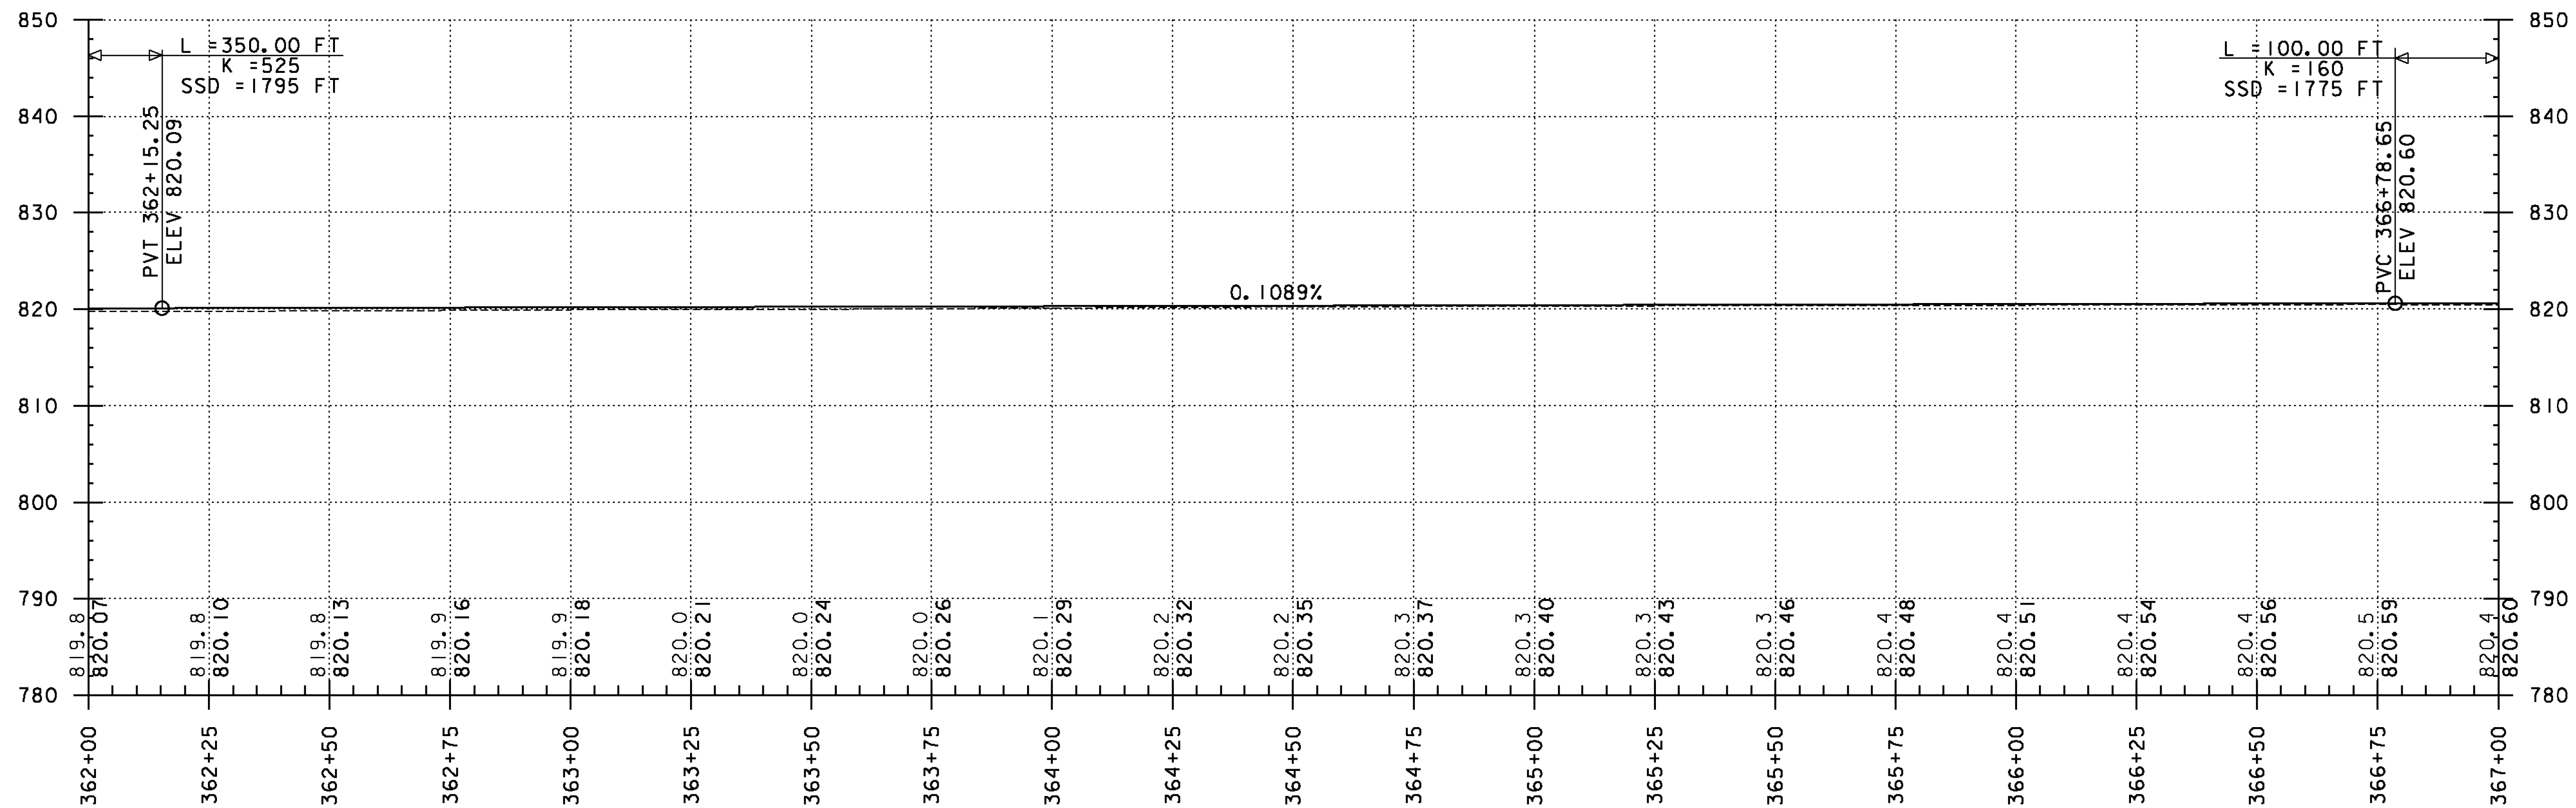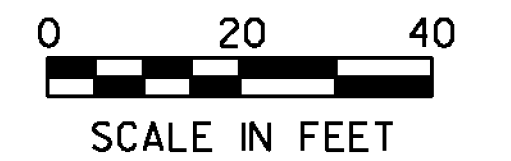

PROJECT NAME: RANDOLPH-ROXBURY  
 PROJECT NUMBER: ER STP 0187(II)

FILE NAME: z13cl82bdr.dgn  
 PROJECT LEADER: M. FOISY  
 DESIGNED BY: I. MAYNARD  
 PLAN & PROFILE SHEET 82

PLOT DATE: 11/17/2014  
 DRAWN BY: G. BURGMEIER  
 CHECKED BY: M. FOISY  
 SHEET 123 OF 545