

UNDERDRAIN FLUSHING BASIN
STA. 367+04, LT

~~STONE FILL TYPE I, GEOTEXTILE UNDER STONE FILL
& GRUBBING MATERIAL~~
STA. 368+70 TO 368+81, LT



DURABLE 4 INCH WHITE LINE, THERMOPLASTIC
DURABLE 4 INCH WHITE LINE, POLYUREA
TEMPORARY 4 INCH WHITE LINE, PAINT
STA. 367+00 TO 372+50, SOLID LT & RT

DURABLE 4 INCH YELLOW LINE, THERMOPLASTIC
DURABLE 4 INCH YELLOW LINE, POLYUREA
TEMPORARY 4 INCH YELLOW LINE, PAINT
STA. 367+00 TO 371+43, DASHED Q
STA. 371+43 TO 372+50, DASHED LT, SOLID RT

GEOTEXTILE FOR SILT FENCE
STA. 370+00 TO 371+50, LT

BARRIER FENCE
STA. 367+00 TO 372+50, RT




EROSION LOG
STA. 367+00 TO 372+50, RT
STA. 367+00 TO 371+50, LT

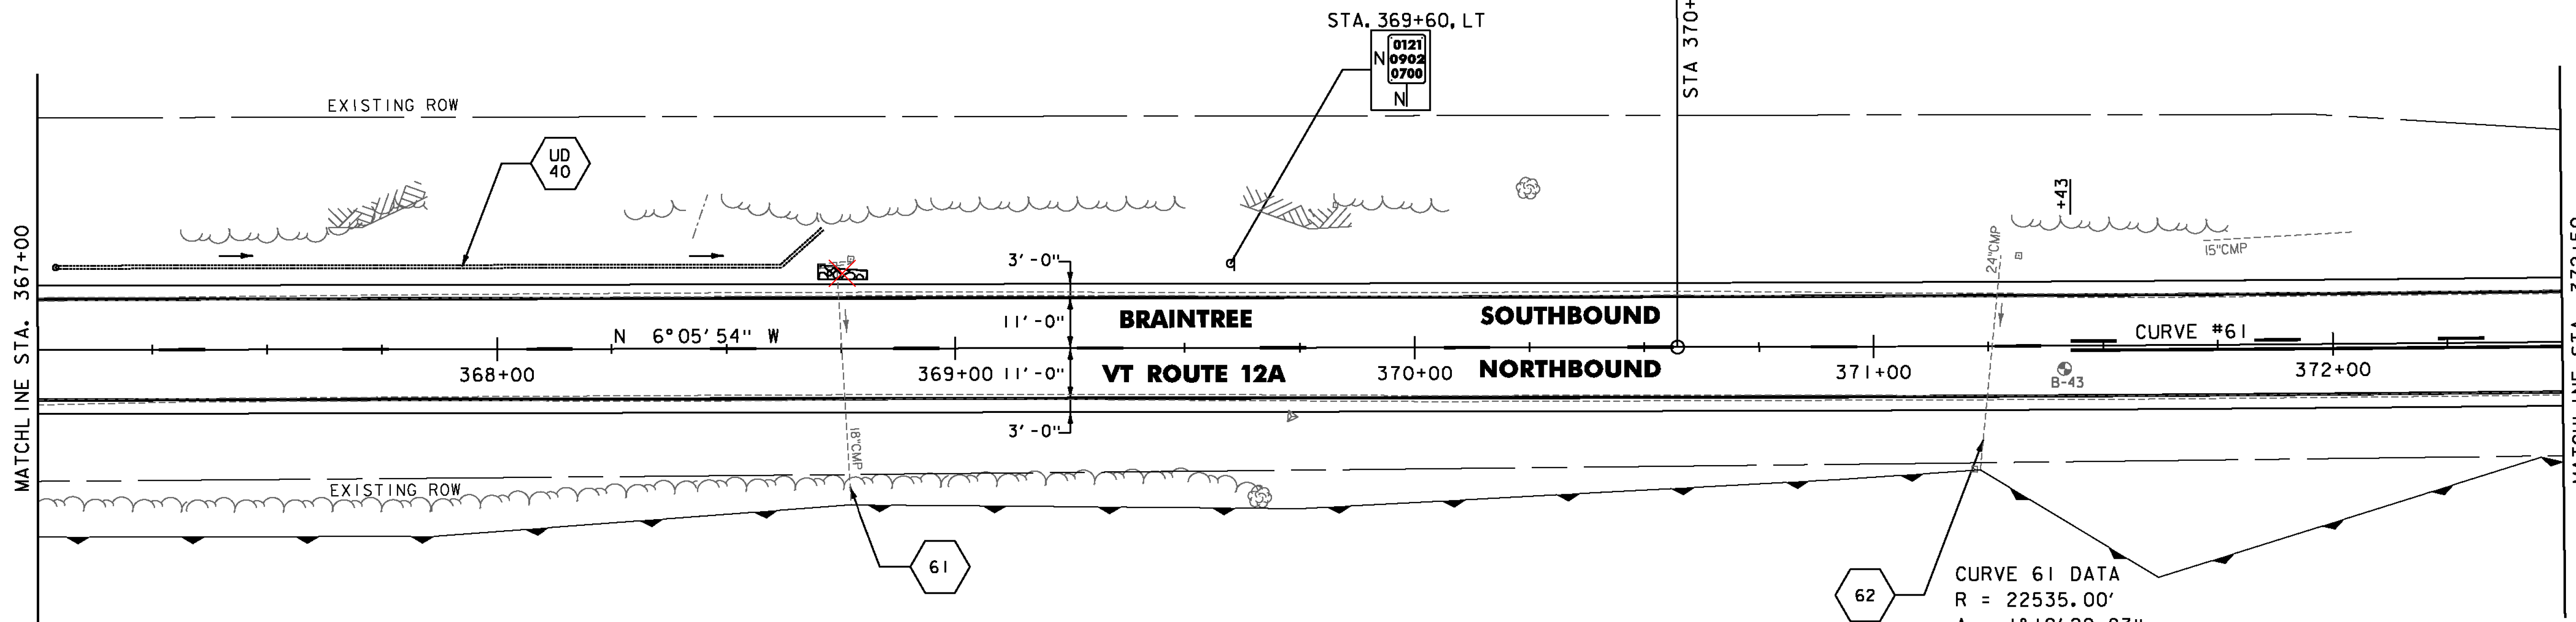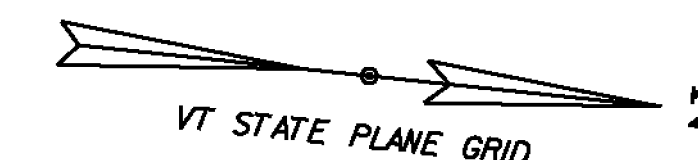

UD 40 STA 367+04, LT TO 368+70, LT
CONSTRUCT 6 INCH UNDERDRAIN PIPE,
SEE SHEETS 8 & 9 FOR DETAIL AND
ASSOCIATED QUANTITIES.

SOIL BORING DATA			
BORING#	DEPTH (FT.)	PCC	COMMENTS
B-43	5.0'	NO	

CURVE 61 DATA
R = 22535.00'
Δ = 1°19'29.93"
D = 0°15'15.31"
T = 260.58'
L = 521.13'
E = 1.51' NOTE:
e = 2.0% 1. REFER TO SHEET 27 OF 545
FOR CULVERT INFORMATION.

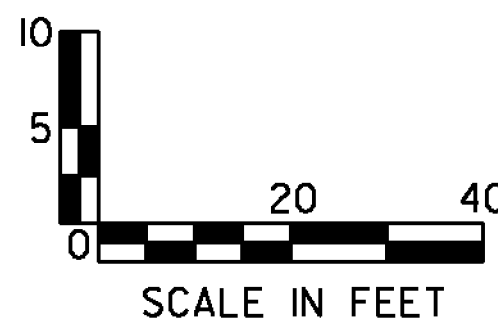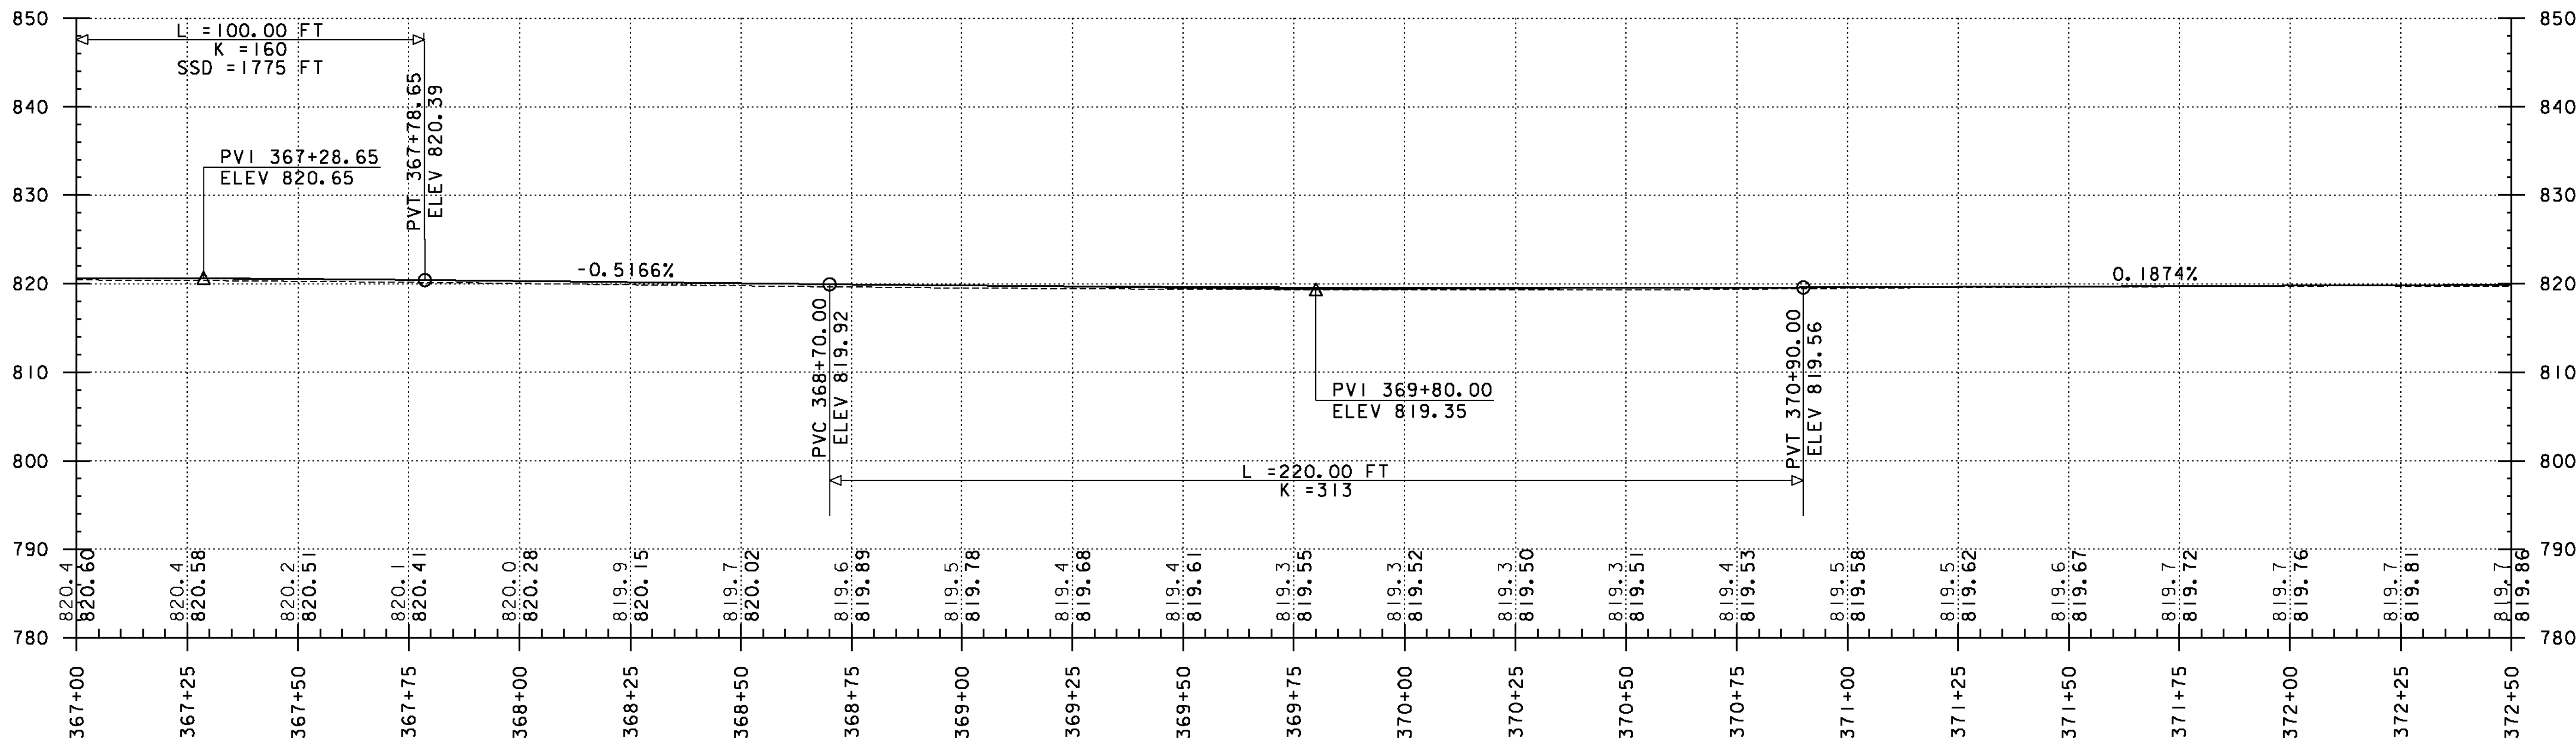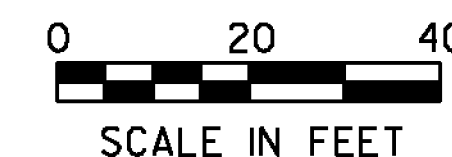

PROJECT NAME: RANDOLPH-ROXBURY
PROJECT NUMBER: ER STP 0187(II)
FILE NAME: z13cl82bdr.dgn PLOT DATE: 11/17/2014
PROJECT LEADER: M. FOISY DRAWN BY: G. BURGMEIER
DESIGNED BY: I. MAYNARD CHECKED BY: M. FOISY
PLAN & PROFILE SHEET 83 SHEET 124 OF 545

