





DURABLE 4 INCH WHITE LINE, THERMOPLASTIC  
 DURABLE 4 INCH WHITE LINE, POLYUREA  
 TEMPORARY 4 INCH WHITE LINE, PAINT  
 STA. 372+50 TO 378+00, SOLID LT & RT

DURABLE 4 INCH YELLOW LINE, THERMOPLASTIC  
 DURABLE 4 INCH YELLOW LINE, POLYUREA  
 TEMPORARY 4 INCH YELLOW LINE, PAINT  
 STA. 372+50 TO 378+00, DASHED LT, SOLID RT

GEOTEXTILE FOR SILT FENCE  
 STA. 372+50 TO 376+00, LT  
 STA. 377+00 TO 378+00, LT

BARRIER FENCE  
 STA. 372+50 TO 378+00, RT

EROSION LOG  
 STA. 372+50 TO 373+12, RT  
 STA. 372+50 TO 376+00, LT  
 STA. 373+53 TO 378+00, RT  
 STA. 377+00 TO 378+00, LT

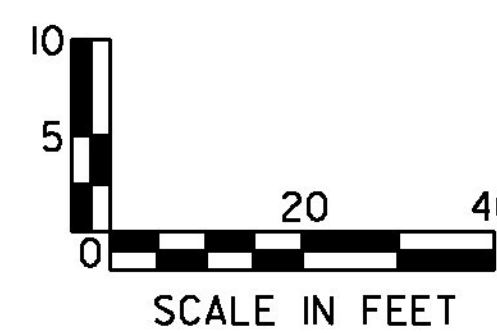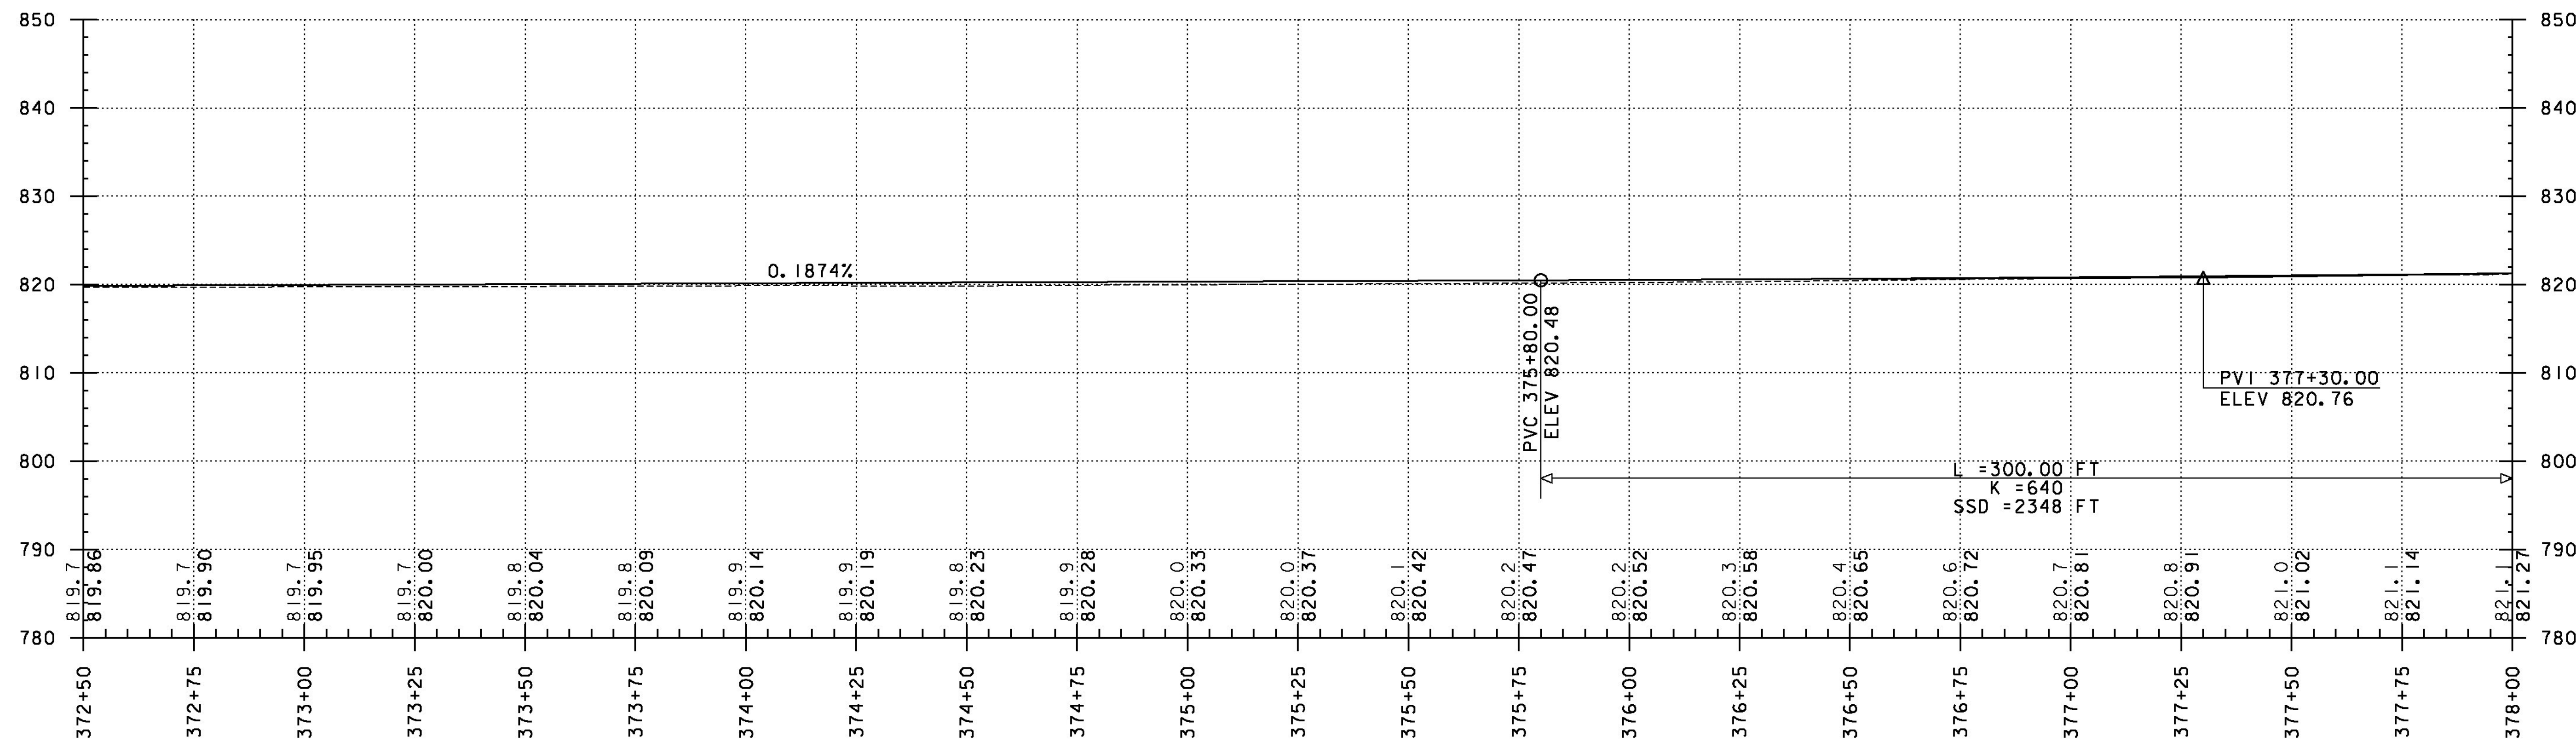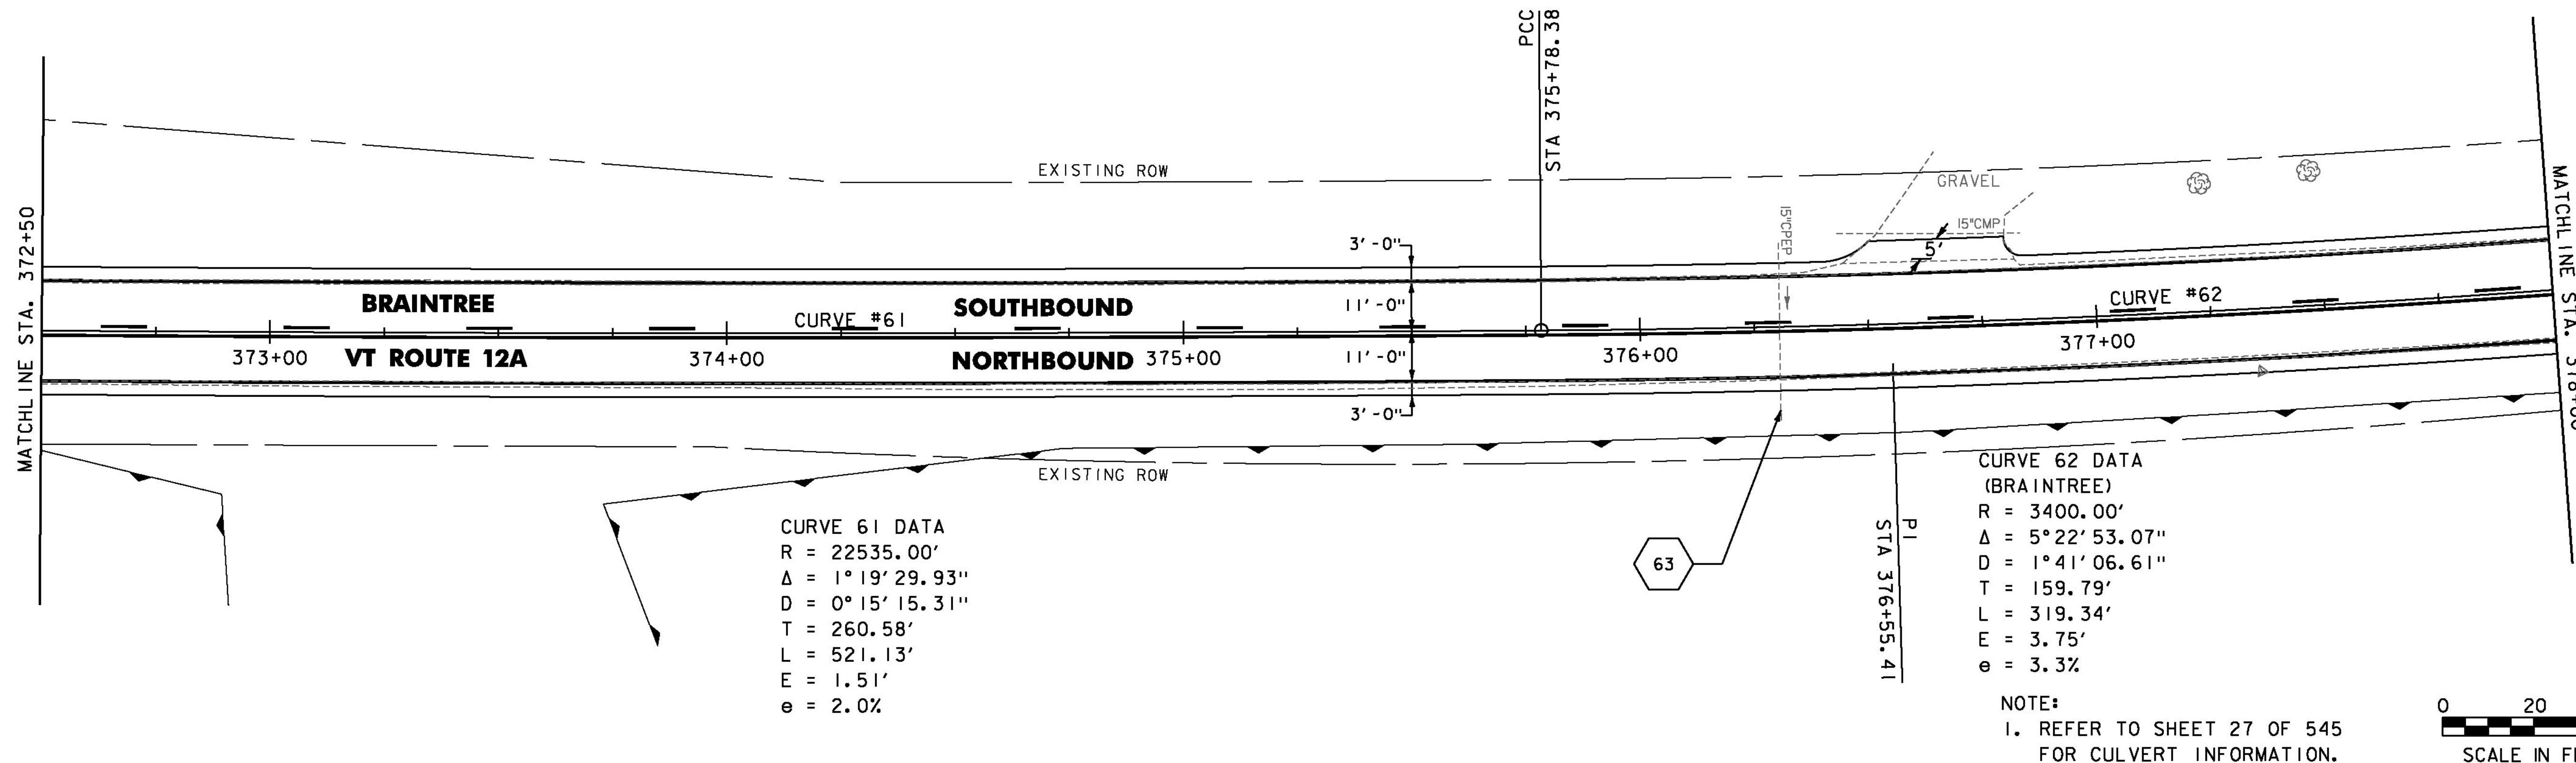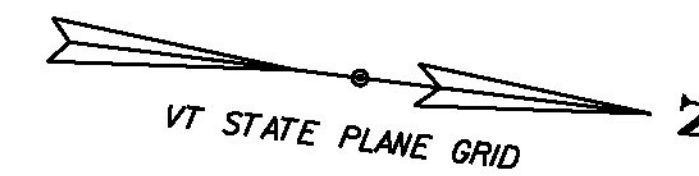

PROJECT NAME: RANDOLPH-ROXBURY  
 PROJECT NUMBER: ER STP 0187(II)  
 FILE NAME: z13ci82bdr.dgn  
 PROJECT LEADER: M. FOISY  
 DESIGNED BY: I. MAYNARD  
 PLOT DATE: 11/17/2014  
 DRAWN BY: G. BURGMEIER  
 CHECKED BY: M. FOISY  
**PLAN & PROFILE SHEET 84**  
 SHEET 125 OF 545