

~~SOLID ROCK EXCAVATION~~
 STA. 7+50 TO 8+20, LT
 STA. 10+00 TO 10+50, LT
 UNDERDRAIN FLUSHING BASIN
 STA. 9+00, LT
 STA. 9+45, LT STA. 9+85, LT
 STONE FILL TYPE 1, GEOTEXTILE UNDER
 STONE FILL & GRUBBING MATERIAL
 STA. 5+26 TO 6+74, LT


RELOCATE MAILBOX, SINGLE SUPPORT
 STA. 8+94, RT
 RELOCATE MAILBOX, MULTIPLE SUPPORT
 STA. 9+02, RT
 DURABLE 4 INCH WHITE LINE, THERMOPLASTIC
 DURABLE 4 INCH WHITE LINE, POLYUREA
 TEMPORARY 4 INCH WHITE LINE, PAINT
 STA. 5+00 TO 10+50, SOLID LT & RT

DURABLE 4 INCH YELLOW LINE, THERMOPLASTIC
 DURABLE 4 INCH YELLOW LINE, POLYUREA
 TEMPORARY 4 INCH YELLOW LINE, PAINT
 STA. 5+00 TO 10+50, SOLID LT & RT

DURABLE 24 INCH STOP BAR, THERMOPLASTIC
 DURABLE 24 INCH STOP BAR, POLYUREA
 TEMPORARY 24 INCH STOP BAR, PAINT
 STA. 9+13, RT (HANDLY RD) (25 LF)
 CURVE 64 DATA
 R = 1070.00'
 $\Delta = 22^\circ 18' 42.00''$
 $D = 5^\circ 21' 17.08''$
 T = 211.01'
 L = 416.67'
 E = 20.61'
 $e = 3.3\%$

DURABLE LETTER OR SYMBOL, THERMOPLASTIC
 DURABLE LETTER OR SYMBOL, POLYUREA
 STA. 9+13, RT (HANDLY RD) - "STOP"
 GEOTEXTILE FOR SILT FENCE
 STA. 5+00 TO 6+50, LT

BARRIER FENCE
 STA. 5+00 TO 8+07, RT
 EROSION LOG
 STA. 6+03 TO 7+27, RT

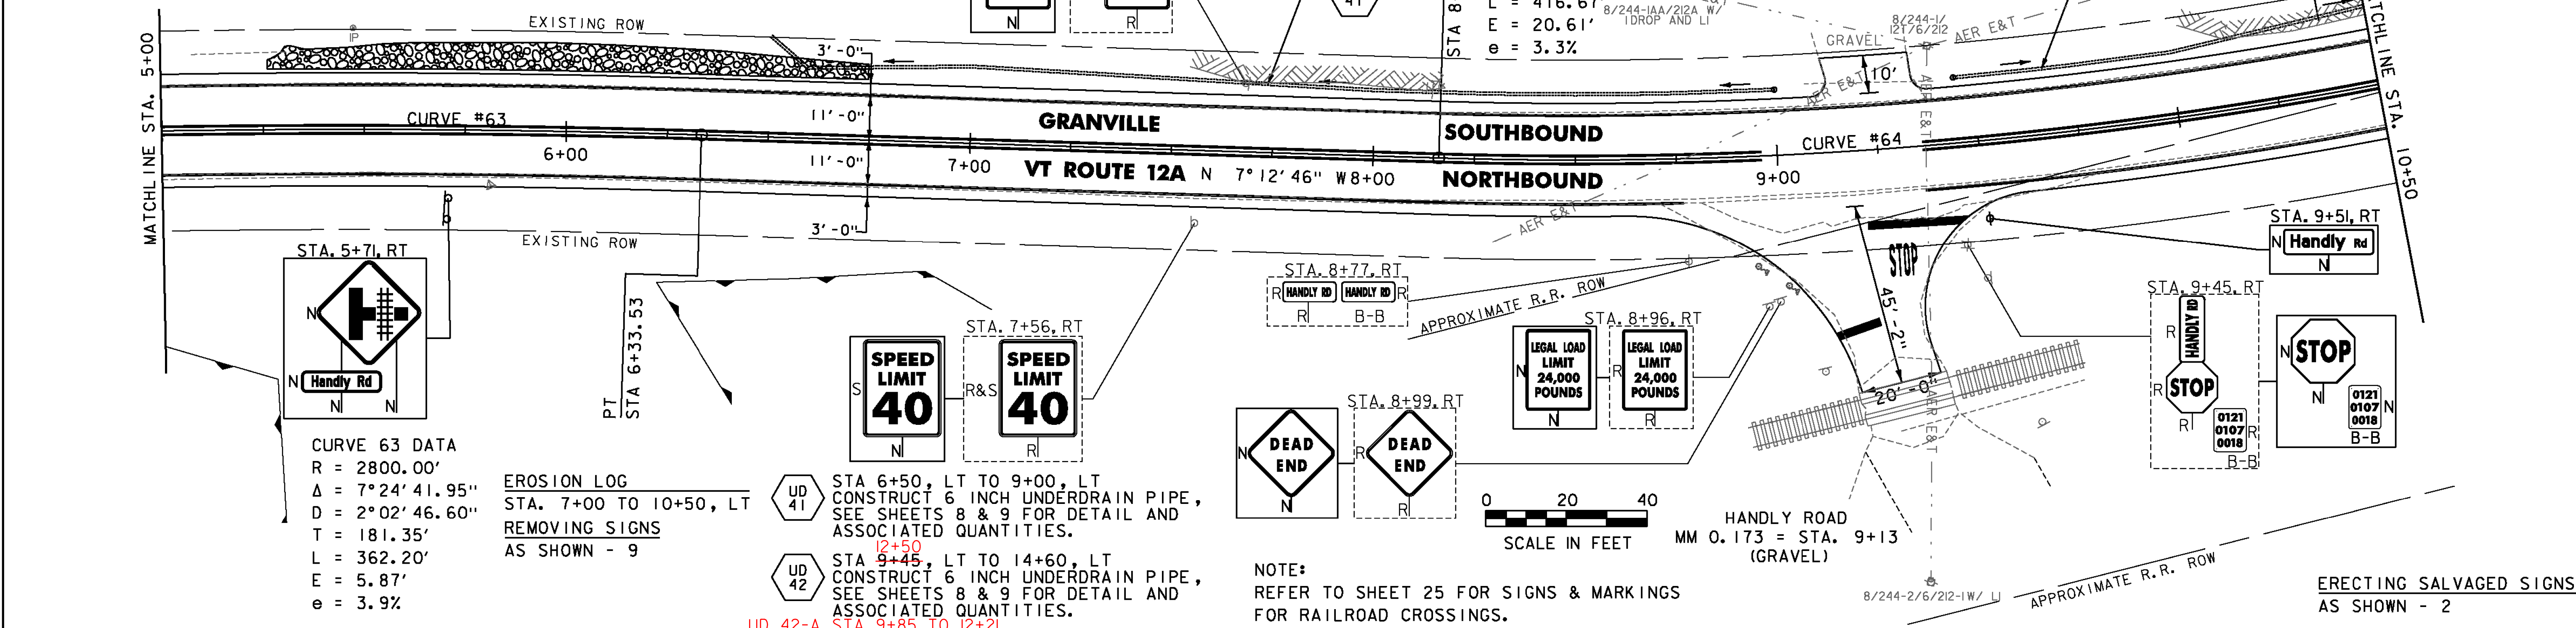

CURVE 63 DATA
 R = 2800.00'
 $\Delta = 7^\circ 24' 41.95''$
 $D = 2^\circ 02' 46.60''$
 T = 181.35'
 L = 362.20'
 E = 5.87'
 $e = 3.9\%$


EROSION LOG
 STA. 7+00 TO 10+50, LT
 REMOVING SIGNS
 AS SHOWN - 9

UD 41 STA 6+50, LT TO 9+00, LT
 CONSTRUCT 6 INCH UNDERDRAIN PIPE,
 SEE SHEETS 8 & 9 FOR DETAIL AND
 ASSOCIATED QUANTITIES.

UD 42 STA 9+45, LT TO 14+60, LT
 CONSTRUCT 6 INCH UNDERDRAIN PIPE,
 SEE SHEETS 8 & 9 FOR DETAIL AND
 ASSOCIATED QUANTITIES.

NOTE:
 REFER TO SHEET 25 FOR SIGNS & MARKINGS
 FOR RAILROAD CROSSINGS.

ERECTING SALVAGED SIGNS
 AS SHOWN - 2

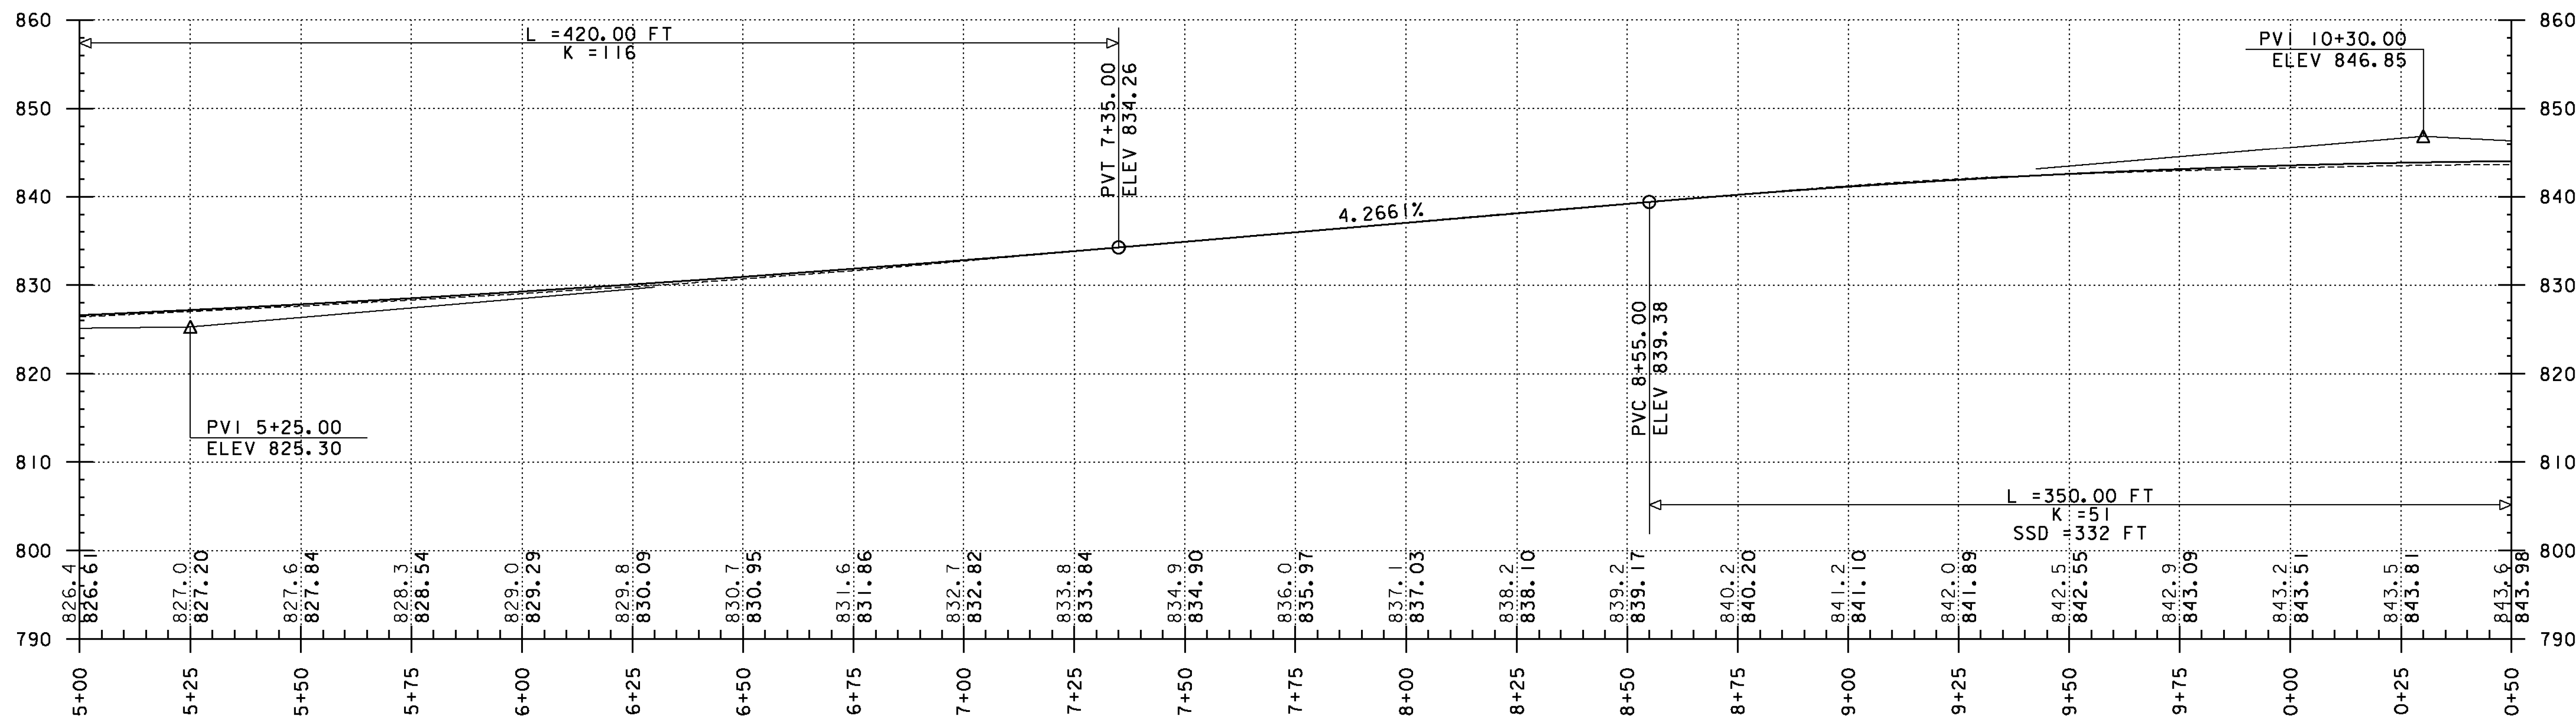

PROJECT NAME: RANDOLPH-ROXBURY
 PROJECT NUMBER: ER STP 0187(III)
 FILE NAME: z13cl82bdr.dgn
 PROJECT LEADER: M. FOISY
 DESIGNED BY: I. MAYNARD
 PLAN & PROFILE SHEET 86
 PLOT DATE: 11/17/2014
 DRAWN BY: G. BURGMEIER
 CHECKED BY: M. FOISY
 SHEET 127 OF 545

