


SOLID ROCK EXCAVATION  
~~STA. 39+15 TO 40+00, LT~~  
~~STA. 39+45 TO 40+00, LT~~  
 UNDERDRAIN FLUSHING BASIN  
 STA. 35+75, LT  
 STA. 38+25, LT  
 STA. 35+54, LT  
 STONE FILL TYPE 1, GEOTEXTILE UNDER STONE FILL  
 & GRUBBING MATERIAL  
 STA. 35+00 TO 35+53, LT  
 STA. 37+76 TO 38+25, LT  
 STA. 37+87 TO 38+46, RT

DURABLE 4 INCH WHITE LINE, THERMOPLASTIC  
 DURABLE 4 INCH WHITE LINE, POLYUREA  
 TEMPORARY 4 INCH WHITE LINE, PAINT  
 STA. 35+00 TO 40+00, SOLID LT & RT


DURABLE 4 INCH YELLOW LINE, THERMOPLASTIC  
 DURABLE 4 INCH YELLOW LINE, POLYUREA  
 TEMPORARY 4 INCH YELLOW LINE, PAINT  
 STA. 35+00 TO 40+00, SOLID LT & RT

GEOTEXTILE FOR SILT FENCE  
 STA. 35+25 TO 35+75, LT  
 STA. 37+75 TO 38+25, LT  
 STA. 37+75 TO 38+25, RT

BARRIER FENCE  
 STA. 35+00 TO 40+00, RT  
 EROSION LOG  
 STA. 35+00 TO 40+00, RT  
 STA. 35+00 TO 40+00, LT

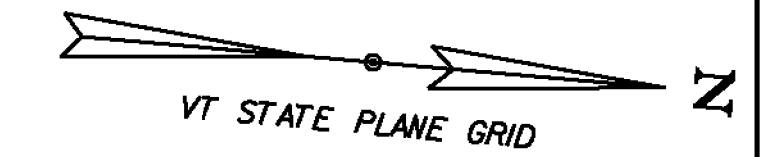

CURVE 69 DATA  
 R = 2800.00'  
 $\Delta = 6^\circ 40' 01.85''$   
 $D = 2^\circ 02' 46.60''$   
 T = 163.09'  
 L = 325.82'  
 E = 4.75'  
 e = 3.9%



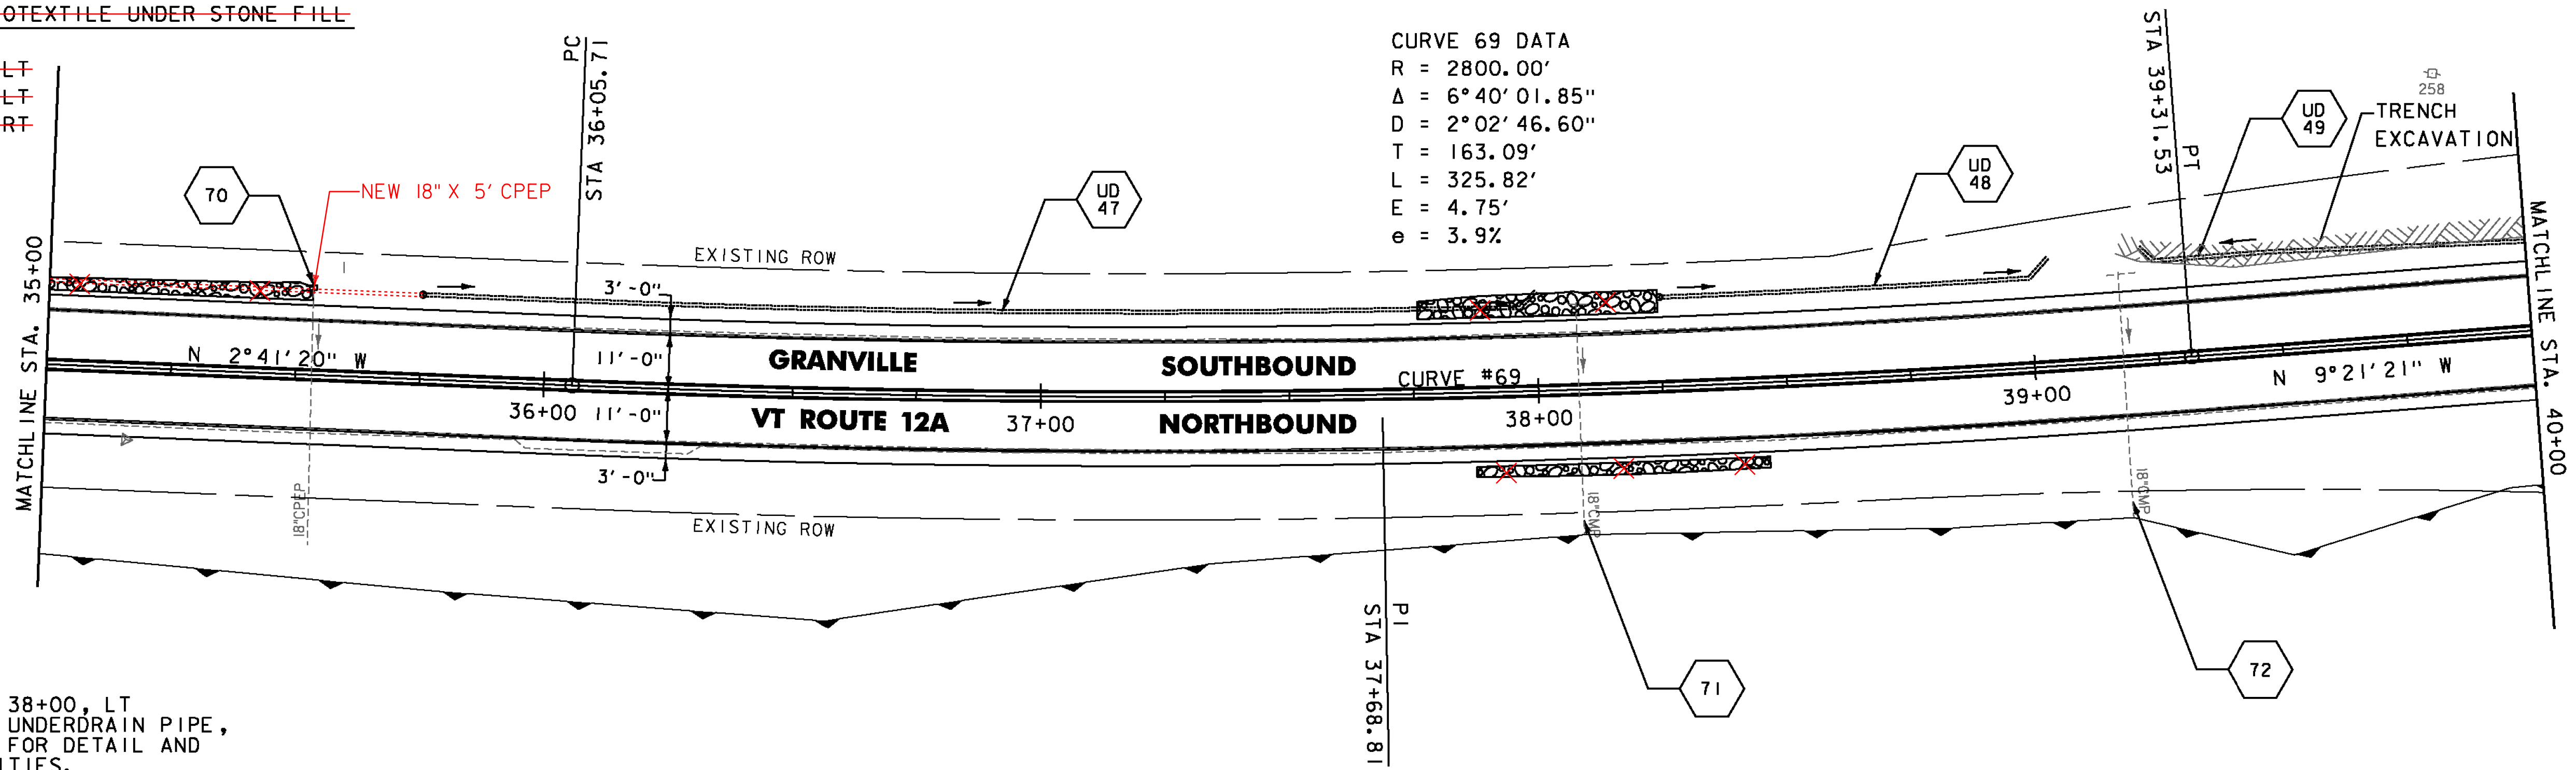


UD 47 STA 35+75, LT TO 38+00, LT  
 CONSTRUCT 6 INCH UNDERDRAIN PIPE,  
 SEE SHEETS 8 & 9 FOR DETAIL AND  
 ASSOCIATED QUANTITIES.

UD 48 STA 38+25, LT TO 39+05, LT  
 CONSTRUCT 6 INCH UNDERDRAIN PIPE,  
 SEE SHEETS 8 & 9 FOR DETAIL AND  
 ASSOCIATED QUANTITIES.

UD 49 STA 39+20, LT TO 40+82, LT  
 CONSTRUCT 6 INCH UNDERDRAIN PIPE,  
 SEE SHEETS 8 & 9 FOR DETAIL AND  
 ASSOCIATED QUANTITIES.

NOTE:  
 1. REFER TO SHEET 27 OF 545  
 FOR CULVERT INFORMATION.

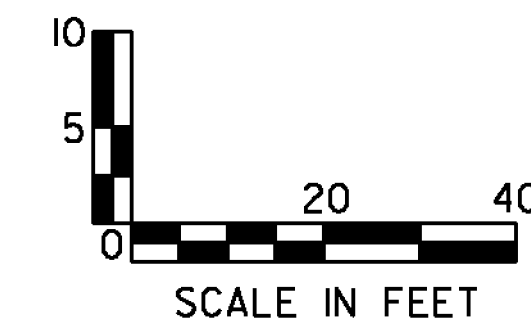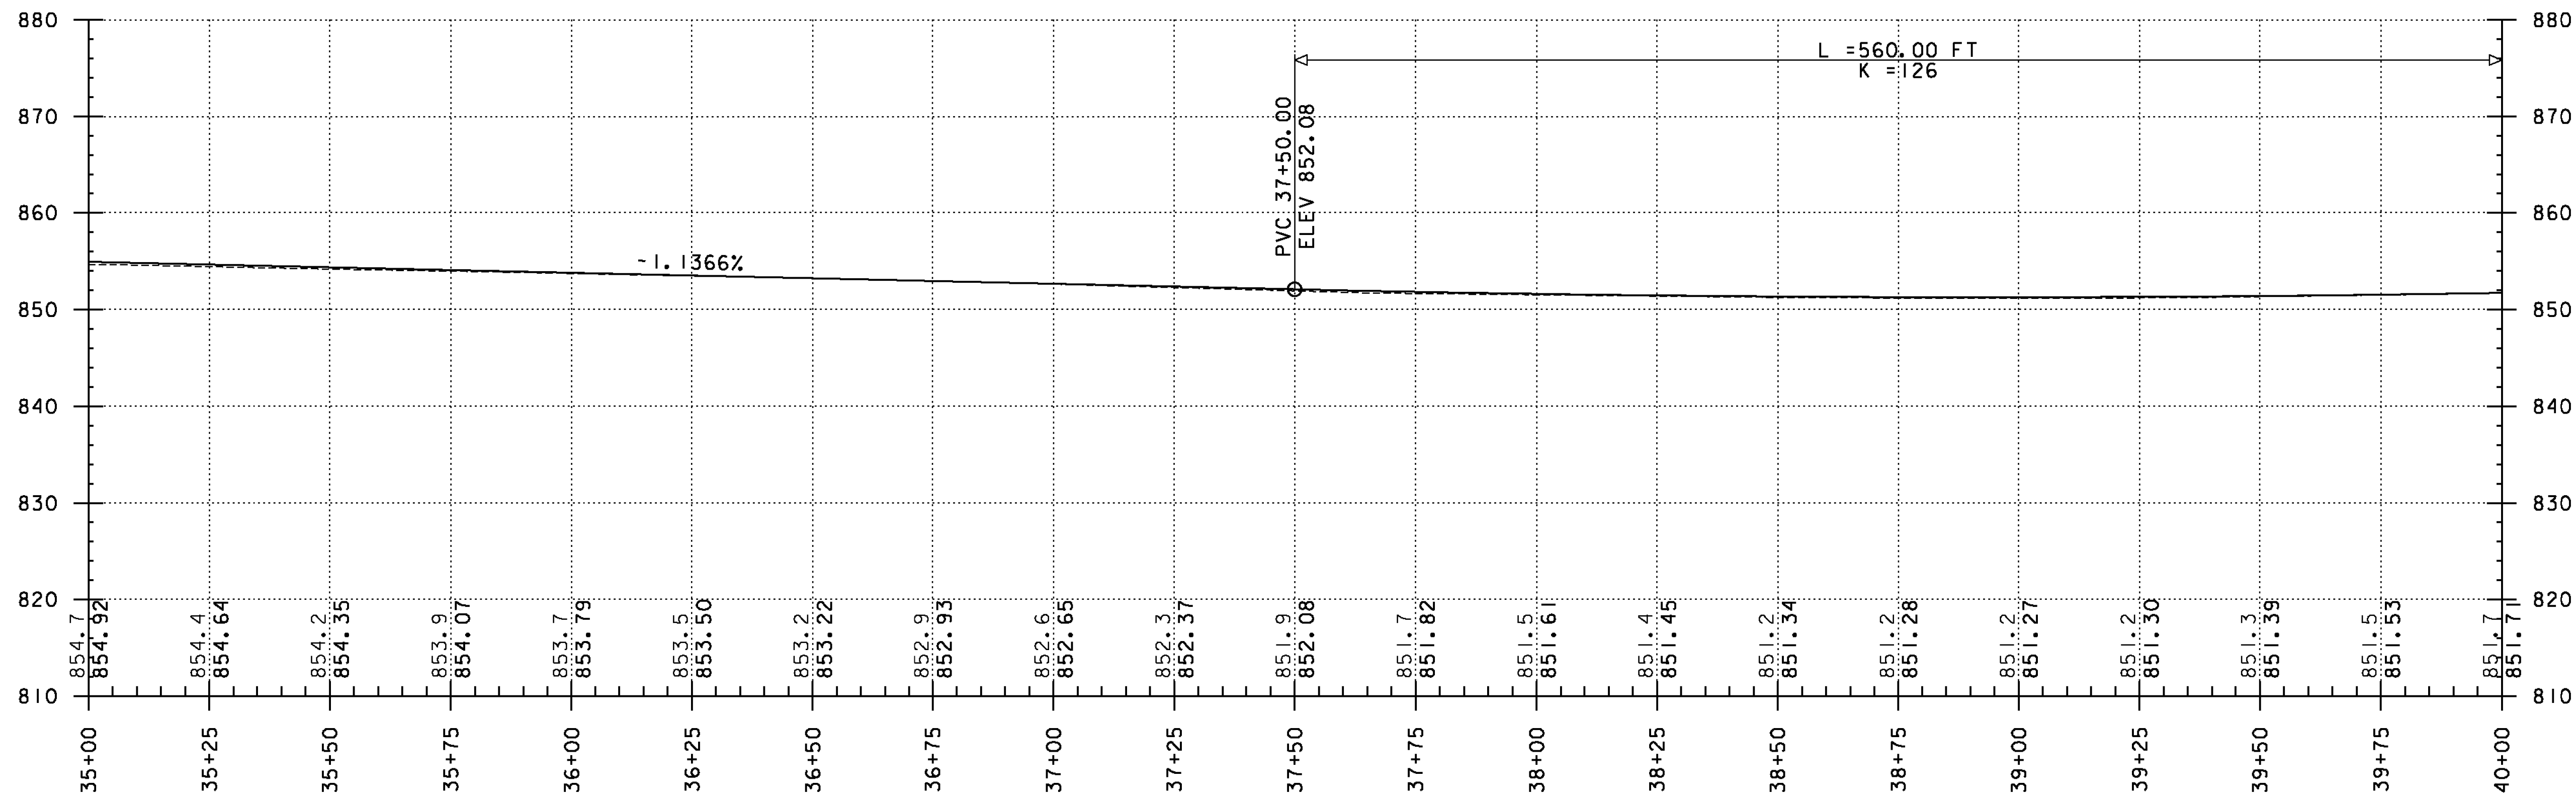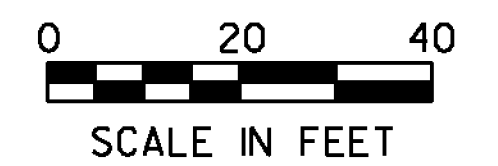

PROJECT NAME: RANDOLPH-ROXBURY  
 PROJECT NUMBER: ER STP 0187(II)

FILE NAME: z13cl82bdr.dgn  
 PROJECT LEADER: M. FOISY  
 DESIGNED BY: I. MAYNARD  
**PLAN & PROFILE SHEET 92**

PLOT DATE: 11/17/2014  
 DRAWN BY: G. BURGMEIER  
 CHECKED BY: M. FOISY  
 SHEET 133 OF 545