
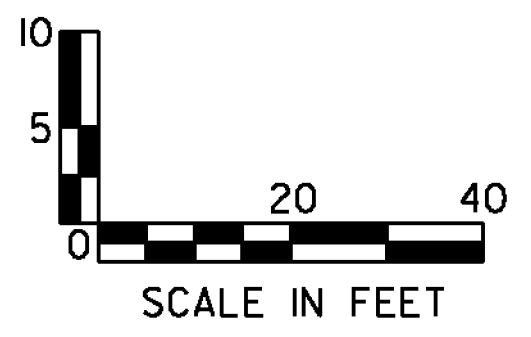
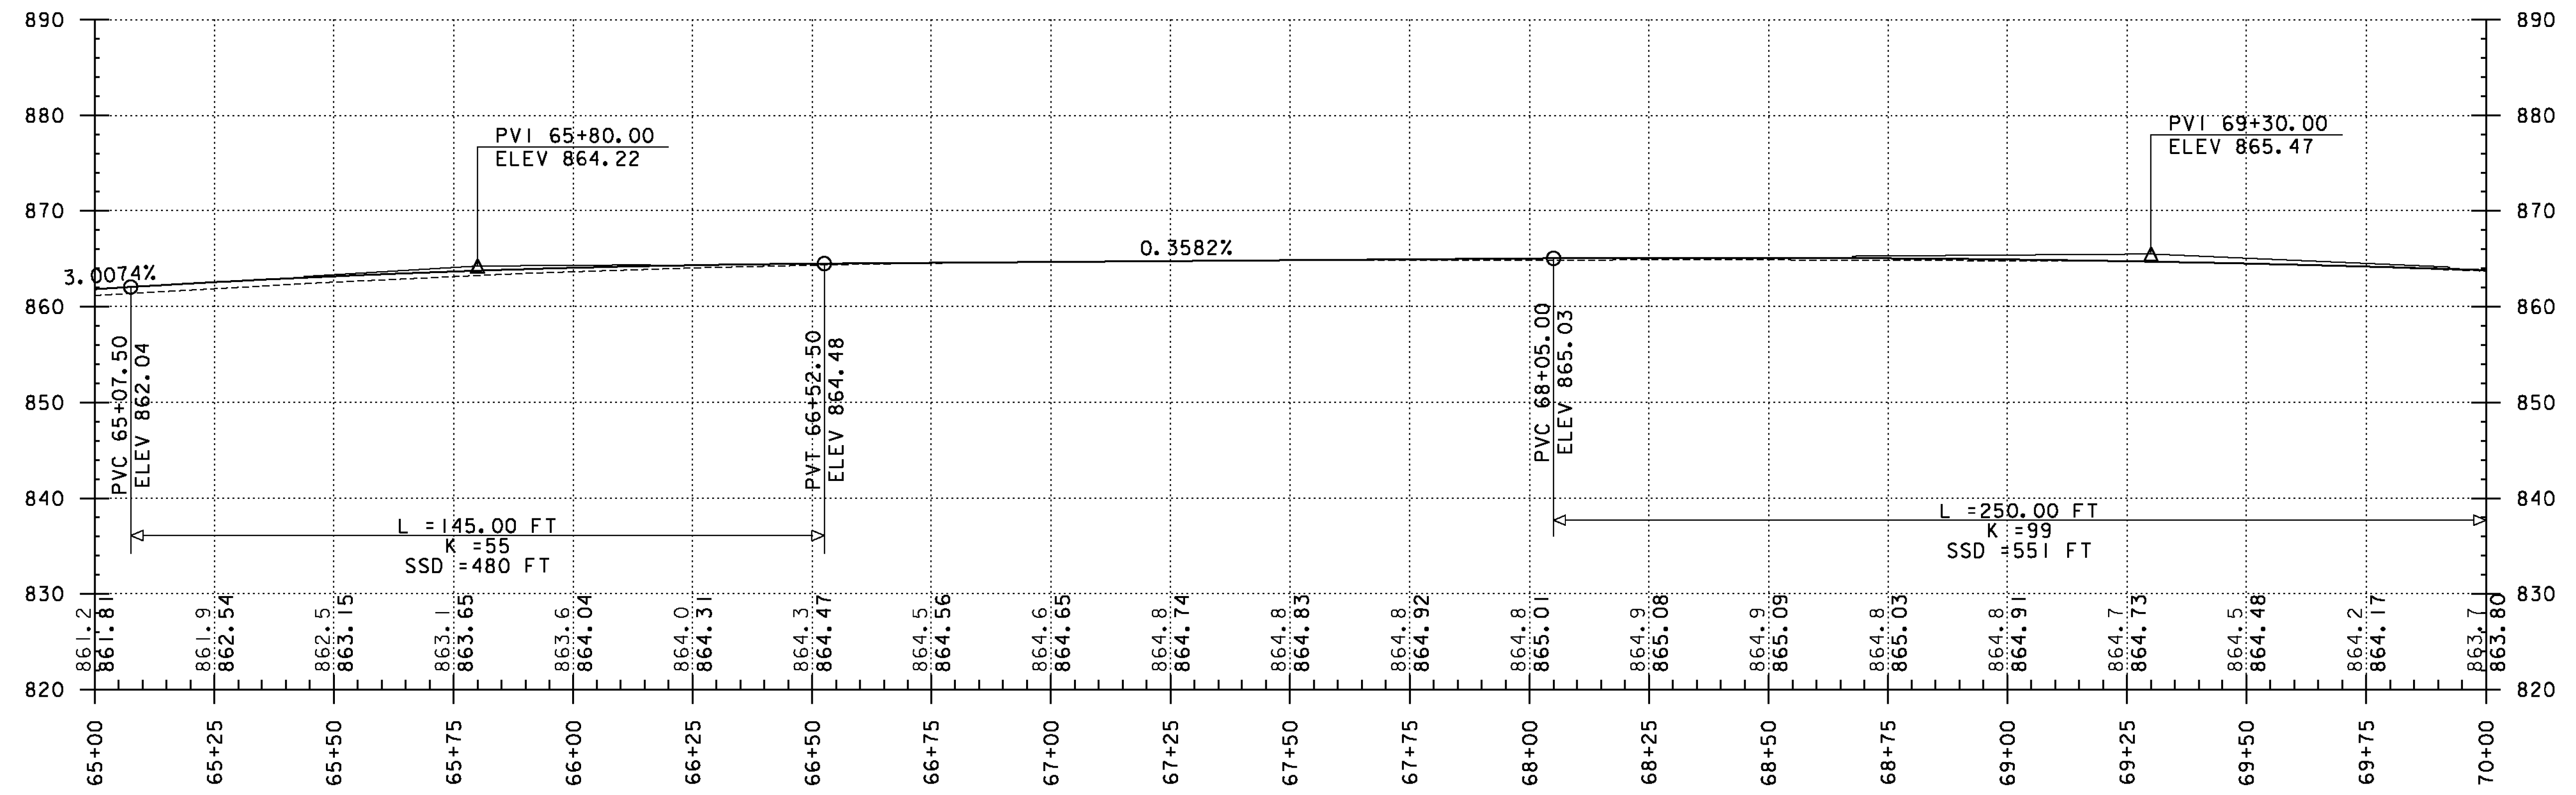


CURVE 75 DATA  
 R = 1210.00'  
 Δ = 17°45'30.20"  
 D = 4°44'06.68"  
 T = 189.03'  
 L = 375.03'  
 E = 14.68'  
 e = 6.9%

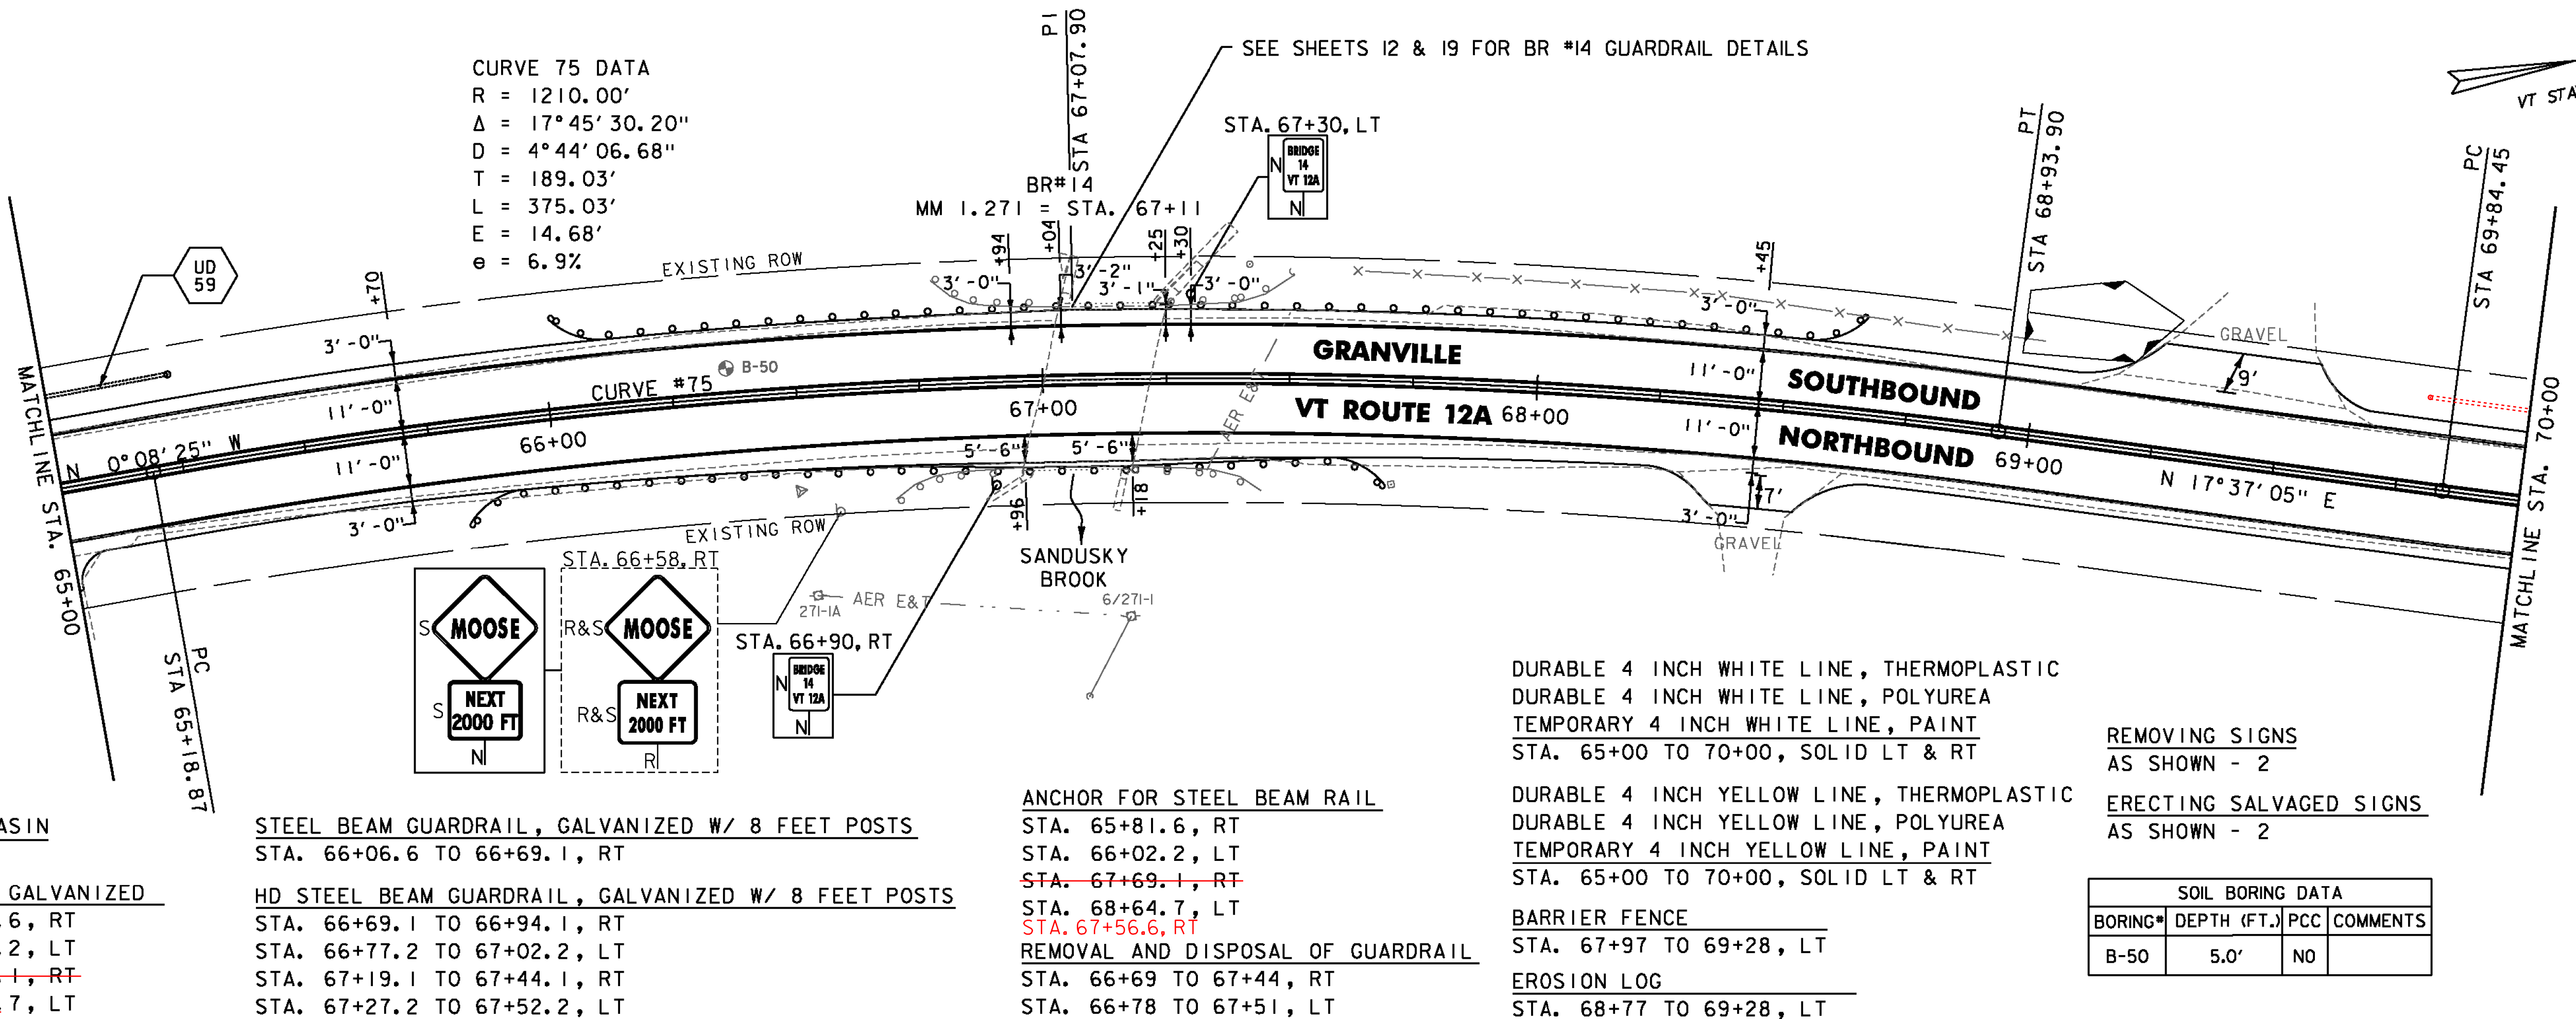

PROJECT NAME: RANDOLPH-ROXBURY  
 PROJECT NUMBER: ER STP 0187(II)

FILE NAME: z13cl82bdr.dgn  
 PROJECT LEADER: M. FOISY  
 DESIGNED BY: I. MAYNARD  
**PLAN & PROFILE SHEET 98**

PLOT DATE: 11/17/2014  
 DRAWN BY: G. BURGMEIER  
 CHECKED BY: M. FOISY  
 SHEET 139 OF 545

