

SOLID ROCK EXCAVATION



STA. 71+70 TO 72+20, LT
 STA. 71+65 TO 72+25, LT
UNDERDRAIN FLUSHING BASIN
 STA. 70+50, LT
 STA. 73+50, LT
 STA. 69+81, LT
 STA. 74+16, LT

DURABLE 4 INCH WHITE LINE, THERMOPLASTIC
 DURABLE 4 INCH WHITE LINE, POLYUREA
 TEMPORARY 4 INCH WHITE LINE, PAINT
 STA. 70+00 TO 75+00, SOLID LT & RT

DURABLE 4 INCH YELLOW LINE, THERMOPLASTIC
 DURABLE 4 INCH YELLOW LINE, POLYUREA
 TEMPORARY 4 INCH YELLOW LINE, PAINT
 STA. 70+00 TO 75+00, SOLID LT & RT
GEOTEXTILE FOR SILT FENCE
 STA. 73+75 TO 74+25, LT

BARRIER FENCE
 STA. 69+34 TO 75+00, RT
EROSION LOG
 STA. 70+14 TO 75+00, RT
 STA. 70+50 TO 75+00, LT




REMOVING SIGNS
 AS SHOWN - 1

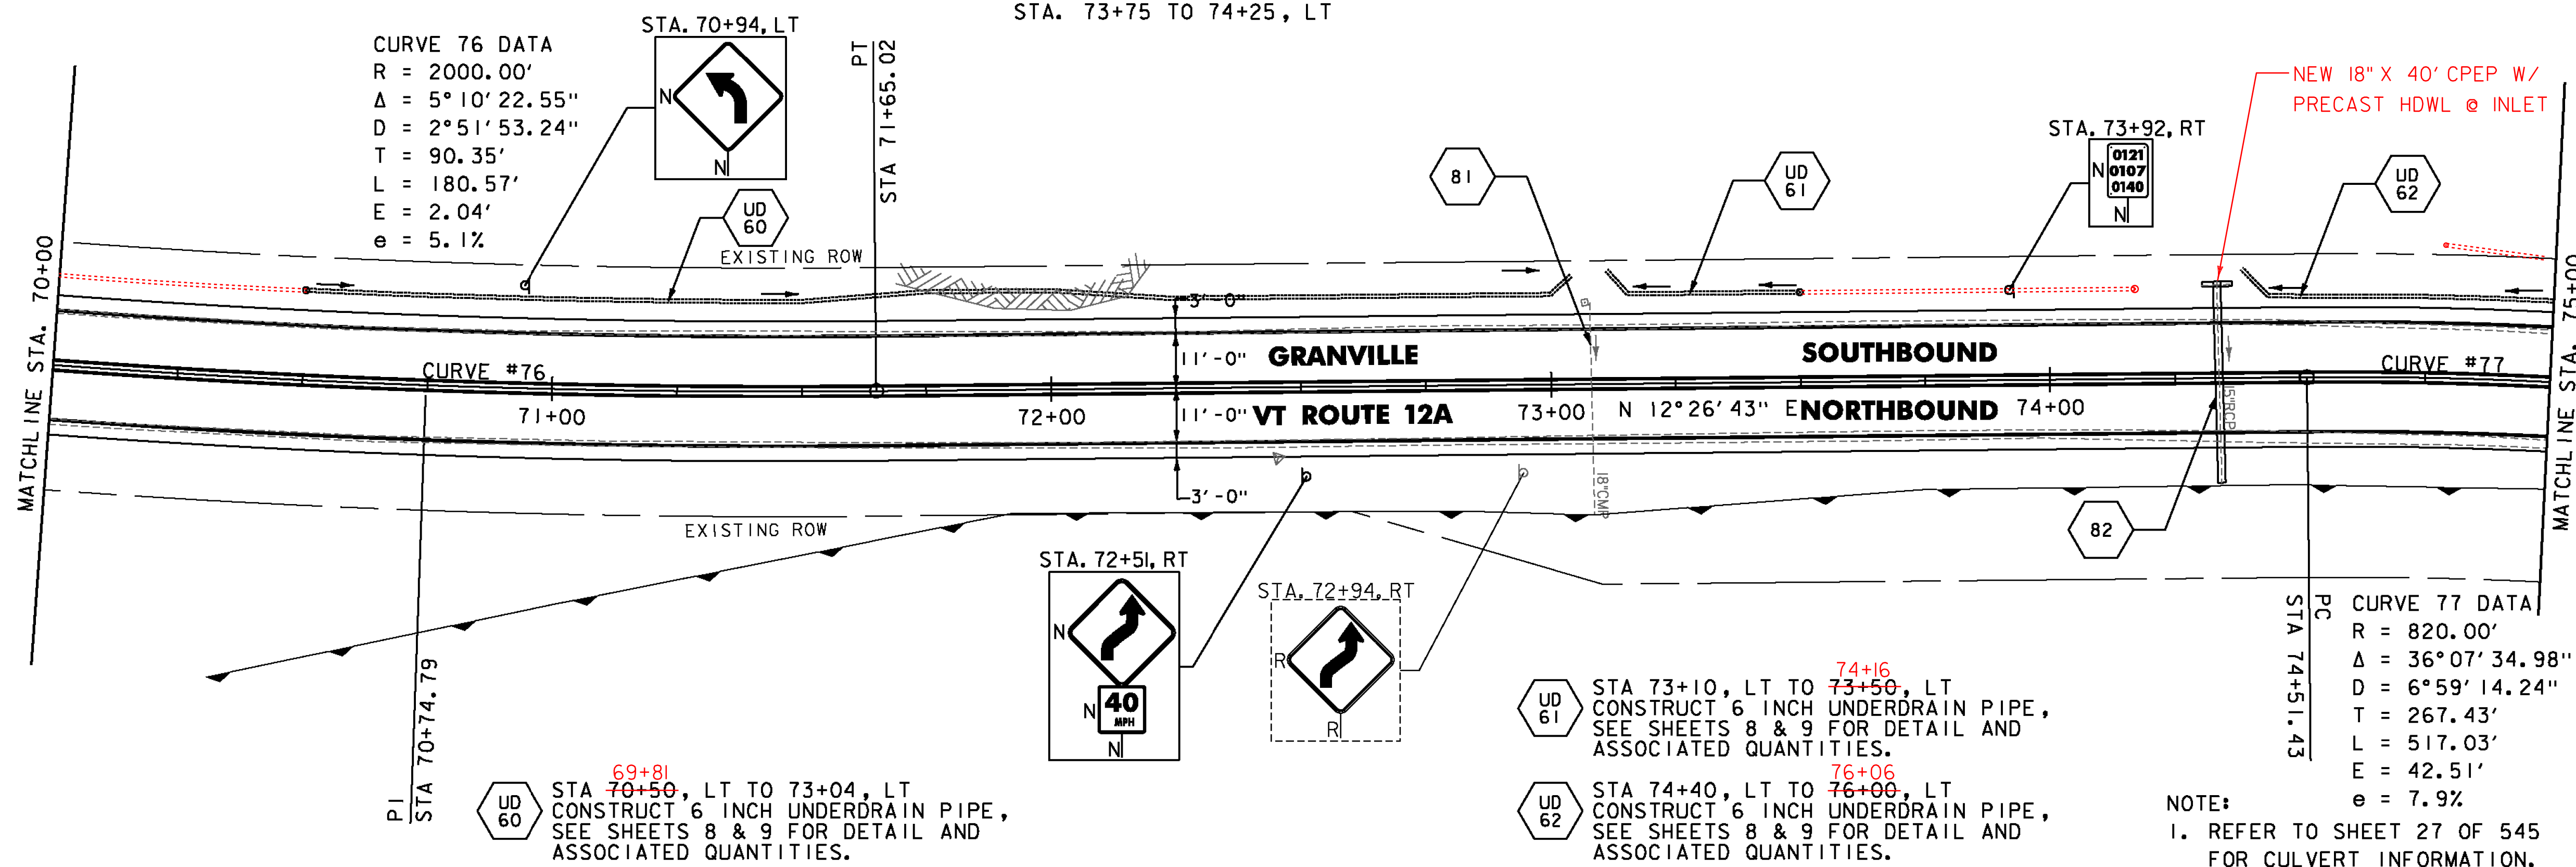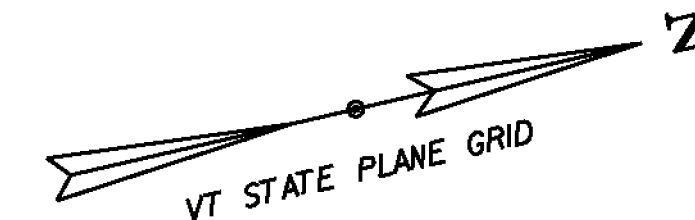

CURVE 76 DATA
 R = 2000.00'
 Δ = 5° 10' 22.55"
 D = 2° 51' 53.24"
 T = 90.35'
 L = 180.57'
 E = 2.04'
 e = 5.1%

CURVE 77 DATA
 R = 820.00'
 Δ = 36° 07' 34.98"
 D = 6° 59' 14.24"
 T = 267.43'
 L = 517.03'
 E = 42.51'
 e = 7.9%

NOTE:
 1. REFER TO SHEET 27 OF 545 FOR CULVERT INFORMATION.

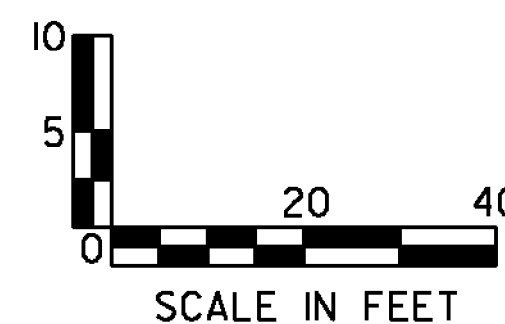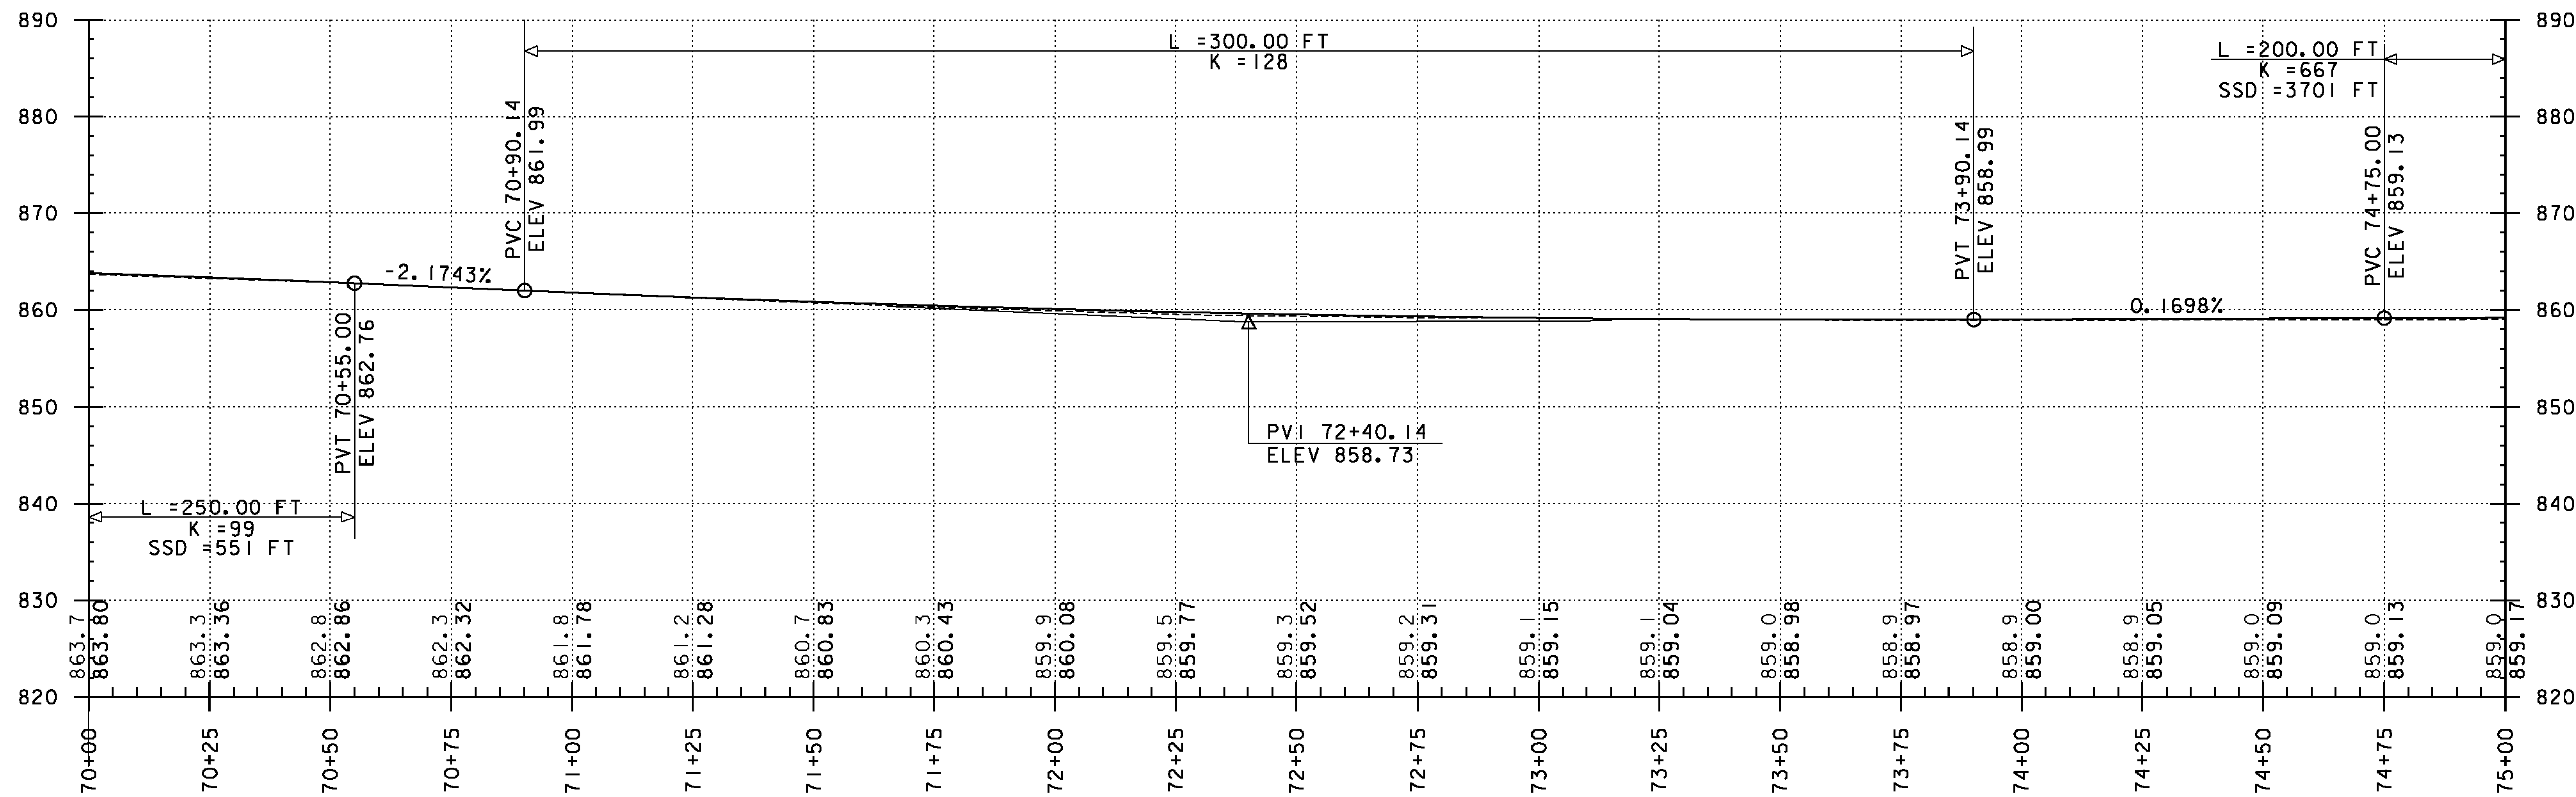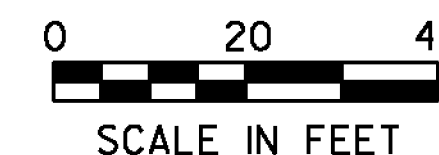

PROJECT NAME: RANDOLPH-ROXBURY
PROJECT NUMBER: ER STP 0187(II)
FILE NAME: z13cl82bdr.dgn
PROJECT LEADER: M. FOISY
DESIGNED BY: I. MAYNARD
PLAN & PROFILE SHEET 99
PLOT DATE: 11/17/2014
DRAWN BY: G. BURGMEIER
CHECKED BY: M. FOISY
SHEET 140 OF 545

