

SOLID ROCK EXCAVATION
 STA. ~~80+00 TO 80+85~~, LT STA. 80+00 TO 81+00, LT
 STA. ~~82+30 TO 83+80~~, LT STA. 82+25 TO 84+00, LT

UNDERDRAIN FLUSHING BASIN
 STA. ~~82+70~~, LT STA. 82+87, LT
 STA. ~~82+71~~, LT STA. 82+88, LT

STONE FILL TYPE I, GEOTEXTILE UNDER STONE FILL & GRUBBING MATERIAL
 STA. ~~81+25 TO 81+84~~, RT
 STA. ~~81+25 TO 81+90~~, LT
 STA. ~~83+96 TO 84+42~~, LT
 STA. 81+25 TO 81+75, LT

DURABLE 4 INCH WHITE LINE, THERMOPLASTIC
 DURABLE 4 INCH WHITE LINE, POLYUREA
 TEMPORARY 4 INCH WHITE LINE, PAINT
 STA. 80+00 TO 85+00, SOLID LT & RT

DURABLE 4 INCH YELLOW LINE, THERMOPLASTIC
 DURABLE 4 INCH YELLOW LINE, POLYUREA
 TEMPORARY 4 INCH YELLOW LINE, PAINT
 STA. 80+00 TO 85+00, SOLID LT & RT


GEOTEXTILE FOR SILT FENCE
 STA. 81+25 TO 81+75, LT

BARRIER FENCE
 STA. 80+00 TO 85+00, RT
 STA. 80+00 TO 81+06, LT

EROSION LOG
 STA. 80+00 TO 85+00, RT
 STA. 80+00 TO 85+00, LT

REMOVING SIGNS
 AS SHOWN - 2

ERECTING SALVAGED SIGNS
 AS SHOWN - 2

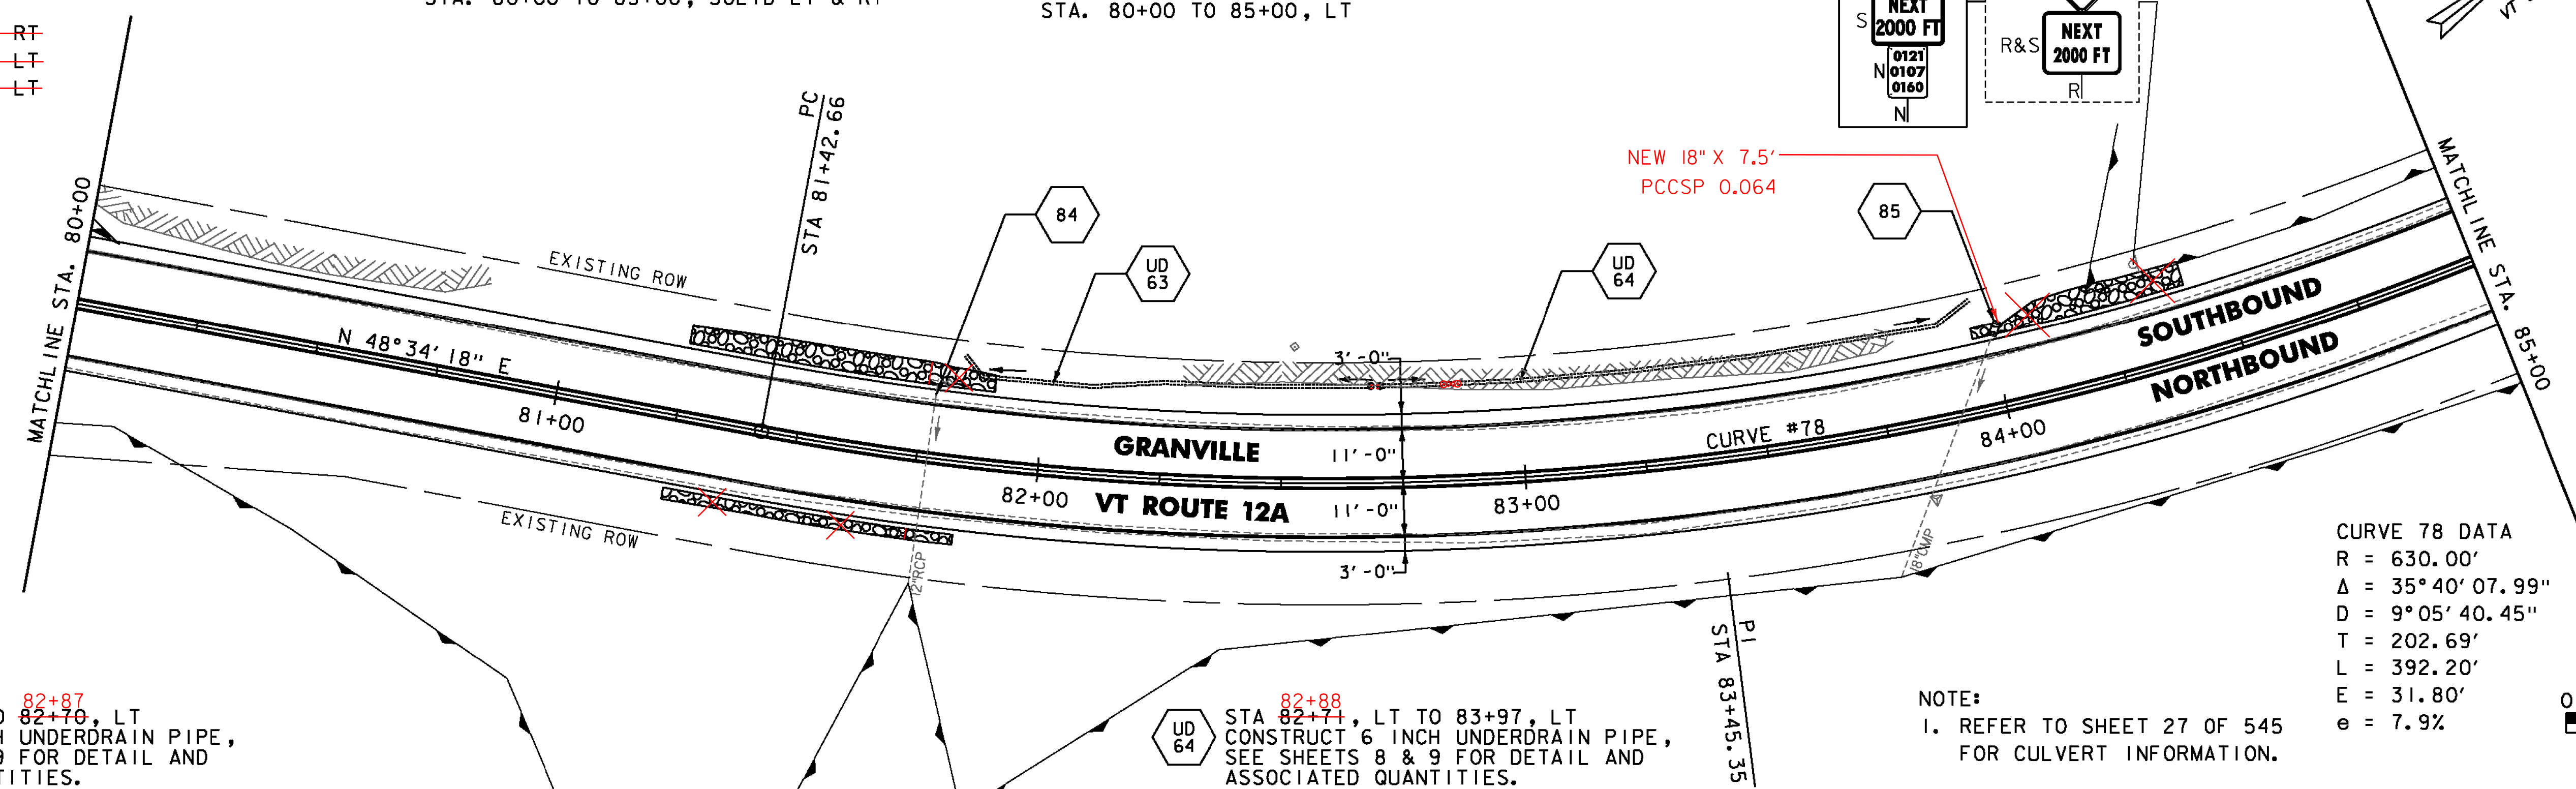



CURVE 78 DATA
 R = 630.00'
 $\Delta = 35^\circ 40' 07.99''$
 D = $9^\circ 05' 40.45''$
 T = 202.69'
 L = 392.20'
 E = 31.80'
 e = 7.9%

NOTE:
 1. REFER TO SHEET 27 OF 545 FOR CULVERT INFORMATION.



UD 63 STA. ~~81+83~~, LT TO ~~82+10~~, LT
 CONSTRUCT 6 INCH UNDERDRAIN PIPE,
 SEE SHEETS 8 & 9 FOR DETAIL AND
 ASSOCIATED QUANTITIES.

UD 64 STA. ~~82+71~~, LT TO 83+97, LT
 CONSTRUCT 6 INCH UNDERDRAIN PIPE,
 SEE SHEETS 8 & 9 FOR DETAIL AND
 ASSOCIATED QUANTITIES.

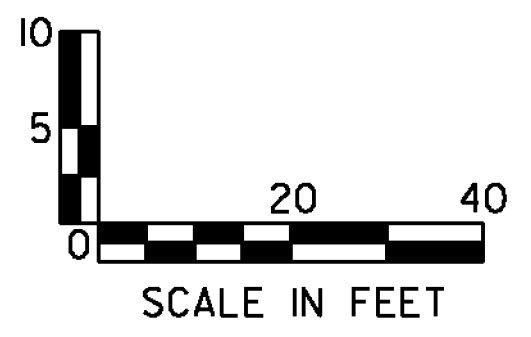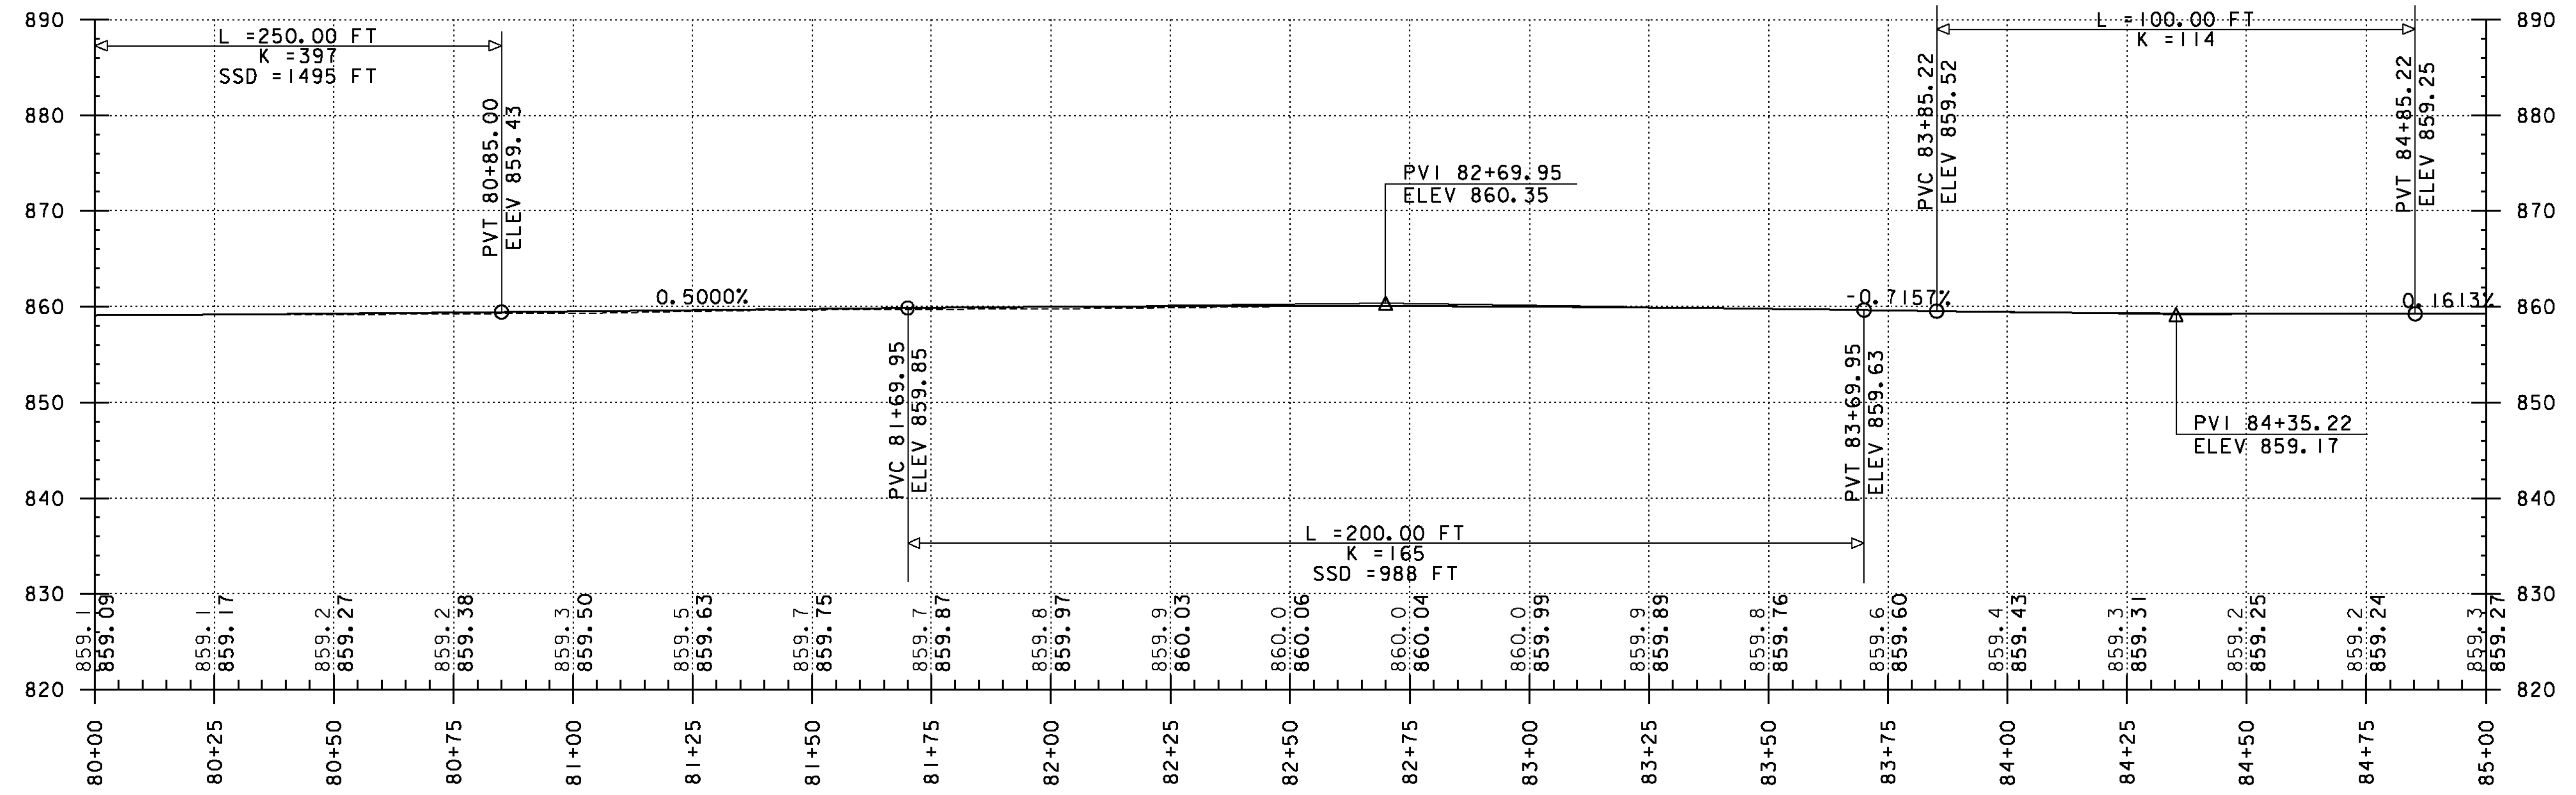

PROJECT NAME: RANDOLPH-ROXBURY
PROJECT NUMBER: ER STP 0187(II)

FILE NAME: z13cl82bdr.dgn
PROJECT LEADER: M. FOISY
DESIGNED BY: I. MAYNARD
PLAN & PROFILE SHEET 101

PLOT DATE: 11/17/2014
DRAWN BY: G. BURGMEIER
CHECKED BY: M. FOISY
SHEET 142 OF 545

