

SOLID ROCK EXCAVATION

STA. 86+25 TO 86+60, LT

STEEL BEAM GUARDRAIL, GALVANIZED

STA. 0+57.5 TO 0+82.5, RT

STEEL BEAM GUARDRAIL, GALVANIZED W/ 8 FEET POSTS

STA. 0+82.5 TO 1+00.0, RT

ANCHOR FOR STEEL BEAM RAIL

STA. 0+57.5, RT

DURABLE 4 INCH WHITE LINE, THERMOPLASTIC

DURABLE 4 INCH WHITE LINE, POLYUREA

TEMPORARY 4 INCH WHITE LINE, PAINT

GRANVILLE STA. 85+00 TO 88+48.34, SOLID LT & RT

ROXBURY STA. 0+00 TO 1+00, SOLID LT & RT

DURABLE 4 INCH YELLOW LINE, THERMOPLASTIC

DURABLE 4 INCH YELLOW LINE, POLYUREA

TEMPORARY 4 INCH YELLOW LINE, PAINT

GRANVILLE STA. 85+00 TO 88+48.34, SOLID LT & RT

ROXBURY STA. 0+00 TO 1+00, SOLID LT & RT

BARRIER FENCE

GRANVILLE STA. 85+00 TO 88+48, RT

GRANVILLE STA. 85+00 TO 85+50, LT

ROXBURY STA. 0+00 TO 1+00, RT

EROSION LOG


GRANVILLE STA. 85+00 TO 88+48, RT

GRANVILLE STA. 85+00 TO 86+00, LT

ROXBURY STA. 0+00 TO 1+00, RT

REMOVING SIGNS

AS SHOWN - 5

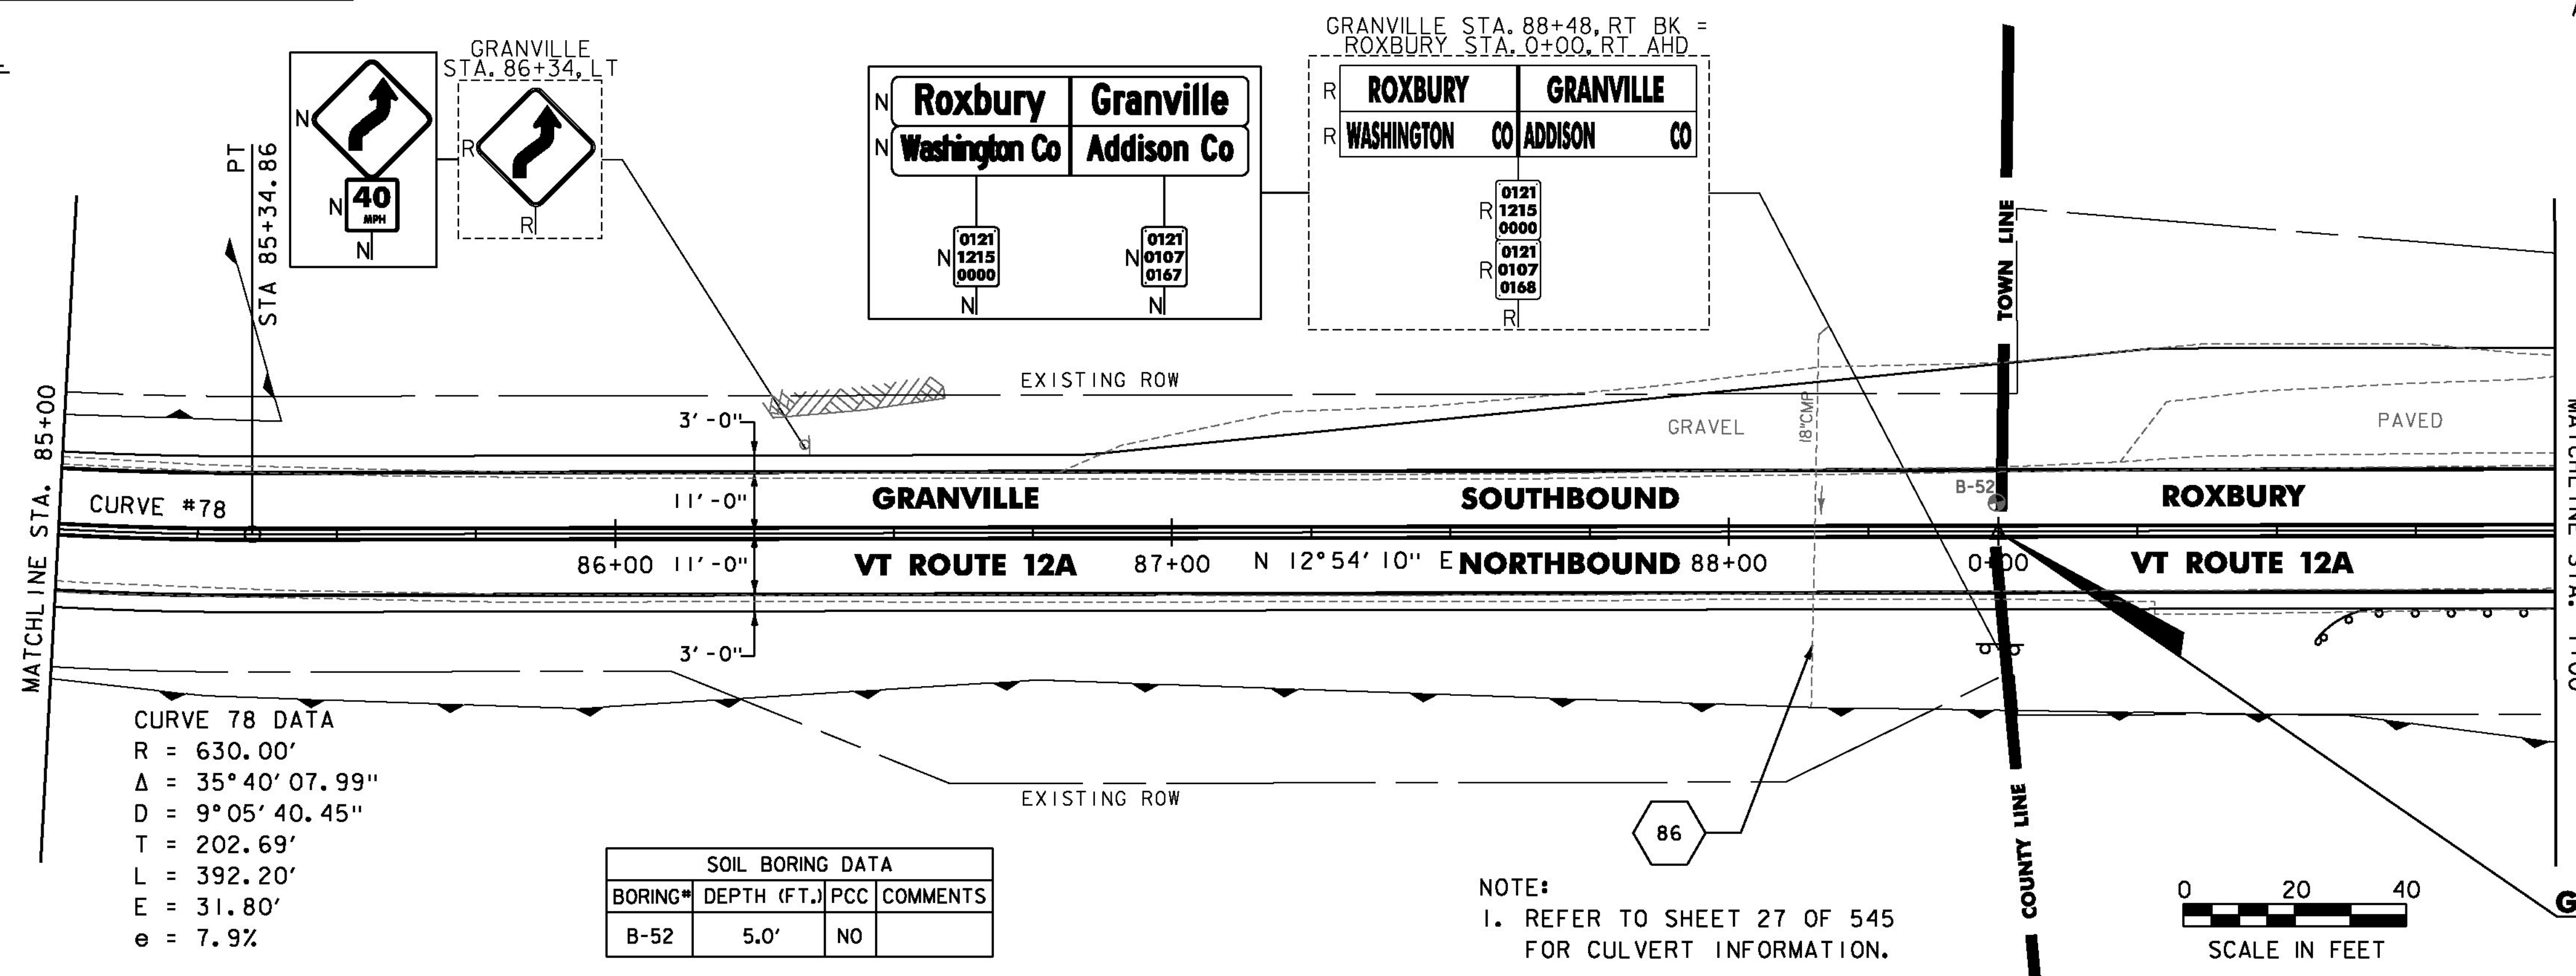

CURVE 78 DATA

R = 630.00'

Δ = 35° 40' 07.99"

D = 9° 05' 40.45"

T = 202.69'

L = 392.20'

E = 31.80'



e = 7.9%

SOIL BORING DATA			
BORING#	DEPTH (FT.)	PCC	COMMENTS
B-52	5.0'	NO	

NOTE:

1. REFER TO SHEET 27 OF 545 FOR CULVERT INFORMATION.

GRANVILLE P.O.T. 88+48.34 BK= ROXBURY P.O.T. 0+00.00 AHD

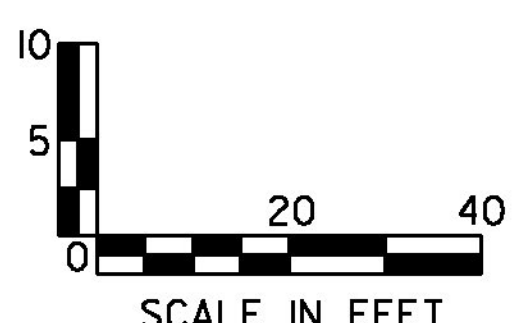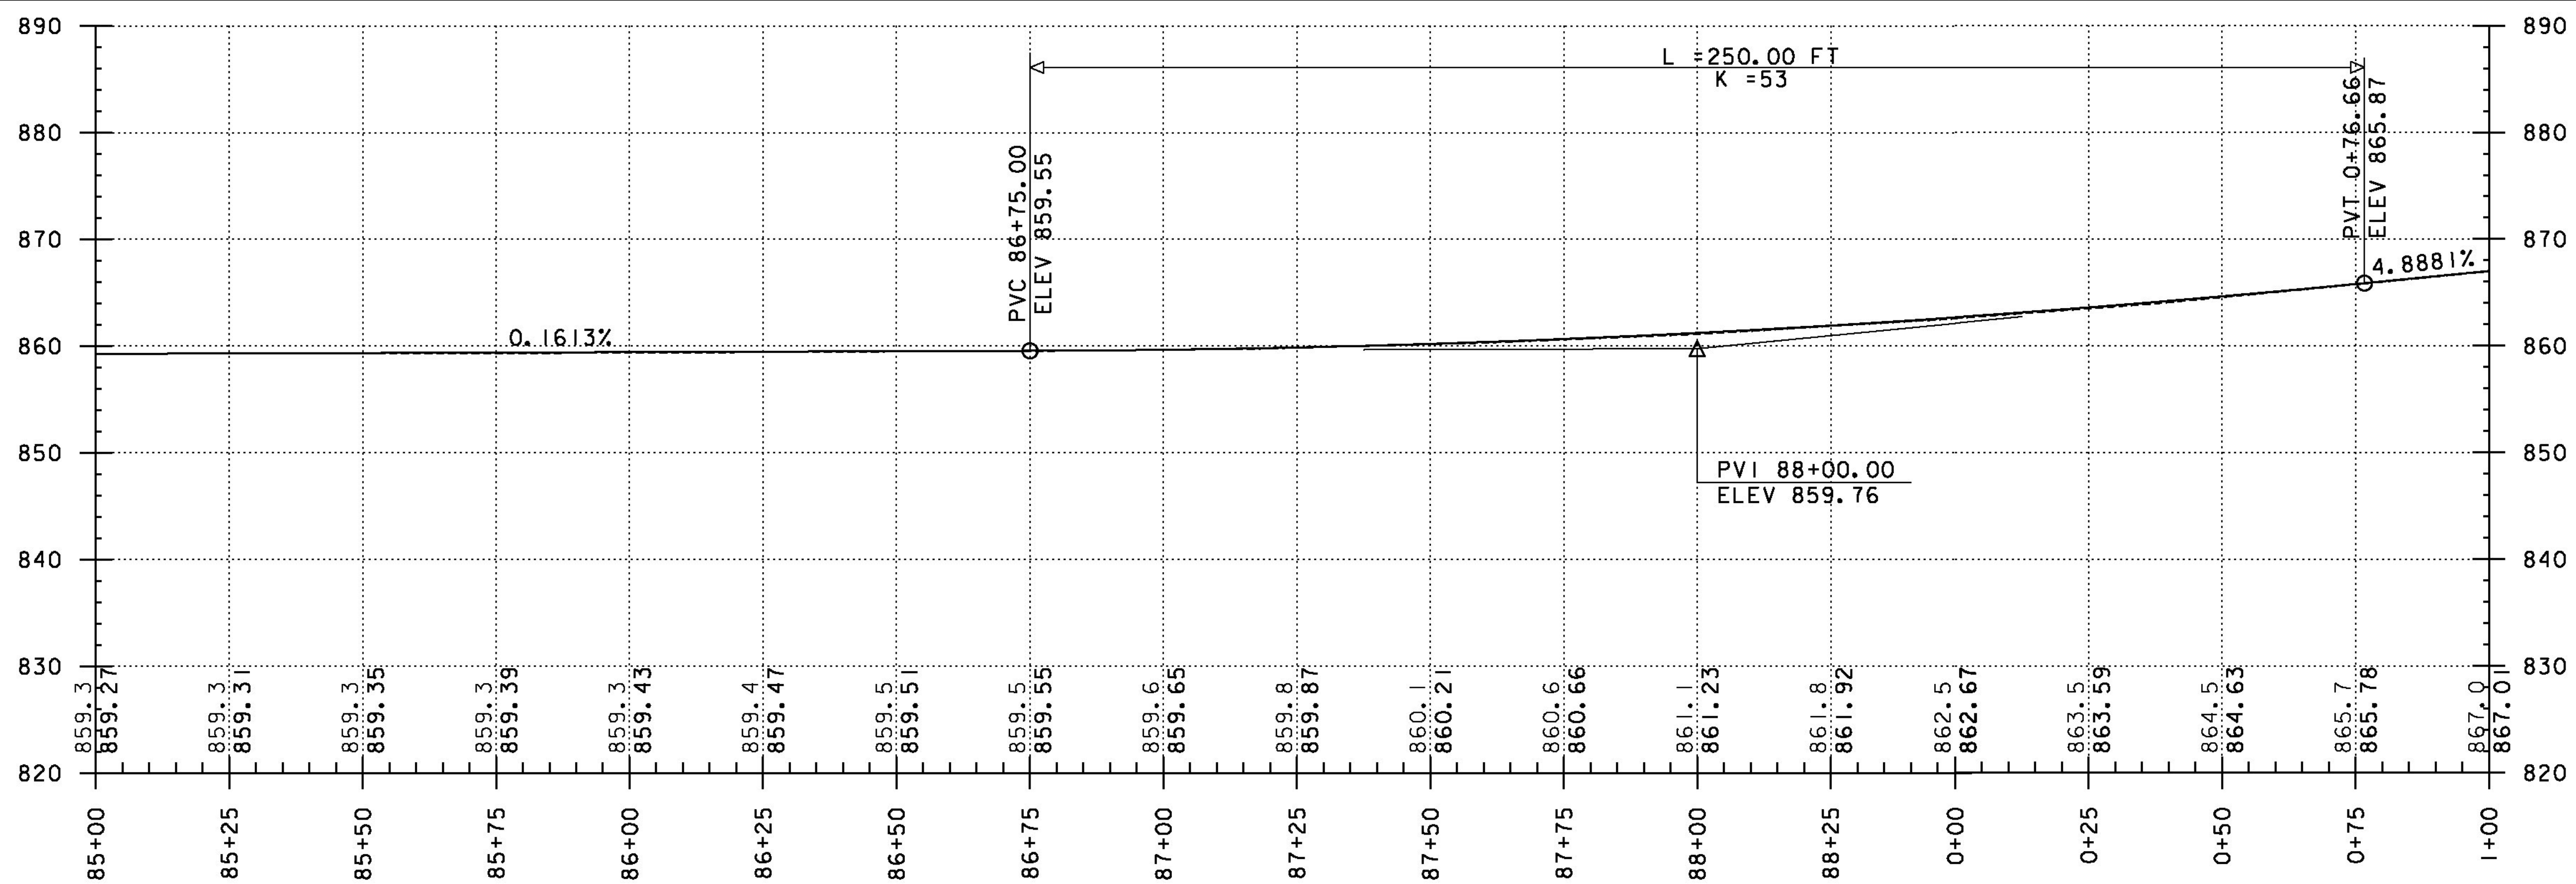

PROJECT NAME: RANDOLPH-ROXBURY

PROJECT NUMBER: ER STP 0187(II)

FILE NAME: z13ci82bdr.dgn

PROJECT LEADER: M. FOISY

DESIGNED BY: I. MAYNARD

PLAN & PROFILE SHEET 102

PLOT DATE: 11/17/2014

DRAWN BY: G. BURGMEIER

CHECKED BY: M. FOISY

SHEET 143 OF 545

