

STONE FILL TYPE I, GEOTEXTILE UNDER STONE FILL & GRUBBING MATERIAL  
 STA. 9+50 TO 9+75, LT  
 STEEL BEAM GUARDRAIL, GALVANIZED W/ 8 FEET POSTS  
 STA. 6+00.0 TO 12+00.0, RT  
 REMOVAL AND DISPOSAL OF GUARDRAIL  
 STA. 6+00 TO 8+85, RT  
 STA. 10+04 TO 12+00, RT




DURABLE 4 INCH WHITE LINE, THERMOPLASTIC  
 DURABLE 4 INCH WHITE LINE, POLYUREA  
 TEMPORARY 4 INCH WHITE LINE, PAINT  
 STA. 6+00 TO 12+00, SOLID LT & RT

DURABLE 4 INCH YELLOW LINE, THERMOPLASTIC  
 DURABLE 4 INCH YELLOW LINE, POLYUREA  
 TEMPORARY 4 INCH YELLOW LINE, PAINT  
 STA. 6+00 TO 12+00, SOLID LT & RT

BARRIER FENCE  
 STA. 6+00 TO 12+00, RT  
 STA. 7+09 TO 12+64, LT

EROSION LOG  
 STA. 6+00 TO 12+00, RT  
 STA. 7+89 TO 11+84, LT

REMOVING SIGNS  
 AS SHOWN - 1

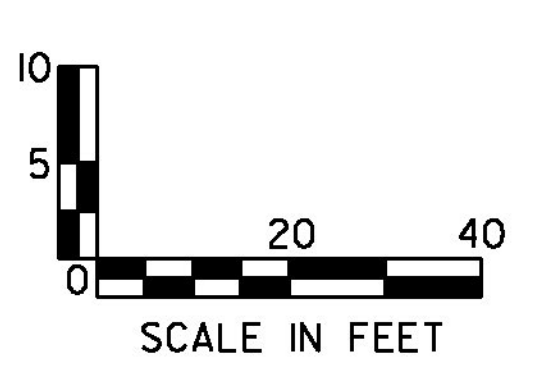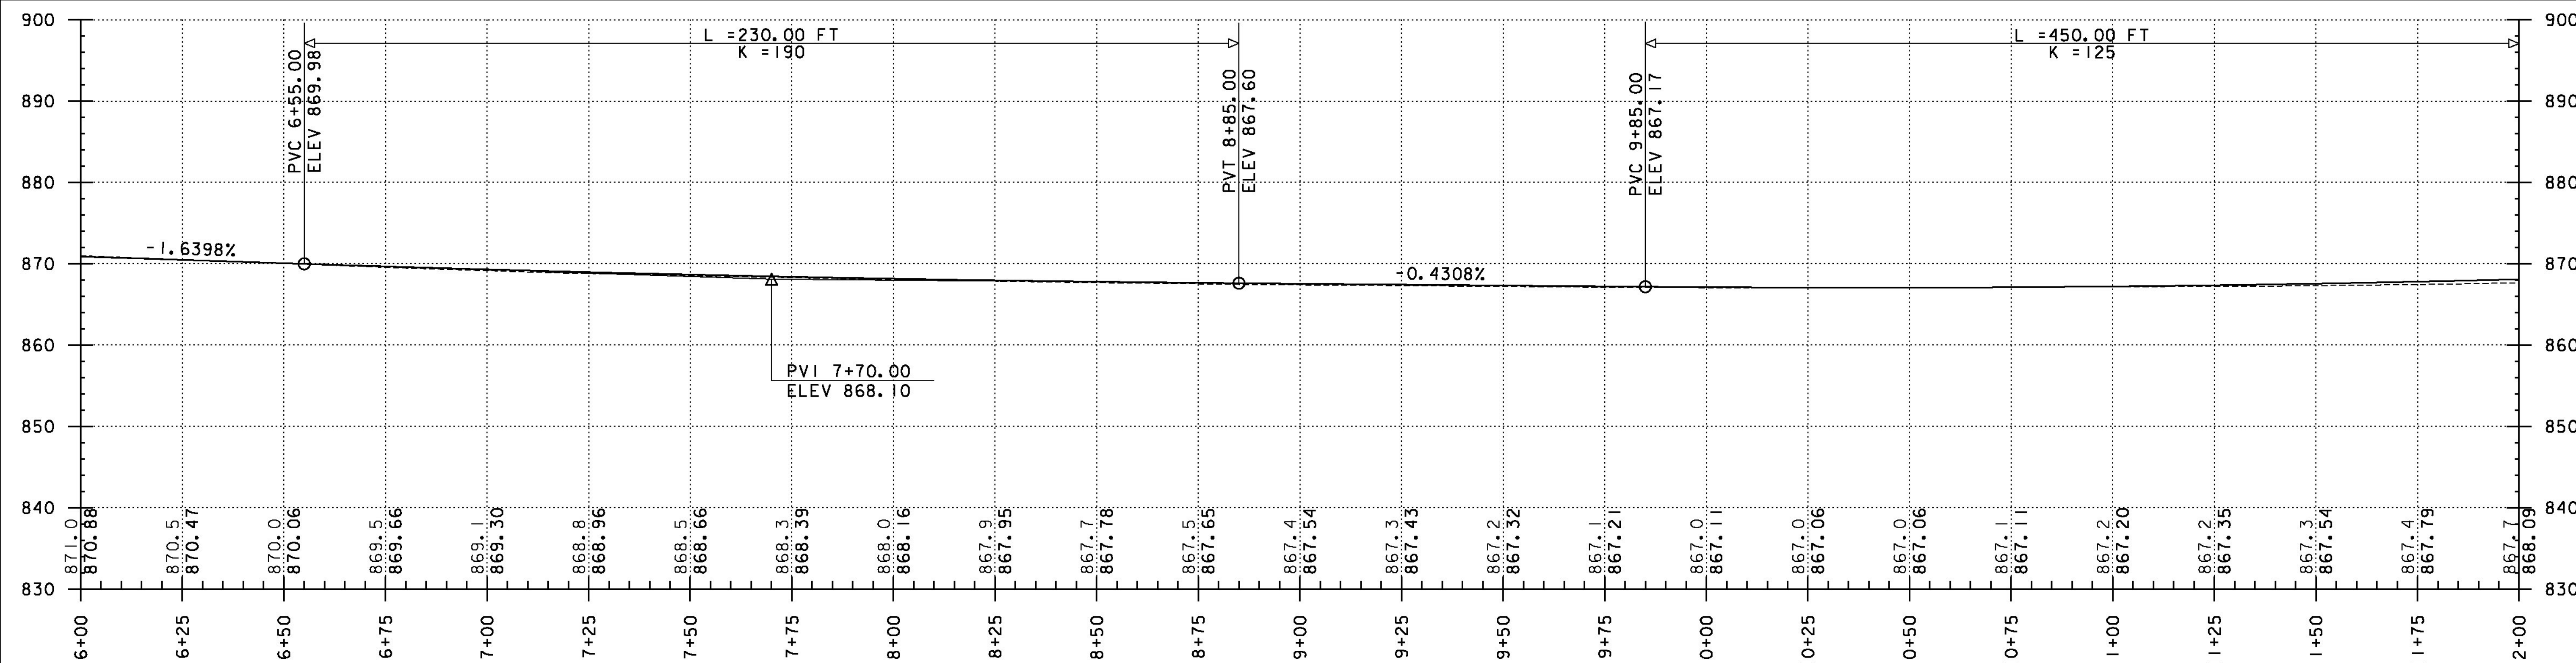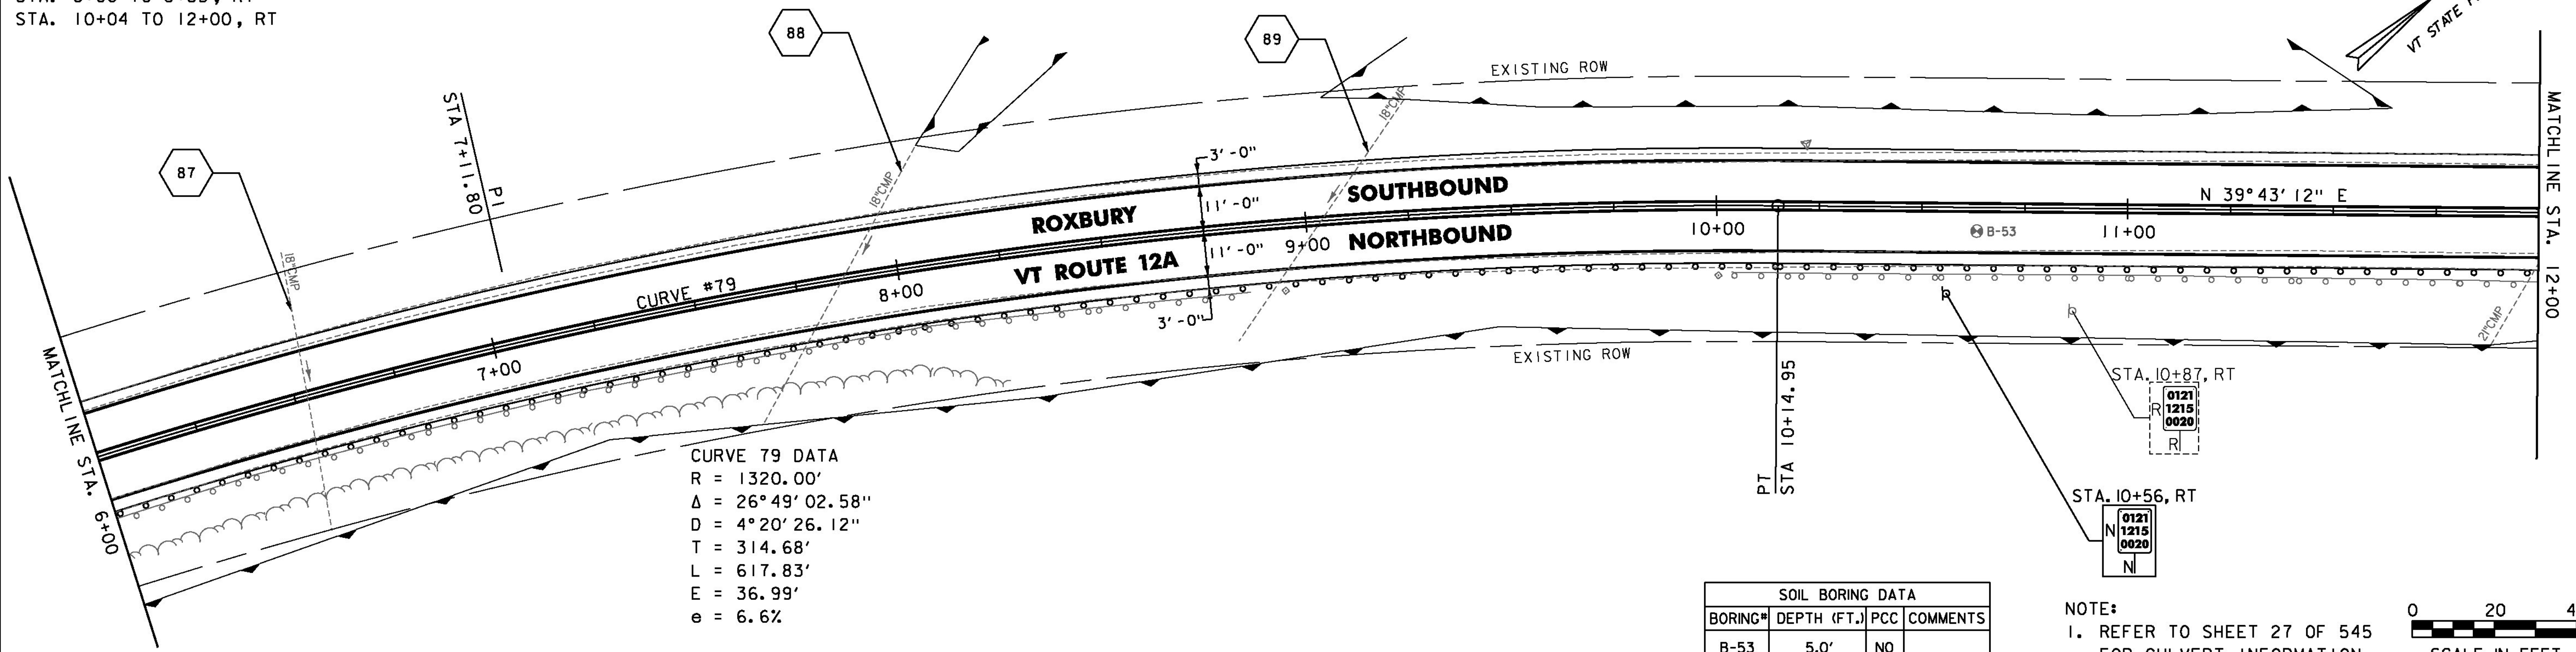

PROJECT NAME: RANDOLPH-ROXBURY  
 PROJECT NUMBER: ER STP 0187(II)  
 FILE NAME: z13ci82bdr.dgn  
 PROJECT LEADER: M. FOISY  
 DESIGNED BY: I. MAYNARD  
 PLOT DATE: 11/17/2014  
 DRAWN BY: G. BURMEIER  
 CHECKED BY: M. FOISY  
**PLAN & PROFILE SHEET 104**  
 SHEET 145 OF 545