



CURVE #16

CURVE #17

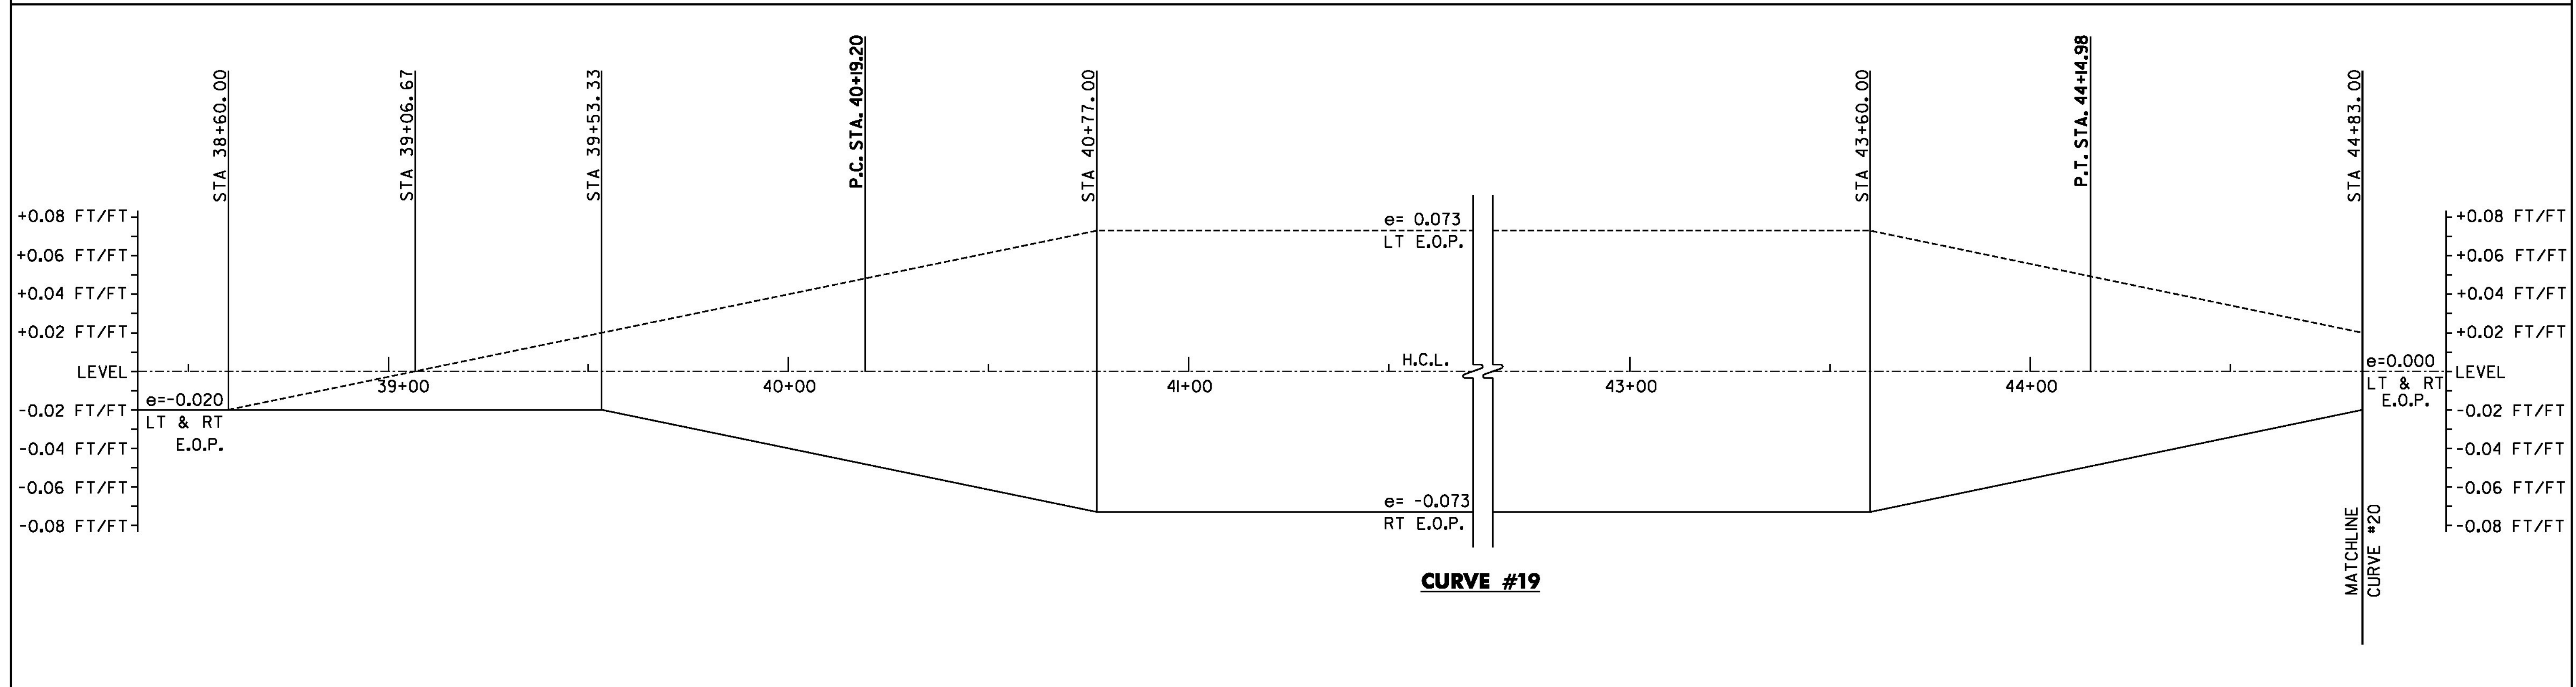

CURVE #19

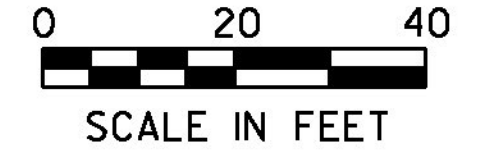

PROJECT NAME: RANDOLPH-ROXBURY	PLOT DATE: 11/17/2014
PROJECT NUMBER: ER STP 0187(II)	DRAWN BY: G. BURGMEIER
FILE NAME: z13ci82sup.dgn	CHECKED BY: M. FOISY
DESIGNED BY: I. MAYNARD	SHEET 154 OF 545
BANKING DIAGRAM SHEET 5	