



CURVE #79

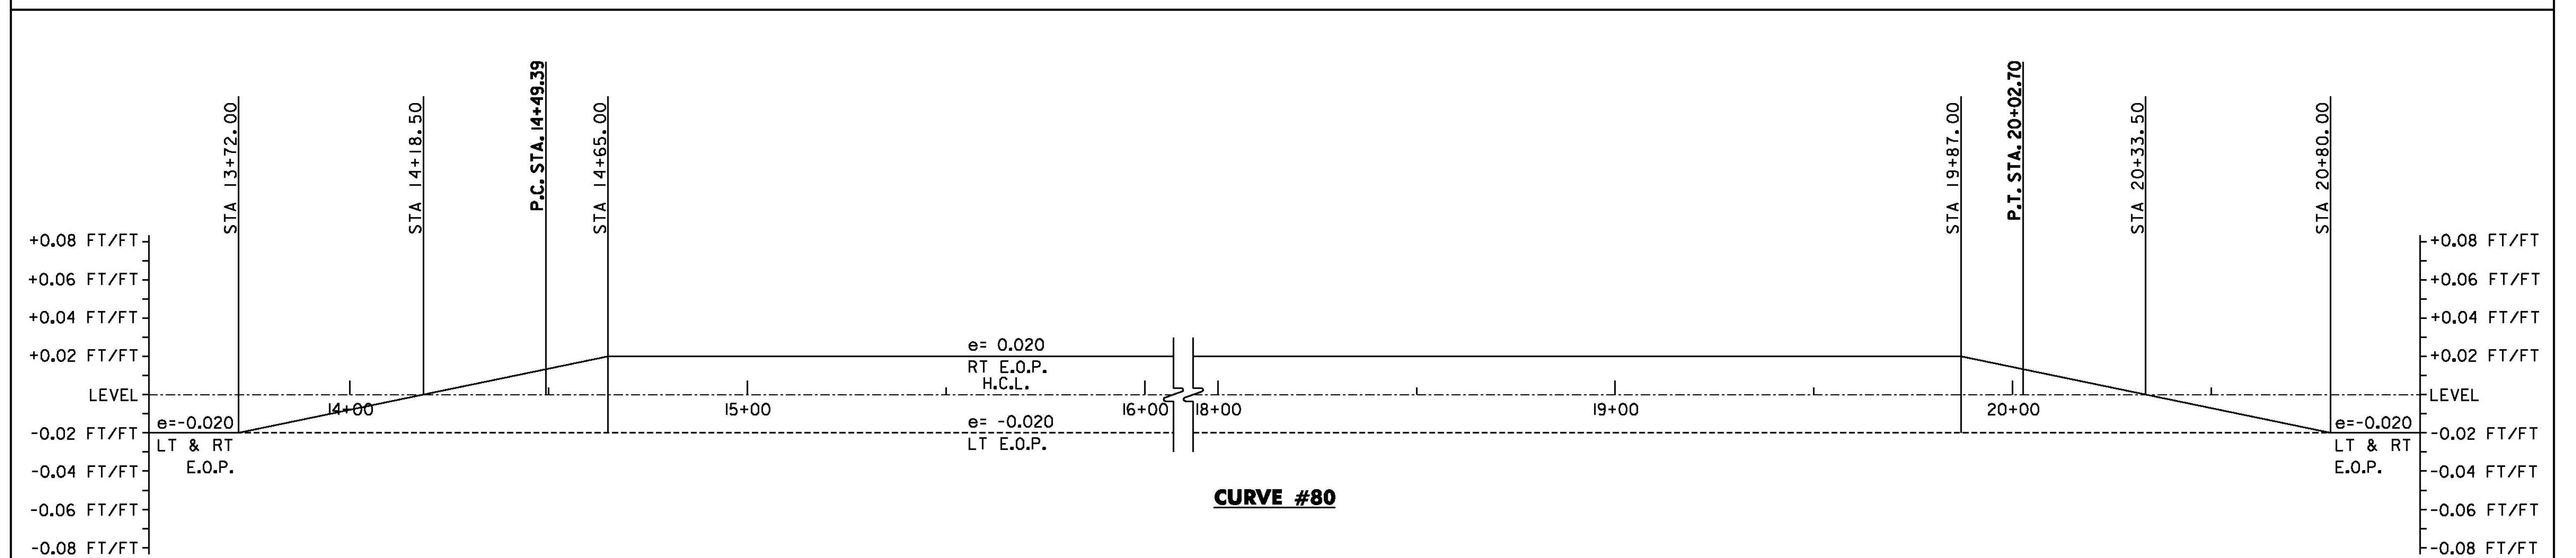

CURVE #80

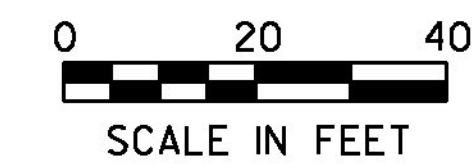

PROJECT NAME: RANDOLPH-ROXBURY
PROJECT NUMBER: ER STP 0187(II)

FILE NAME: z13c182sup.dgn
PROJECT LEADER: M. FOISY
DESIGNED BY: I. MAYNARD
BANKING DIAGRAM SHEET 25

PLOT DATE: 11/17/2014
DRAWN BY: G. BURGMIEER
CHECKED BY: M. FOISY
SHEET 174 OF 545