

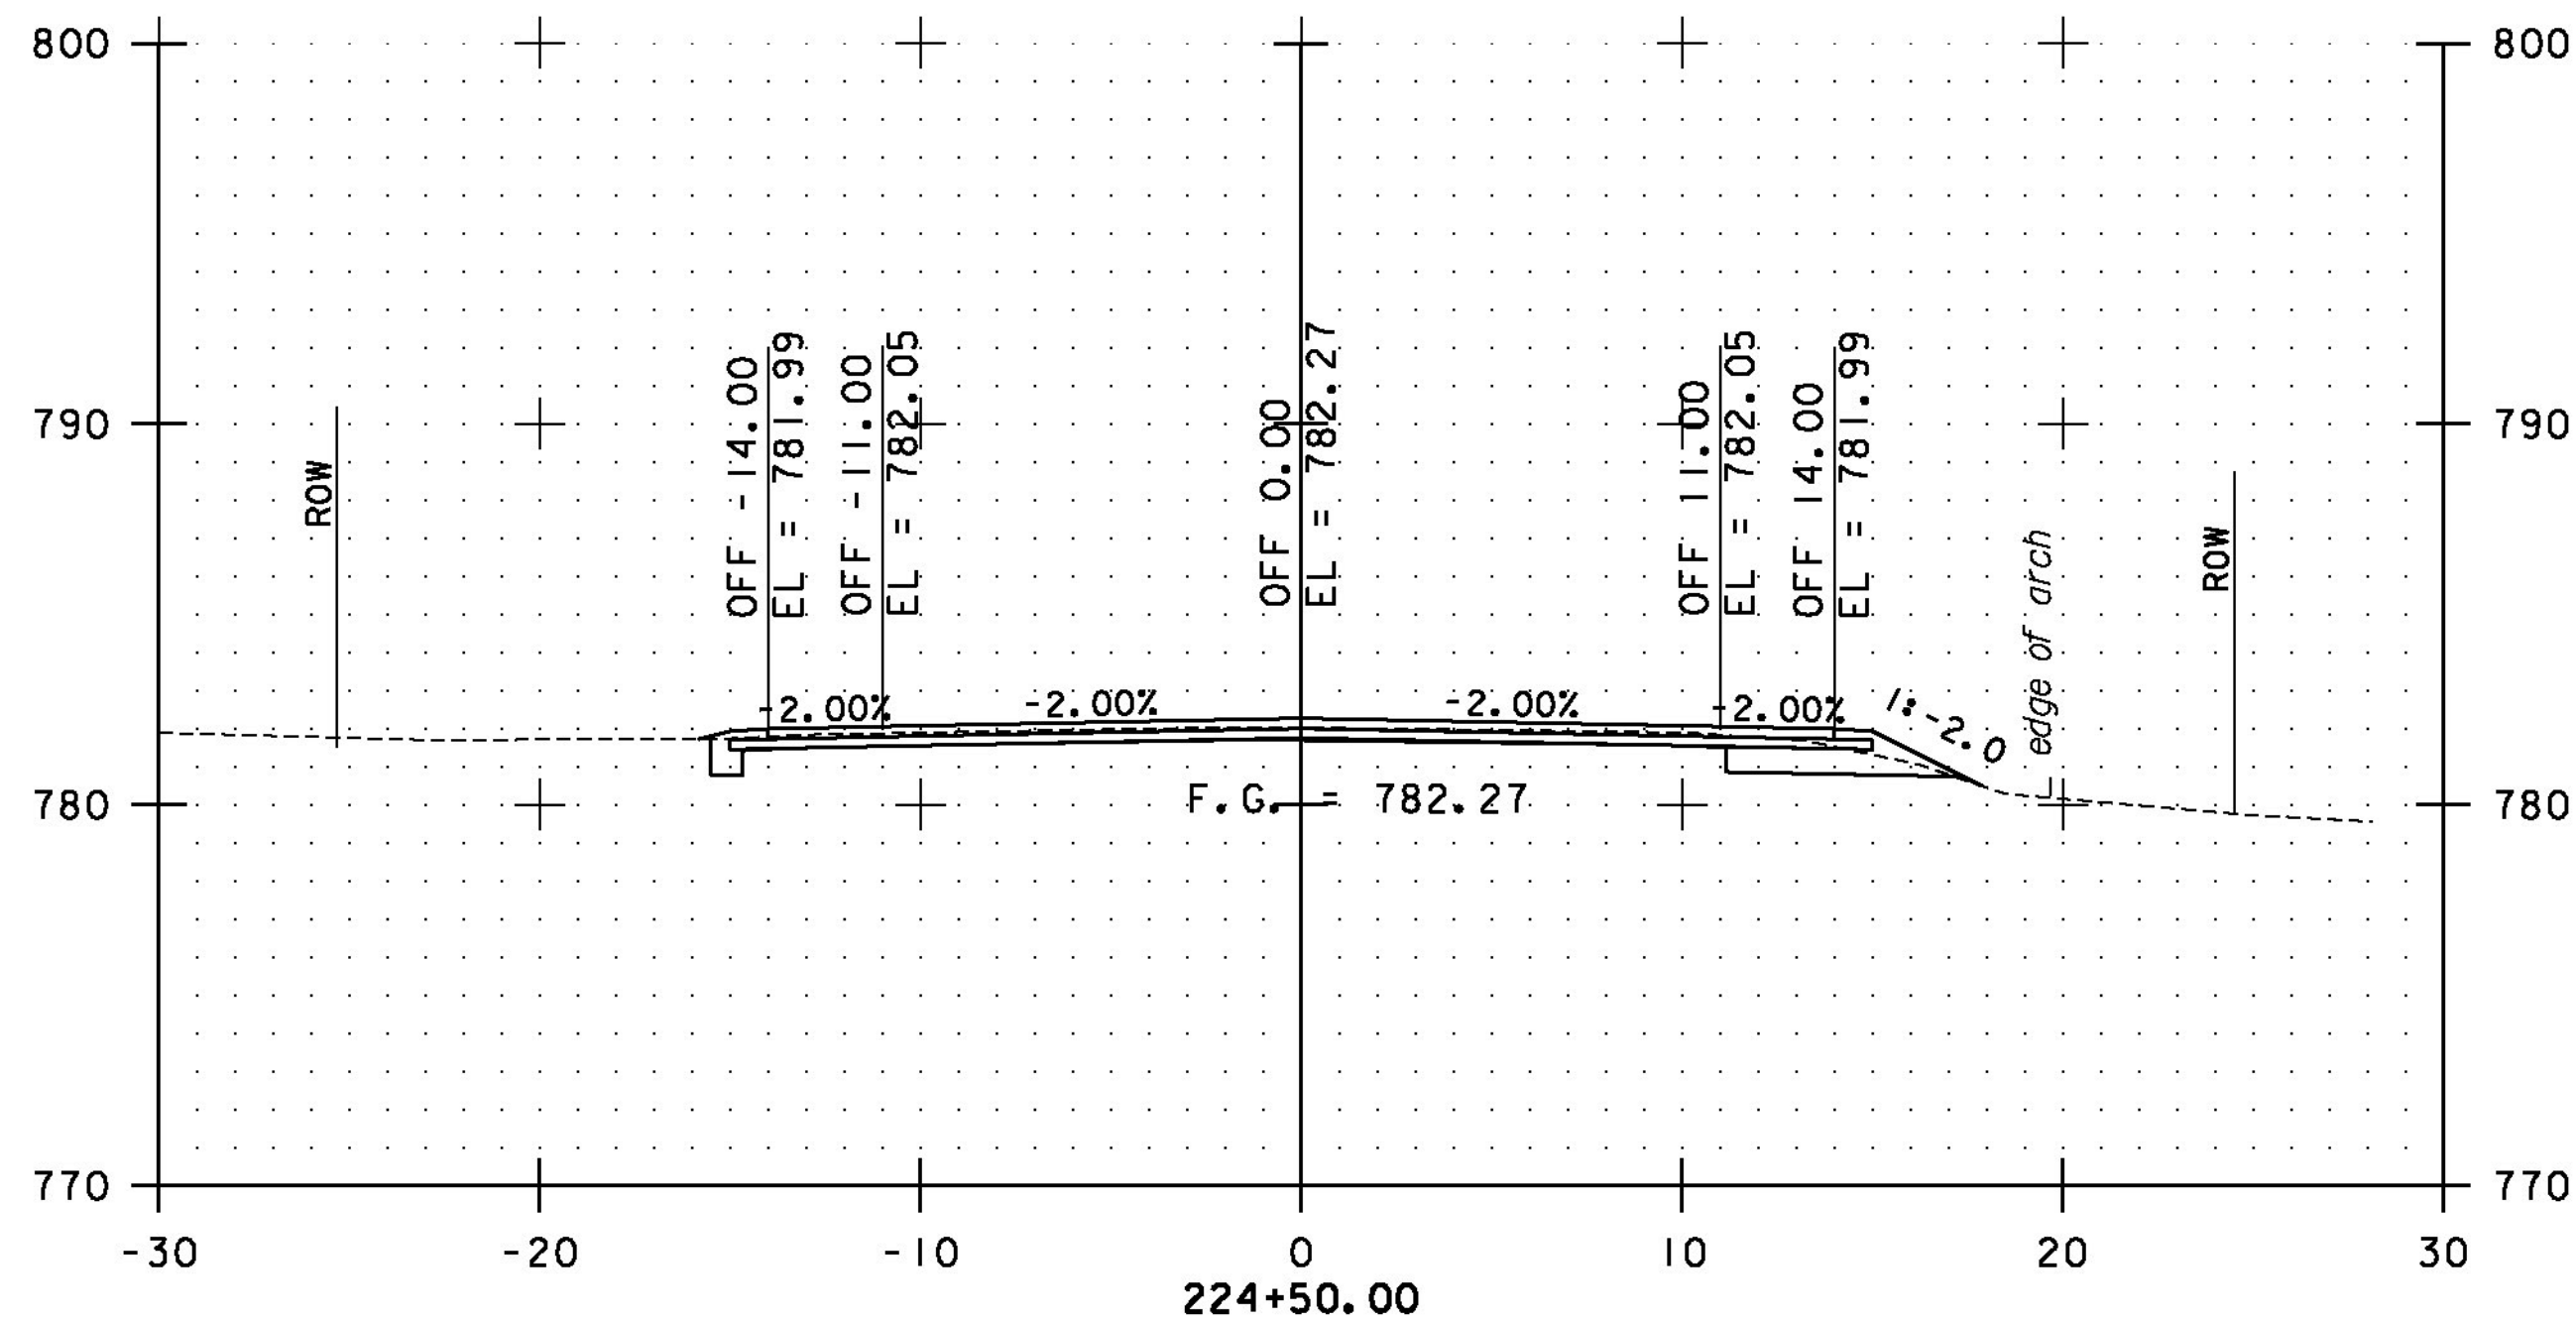
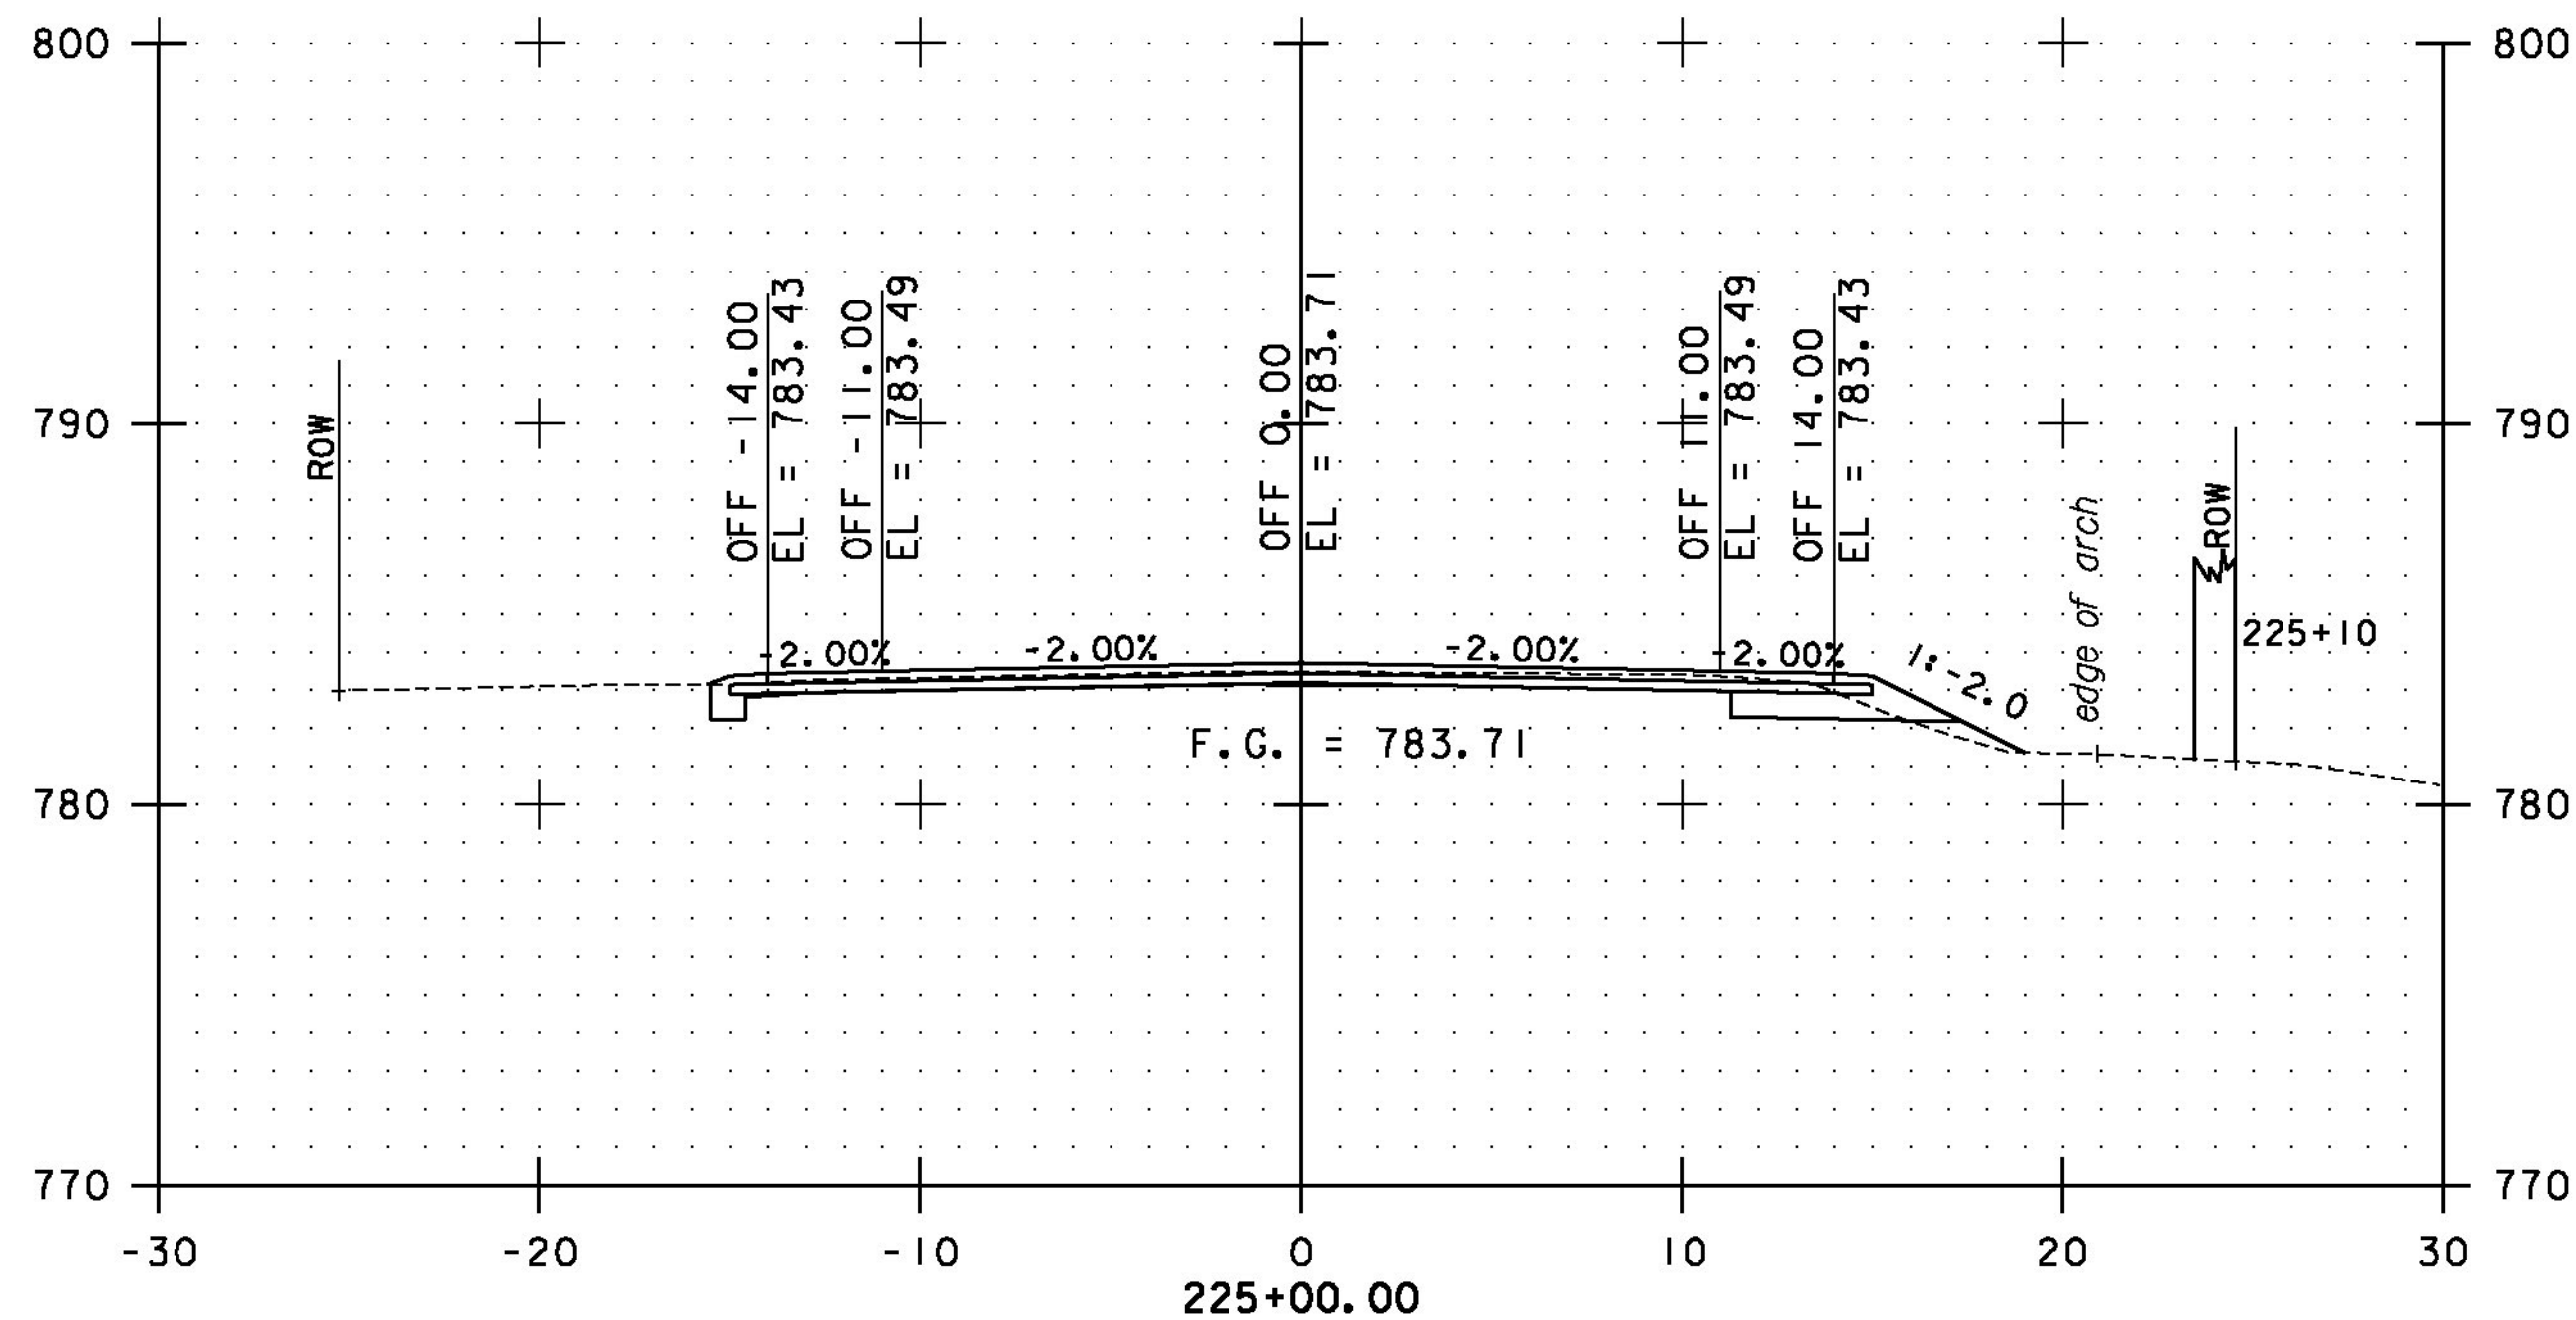
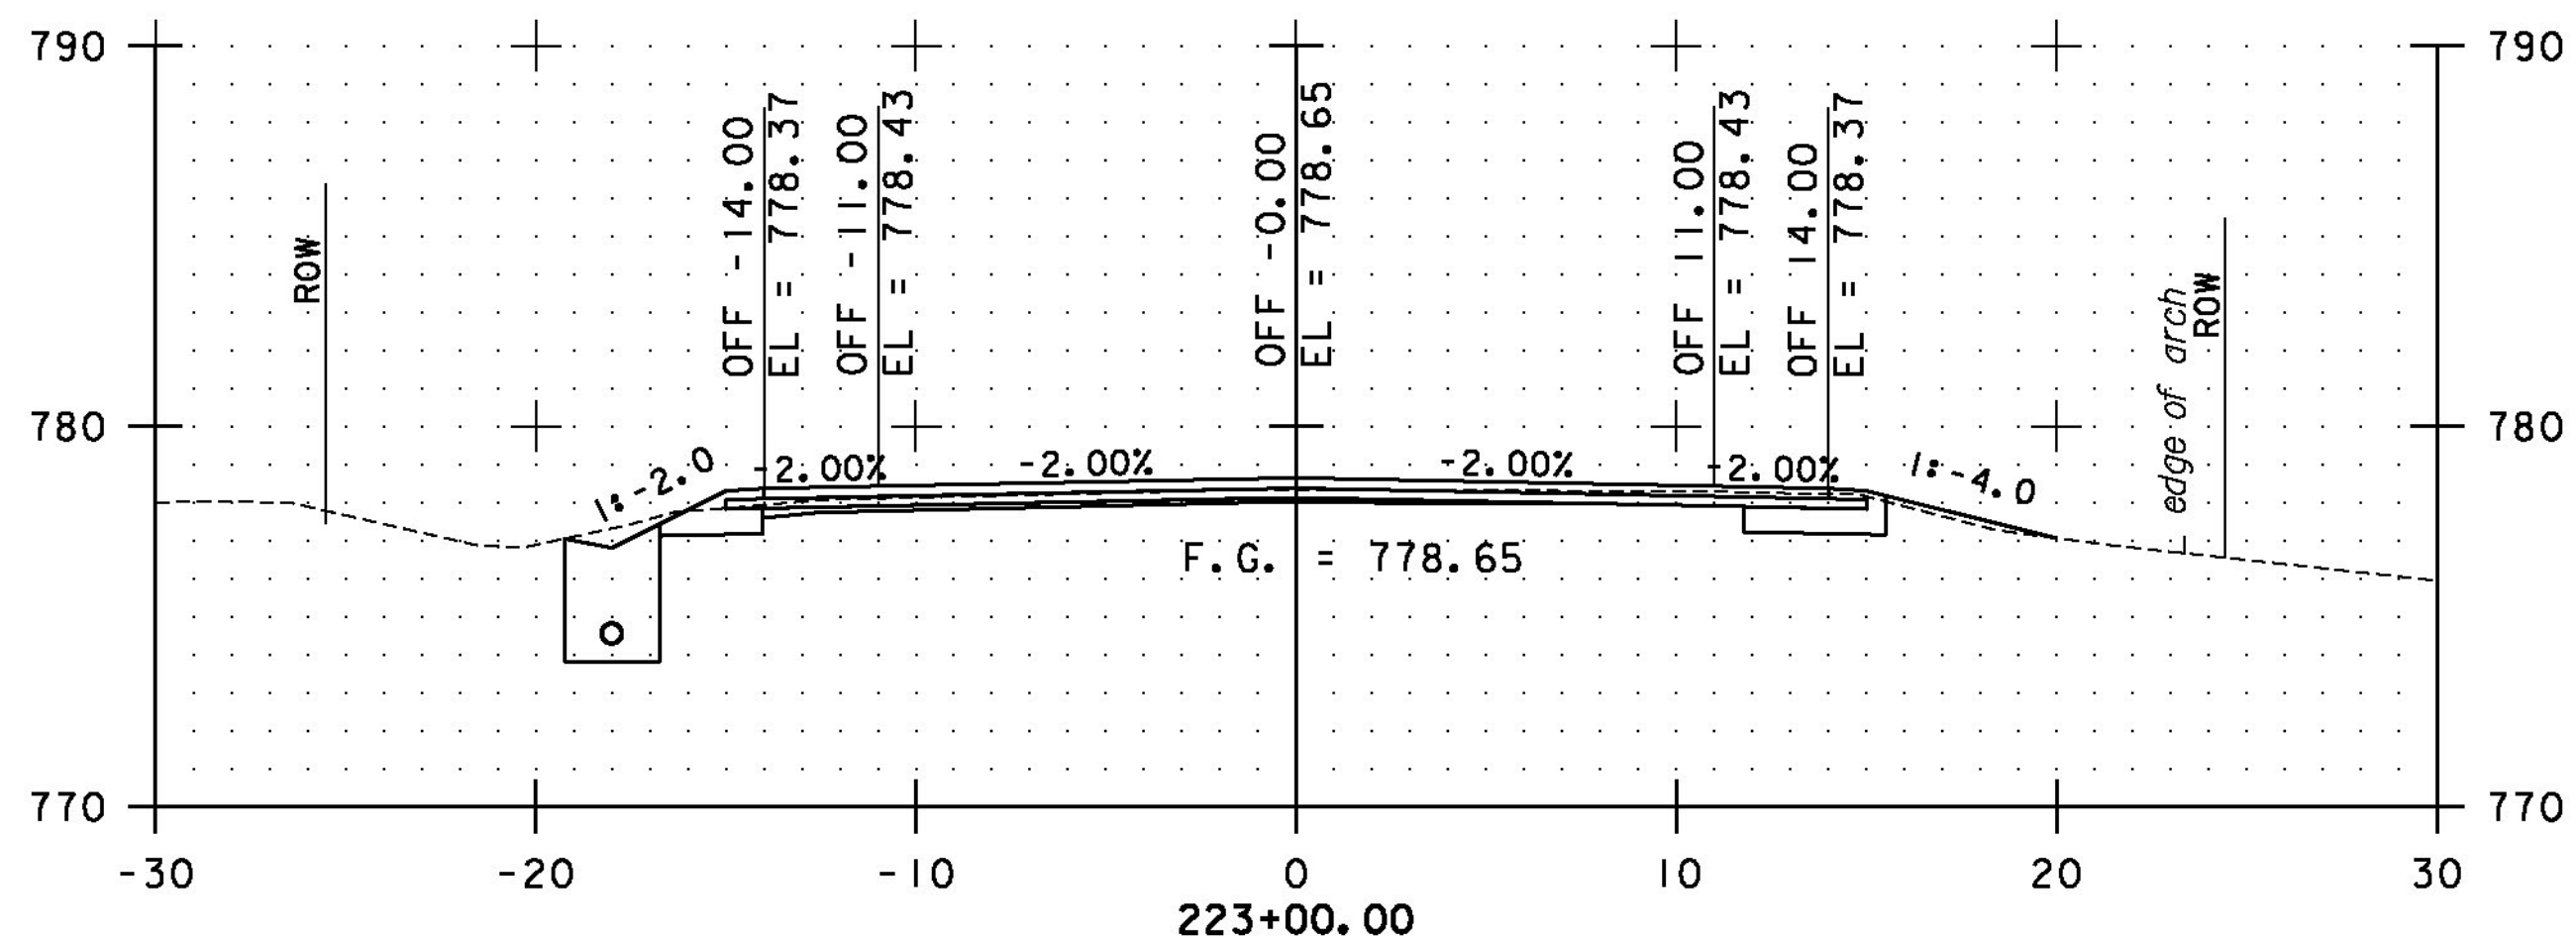


*FOR ADDITIONAL DRIVE INFORMATION, SEE DRIVE CROSS SECTIONS ON SHEETS 470 TO 540 OF 545.

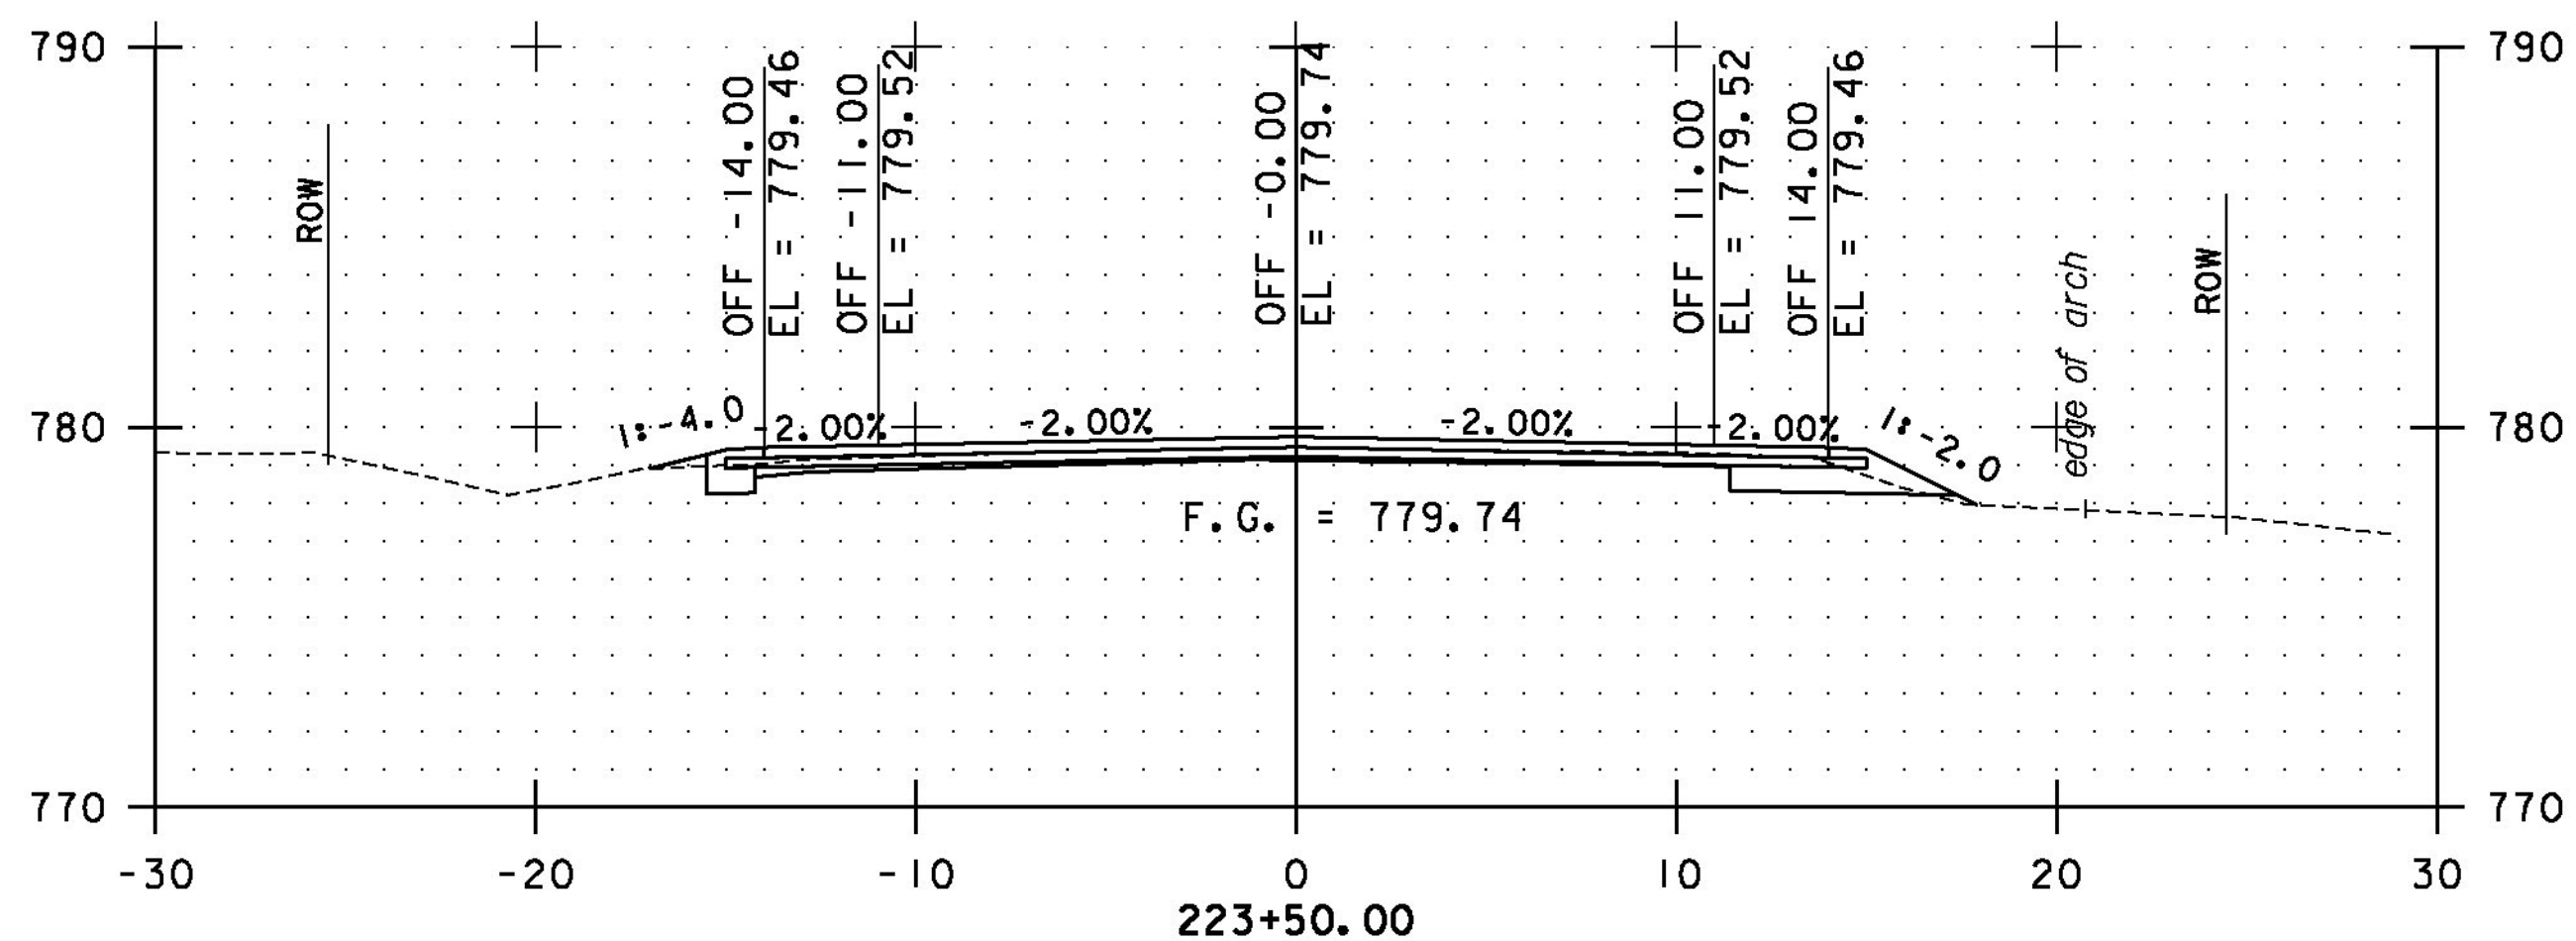

STA. 223+00 TO STA. 225+00

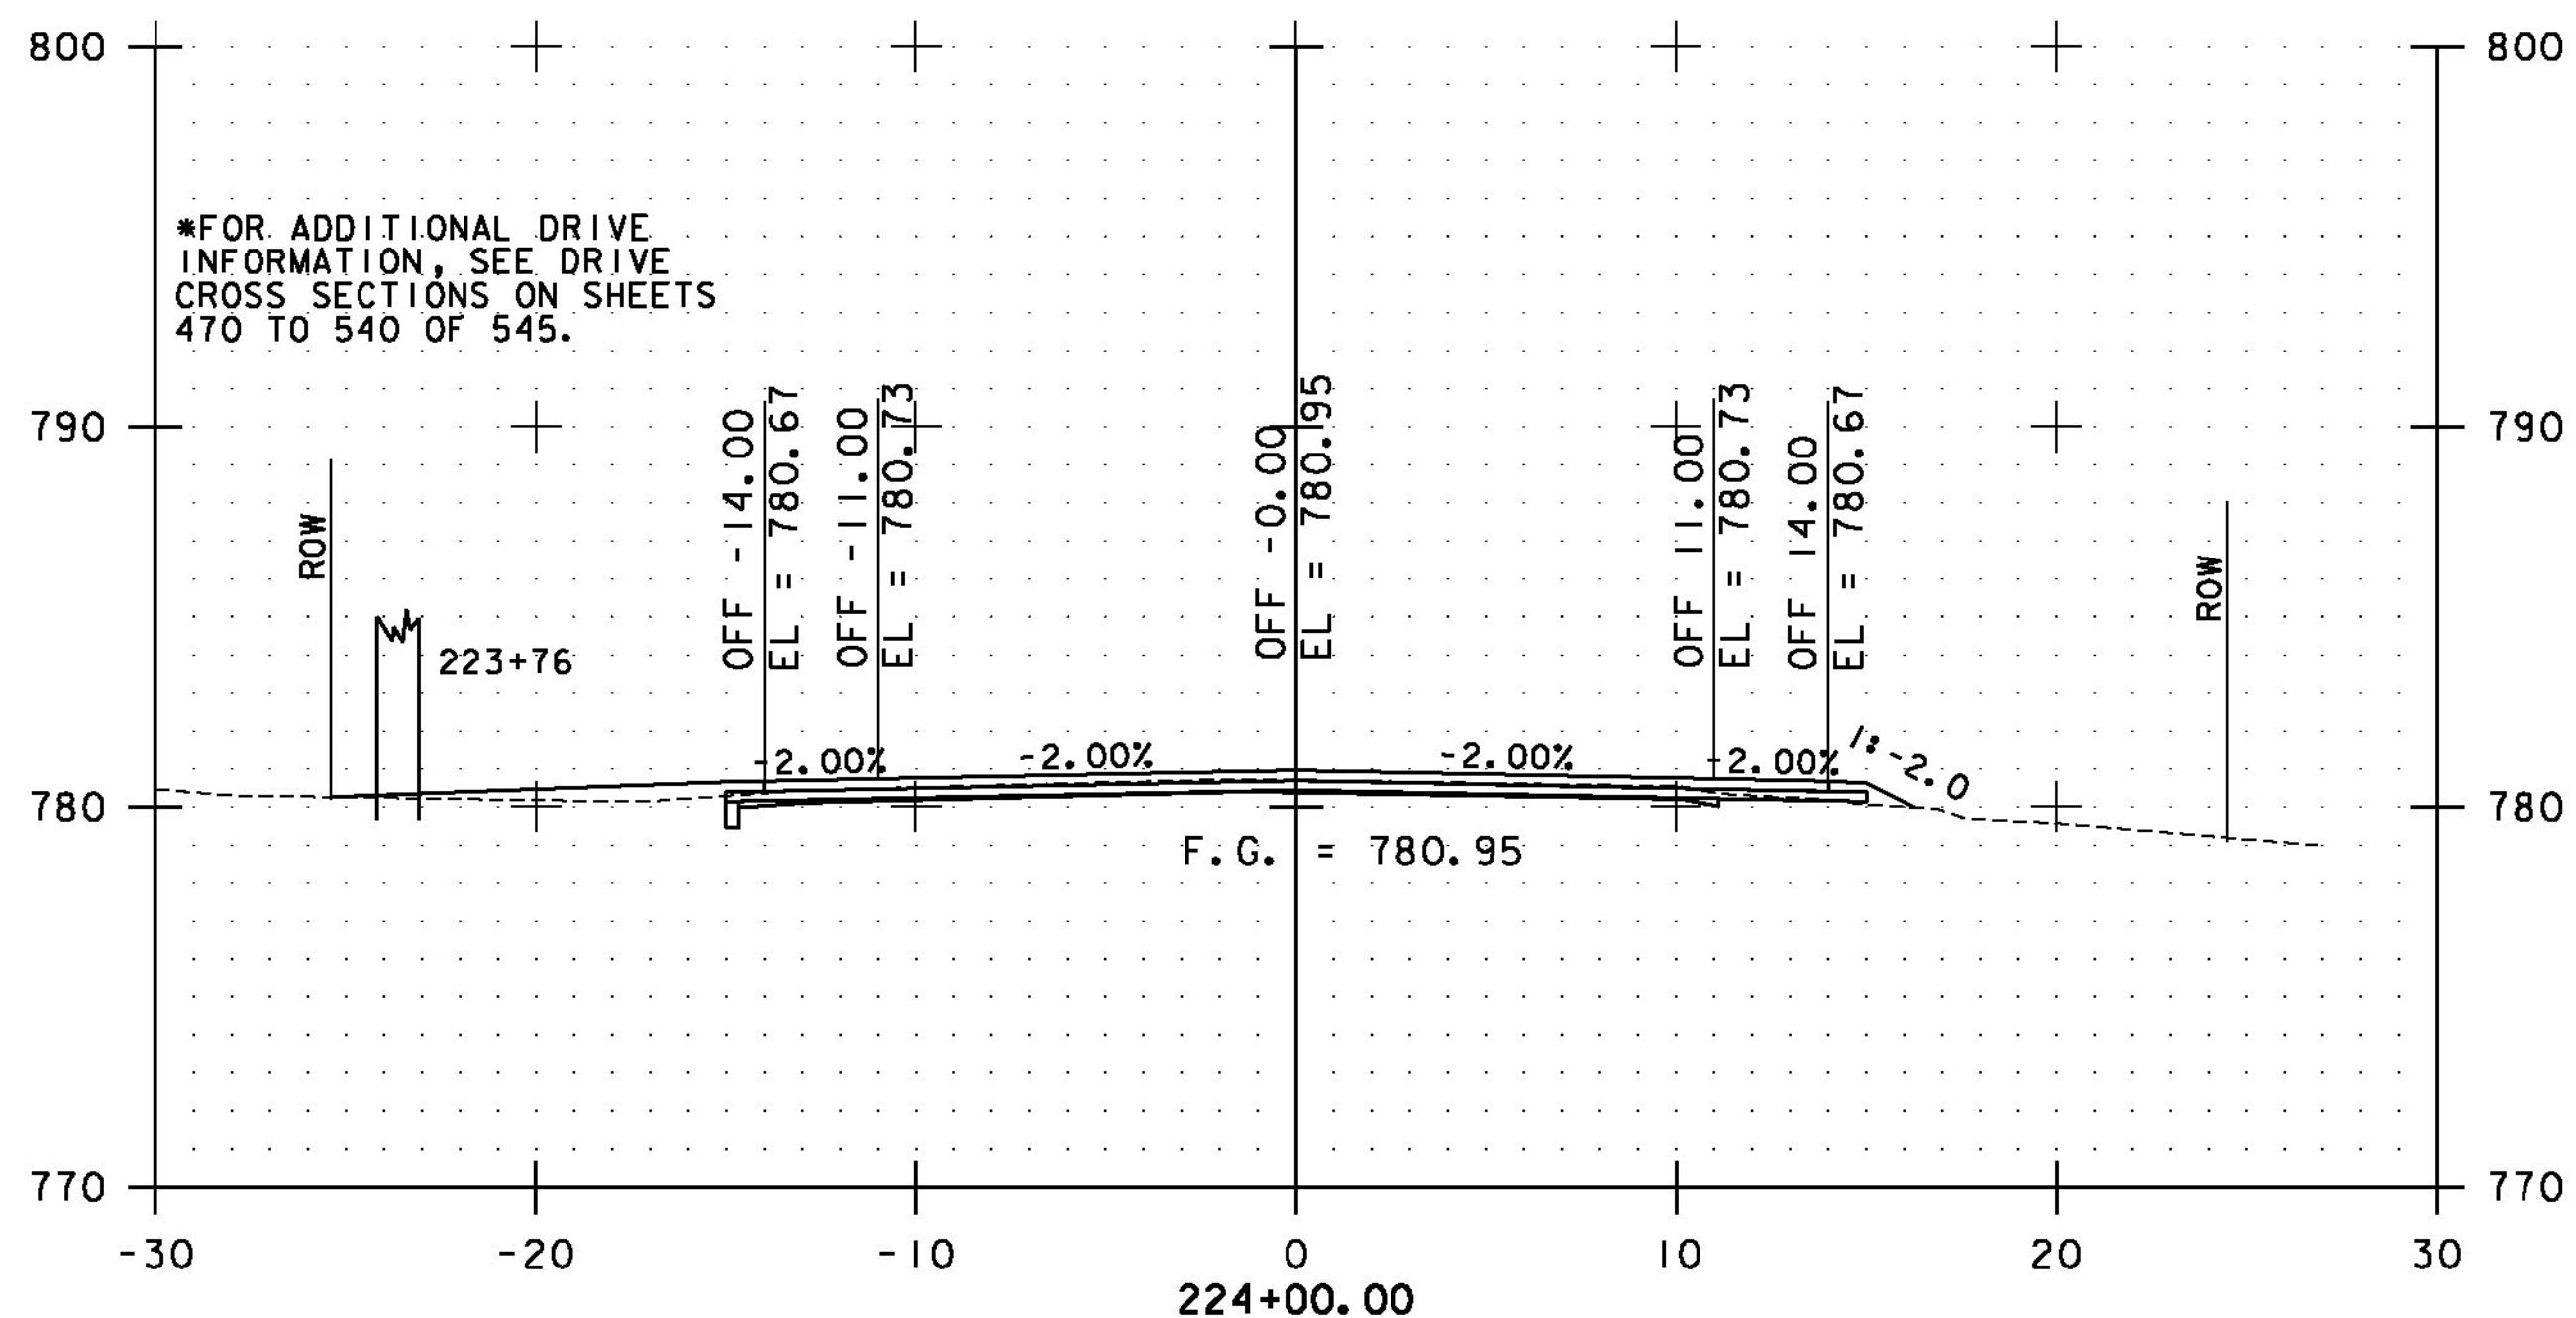

PROJECT NAME: RANDOLPH-ROXBURY	PLOT DATE: 11/17/2014
PROJECT NUMBER: ER STP 0187(II)	DRAWN BY: G. BURGMEIER
FILE NAME: z13ci82xs.dgn	DESIGNED BY: I. MAYNARD
PROJECT LEADER: M. FOISY	CHECKED BY: M. FOISY
BRAINTREE CROSS SECTIONS SHEET 104 SHEET 333 OF 545	