



\*FOR ADDITIONAL DRIVE INFORMATION, SEE DRIVE CROSS SECTIONS ON SHEETS 470 TO 540 OF 545.

STA. 253+50 TO STA. 255+00

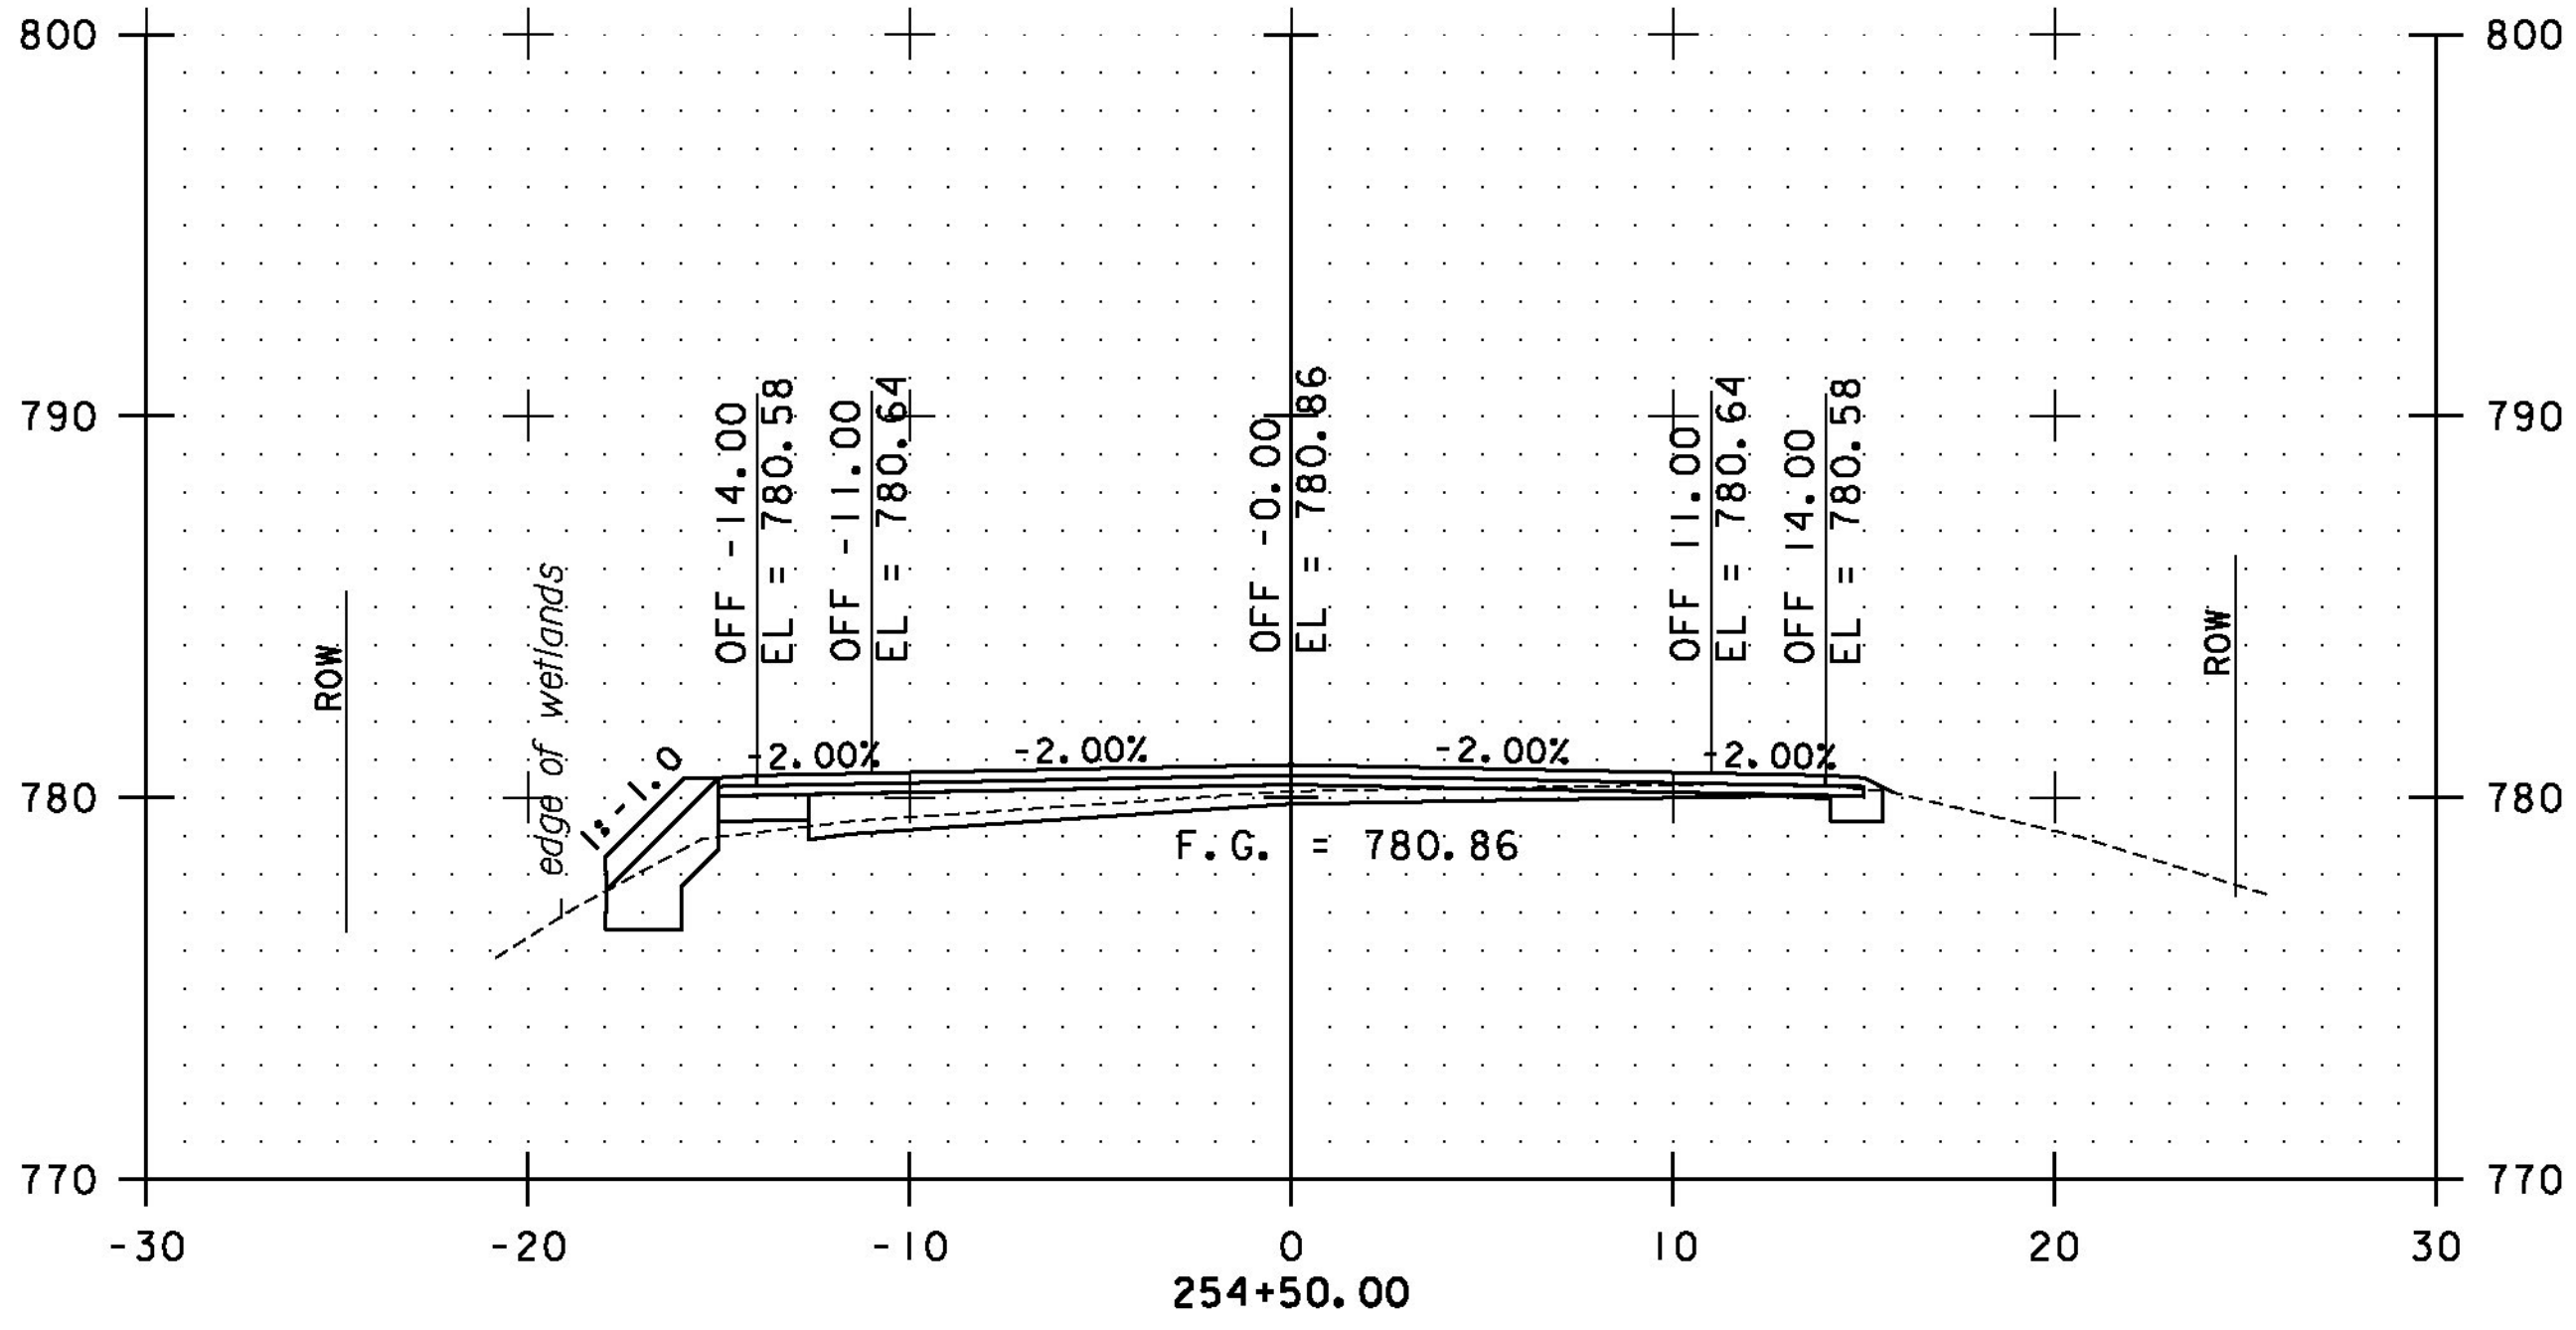

PROJECT NAME: RANDOLPH-ROXBURY	
PROJECT NUMBER: ER STP 0187(II)	
FILE NAME: z13ci82xs.dgn	PLOT DATE: 11/17/2014
PROJECT LEADER: M. FOISY	DRAWN BY: G. BURGMEIER
DESIGNED BY: I. MAYNARD	CHECKED BY: M. FOISY
<b>BRAINTREE CROSS SECTIONS SHEET 116</b>	
SHEET 345 OF 545	

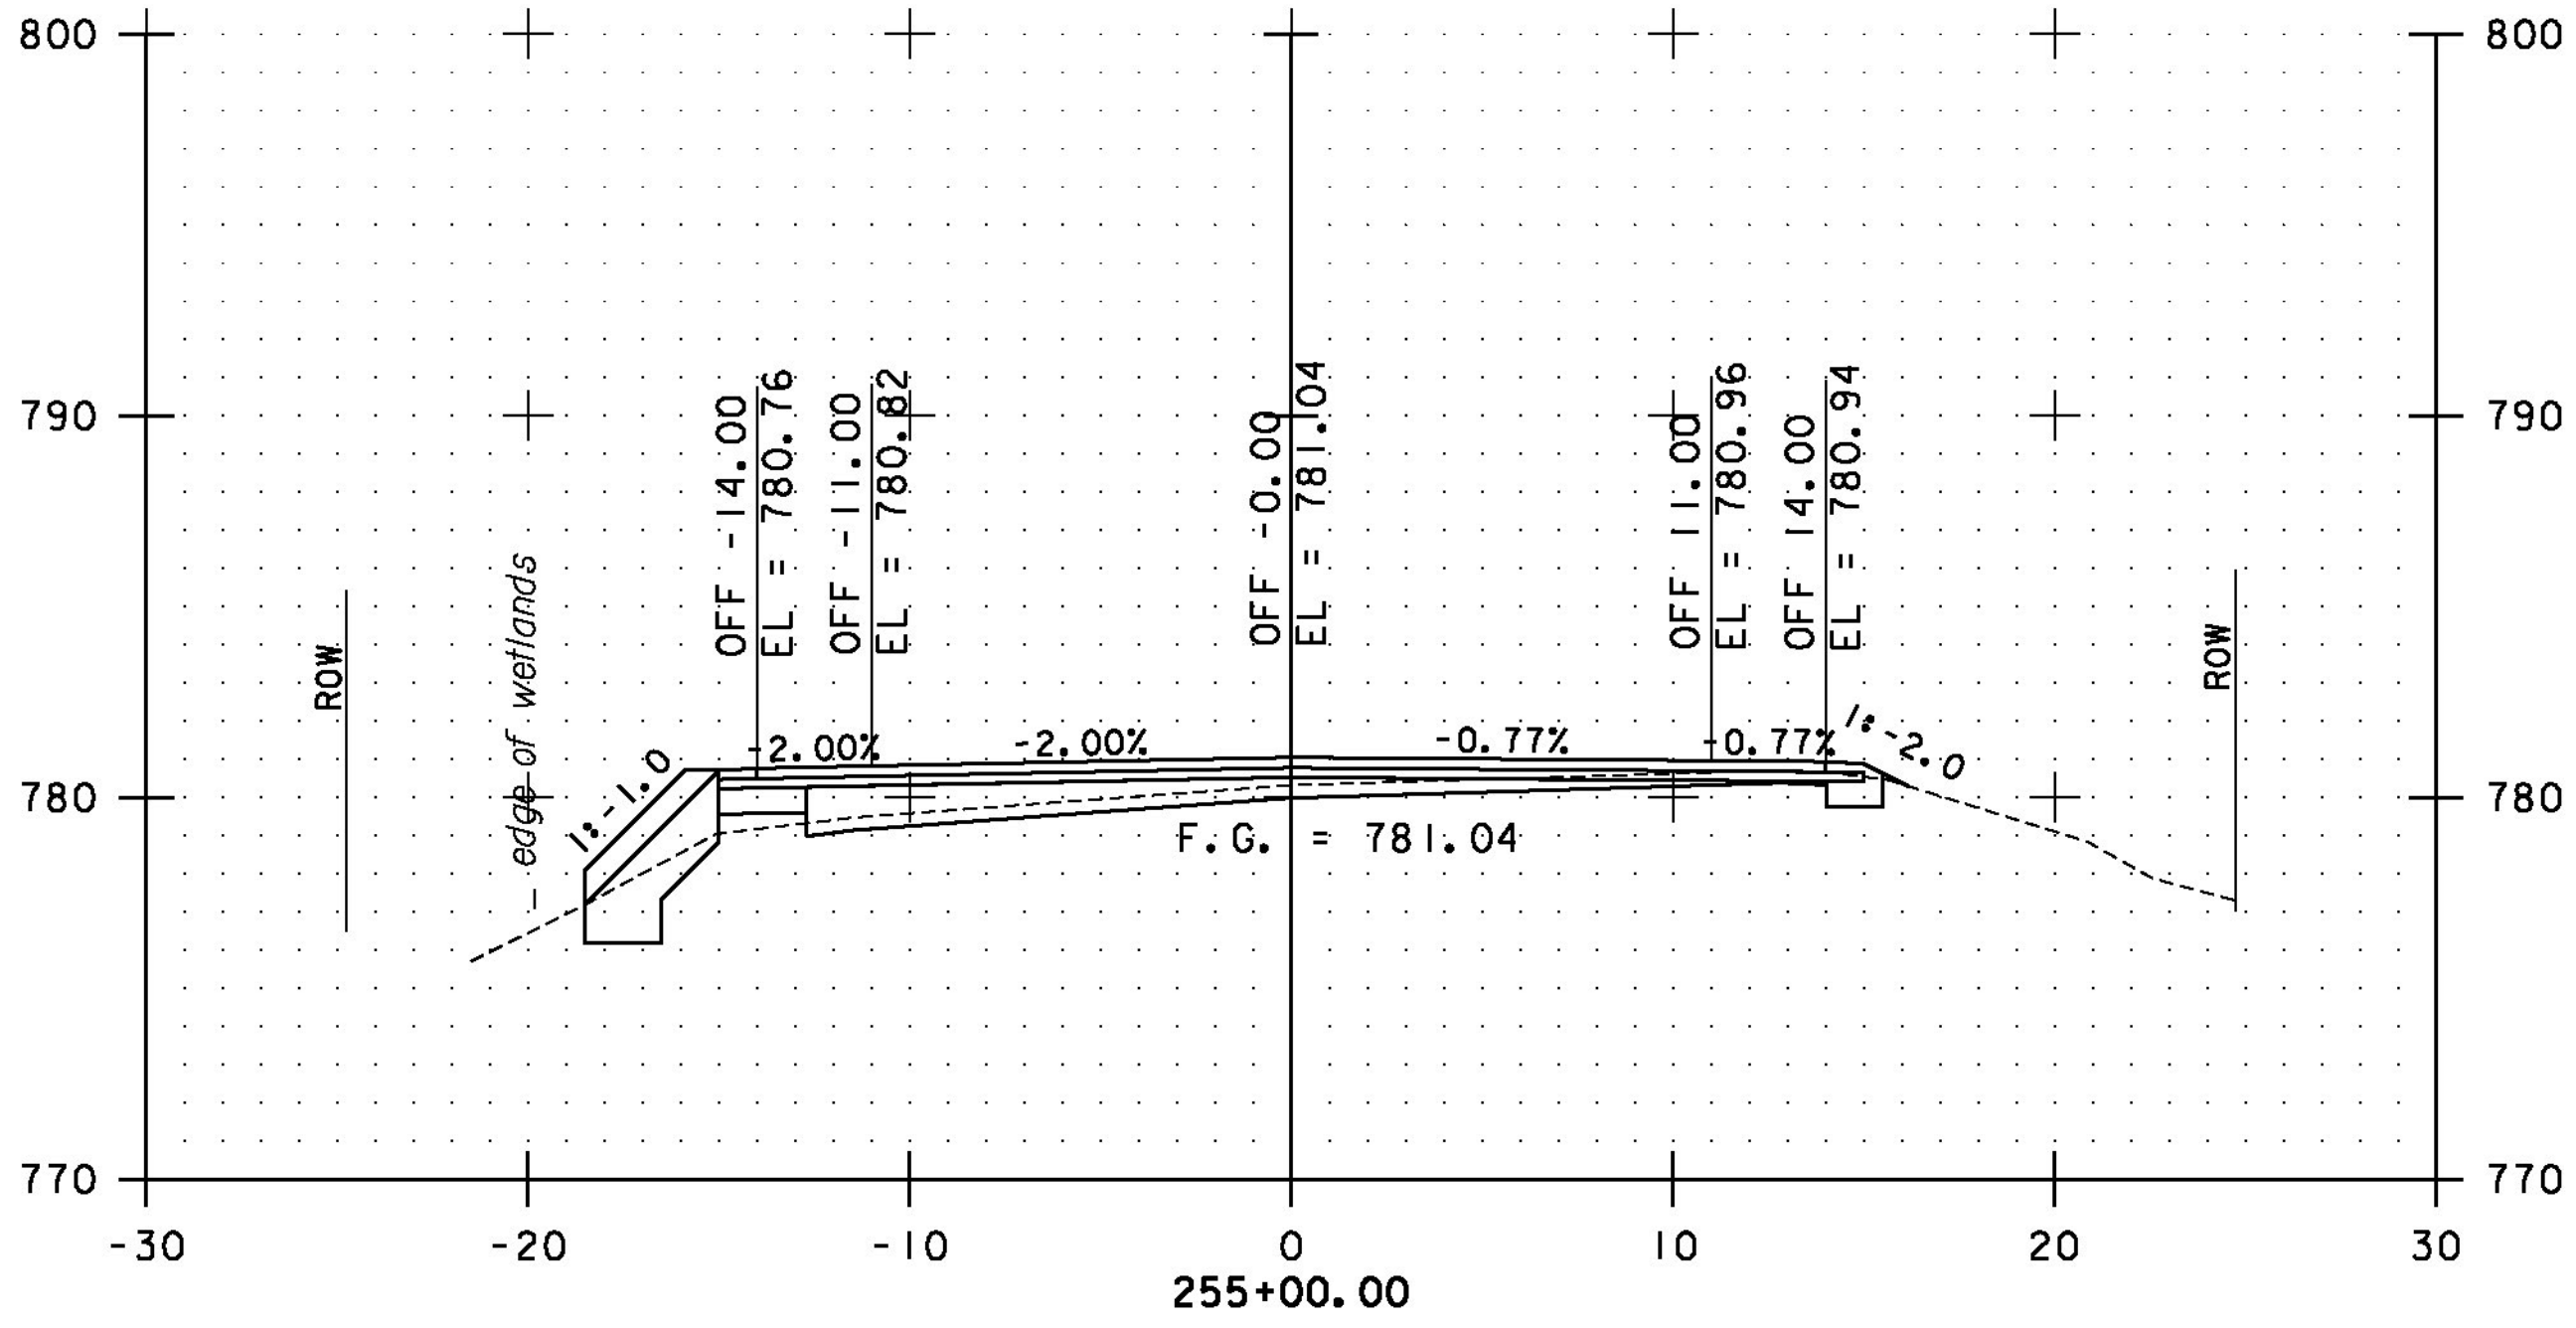