


STATE OF VERMONT AGENCY OF TRANSPORTATION

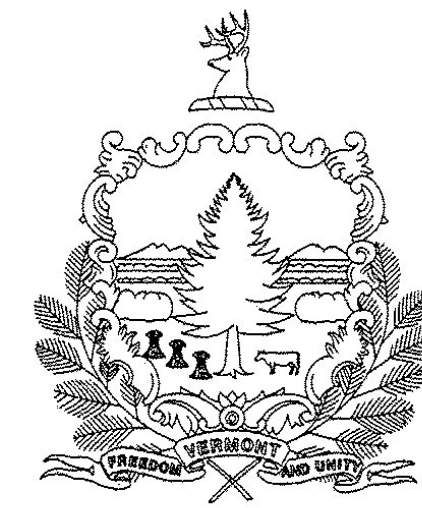


Record Plans
 Contractor: PIKE INDUSTRIES, INC.
 Resident Engineer: CHRIS BARKER
 Construction Began: OCTOBER 12, 2016
 Construction Complete: JULY 3, 2018
 Record Plans By: CHRIS BARKER & JESSE IVES

I hereby certify that all construction required by this set of drawings has been accomplished as indicated herein.

BY:  E-SIGNED by Christopher Barker on 2019-02-19 13:57:56 UTC Resident Engineer

Date: February 19, 2019

NOTE: Any further information concerning final quantities, amounts or other details relative to this project may be found at Central Files in the electronic archives.

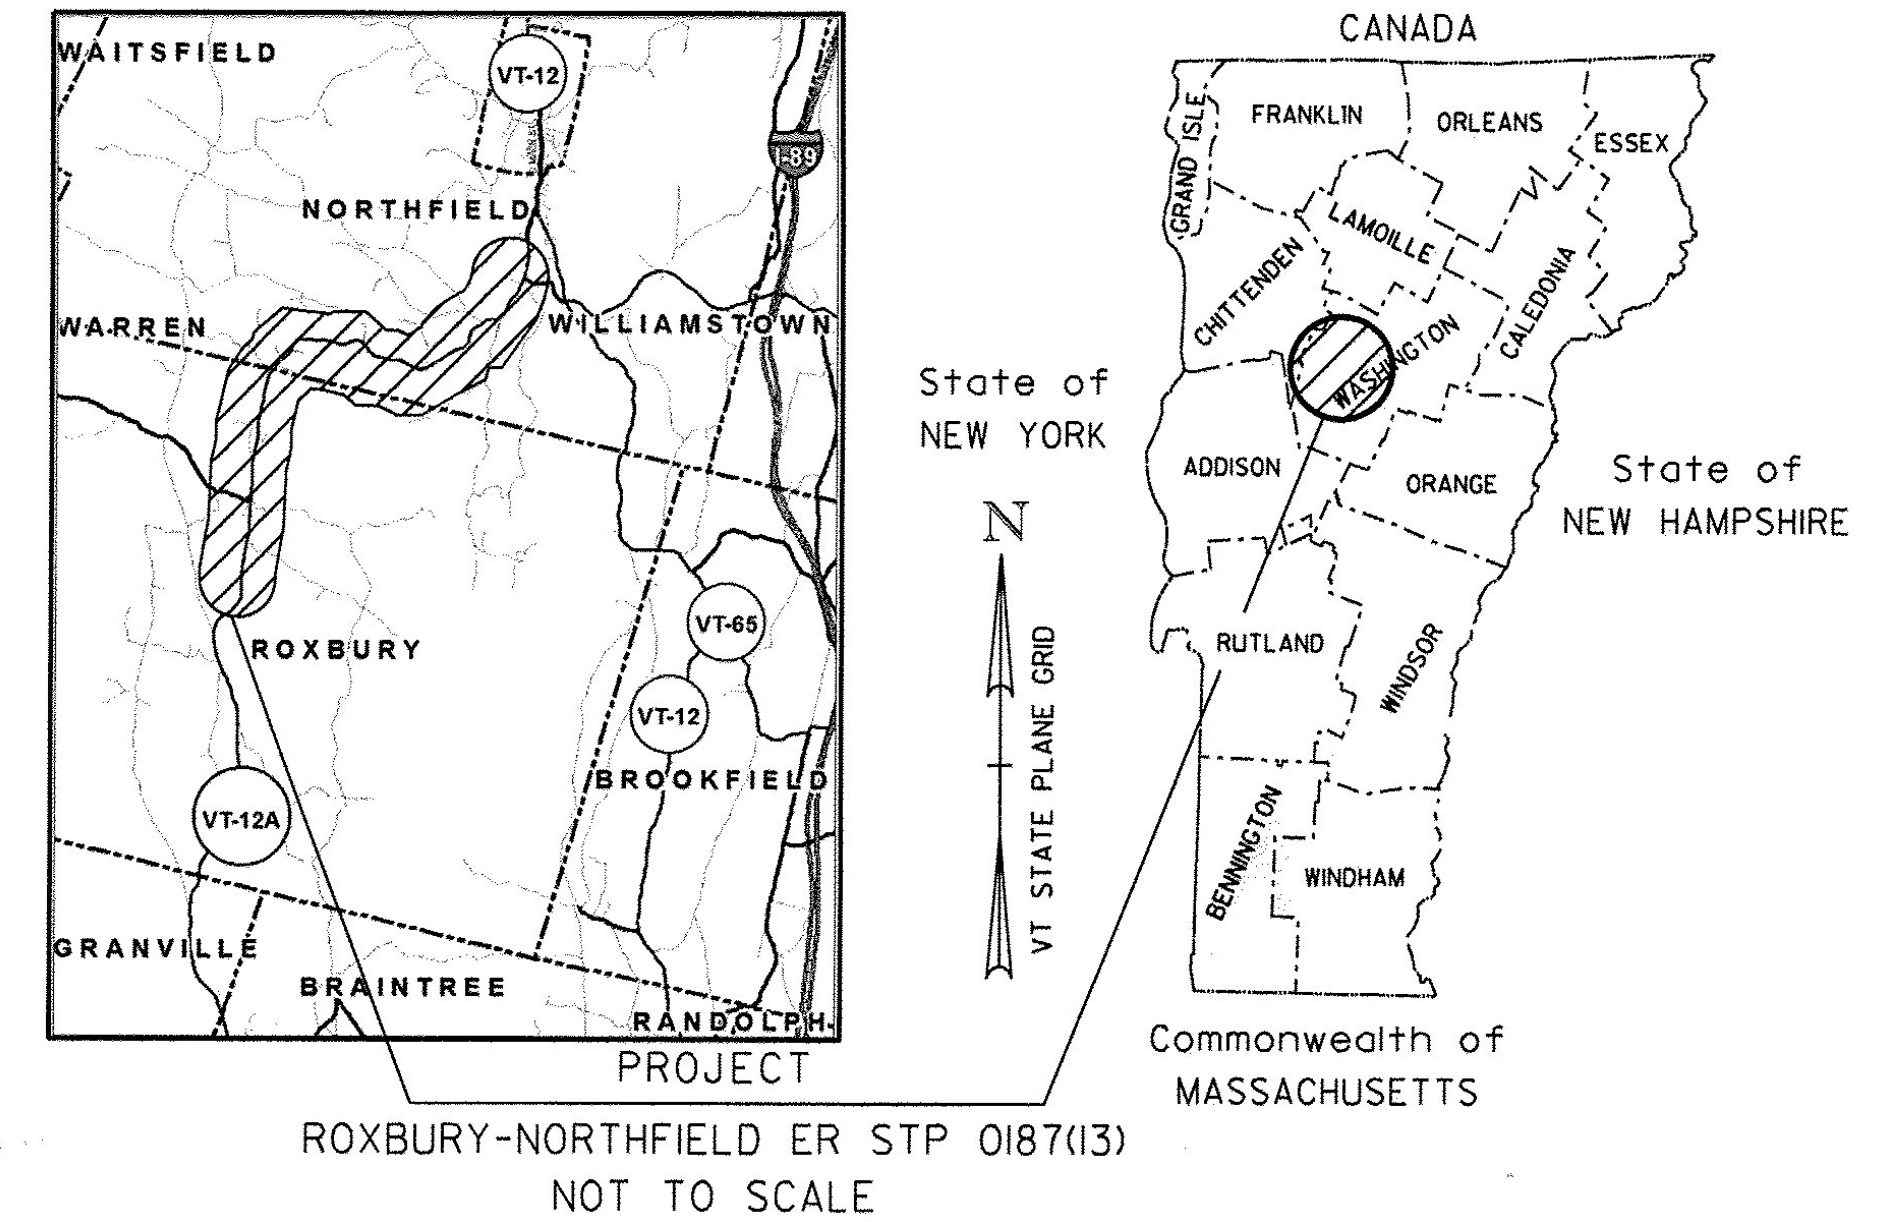


PROPOSED IMPROVEMENT TOWNS OF ROXBURY & NORTHFIELD COUNTY OF WASHINGTON VT ROUTE 12A (MAJOR COLLECTOR)

BEGINNING IN THE TOWN OF ROXBURY ON VT ROUTE 12A AT STA. 35+32.32 (MM 0.669) AND CONTINUING NORTHERLY AND ENDING IN THE TOWN OF NORTHFIELD AT THE NORTHFIELD VILLAGE LINE AT STA. 215+29.88 (MM 4.078).



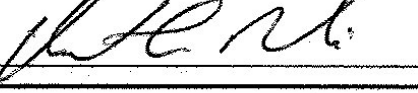
WORK TO BE PERFORMED UNDER THIS PROJECT INCLUDES COLD PLANING, RECLAIMING AND RESURFACING OF THE EXISTING HIGHWAY WITH A RECLAIMED STABILIZED BASE, COLD MIXED RECYCLED PAVEMENT, INTERMEDIATE AND WEARING COURSE, CORRECTING SUPERELEVATION DEFICIENCIES, NEW PAVEMENT MARKINGS, GUARDRAIL, SIGNS, RAILROAD CROSSINGS, AND DRAINAGE IMPROVEMENTS AND OTHER HIGHWAY RELATED ITEMS.

TOWN OF ROXBURY	LENGTH (FEET)	LENGTH (MILES)	TOWN OF NORTHFIELD	LENGTH (FEET)	LENGTH (MILES)	TOTAL LENGTH OF PROJECT:		
VT ROUTE 12A STA. 35+32.32 TO STA. 327+77.95 MM 0.669 TO MM 6.208	29,245.63	5.539	VT ROUTE 12A STA. 0+00.00 TO STA. 215+29.88 MM 0.000 TO MM 4.078	21,529.88	4.078	TOTAL LENGTH OF PROJECT:	50,775.51	9.617
						TOTAL LENGTH OF ROADWAY:	50,775.51	9.617

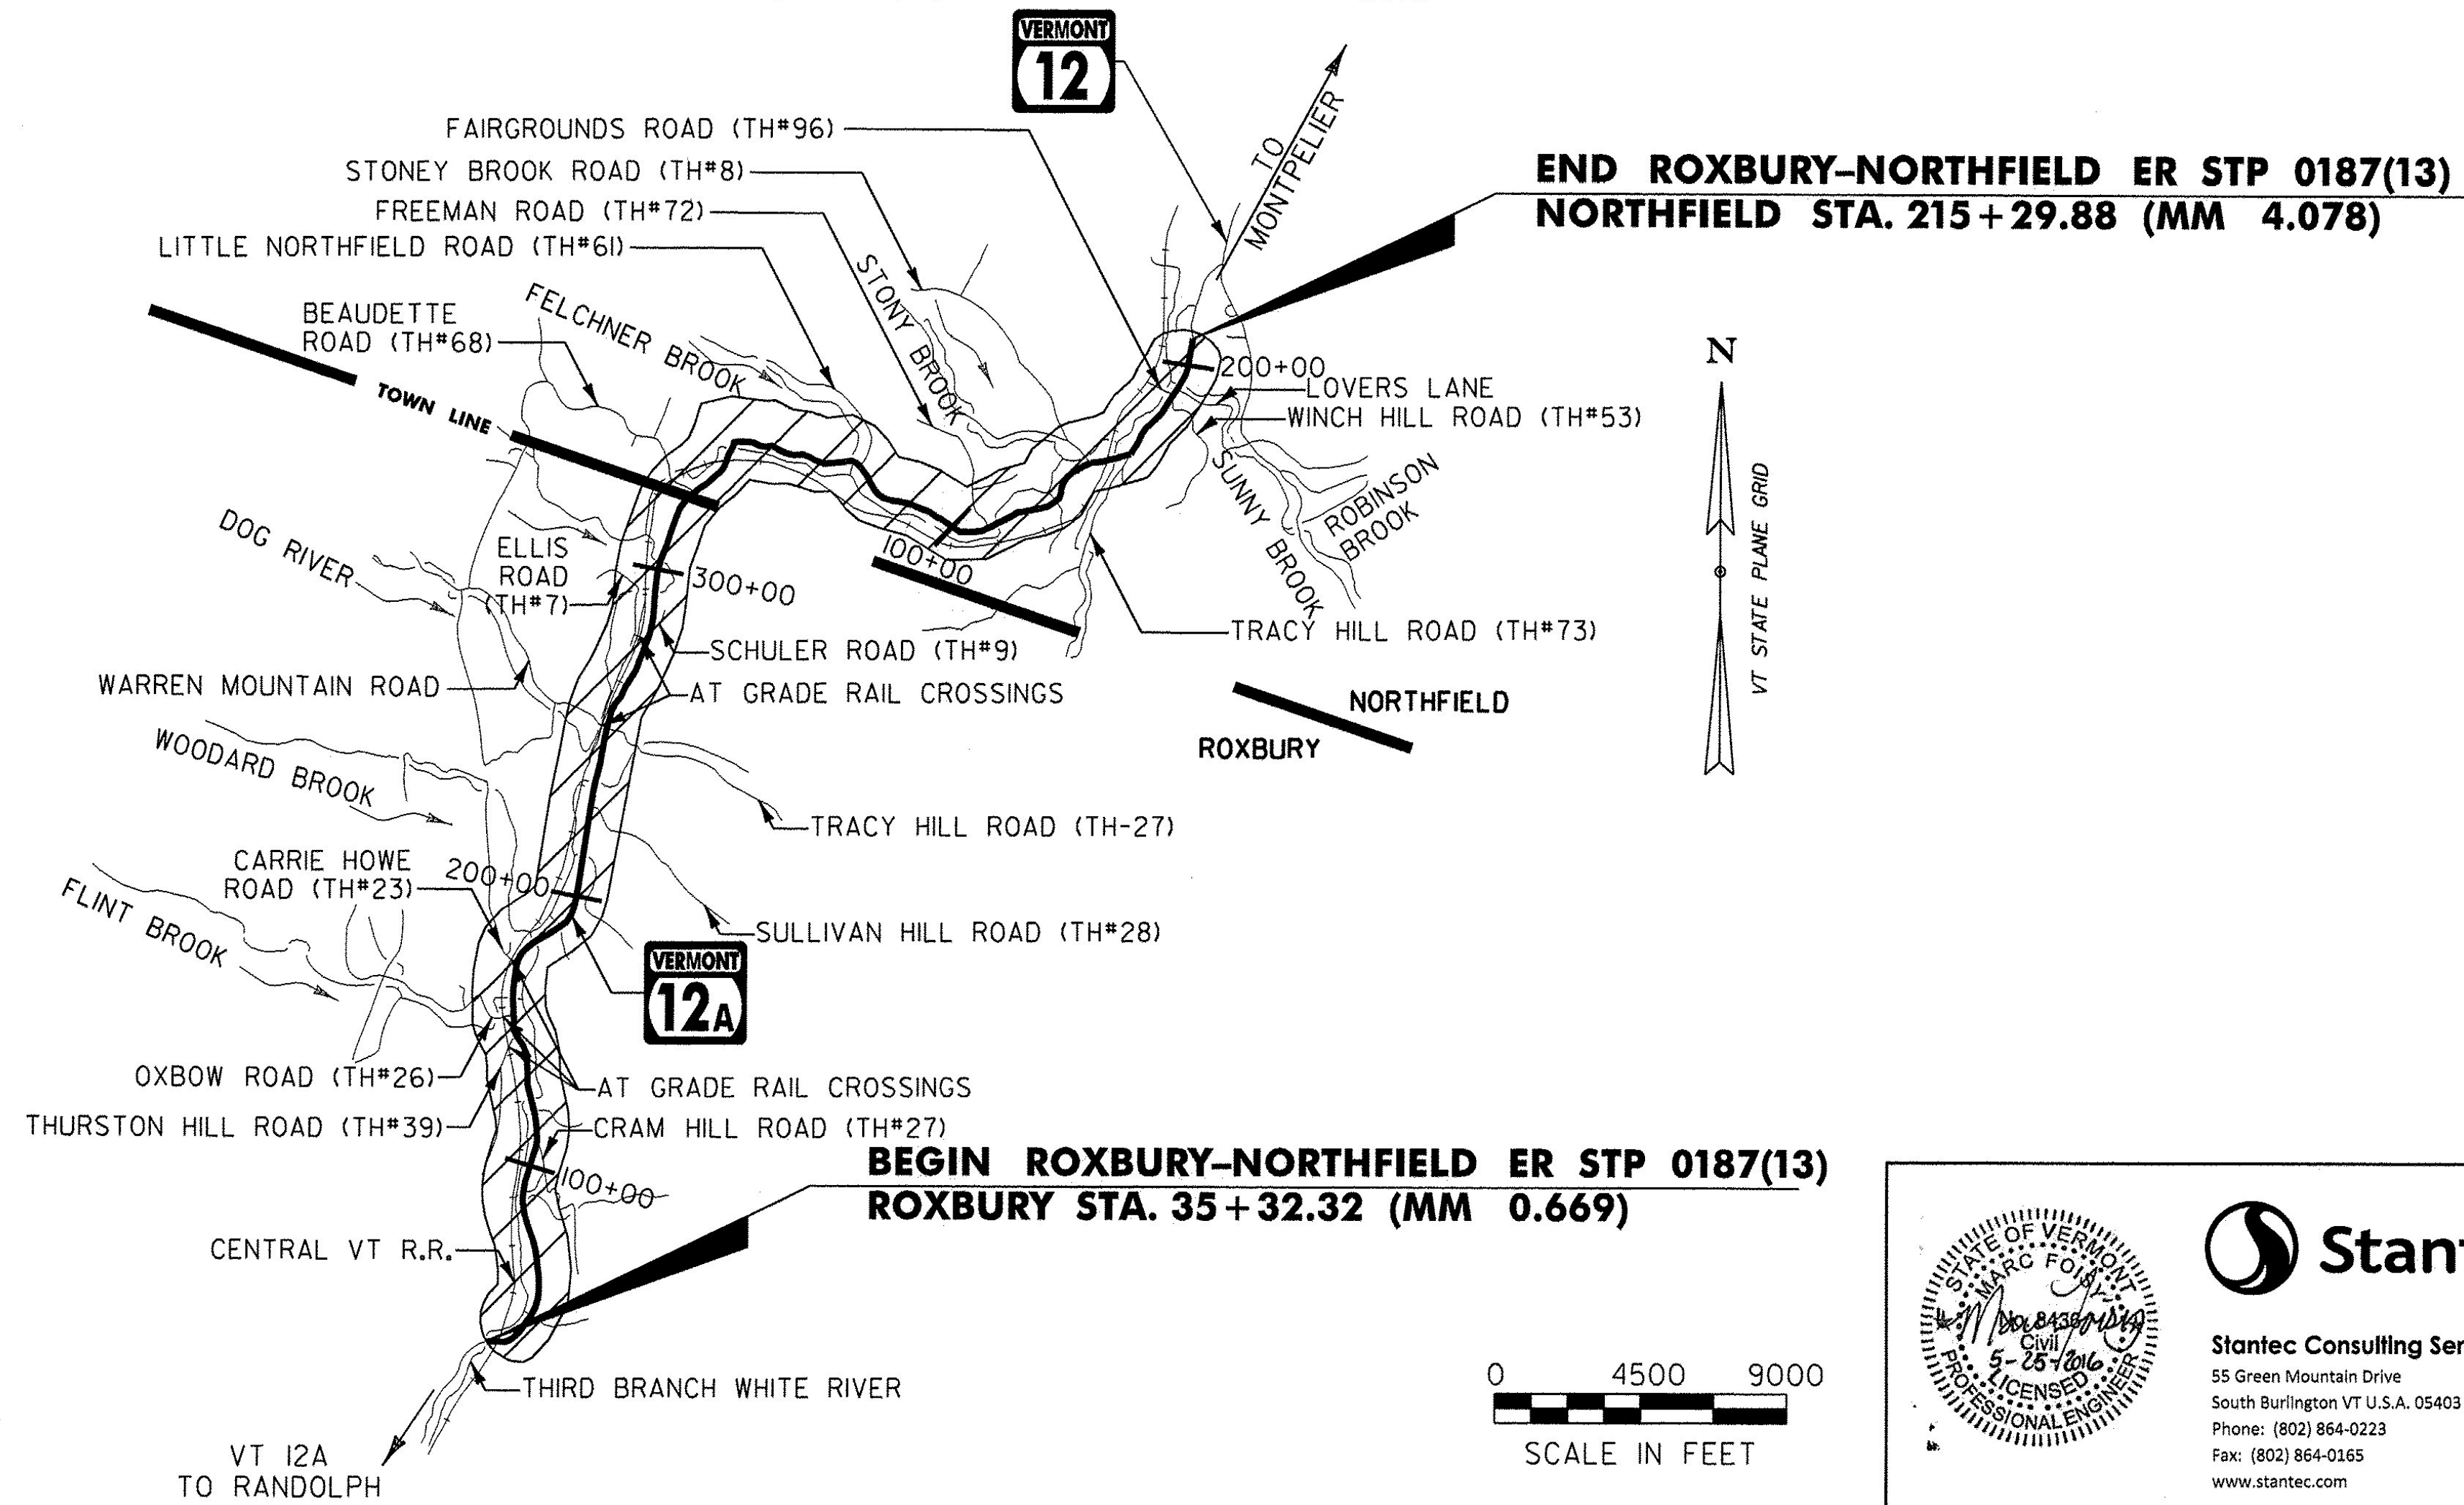

CONSTRUCTION IS TO BE CARRIED ON IN ACCORDANCE WITH THESE PLANS AND THE STANDARD SPECIFICATIONS FOR CONSTRUCTION DATED 2011, AS APPROVED BY THE FEDERAL HIGHWAY ADMINISTRATION ON JULY 20, 2011 FOR USE ON THIS PROJECT, INCLUDING ALL SUBSEQUENT REVISIONS AND SUCH REVISED SPECIFICATIONS AND SPECIAL PROVISIONS AS ARE INCORPORATED IN THESE PLANS.

QUALITY ASSURANCE PROGRAM : LEVEL 2
SURVEYED BY : VERMONT SURVEY & ENGINEERING
SURVEYED DATE : 2012
DATUM
VERTICAL NAVD 88
HORIZONTAL NAD 83(2011)

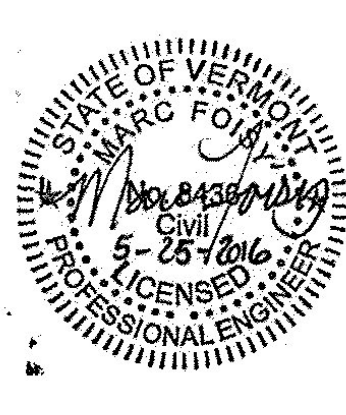	 Stantec Consulting Services Inc. 55 Green Mountain Drive South Burlington VT U.S.A. 05403 Phone: (802) 864-0223 Fax: (802) 864-0165 www.stantec.com	DIRECTOR OF PROJECT DELIVERY
		APPROVED:  DATE: 4/9/2016
		PROJECT MANAGER : MICHAEL J. FOWLER, P.E.
		PROJECT NAME : ROXBURY-NORTHFIELD PROJECT NUMBER : ER STP 0187(13)
SCALE IN FEET 0 4500 9000		SHEET 1 OF 476 SHEETS