

RECLAIM TYPICAL SECTION (SEGMENT 2)


ROXBURY STA. 262+00 - 327+78 (TOWN LINE) NORTHFIELD STA. 0+00 - 18+10 (BR#30 APPROACH)
 STA. 22+32 - 98+50 (UNDERCUT AREA) STA. 108+50 - 116+08 (BR#32 APPROACH) 116+43
 118+53 STA. 118+80 - 159+53 (BR#35 APPROACH) 160+00
 161+50 STA. 162+11 - 190+77 (BR#36 APPROACH) 191+82
 STA. 193+34 - 214+17.38 (END PROJECT) 192+72 215+00

FOG SEAL NOT USED ON THIS SEGMENT

RECLAIM TYPICAL SECTION (SEGMENT 2)

STEP	DESCRIPTION	PAYMENT ITEM(S)
1	REPLACE CULVERTS AS INDICATED ON CULVERT AND STRUCTURE INVENTORY SHEET. (SEE SHEET 30)	ITEM 204.20 TRENCH EXCAVATION OF EARTH ITEM 301.28 SUBBASE OF CRUSHED GRAVEL, FINE GRADED OPTION BB ITEMS 601.0216, 601.0416, OR 601.0915 OPTION CC ITEMS 601.0226, 601.0426, OR 601.0920 OPTION DD ITEMS 601.0816, OR 601.2615
2	COLD PLANE EXISTING BITUMINOUS CONCRETE PAVEMENT 4"	ITEM 210.10 COLD PLANING BITUMINOUS PAVEMENT
3	REPAIR EXISTING SHOULDERS AS DIRECTED BY THE ENGINEER	ITEM 301.28 SUBBASE OF CRUSHED GRAVEL, FINE GRADED
4	RECLAIM EXISTING ROAD BED AS SHOWN IN TYPICAL SECTION. (SEE NOTE 8 ON SHEET 4)	ITEM 900.675 SPECIAL PROVISION (RECLAIMED STABILIZED BASE)
5	CORRECT SUPERELEVATION DEFICIENCIES	ITEM 301.28 SUBBASE OF CRUSHED GRAVEL, FINE GRADED
6	RECLAIM ROAD BED 6" AND INJECT WITH EMULSION	ITEM 900.675 SPECIAL PROVISION (FULL DEPTH RECLAMATION, EMULSIFIED ASPHALT) ITEM 900.683 SPECIAL PROVISION (EMULSIFIED ASPHALT FOR FULL DEPTH RECLAMATION) ITEM 900.680 SPECIAL PROVISION (PORTLAND CEMENT FOR FULL DEPTH RECLAMATION, EMULSIFIED ASPHALT)
7	FOG SEAL SHALL BE APPLIED AFTER THE DAILY COMPLETION OF SPECIAL PROVISION (FDR, EMULSIFIED ASPHALT) AT A RATE OF 0.15 GAL/SY	ITEM 900.683 SPECIAL PROVISION (FOG SEAL SURFACE TREATMENT)
8	APPLY TACK COAT, THEN PLACE 1/2" TYPE IVS LEVELING COURSE	ITEM 404.65 EMULSIFIED ASPHALT OR 900.680 SPECIAL PROVISION (EMULSIFIED ASPHALT) (RS-IH OR CRS-IH) ITEM 490.30 SUPERPAVE BITUMINOUS CONCRETE PAVEMENT
9	APPLY TACK COAT, THEN PLACE 1/2" TYPE IVS WEARING COURSE	ITEM 404.65 EMULSIFIED ASPHALT OR 900.680 SPECIAL PROVISION (EMULSIFIED ASPHALT) (RS-IH OR CRS-IH) ITEM 490.30 SUPERPAVE BITUMINOUS CONCRETE PAVEMENT

NOTE: THIS LIST OF PROCEDURES FOR REHABILITATING THE EXISTING ROADBED ARE PRESENTED FOR INFORMATIONAL PURPOSES ONLY AND SHALL NOT BE CONSIDERED ALL INCLUSIVE. THE CONTRACTOR SHALL PREPARE THEIR OWN SCHEDULE OF OPERATIONS TO COMPLETE THE PROPOSED WORK UTILIZING THE APPROPRIATE PAY ITEMS AS SHOWN IN THE PLANS OR AS DIRECTED BY THE ENGINEER.

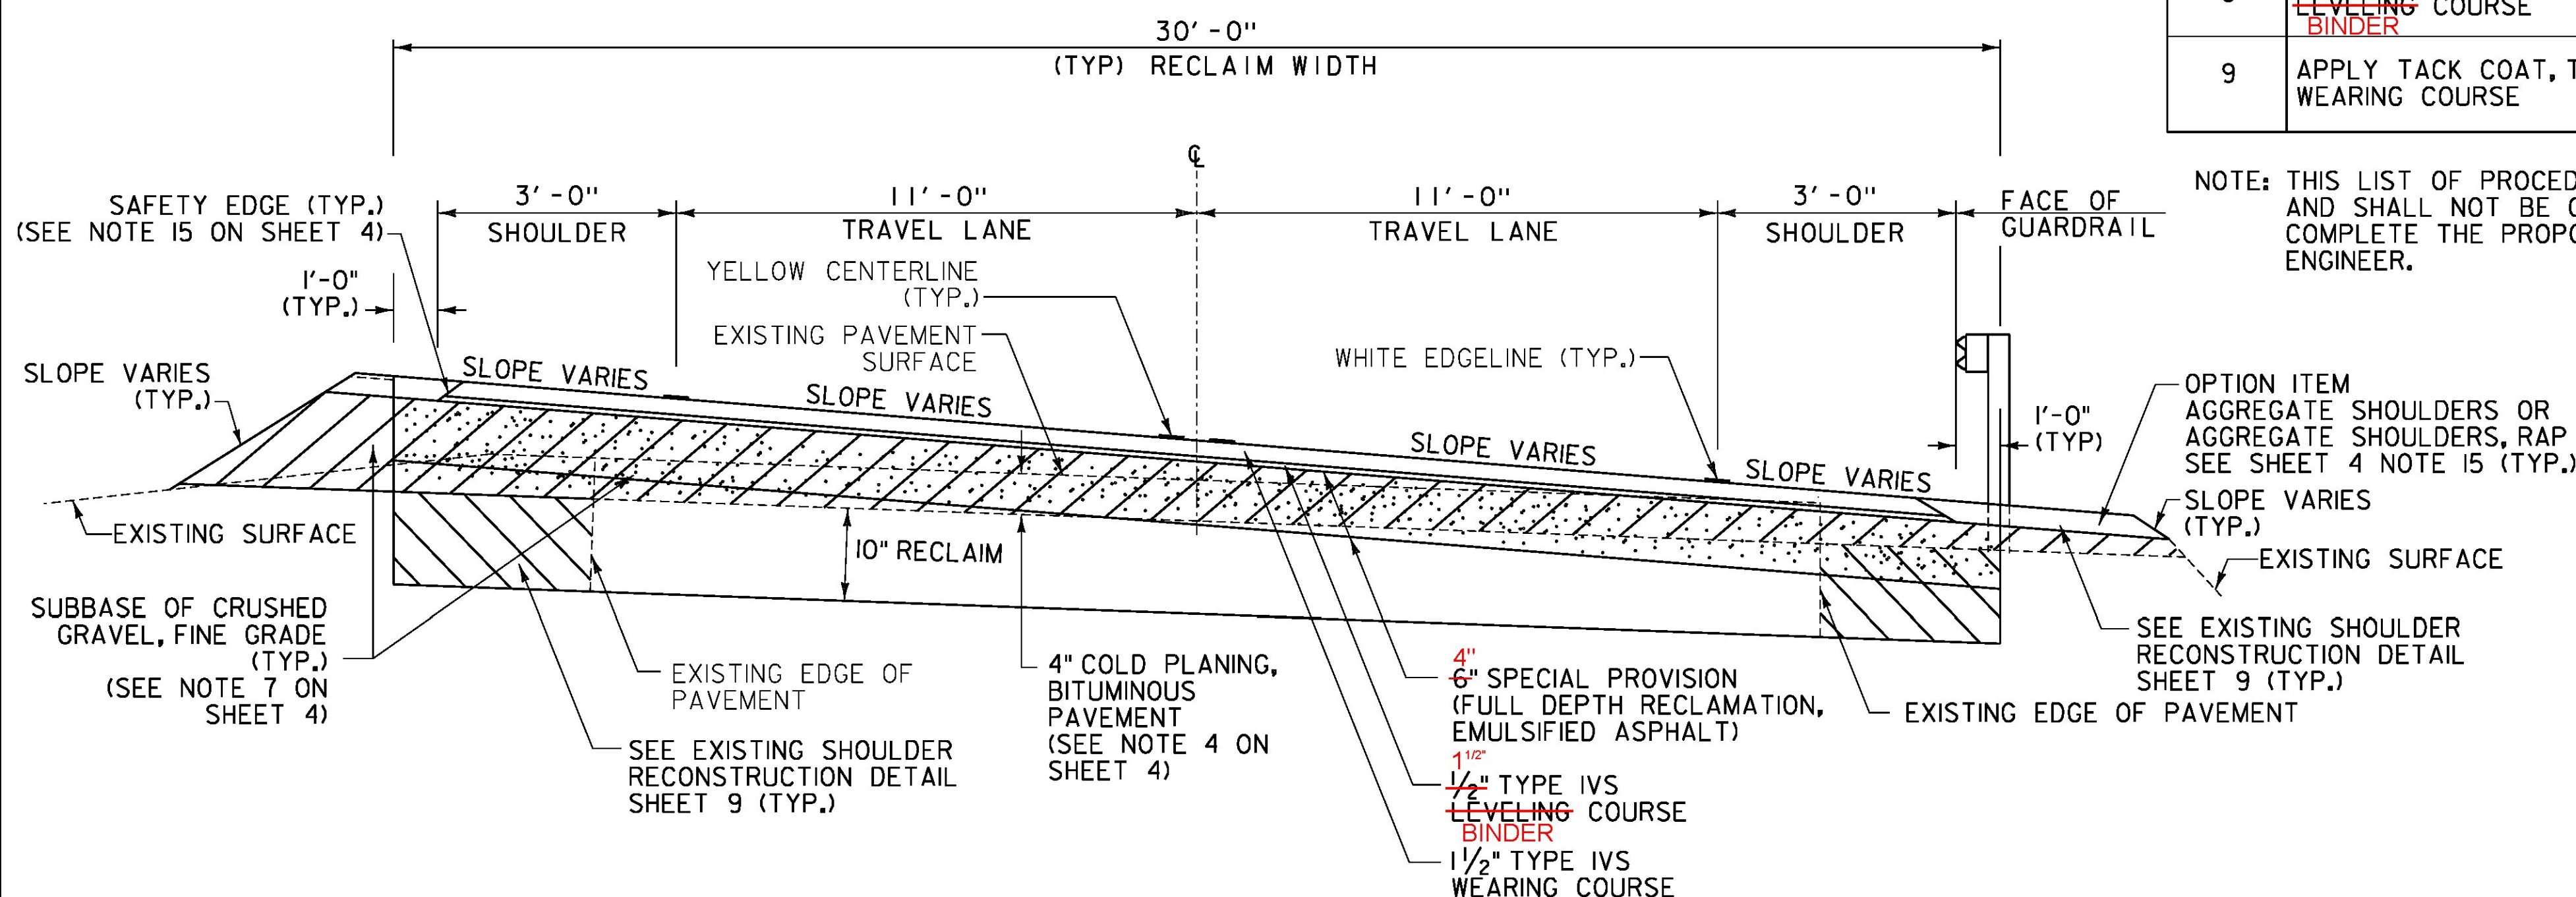

RECLAIM SUPERELEVATED TYPICAL SECTION (SEGMENT 2)

SEE BANKING DIAGRAM SHEETS AND CROSS SECTIONS FOR LOCATIONS AND CROSS SLOPES

NOT TO SCALE

PROJECT NAME: ROXBURY-NORTHFIELD
 PROJECT NUMBER: ER STP 0187(13)

FILE NAME: z13c184typ.dgn PLOT DATE: 6/21/2016
 PROJECT LEADER: M. FOISY DRAWN BY: G. BARRETT
 DESIGNED BY: G. BURGMEIER CHECKED BY: G. EDWARDS
TYPICAL SECTION SHEET 3 SHEET 6 OF 476

