
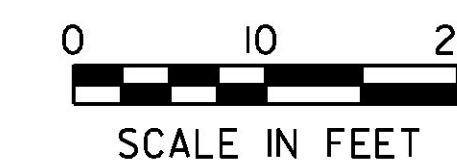
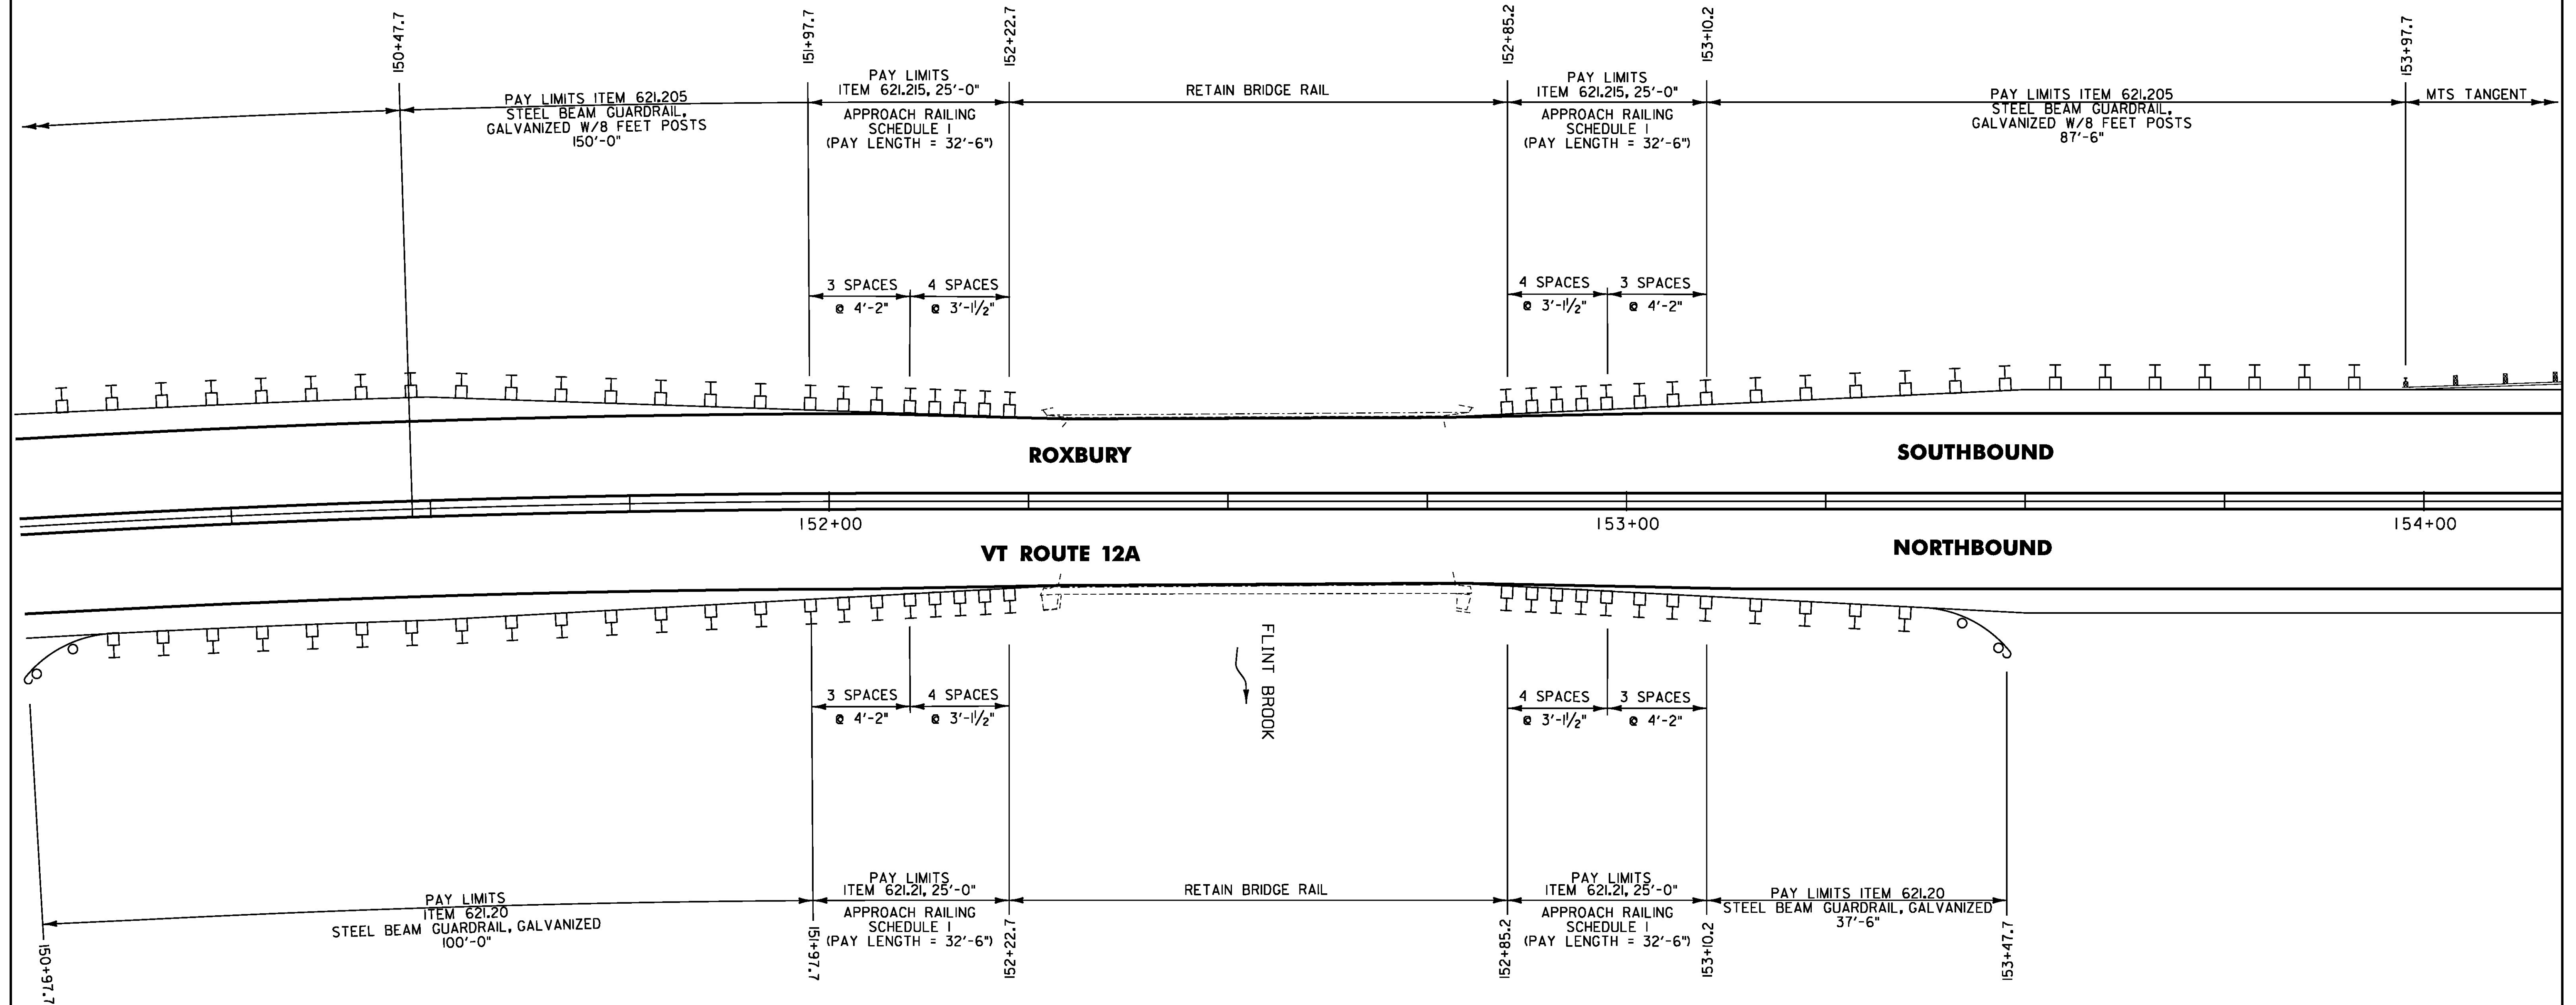


ROXBURY
BR#21
MM 2.889 = STA. 152+53

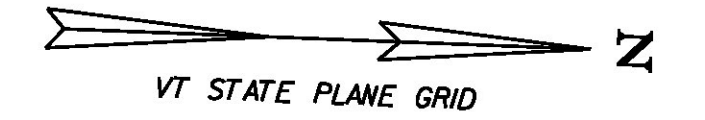

PROJECT NAME: ROXBURY-NORTHFIELD
PROJECT NUMBER: ER STP 0187(13)

FILE NAME: z13ci84typ.dgn
PROJECT LEADER: M. FOISY
DESIGNED BY: I. MAYNARD
GUARDRAIL DETAIL SHEET 3

PLOT DATE: 5/25/2016
DRAWN BY: I. MAYNARD
CHECKED BY: G. EDWARDS
SHEET 34 OF 476