



ROXBURY
BR#25
MM 3.923 = STA. 207+11

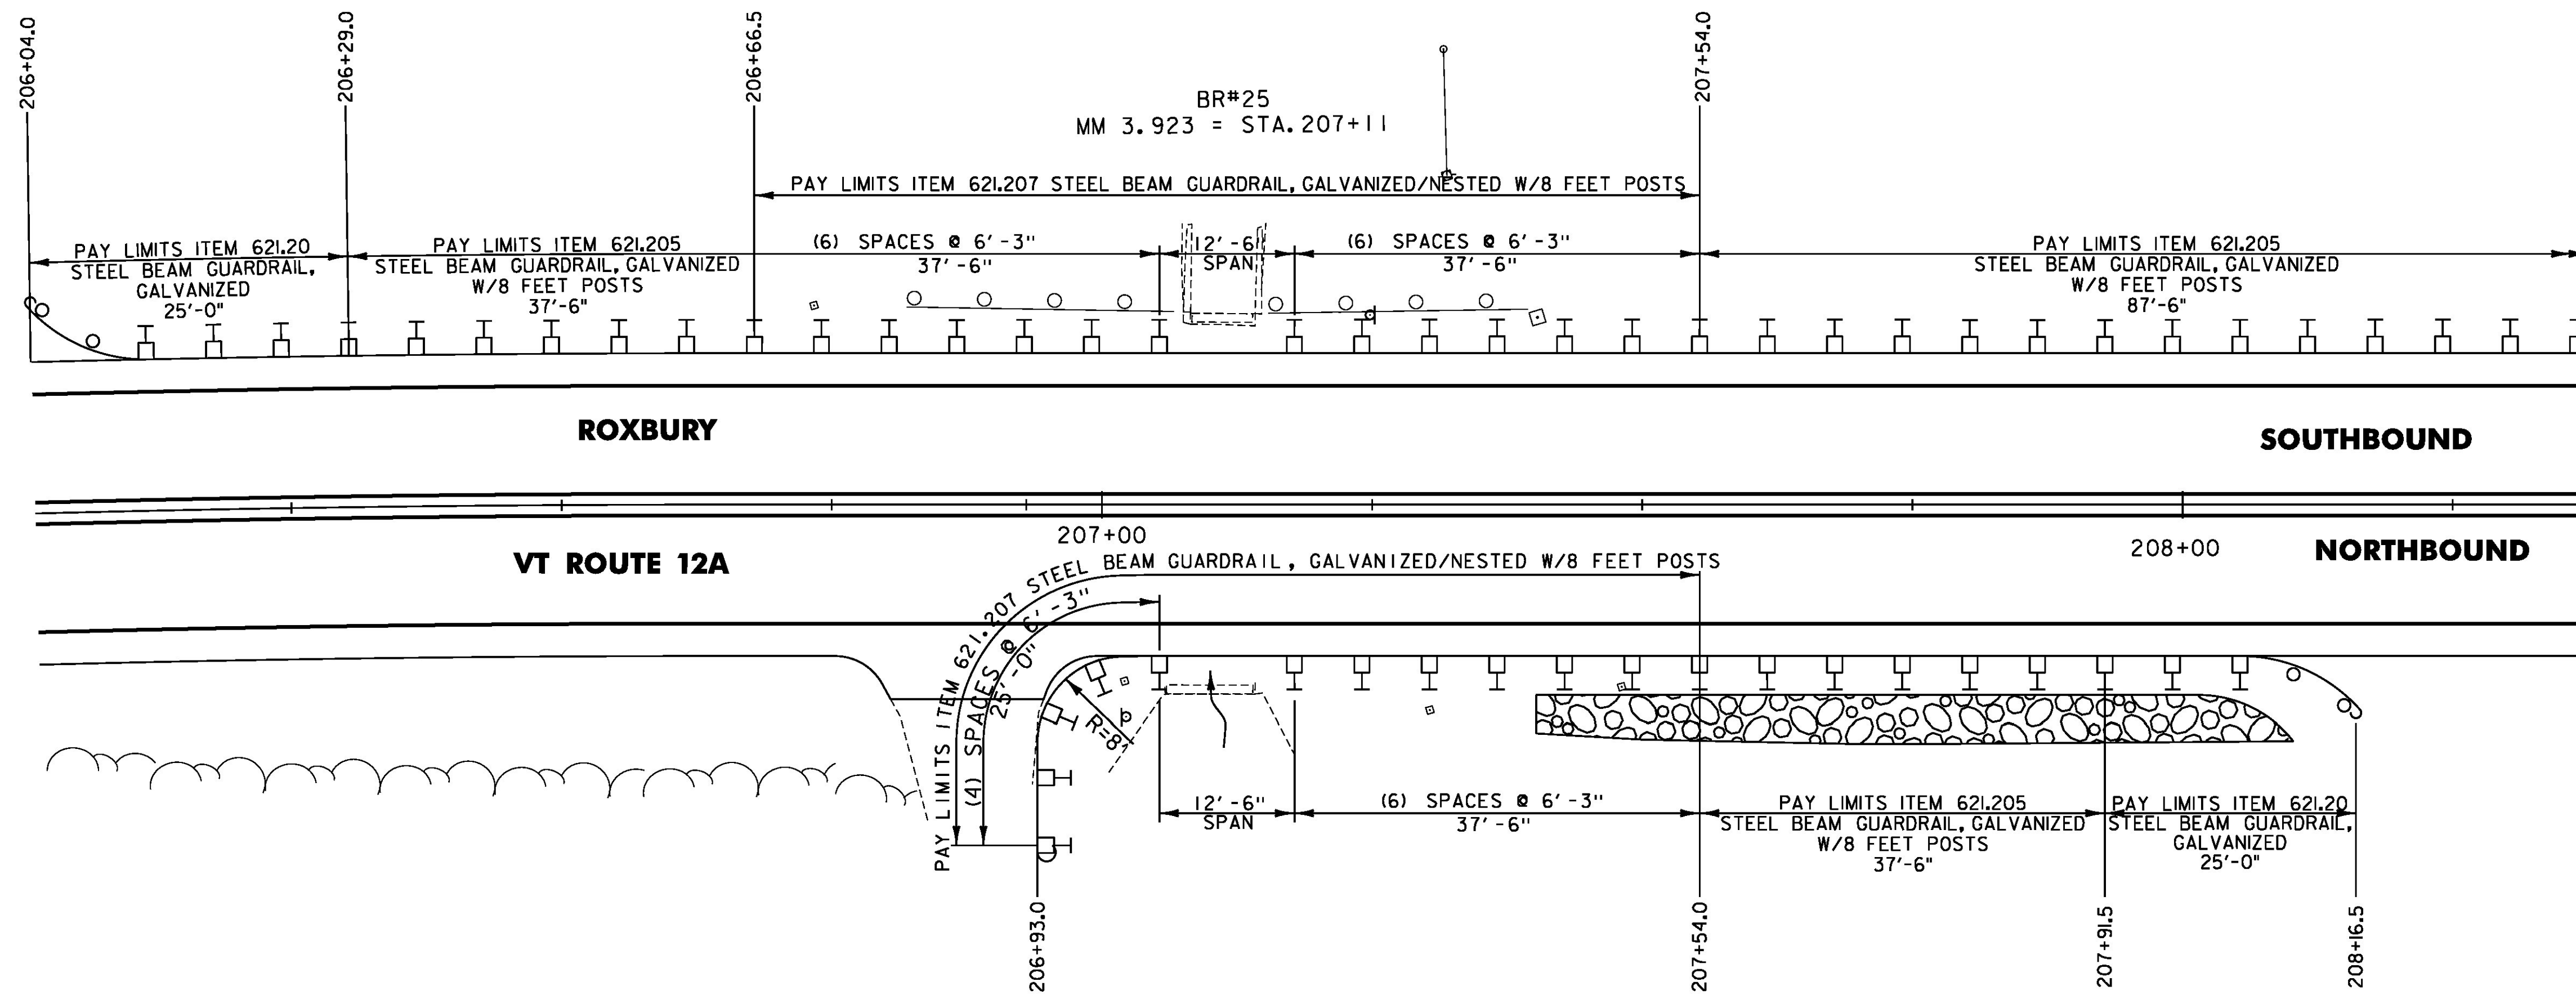

ROXBURY SOUTHBOUND
VT ROUTE 12A NORTHBOUND

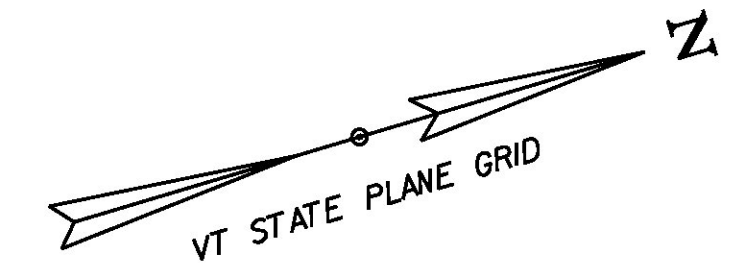

PROJECT NAME:	ROXBURY-NORTHFIELD
PROJECT NUMBER:	ER STP 0187(13)
FILE NAME:	z13cl84typ.dgn
PROJECT LEADER:	M. FOISY
DESIGNED BY:	I. MAYNARD
CHECKED BY:	G. EDWARDS
PLOT DATE:	5/25/2016
DRAWN BY:	I. MAYNARD
GUARDRAIL DETAIL SHEET 4	SHEET 35 OF 476