

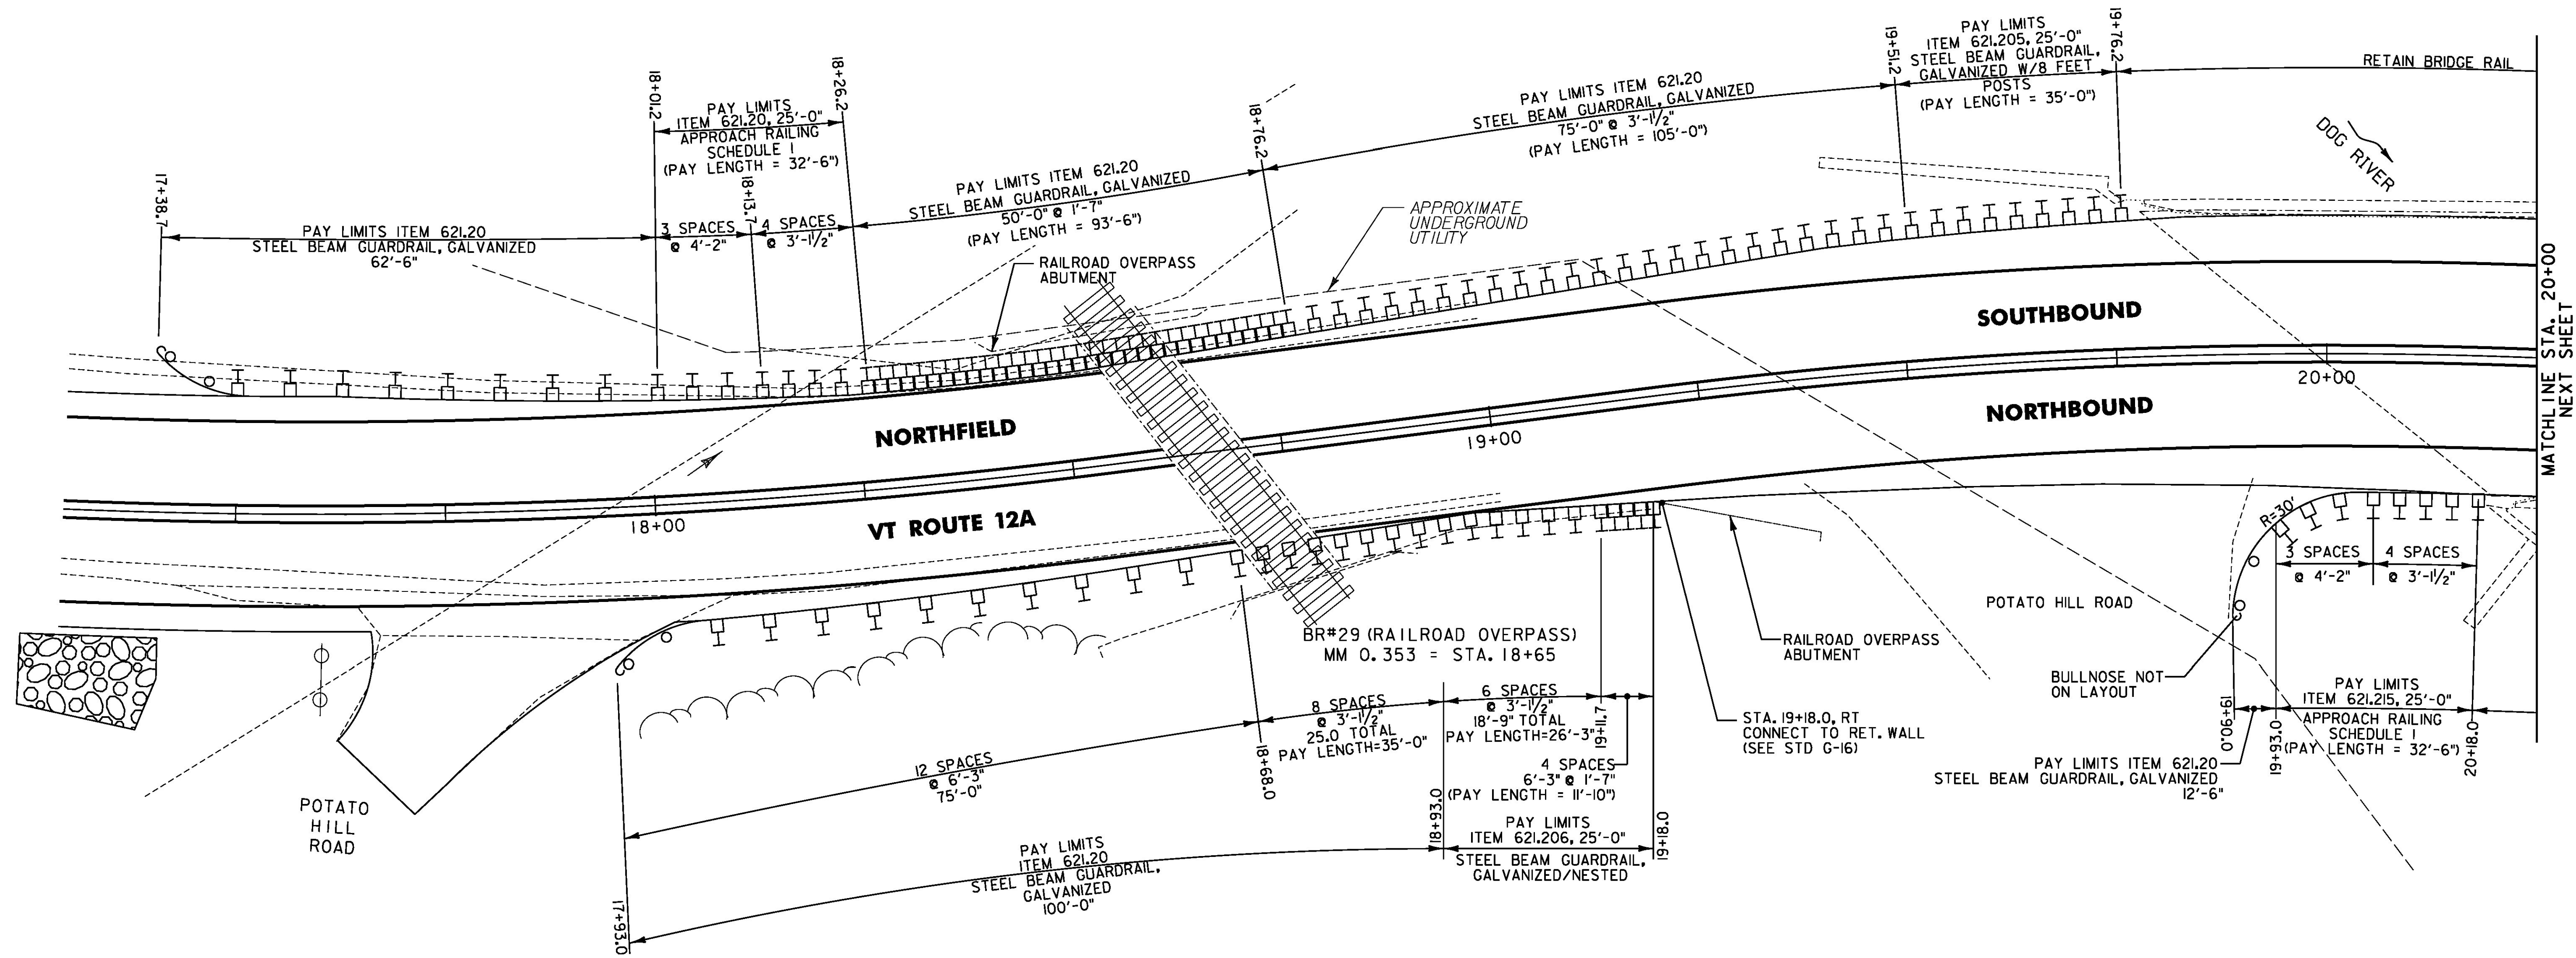


NORTHFIELD  
BR#30  
MM 0.387 = STA. 20+44

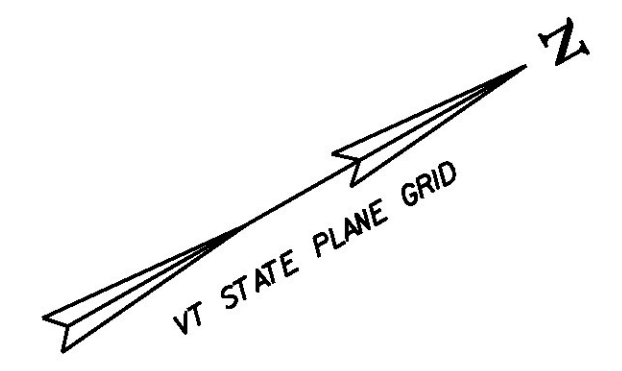

MATCHLINE STA. 20+00  
NEXT SHEET

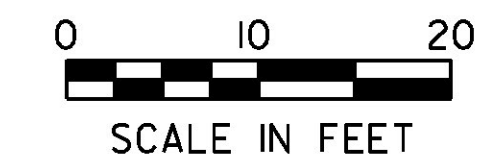

PROJECT NAME:	ROXBURY-NORTHFIELD
PROJECT NUMBER:	ER STP 0187(I3)
FILE NAME:	z13ci84typ.dgn
PROJECT LEADER:	M. FOISY
DESIGNED BY:	I. MAYNARD
CHECKED BY:	G. EDWARDS
<b>GUARDRAIL DETAIL SHEET 5</b>	
PLOT DATE:	5/25/2016
DRAWN BY:	I. MAYNARD
CHECKED BY:	G. EDWARDS
SHEET	36 OF 476