
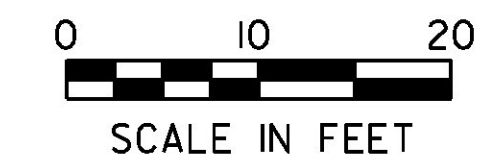
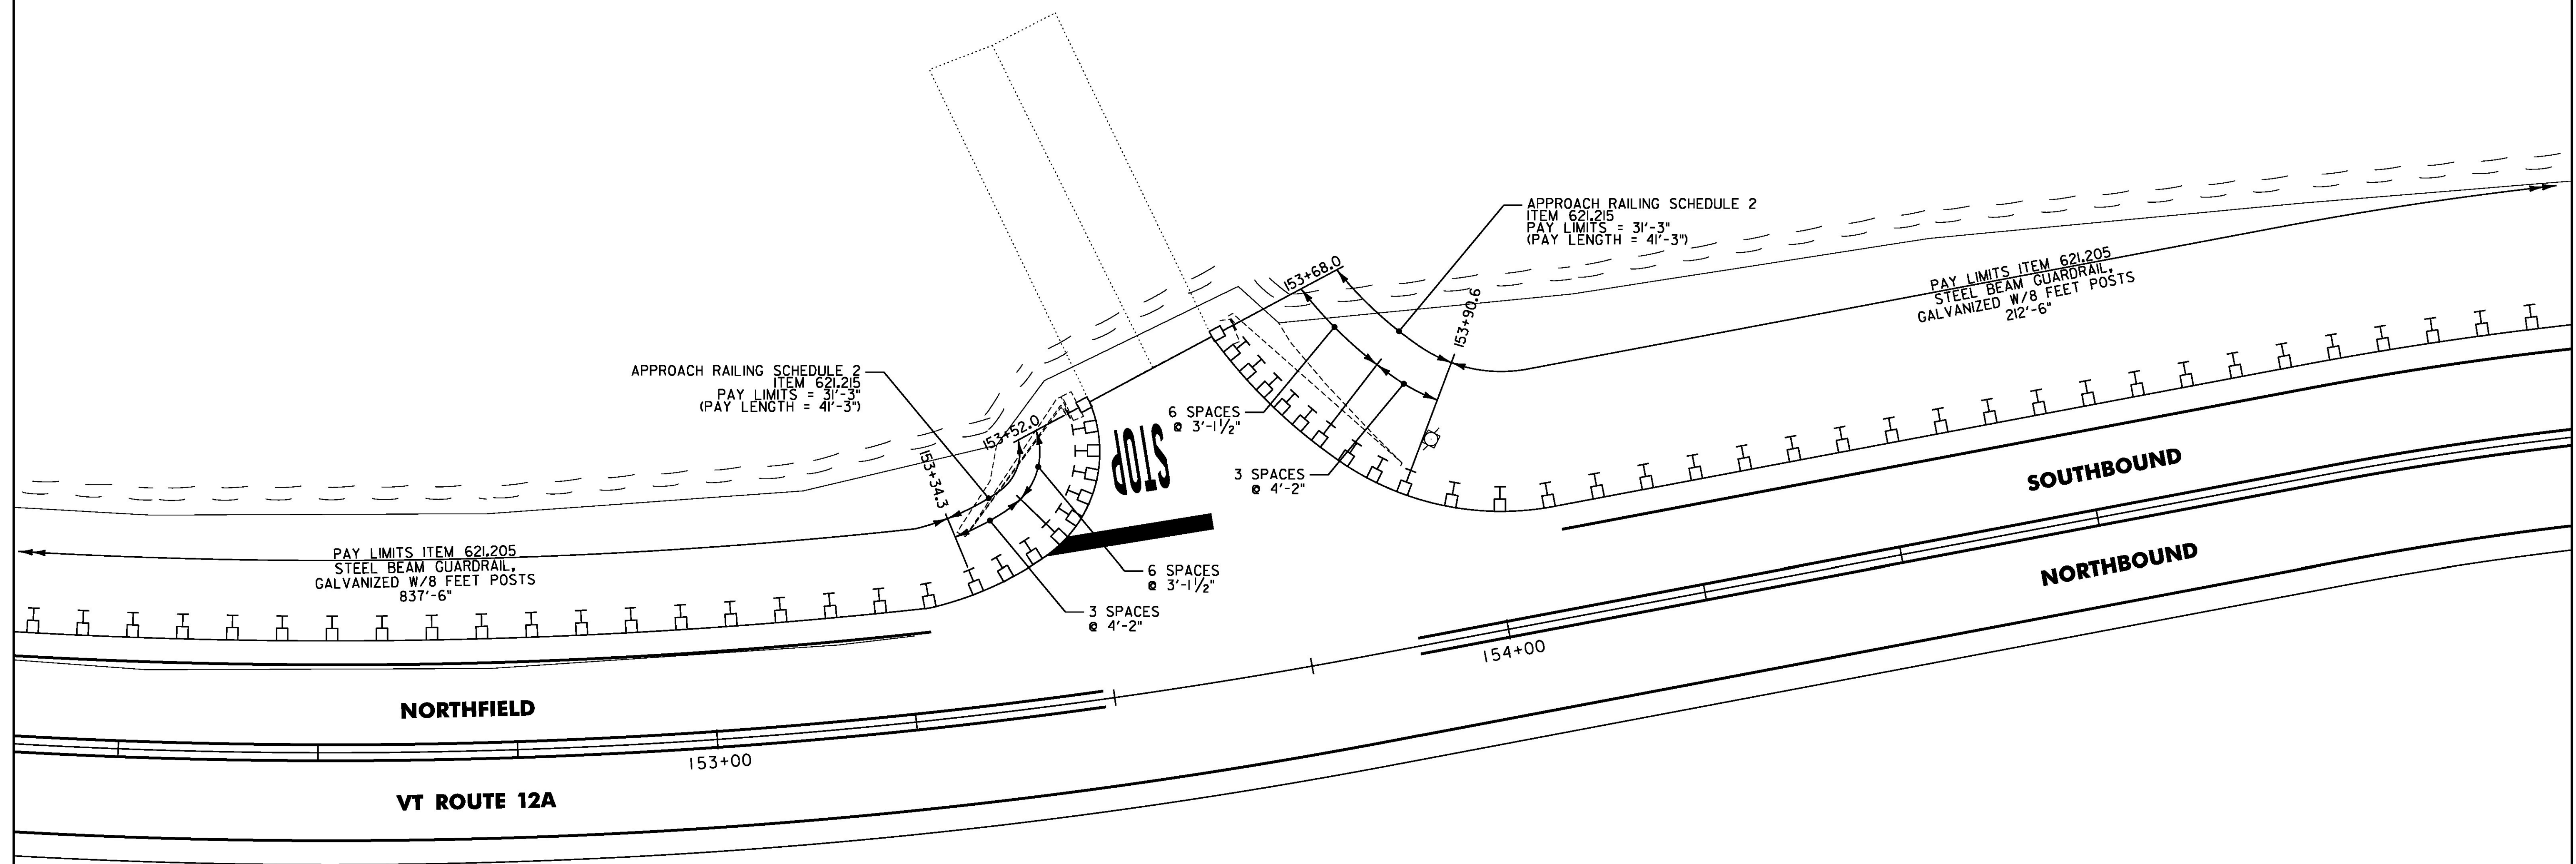


NORTHFIELD
 STONEY BROOK ROAD
 MM 2.910 = STA. 153+67

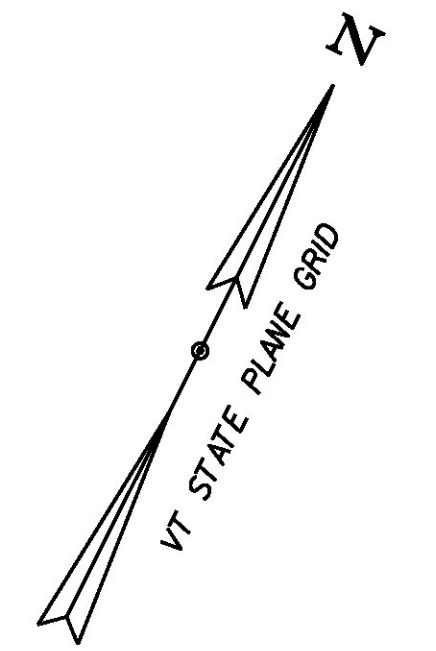

PROJECT NAME:	ROXBURY-NORTHFIELD	PLOT DATE:	5/25/2016
PROJECT NUMBER:	ER STP 0187(13)	DRAWN BY:	I. MAYNARD
FILE NAME:	z13ci84typ.dgn	CHECKED BY:	G. EDWARDS
PROJECT LEADER:	M. FOISY	SHEET	39 OF 476
DESIGNED BY:	I. MAYNARD	GUARDRAIL DETAIL SHEET 8	