

RELOCATE MAILBOX, SINGLE SUPPORT
 STA. 62+57, LT
 STONE FILL TYPE I & GRUBBING
 MATERIAL (6")
 STA. 60+00 TO 60+59, RT



DURABLE 4 INCH WHITE LINE (OPTION BID ITEM)
 TEMPORARY 4 INCH WHITE LINE, PAINT
 (ALL LINES SHALL INCLUDE EDGE LINE BREAKS
 AND RADII FOR SIDE ROADS)
 STA. 60+00 TO 65+00, SOLID LT & RT

DURABLE 4 INCH YELLOW LINE (OPTION BID ITEM)
 TEMPORARY 4 INCH YELLOW LINE, PAINT
 (ALL LINES SHALL INCLUDE CENTER LINE BREAKS
 FOR SIDE ROADS)
 STA. 60+00 TO 61+78, SOLID LT, DASHED RT
 STA. 61+78 TO 62+30, SOLID LT & RT
 STA. 62+30 TO 65+00, DASHED LT, SOLID RT




REMOVING SIGNS
 AS SHOWN - 2

BARRIER FENCE
 STA. 60+00 TO 60+25, LT
 STA. 61+80 TO 62+50, RT
 STA. 62+70 TO 65+00, RT

EROSION LOG
 STA. 62+70 TO 65+00, RT

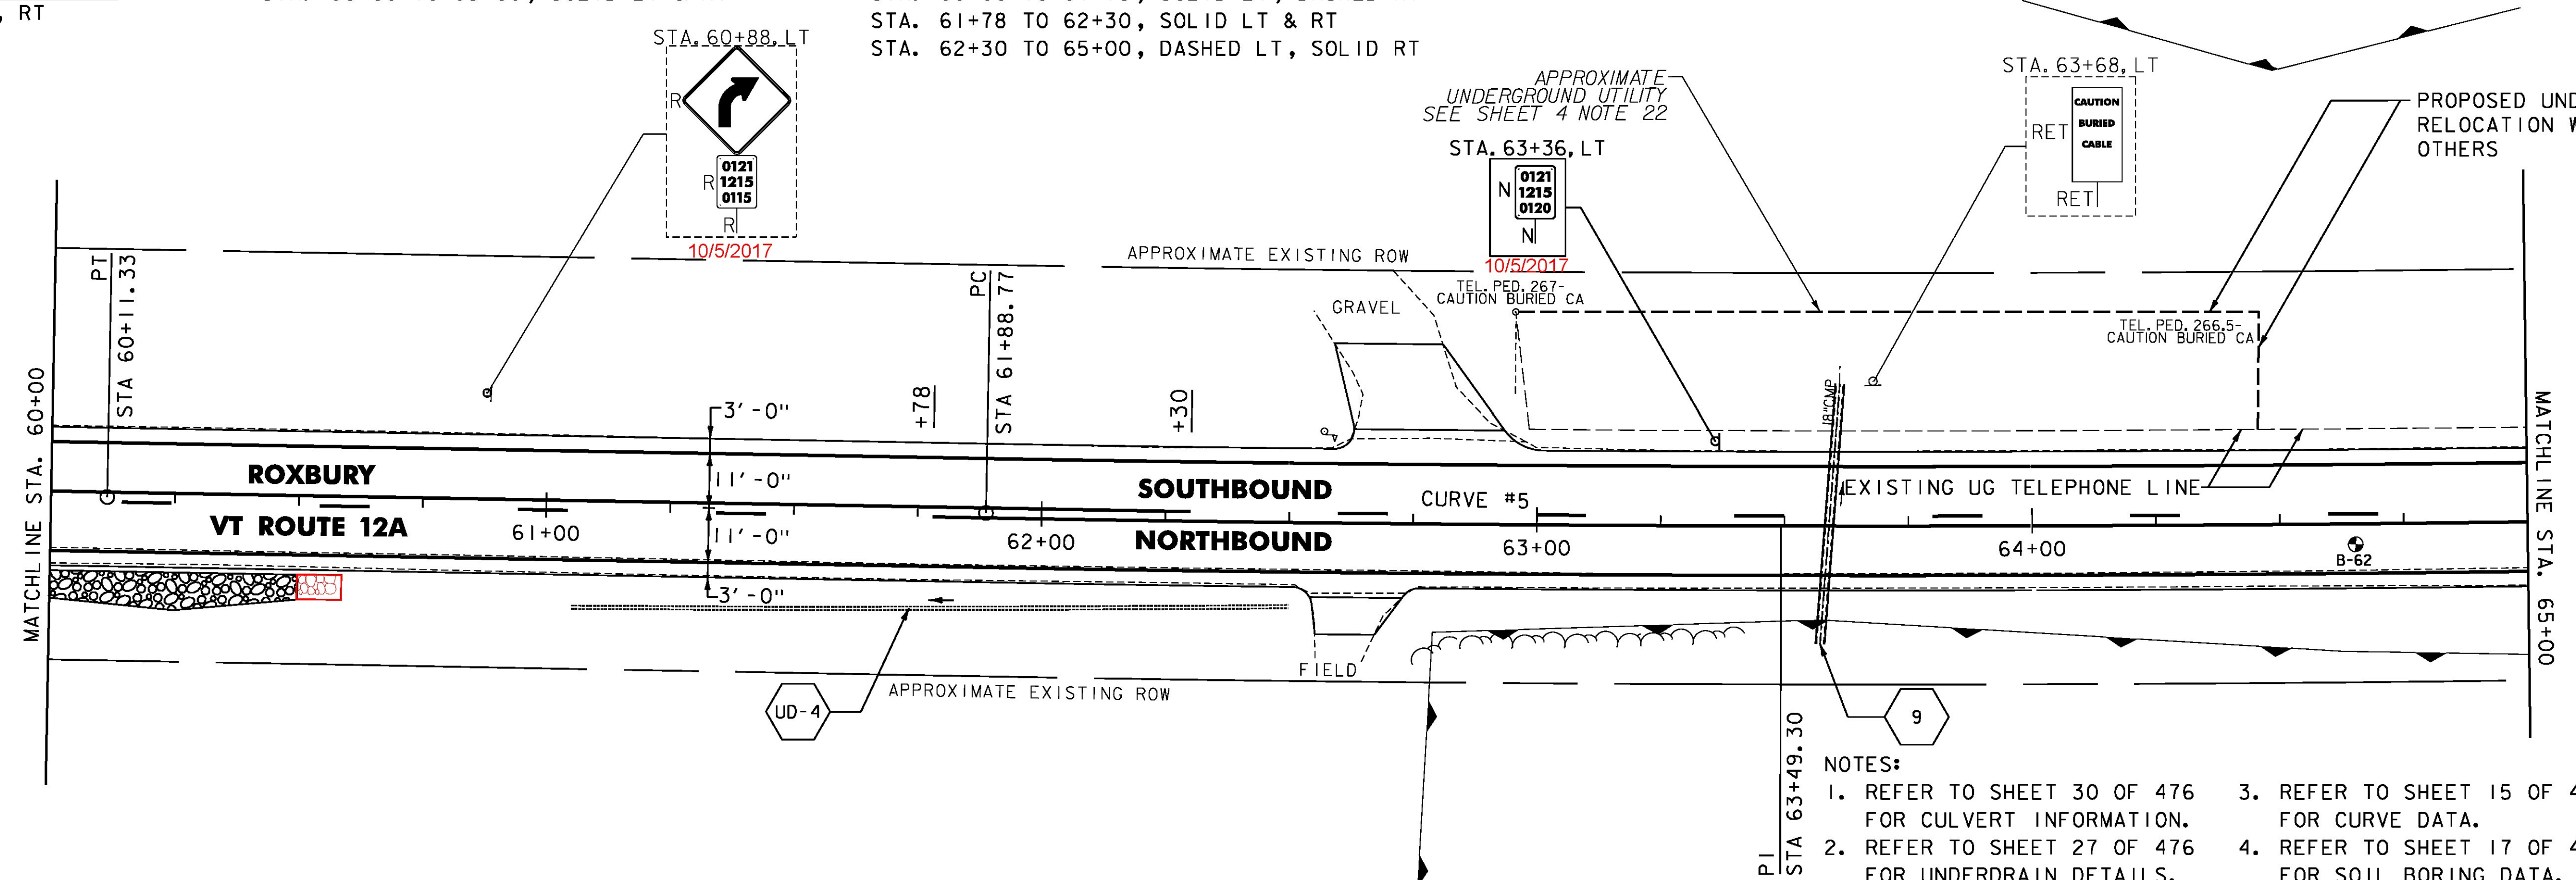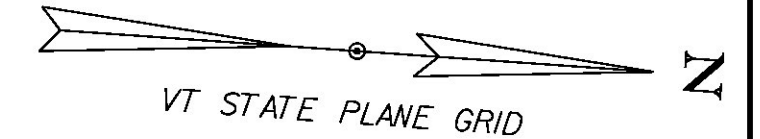

- NOTES:
- REFER TO SHEET 30 OF 476 FOR CULVERT INFORMATION.
 - REFER TO SHEET 27 OF 476 FOR UNDERDRAIN DETAILS.
 - REFER TO SHEET 15 OF 476 FOR CURVE DATA.
 - REFER TO SHEET 17 OF 476 FOR SOIL BORING DATA.

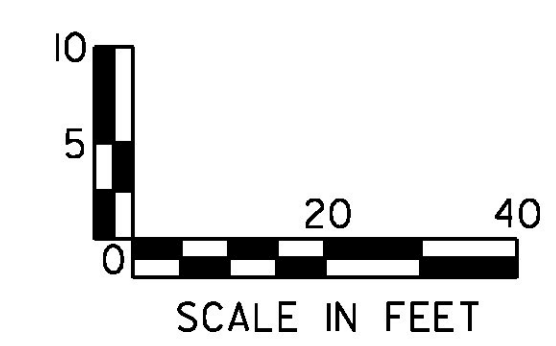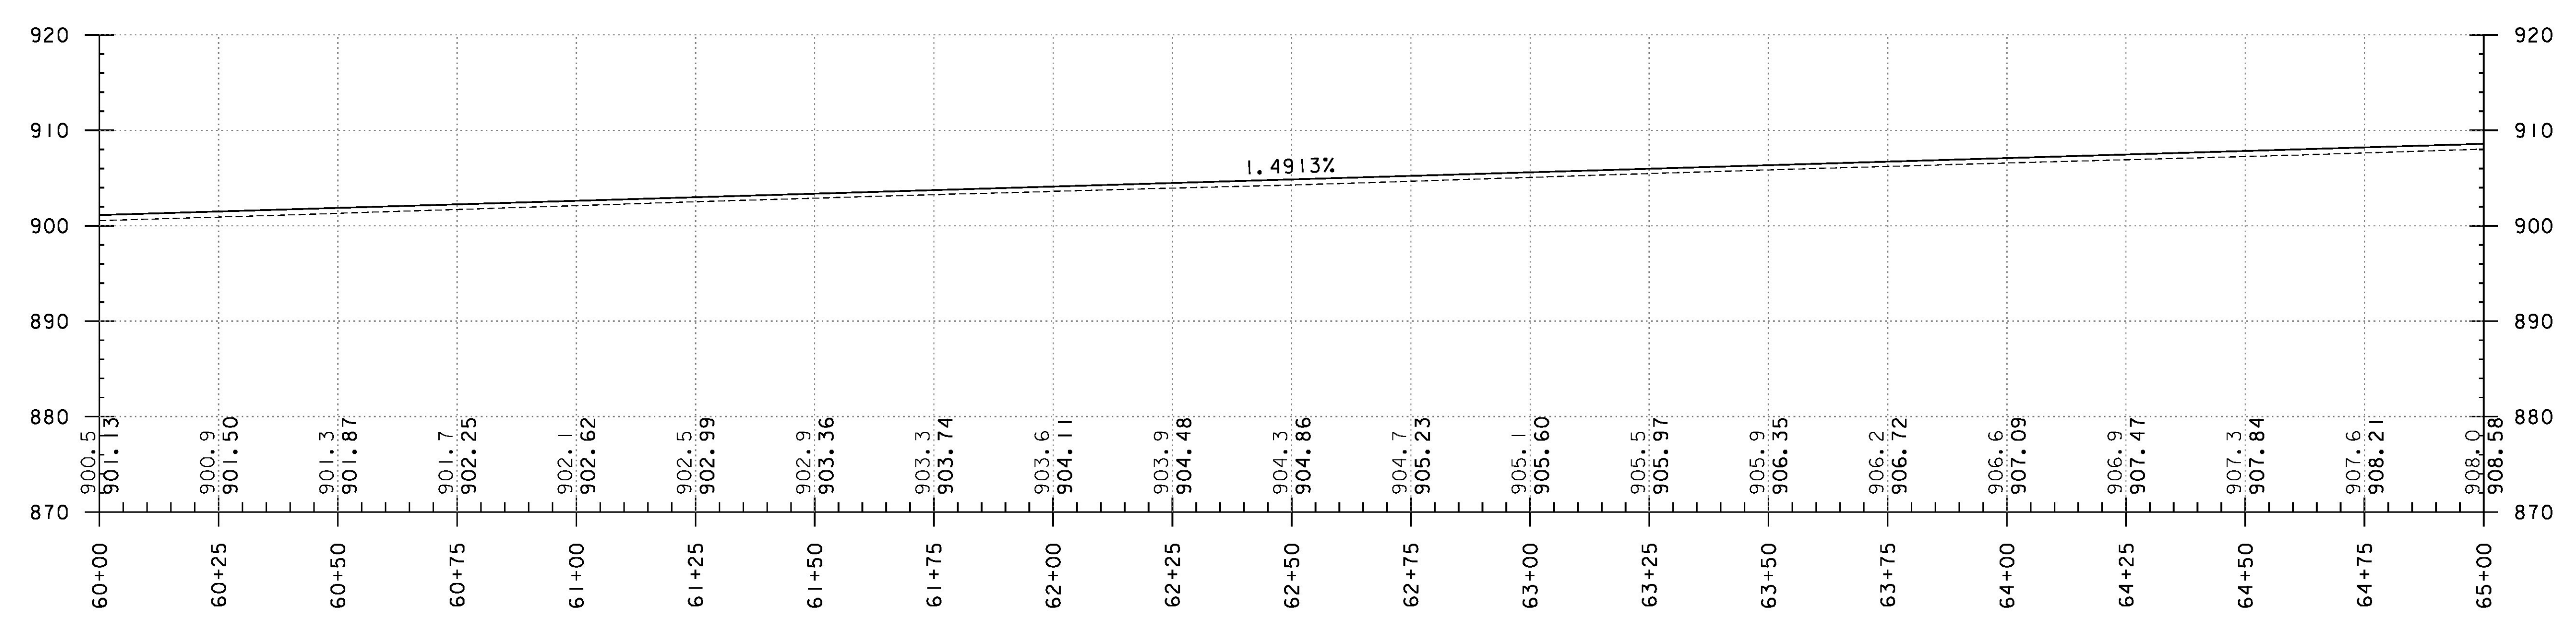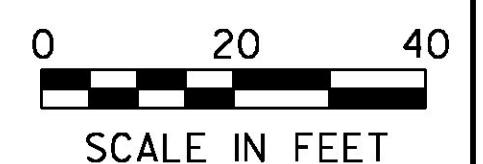

PROJECT NAME: ROXBURY - NORTHFIELD
 PROJECT NUMBER: ER STP 0187(13)
 FILE NAME: z13cl84bdr.dgn
 PROJECT LEADER: M. FOISY
 DESIGNED BY: G. BURGMEIER
 PLAN & PROFILE SHEET 6
 PLOT DATE: 5/25/2016
 DRAWN BY: G. BARRETT
 CHECKED BY: G. EDWARDS
 SHEET 56 OF 476